

**ITEM 6. ITEM FOR COMMITTEE INFORMATION - SEPARATED BI-
DIRECTIONAL CYCLEWAY – GEORGE STREET REDFERN**

TRIM RECORD NO: 2012/091176

RECOMMENDATION

It is recommended that the Committee note the attached line marking and signposting as installed with the separated bi-directional cycleway on George Street Redfern.

DECISION

BACKGROUND

The George Street cycleway project connects Bourke Street at Green Square to Cleveland Street at Prince Alfred Park near Central Station (1.7km). The project also includes an east-west connection from Mandible Street to Bourke Street via Botany Road/Allen and Short Streets (0.7km).

George Street is a critical link along the proposed Green Square to City Centre Regional Route. The east-west route is a key link along the University of NSW to University of Sydney Regional Cycleway Route.

COMMENTS

The Local Pedestrian, Cycling and Traffic Calming Committee (LPCTCC) endorsed the Separated Bi-directional Cycleway on George Street Redfern at its meeting in October 2012.

Line marking and signposting changes have now been completed (after further community consultation) for a separated bi-directional cycleway on the following streets:

- George Street between Cleveland Street, Redfern and Navins Lane, Zetland,
- Short and Allen Streets, Waterloo
- Mandible Street between Hawksley and Wyndham Streets, Waterloo,

These changes included the relocation of the STA bus zone (and shelter) from Pitt Street to Wellington Street, Waterloo with approval from Sydney Buses.

CONSULTATION

A public exhibition was undertaken in April-May 2012 with 6700 letters sent to local residents, in addition to over 10,000 e-news letters, online updates on Councils websites, several public community forums and extensive face to face consultation along the route.


FINANCIAL

Works have already been completed.

ATTACHMENTS

Item For Committee Information - Separated Bi-Directional Cycleway – George Street Redfern

Rob Serventi Senior Project Manager

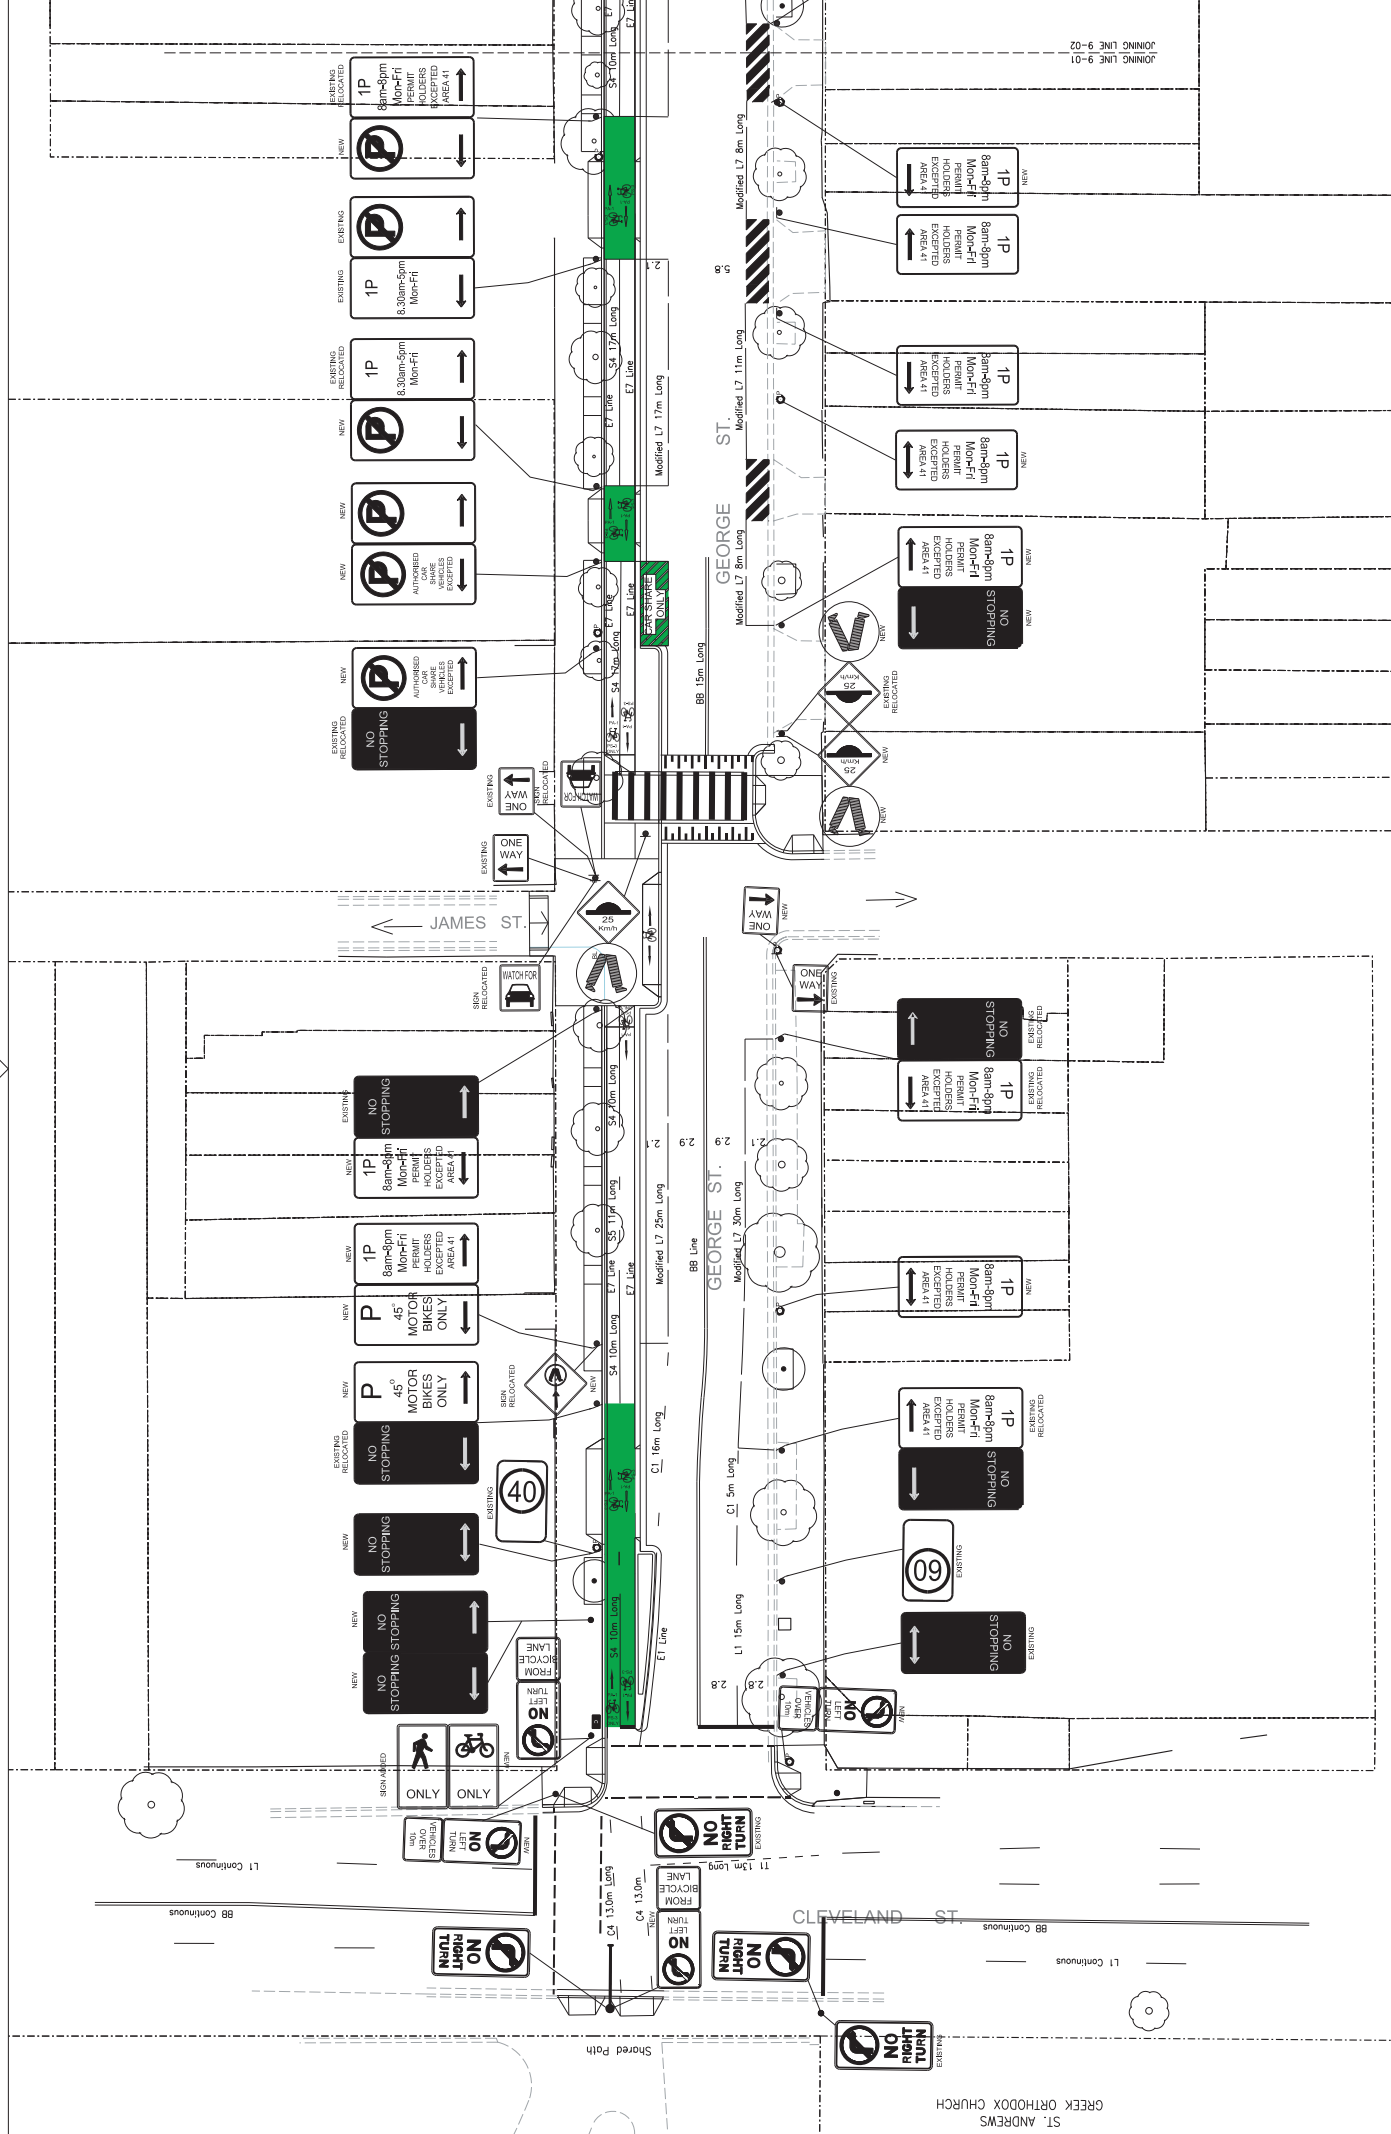


REV	DATE	INFORMATION / REVISION DESCRIPTION	APPROVAL	NAME	ROLE
1	31/03/13	CONSTRUCTION ISSUE	DRAFTSMAN	JAB	
2	15/02/13	AMEND CONSTRUCTION ISSUE	DRAFTING CHECK	SH	
3	24/02/14	WORKS AS EXECUTED	DESIGNER	TTPA	
4	24/02/14	WORKS AS EXECUTED	DESIGN CHECK	SH	
5	30/02/14	WORKS AS EXECUTED	PROJECT MANAGER	RS	
			PROJECT DIRECTOR	JAC	

LEAD CONSULTANT / LANDSCAPE ARCHITECT	CONSULTANTS	CLIENT	SCALE & A1	PROJECT TITLE
GROUP USA www.groupusa.com.au P: +61 8 8332 3137 F: +61 8 8332 3668 25 Wren Street, East Sydney NSW	GILL ENGINEERING - STRUCTURAL CONSULTING ENGINEERS TRAFFIC ENGINEERING, TRANSPORT AND TRAFFIC PLANNING ASSOCIATES LIFTING CONSULTANTS - LIFTING, P&I & SCIENCE CYCLE CONSULTING - SUSTAINABLE TRANSPORT CONSULTANTS ACCESS CONSULTING - ACCESS, USER ACCESSIBILITY CONSULTING	www.dialbeforeyoudig.com.au DIAL 1100 BEFORE YOU DIG	1:200	GEORGE STREET CYCLEWAY - PACKAGE 2A SIGNAGE & LINEMARKING WORKS AS EXECUTED

DATE	DESCRIPTION	BY	APPROVED BY
31/03/13	CONSTRUCTION ISSUE	JAB	
15/02/13	AMEND CONSTRUCTION ISSUE	SH	
24/02/14	WORKS AS EXECUTED	TTPA	
24/02/14	WORKS AS EXECUTED	SH	
30/02/14	WORKS AS EXECUTED	RS	


PROJECT TITLE	SCALE & A1	CLIENT	PROJECT DRAWINGS NO.	REVISION
GEORGE STREET CYCLEWAY - PACKAGE 2A	1:200		9_01	5

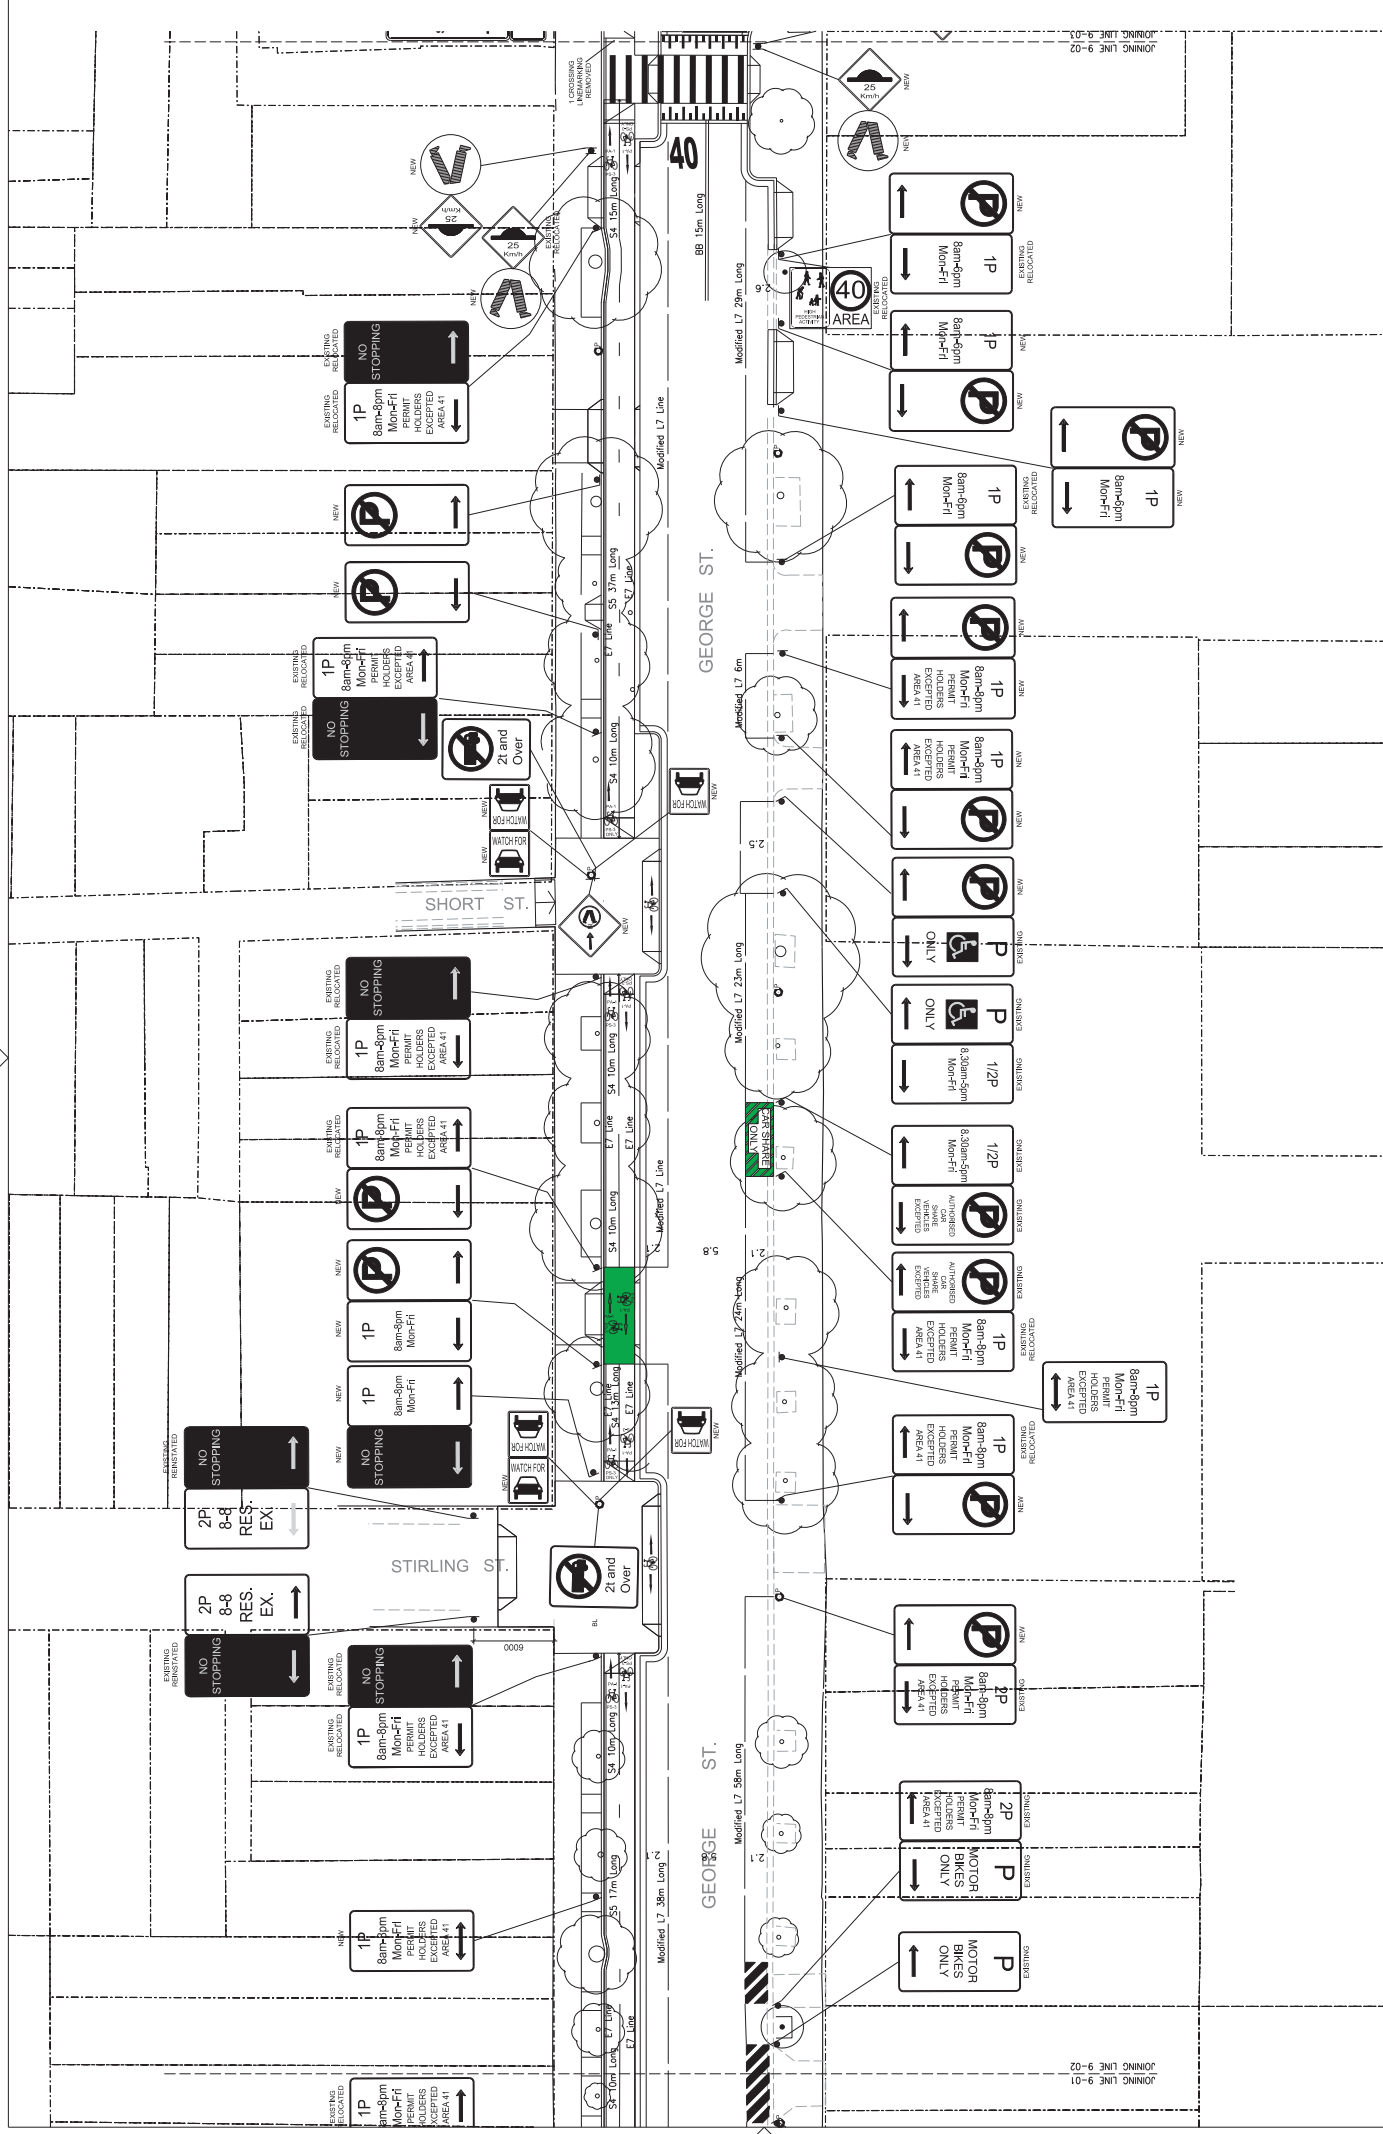

REV	DATE	REVISION / REVISION DESCRIPTION	APPROVAL	NAME	ROLE
1	31/03/13	CONSTRUCTION ISSUE	IM	DRAFTSMAN	AB
2	24/01/14	WORKS AS EXECUTED	IM	DRAFTING CHECK	SH
3	24/01/14	WORKS AS EXECUTED	IM	DESIGNER	TPA
4	30/01/14	WORKS AS EXECUTED	AB	DESIGN CHECK	SH
				PROJECT MANAGER	RES
				PROJECT DIRECTOR	RES

LEAD CONSULTANT / LANDSCAPE ARCHITECT	CONSULTANTS	CLIENT	SCALE	PROJECT TITLE
 P.O. Box 8202 2137 F +61 8 9332 2668 25 Wren Street East Sydney NSW	 www.dialbeforeyoudig.com.au BEFORE YOU DIG		1:200	GEORGE STREET CYCLEWAY - PACKAGE 2A

DATE	DESCRIPTION	PROJECT STATUS	DRAWING TITLE	PROJECT / DRAWINGS No.
31/03/13	CONSTRUCTION ISSUE	AS EXECUTED	SIGNAGE & LINEMARKING	9_02
24/01/14	WORKS AS EXECUTED	AS EXECUTED		
30/01/14	WORKS AS EXECUTED	AS EXECUTED		

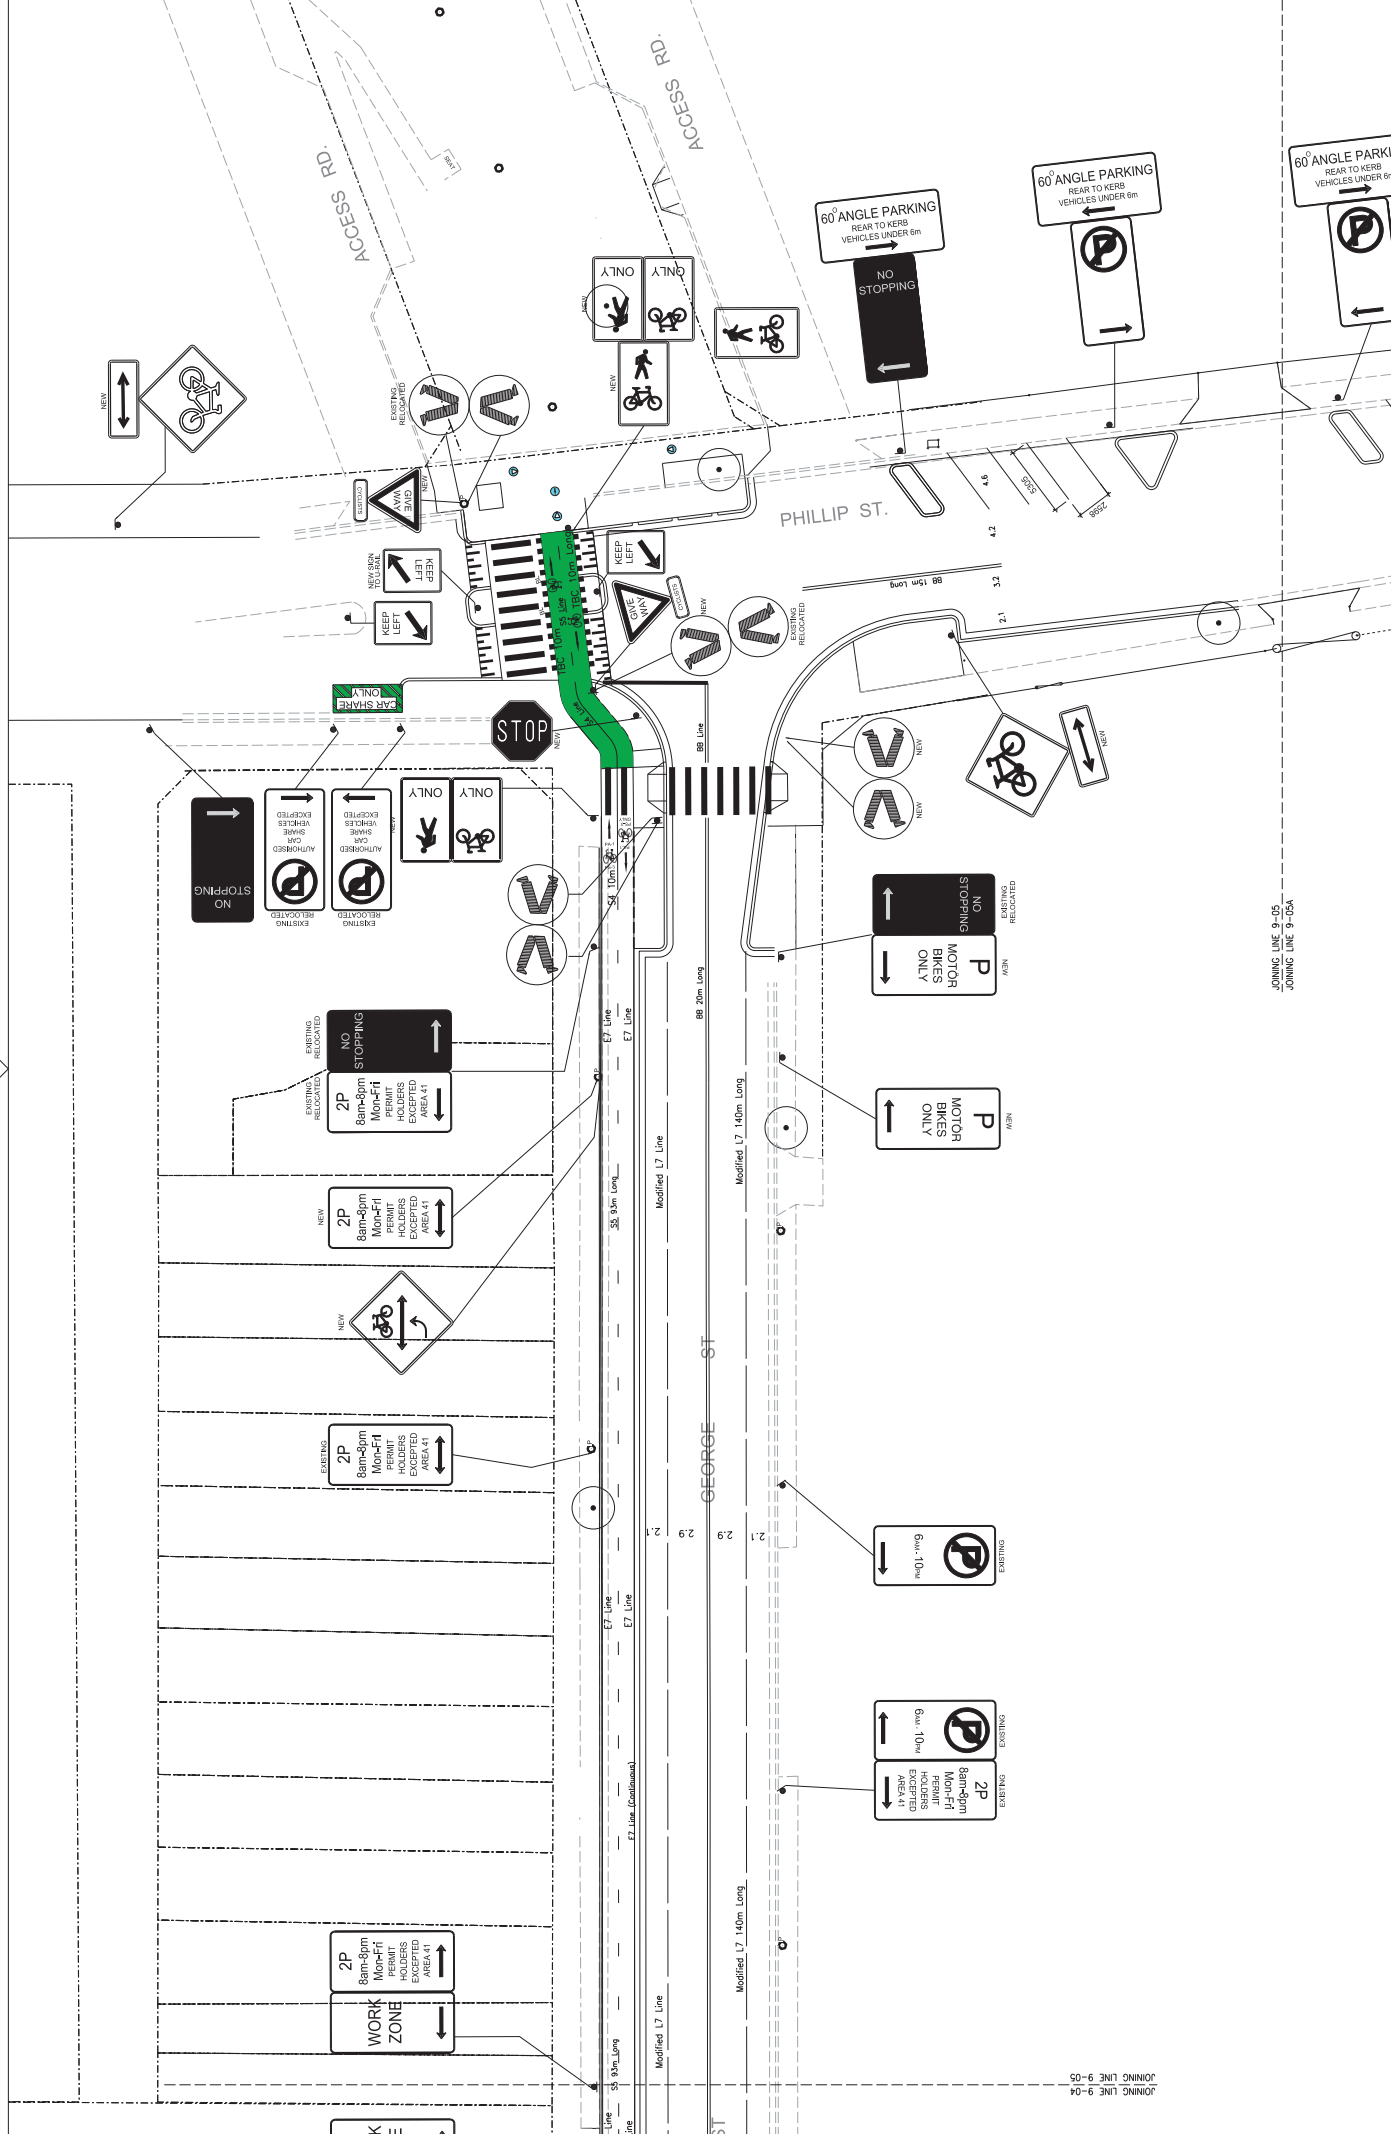


REV	DATE	AMENDMENT / REVISION DESCRIPTION	APPROVAL	NAME	ROLE
1	31/03/13	CONSTRUCTION ISSUE	PH	AB	ISSUE
2	18/04/13	AMENDED CONSTRUCTION ISSUE	PH	SH	DRAFTING CHECK
3	18/04/13	AMENDED CONSTRUCTION ISSUE	PH	TPPA	DESIGNER
4	11/05/13	AMENDED CONSTRUCTION ISSUE	PH	SH	DESIGN CHECK
5	20/02/13	AMENDED CONSTRUCTION ISSUE	PH	RS	PROJECT MANAGER
6	16/01/14	AMENDED CONSTRUCTION ISSUE	PH	RS	PROJECT MANAGER
7	24/07/14	WORKS AS EXECUTED	PH	RS	PROJECT DIRECTOR
8	30/07/16	WORKS AS EXECUTED	PH	RS	PROJECT DIRECTOR

LEAD CONSULTANT / LANDSCAPE ARCHITECT	GROUP USA pod
CONSULTANTS	<ul style="list-style-type: none"> ONLINE ENGINEERING - ARCHITECTURE CONSULTING ENGINEERS TRIPLEX ENGINEERING - TRANSPORT AND TRAFFIC PLANNING ASSOCIATES LETTING CONSULTANTS - LIGHTING, ART & SCIENCE CYCLE CONSULTING - SUSTAINABLE TRANSPORT CONSULTANTS ACCESS CONSULTANT / ACCESS USER ACCESSIBILITY CONSULTING
CLIENT	City of Sydney
SCALE	1:200
PROJECT TITLE	GEORGE STREET CYCLEWAY - PACKAGE 2A
DRAWING TITLE	SIGNAGE & LINEMARKING
DRAWING STATUS	WORKS AS EXECUTED
PROJECT DRAWINGS No.	9_05
REVISION	8

JOINING LINE 9-04
JOINING LINE 9-05




SCALE 1:200
PROJECT TITLE: GEORGE STREET CYCLEWAY - PACKAGE 2A
DRAWING TITLE: SIGNAGE & LINEMARKING
DRAWING STATUS: WORKS AS EXECUTED
PROJECT DRAWINGS No.: 9_05
REVISION: 8

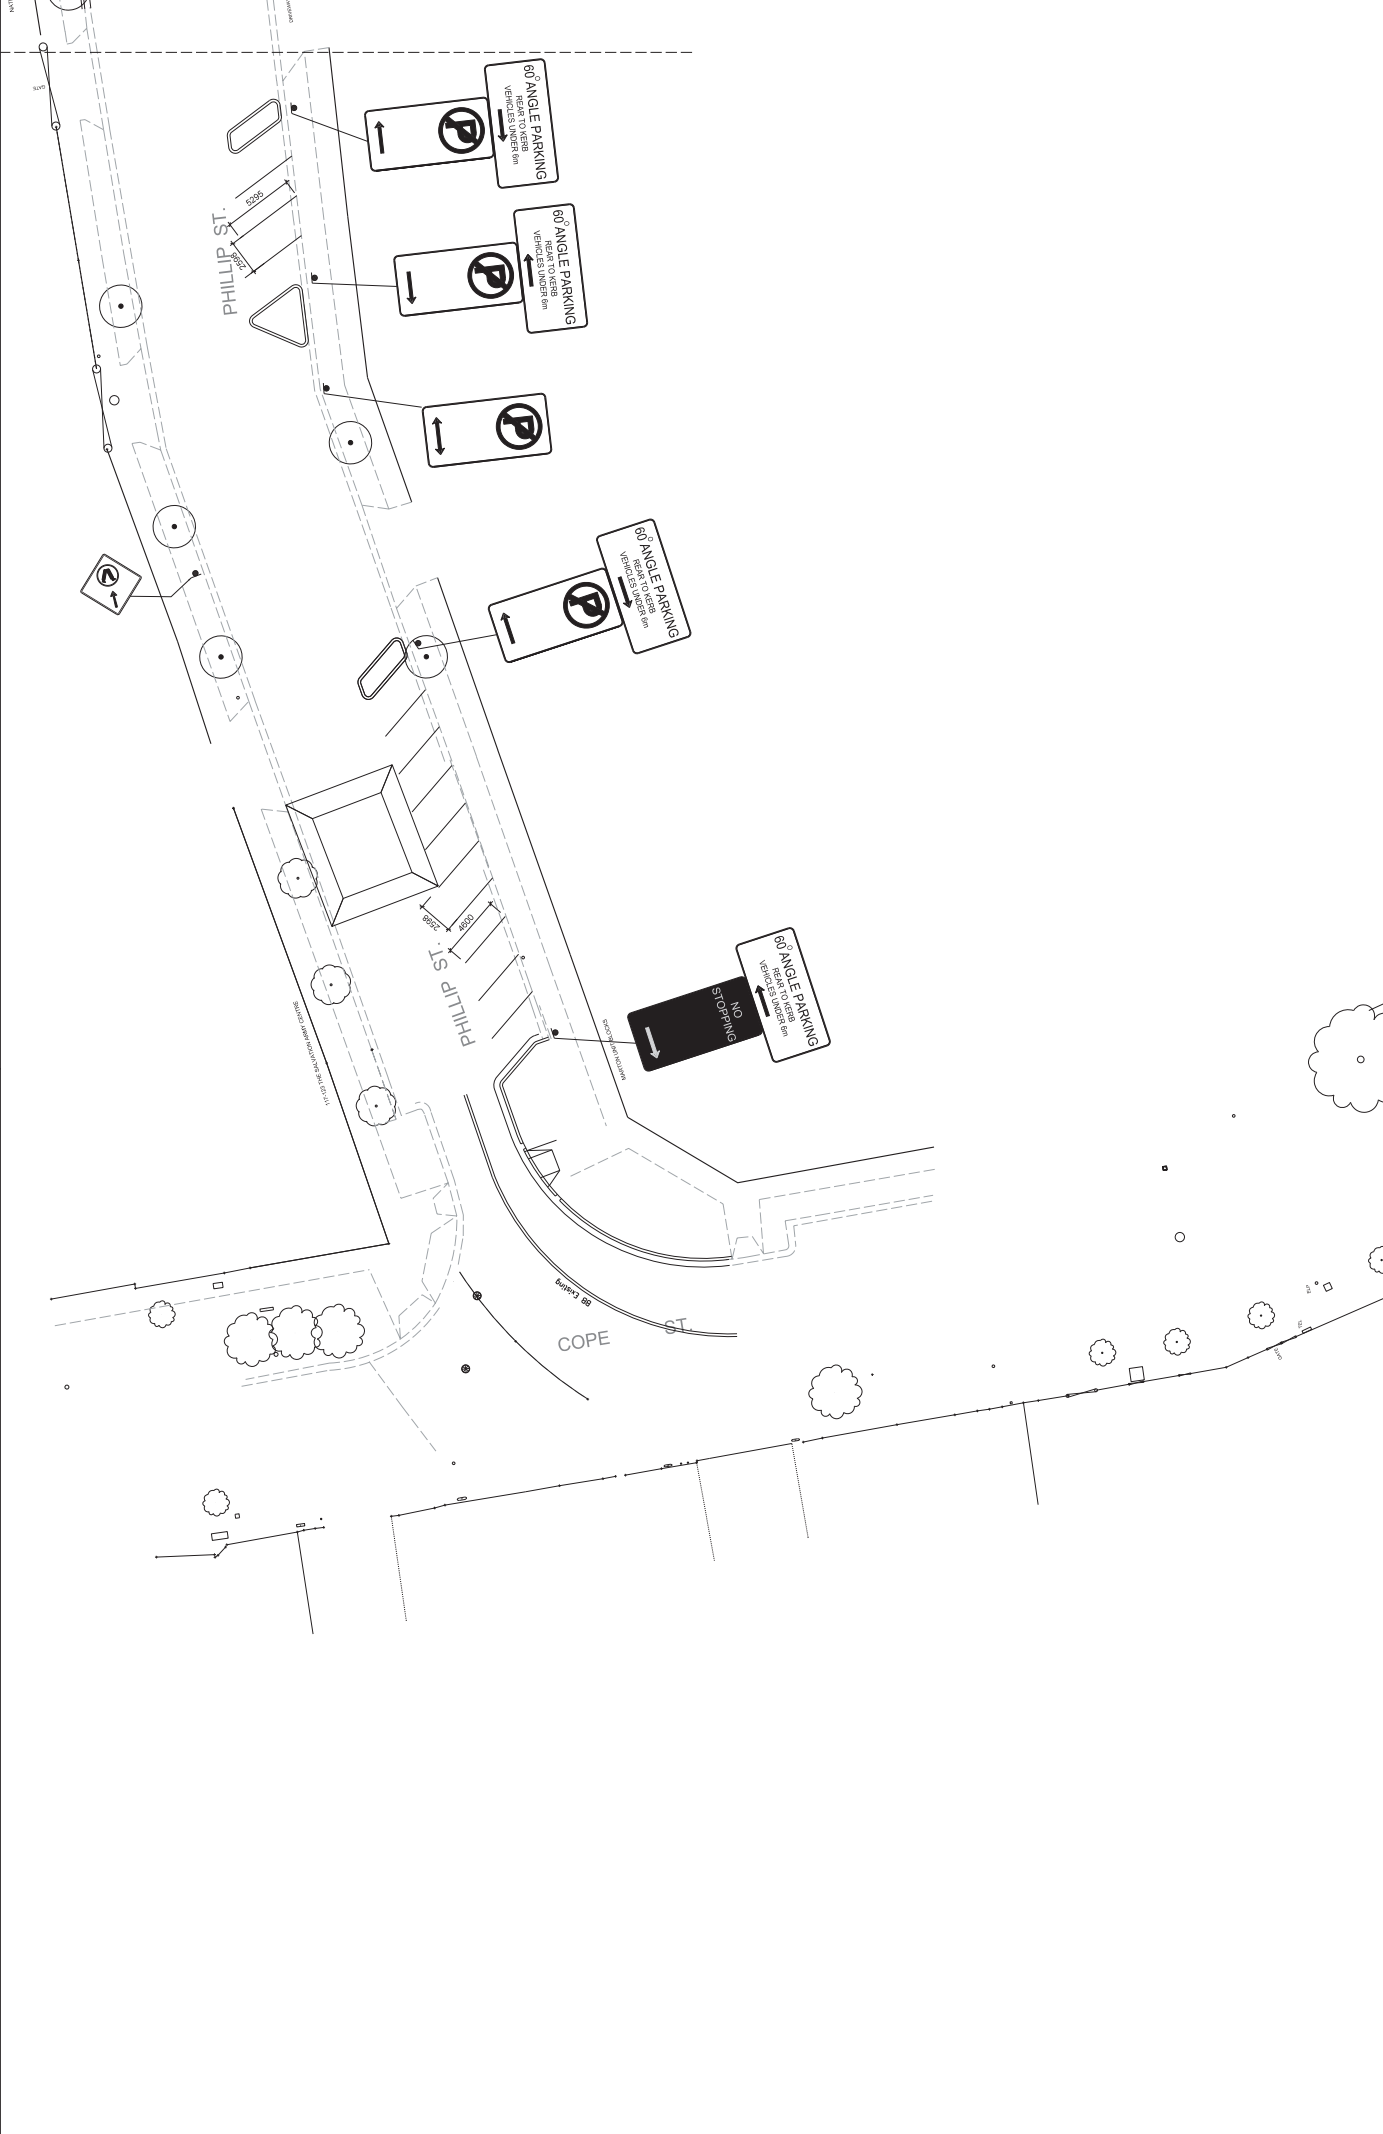

REV	DATE	AMENDMENT / REVISION / DESCRIPTION	APPROVAL	NAME	ROLE
1	31/03/13	CONSTRUCTION ISSUE	PH	PHILIP HARRIS	PROJECT DIRECTOR
2	26/07/14	WORKS AS EXECUTED	PH	PHILIP HARRIS	PROJECT DIRECTOR
3	09/11/14	WORKS AS EXECUTED	PH	PHILIP HARRIS	PROJECT DIRECTOR


LEAD CONSULTANT / LANDSCAPE ARCHITECT	CONSULTANTS	CLIENT	SCALE @ A4	PROJECT TITLE
GROUP USA pod architects interior design urban design landscape P: +61 2 9232 3137 F: +61 2 9232 3658 151 Pitt Street East Sydney NSW	CIVIL ENGINEERING, SURVEYING CONSULTING ENGINEERS TRAFFIC ENGINEERING, TRANSPORT AND TRADING PLANNING ASSOCIATES LIGHTING CONSULTANTS - LIGHTING, ART & SCIENCE CYCLE CONSULTANTS - SUSTAINABLE TRANSPORT CONSULTANTS ACCESS CONSULTANT - ACCESS POINT ACCESSIBILITY CONSULTING	EOFSYDNEY www.dial1100.com.au DIAL 1100 BEFORE YOU DIG	1:200	GEORGE STREET CYCLEWAY - PACKAGE 2A SIGNAGE & LINEMARKING PROJECT DRAWINGS: 9_05A

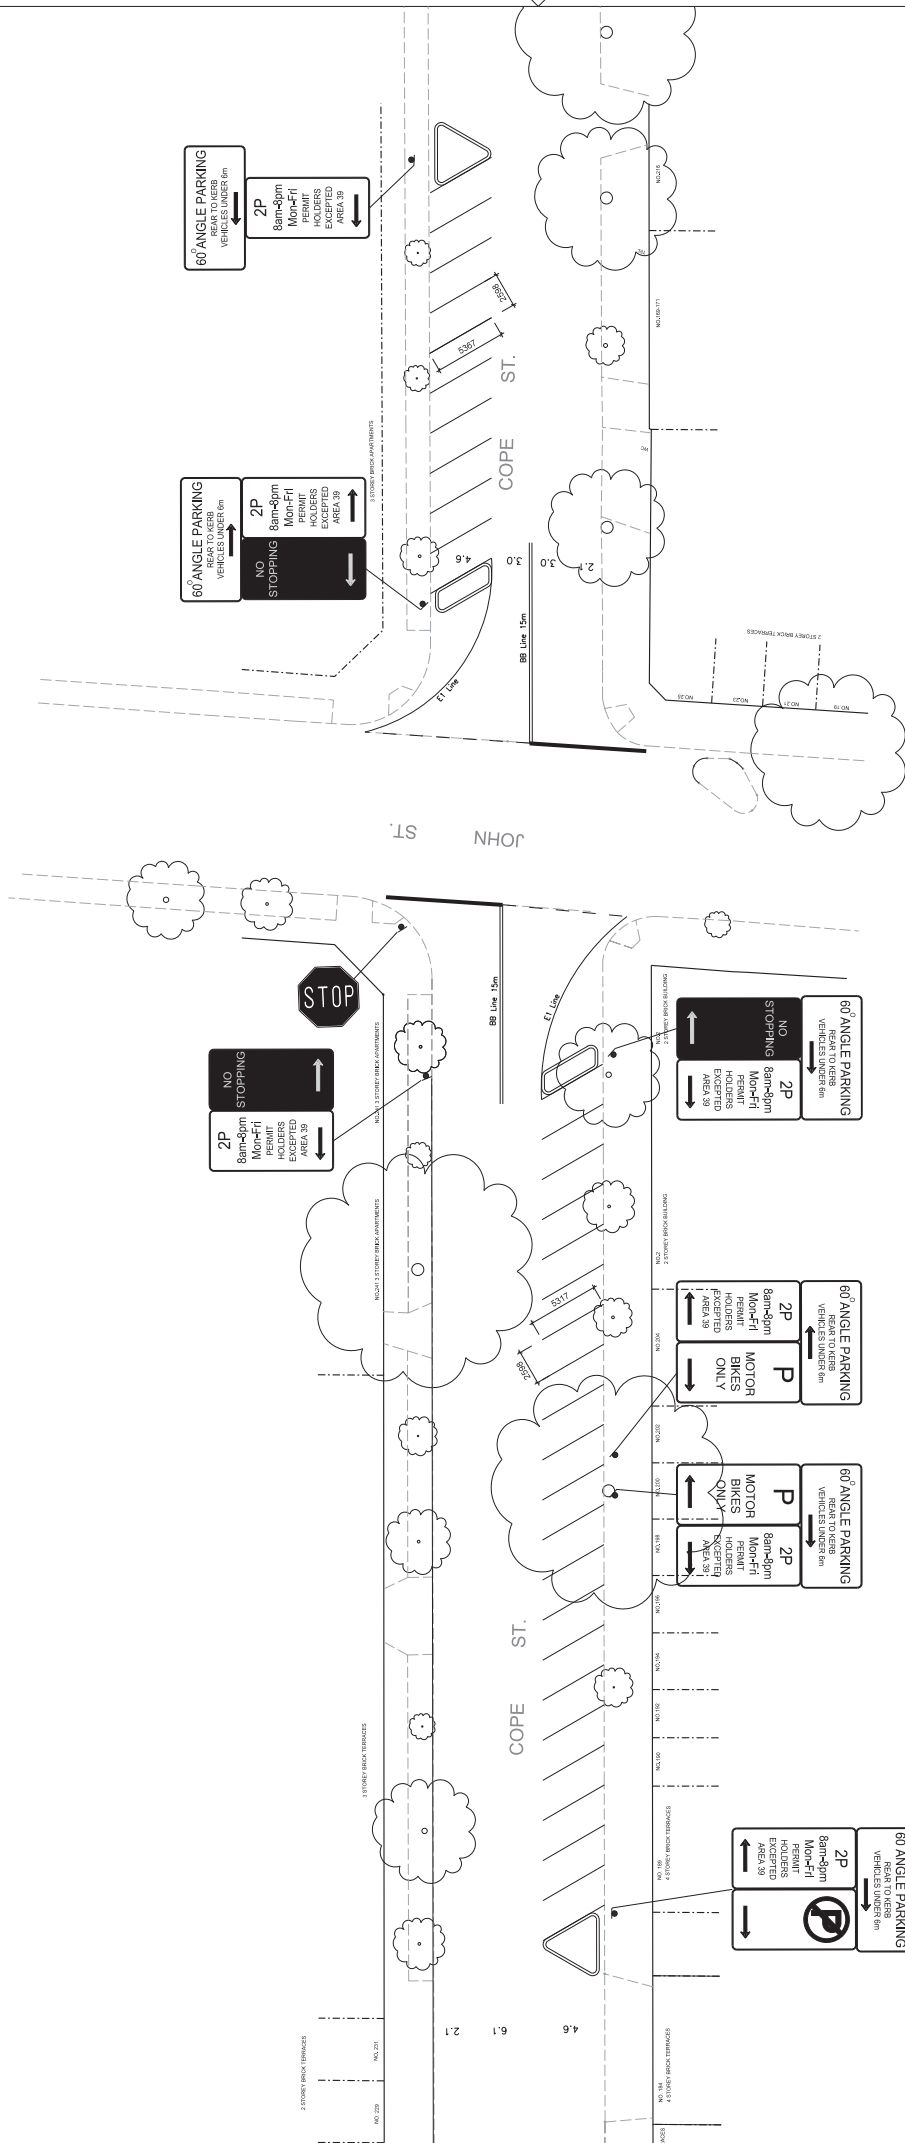

REV	DATE	AMENDMENT / REVISION / DESCRIPTION	APPROVAL	NAME	ROLE
1	31/03/13	CONSTRUCTION ISSUE	PM	DRIFTSMAN	JAB
2	26/07/14	WORKS AS EXECUTED	DR	DRAFTING CHECK	SH
3	08/11/14	WORKS AS EXECUTED	DR	DESIGNER	TPPA
				DESIGNER CHECK	SH
				PROJECT MANAGER	RS
				PROJECT DIRECTOR	RS

LEAD CONSULTANT / LANDSCAPE ARCHITECT	GROUP VSA <small>landscape architects</small>
CONSULTANTS	CIVIL ENGINEERING - ADVISORY CONSULTING ENGINEERS TRAFFIC ENGINEERING, MANAGEMENT AND TRAINING PLANNING ASSOCIATES LIGHTING CONSULTANT - LIGHTING, ART & SCIENCE CYCLE CONSULTING - SUSTAINABLE TRANSPORT CONSULTANTS ACCESS CONSULTANT - COPEL JORDAN ACCESSIBILITY CONSULTING


CLIENT	City of Sydney
SCALE	1:200
PROJECT TITLE	GEORGE STREET CYCLEWAY - PACKAGE 2A
DRAWING TITLE	SIGNAGE & LINEMARKING
DRAWING STATUS	WORKS AS EXECUTED
PROJECT DRAWINGS	9_05B
REVISION	3

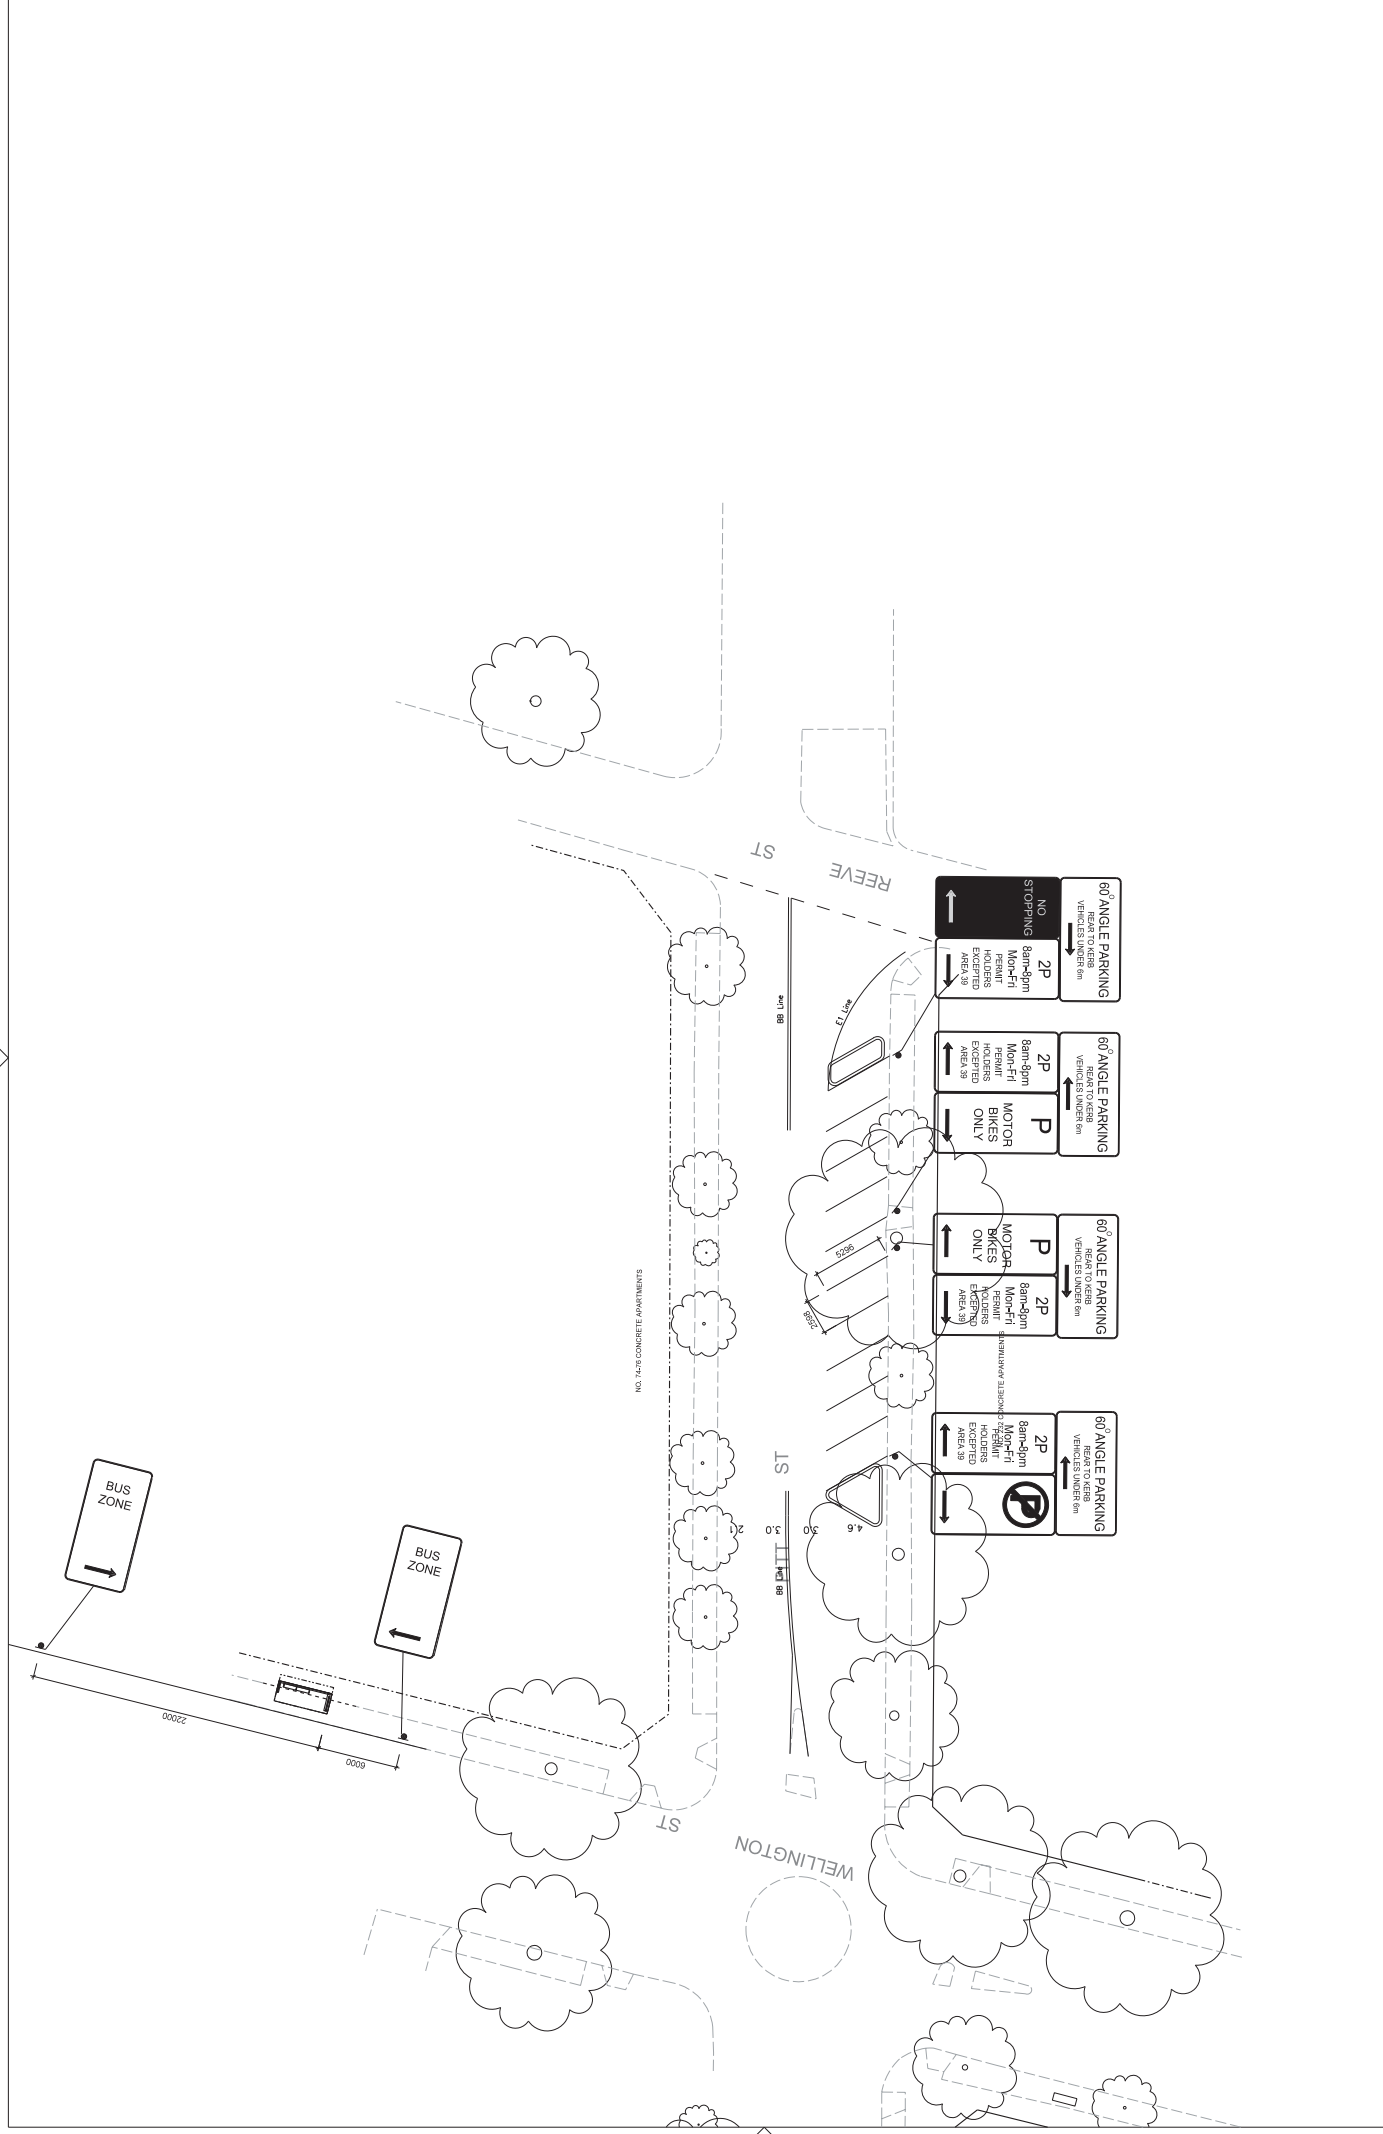

REV	DATE	AMENDMENT / REVISION / DESCRIPTION	APPROVAL	NAME	ROLE
1	31/03/13	CONSTRUCTION	SH	JAB	PROJECT DIRECTOR
2	30/03/14	WORKS AS EXECUTED	SH	SH	PROJECT DIRECTOR
3	31/03/14	WORKS AS EXECUTED	SH	SH	PROJECT DIRECTOR
4	31/03/14	WORKS AS EXECUTED	SH	SH	PROJECT DIRECTOR

LEAD CONSULTANT / LANDSCAPE ARCHITECT	CONSULTANTS	CLIENT	SCALE @ A4	PROJECT TITLE
GROUP USA www.groupusa.com.au P: +61 8 932 3137 F: +61 8 932 3668 25 Wilton Street East Sydney NSW Australia	ONI ENGINEERING - URBANSHIP CONSULTING ENGINEERS TRIPLE ENGINEERING, ENGINEERING AND TRAFFIC PLANNING ASSOCIATES URBAN CONSULTANTS - URBAN PLANNING, ART & SCIENCE CYCLE CONSULTANTS - SUSTAINABLE TRANSPORT CONSULTANTS ACCESS CONSULTANT - ACCESS URBAN ACCESSIBILITY CONSULTING	GOV OF SYDNEY www.dialbeforeyoudig.com.au DIAL 1100 BEFORE YOU DIG	1:200	GEORGE STREET CYCLEWAY - PACKAGE 2A SIGNAGE & LINEMARKING WORKS AS EXECUTED 9_05C

DATE	DESCRIPTION	BY	CHECKED	DATE	DESCRIPTION
31/03/13	CONSTRUCTION	SH	JAB	31/03/13	CONSTRUCTION
30/03/14	WORKS AS EXECUTED	SH	SH	30/03/14	WORKS AS EXECUTED
31/03/14	WORKS AS EXECUTED	SH	SH	31/03/14	WORKS AS EXECUTED

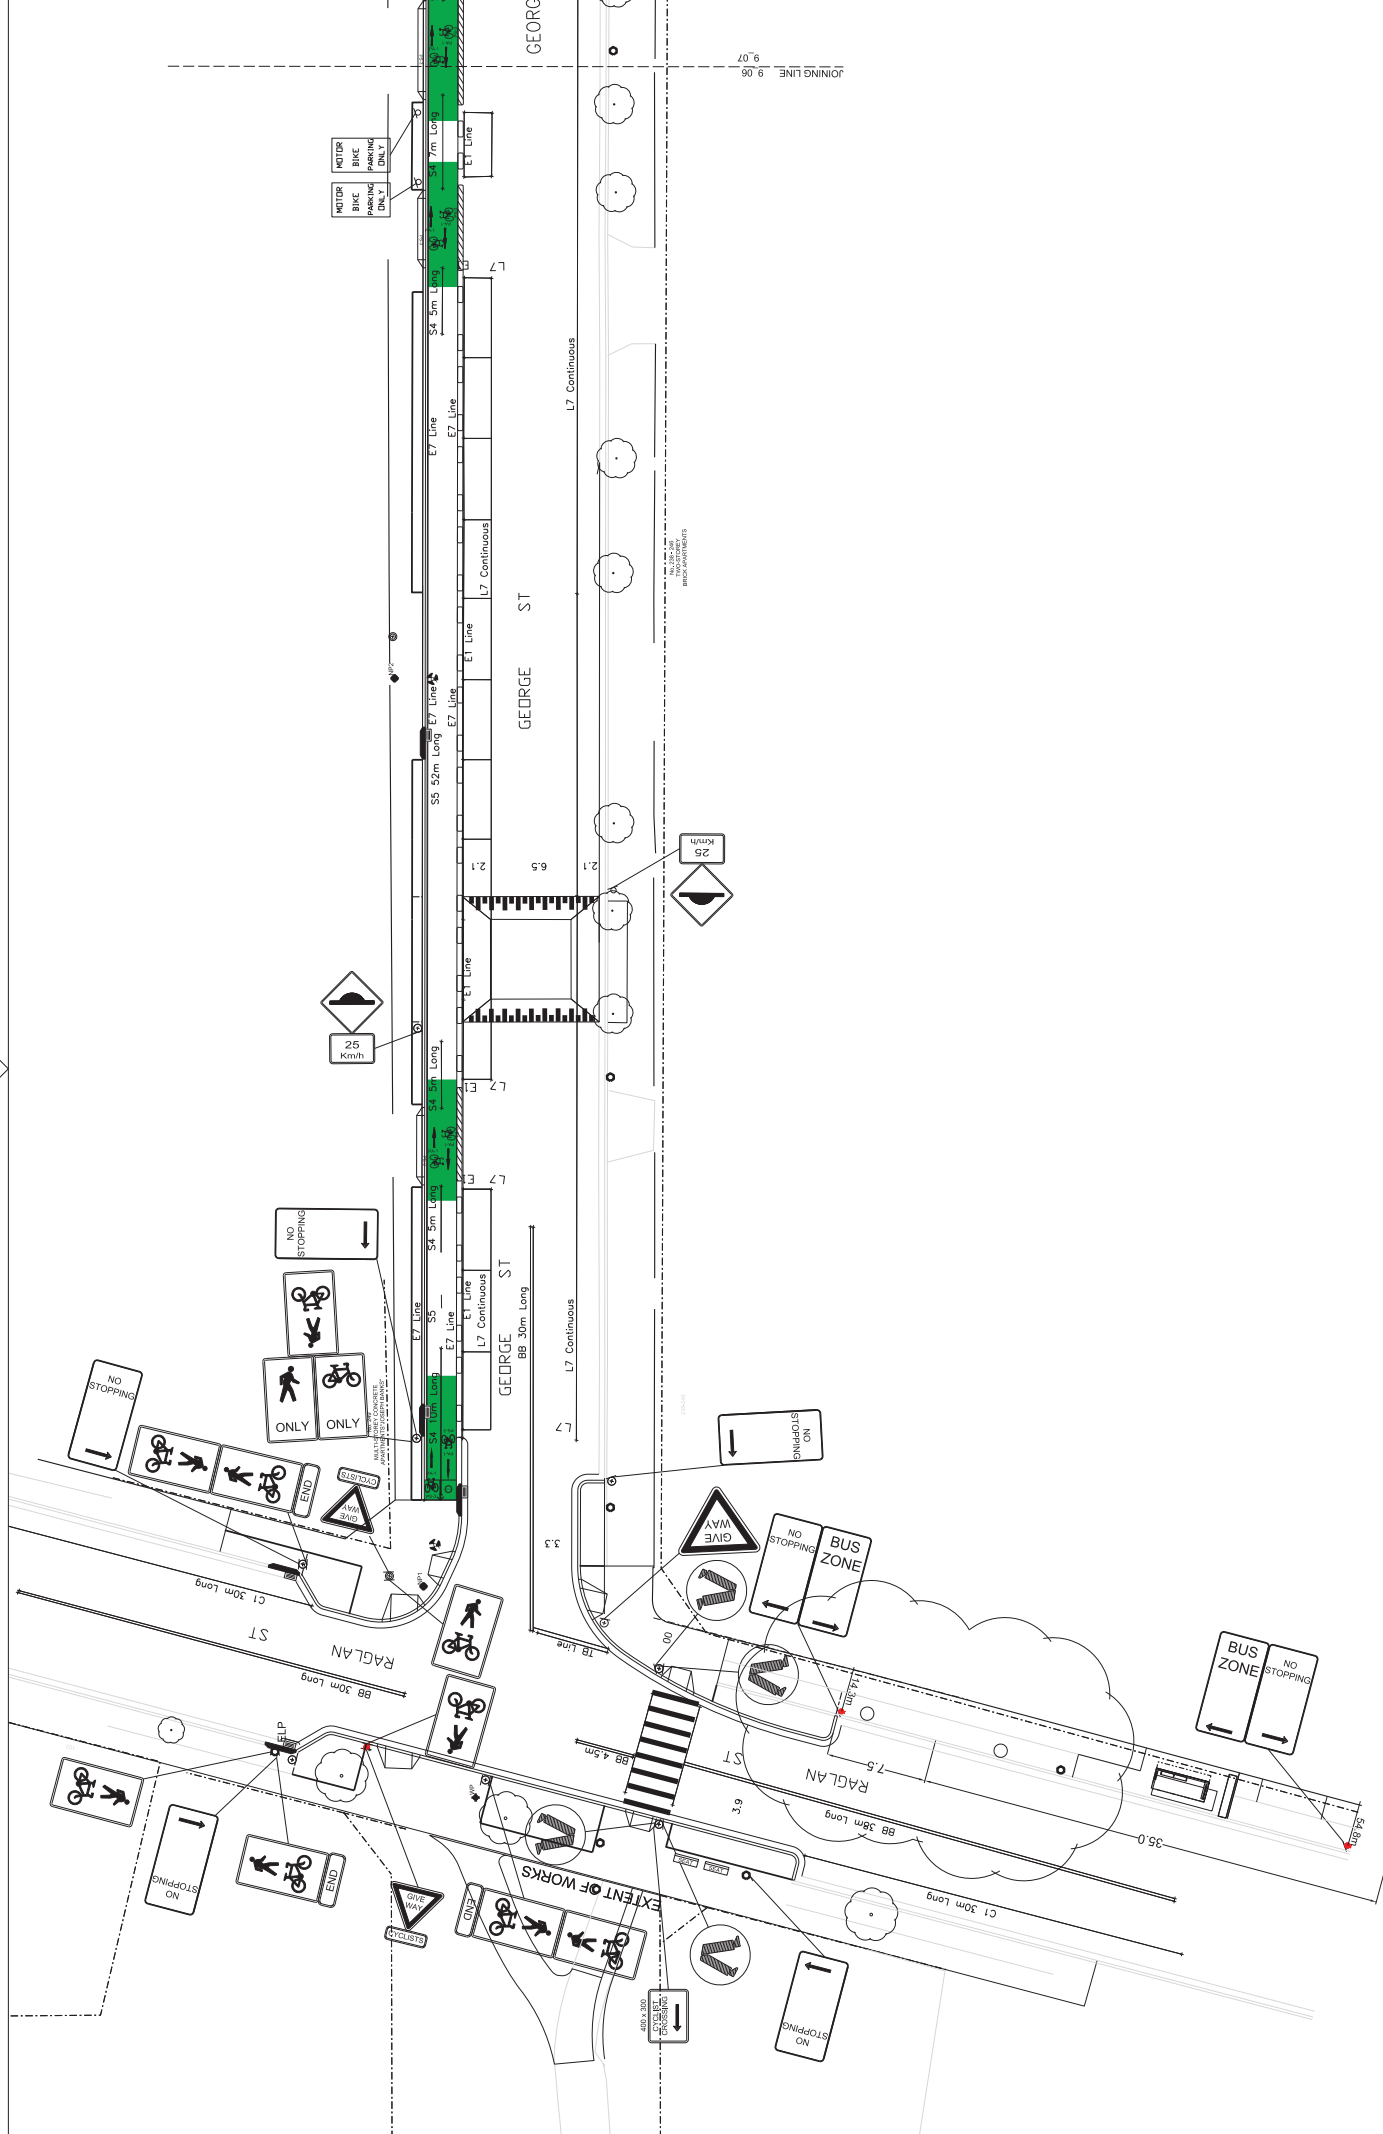



REV	DATE	AMENDMENT / REVISION DESCRIPTION	APPROVAL	NAME	ROLE
A	20/01/13	CONSTRUCTION ISSUE	HW	DRAFTSMAN	FAB
B	18/01/14	AMEND CONSTRUCTION ISSUE	HW	DRAFTING CHECK	SH
C	18/01/14	AMEND CONSTRUCTION ISSUE	HW	DESIGNER	TPA
D	23/01/14	WORKS AS EXECUTED	HW	DESIGN CHECK	SH
E	26/01/14	WORKS AS EXECUTED	HW	PROJECT MANAGER	RS
				PROJECT DIRECTOR	RS

LEAD CONSULTANT / LANDSCAPE ARCHITECT	CONSULTANTS
GROUP USA pod groupusa.com.au P: +61 8 8332 3137 F: +61 8 8332 3168 151 William Street, East Sydney NSW	CH2M HILL TRANSPORT CONSULTANTS TRANSPORT ENGINEERING, TRANSPORT AND TRAFFIC PLANNING ASSOCIATES URBAN CONSULTANTS - URBAN, ART & SCIENCE CYCLE CONSULTING - SUSTAINABLE TRANSPORT CONSULTANTS ACCESS CONSULTANT - ACCESS URBAN ACCESSIBILITY CONSULTING

CLIENT	SCALE @ A4	PROJECT TITLE
www.dialbeforeyoudig.com.au DIAL 1100 BEFORE YOU DIG	1:200	GEORGE STREET CYCLEWAY - PACKAGE 1

DRAWING TITLE	PROJECT DRAWINGS No.	REVISION
SIGNAGE & LINEMARKING		E

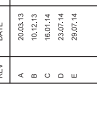

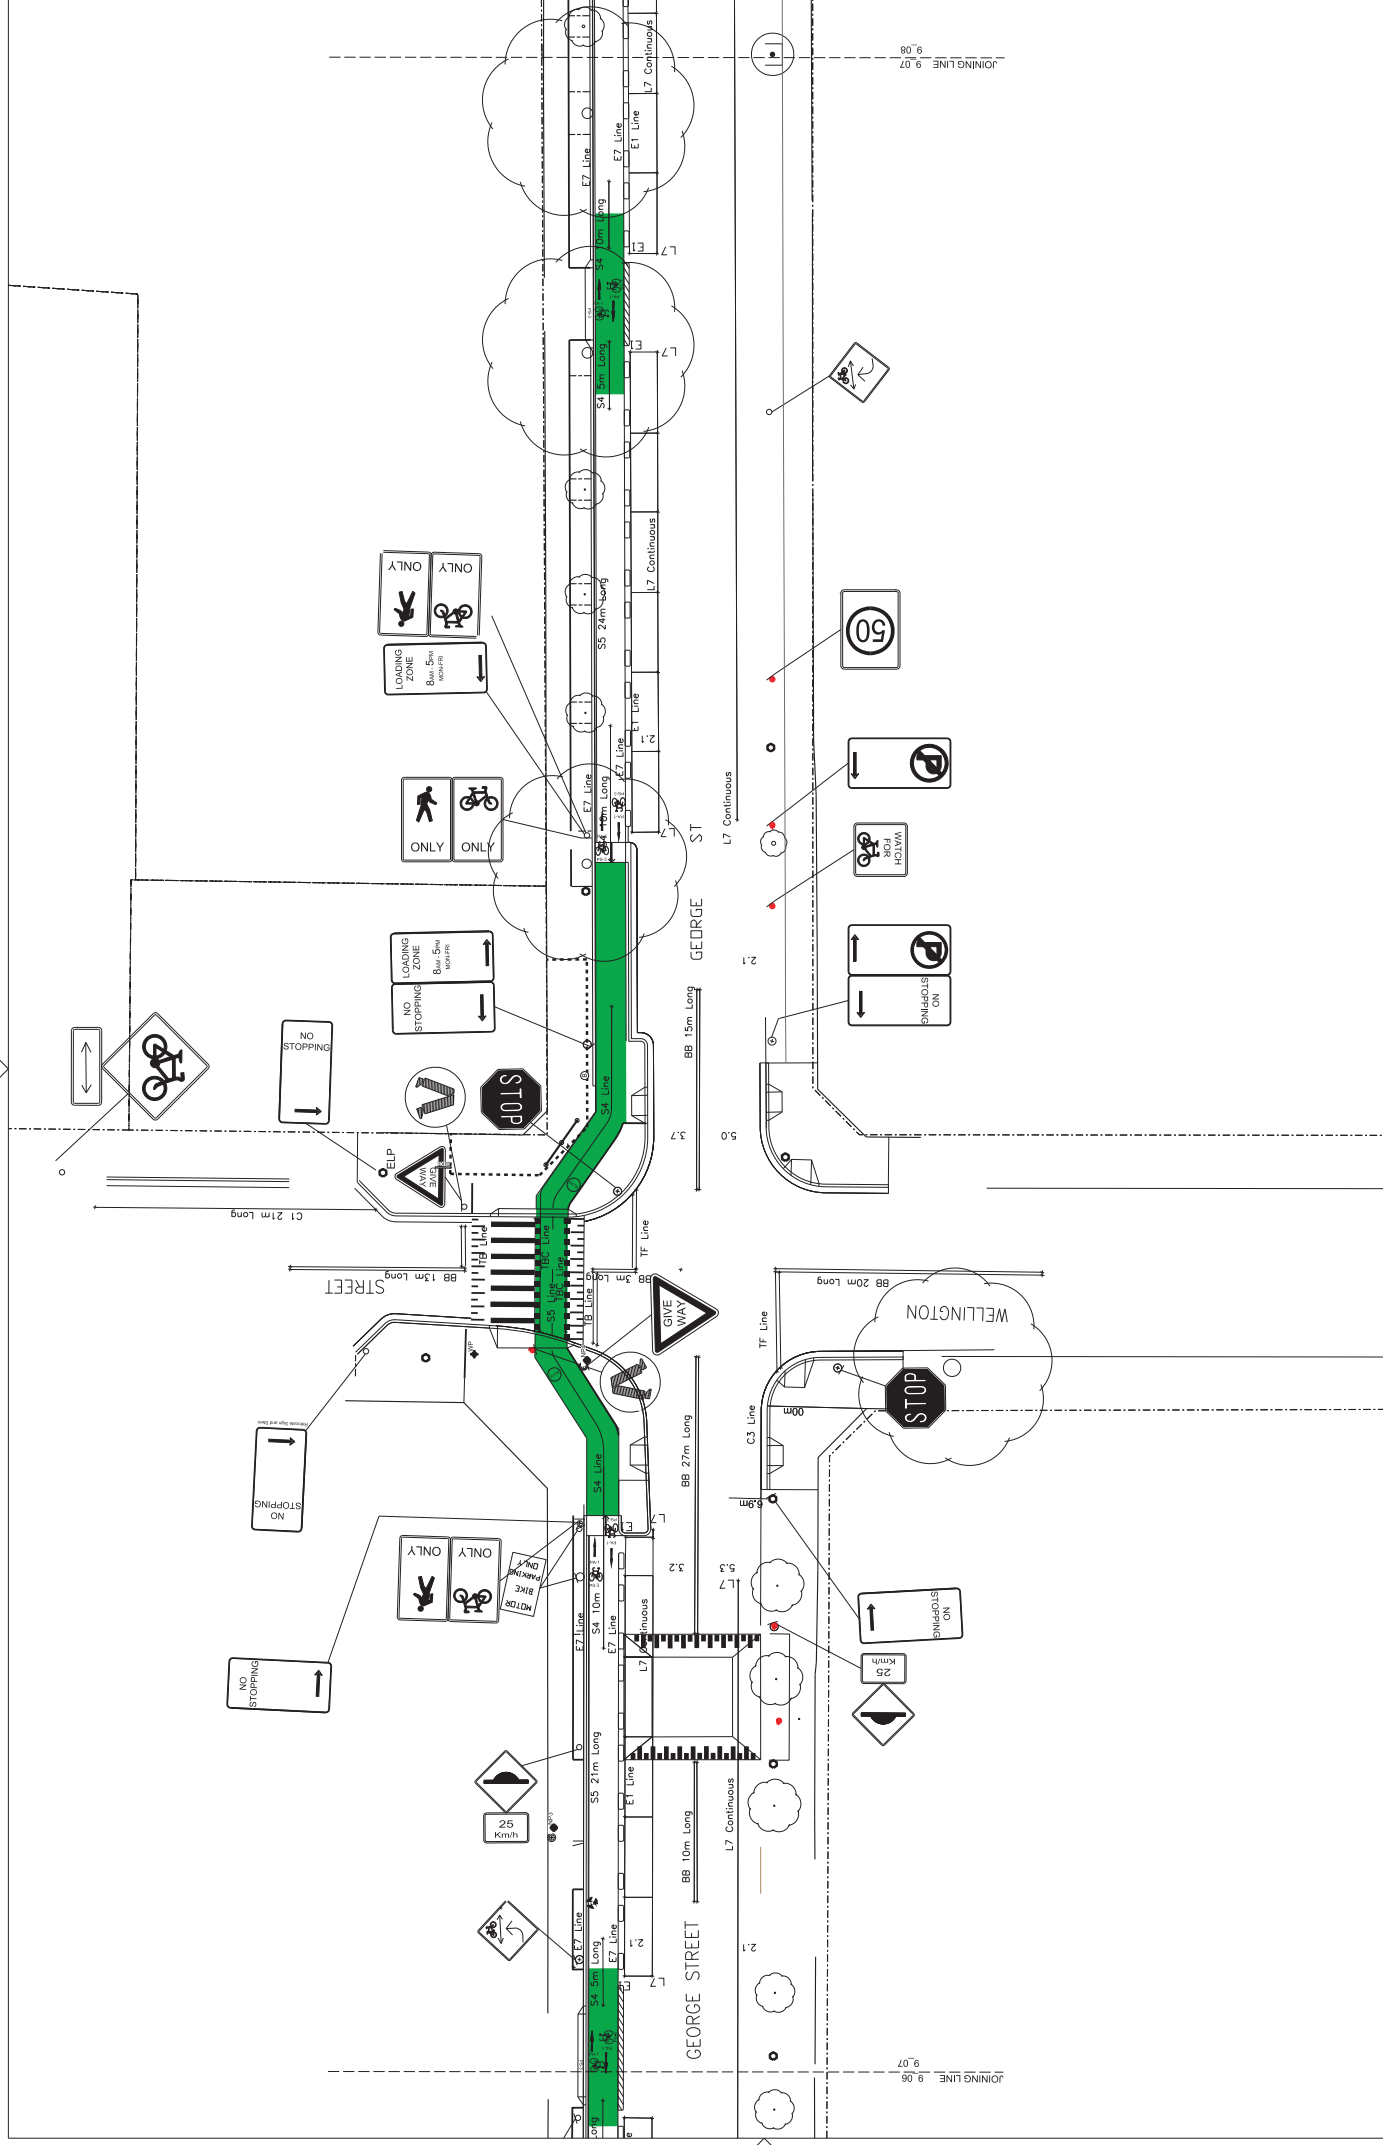


REV	DATE	AMENDMENT / REVISION DESCRIPTION	APPROVAL	NAME	ROLE
A	2023/13	CONSTRUCTION ISSUE	HW	JAB	NAME
B	23/02/24	WORKS AS EXECUTED	HW	SHI	JAB
C	23/02/24	WORKS AS EXECUTED	HW	TPA	SHI
D	24/02/24	WORKS AS EXECUTED	HW	SH	TPA

APPROVAL	NAME	ROLE
DRIFTSMAN	SHI	NAME
DRAFTING CHECK	TPA	SHI
DESIGNER	SH	TPA
DESIGN CHECK	SH	TPA
PROJECT MANAGER	RES	SH
PROJECT DIRECTOR	RES	SH

LEAD CONSULTANT / LANDSCAPE ARCHITECT	CONSULTANTS
GROUP USA pod 4/100 Pitt Street Sydney NSW P +61 2 9232 3127 F +61 2 9232 3618 www.groupusa.com.au	CHL ENGINEERING - TRANSPORT CONSULTING ENGINEERS TRAFFIC ENGINEERING, TRANSPORT AND TRADING PLANNING ASSOCIATES LIGHTING CONSULTANT - LIGHTING ART & SCIENCE CYCLE CONSULTANT - SUSTAINABLE TRANSPORT CONSULTANTS ACCESS CONSULTANT - ACCESS POINT ACCESSIBILITY CONSULTING

CLIENT	SCALE @ A1	PROJECT TITLE
	1:200	GEORGE STREET CYCLEWAY - PACKAGE 1

DRAWING TITLE	DRAWING STATUS	PROJECT DRAWINGS No.	REVISION
SIGNAGE & LINEMARKING	WORKS AS EXECUTED	9_07	D

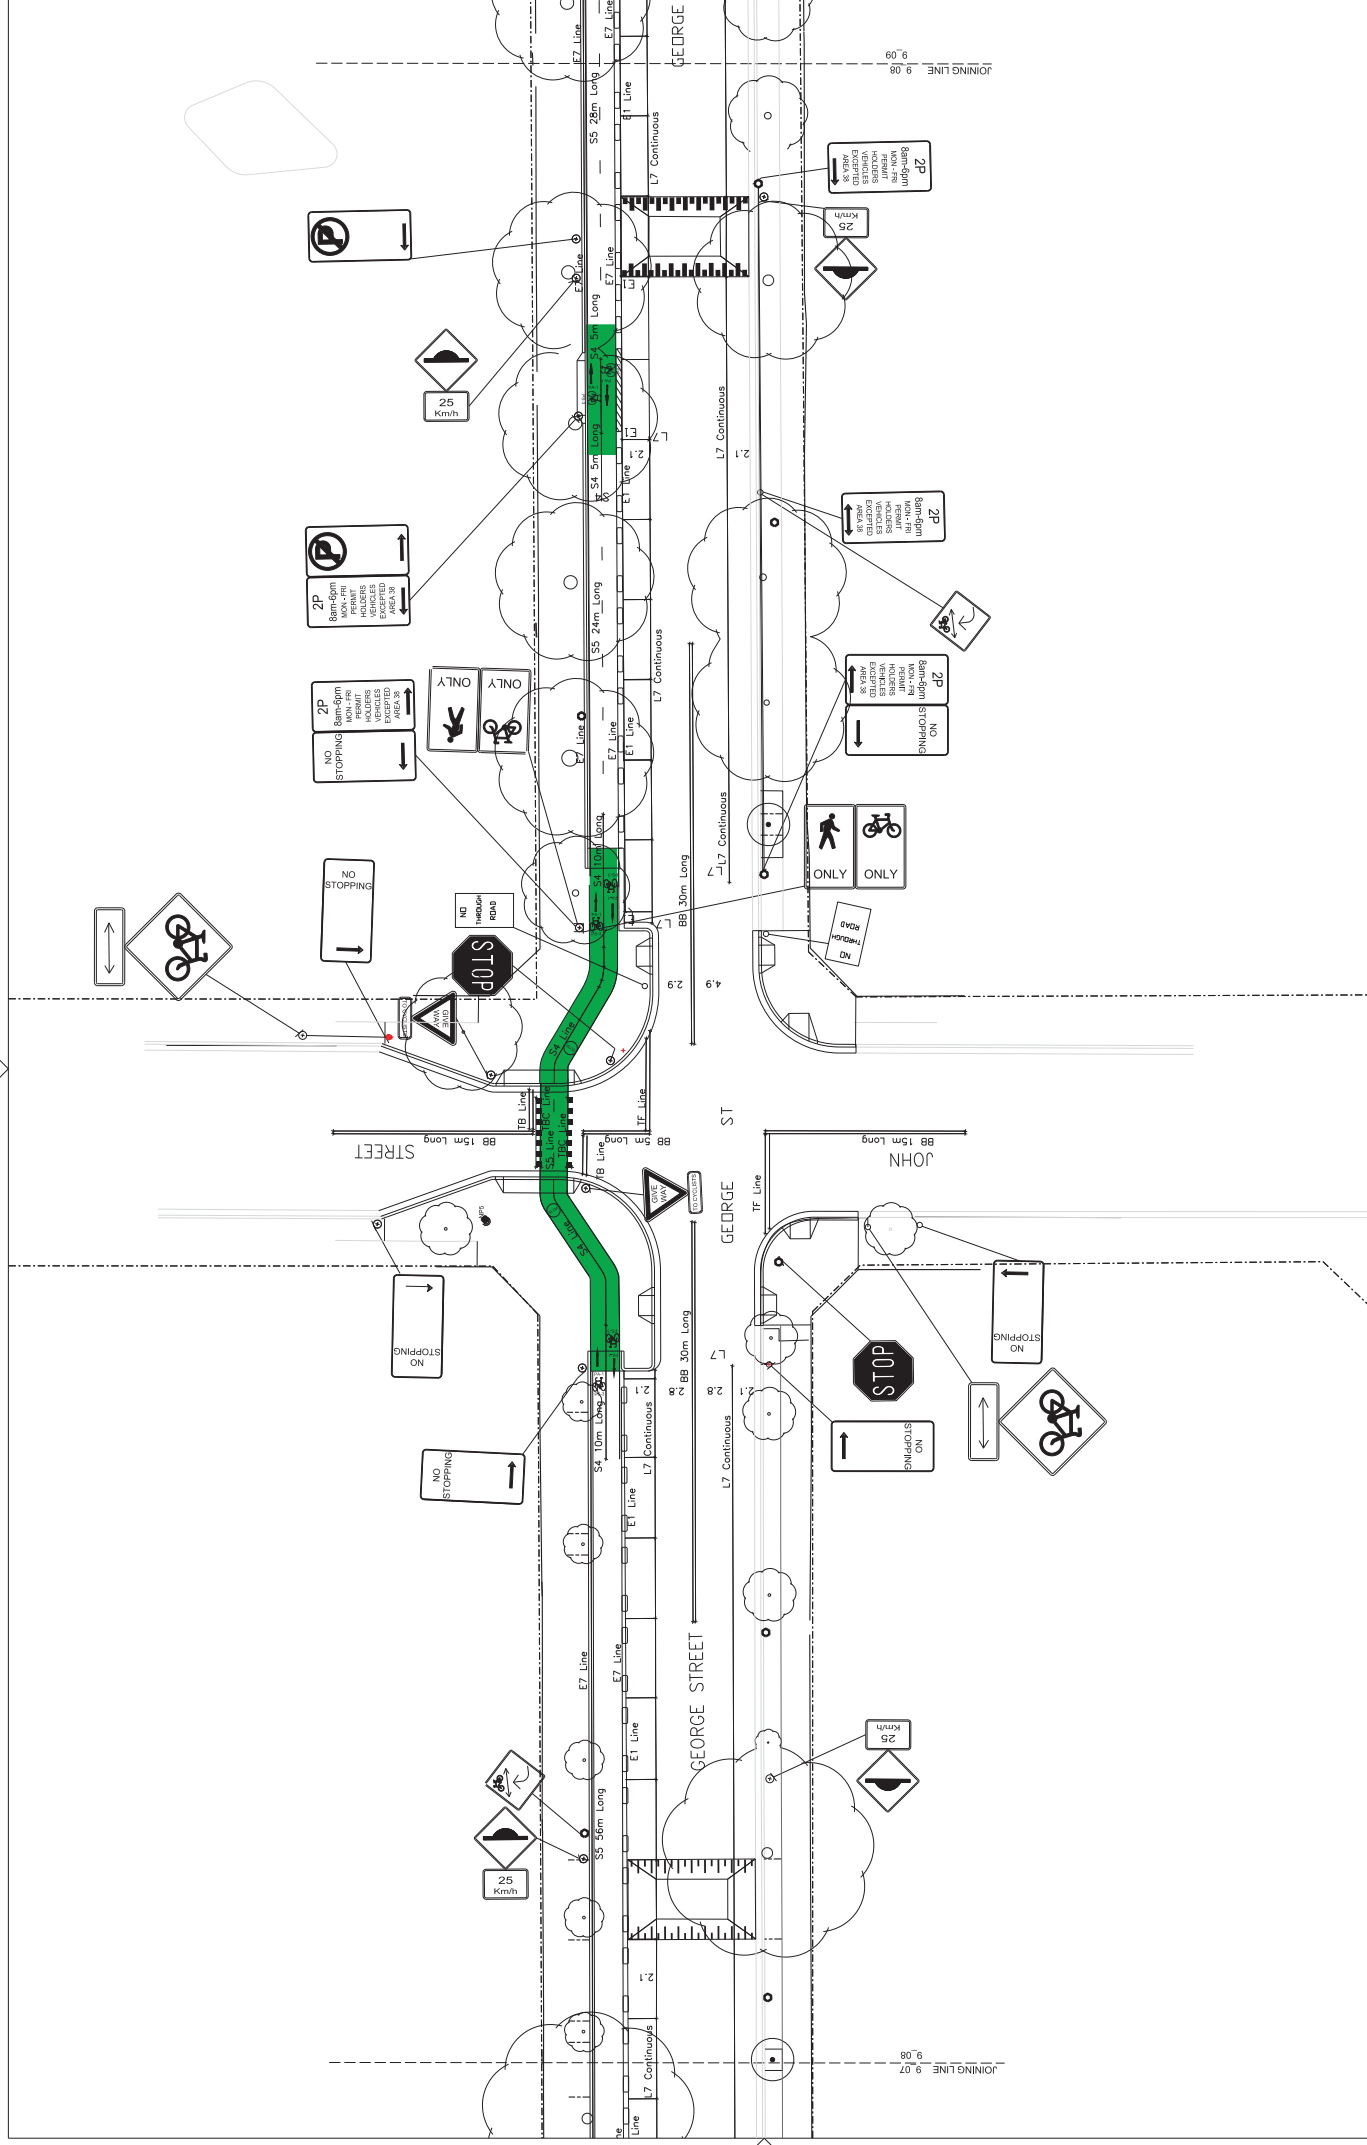

REV	DATE	REVISION / REVISION DESCRIPTION	APPROVAL	NAME	ROLE
A	20/01/13	CONSTRUCTION ISSUE	HW	NAME	NAME
B	20/01/14	WORKS AS EXECUTED	HW	NAME	NAME
C	20/01/14	WORKS AS EXECUTED	HW	NAME	NAME
D	20/01/14	WORKS AS EXECUTED	HW	NAME	NAME

LEAD CONSULTANT / LANDSCAPE ARCHITECT	CONSULTANTS	CLIENT	SCALE	PROJECT TITLE
GROUP SA pod architecture interior design urban design landscape 4/412 BROADWAY SYDNEY NSW Australia	CIVIL ENGINEERING - ADVISORY CONSULTING ENGINEERS TRAFFIC ENGINEERING, TRANSPORT AND TRAFFIC PLANNING ASSOCIATES URBAN CONSULTANTS - URBAN PLANNING, ART & SCIENCE CYCLE CONSULTING - SUSTAINABLE TRANSPORT CONSULTANTS ACCESS CONSULTANT - ACCESS URBAN ACCESSIBILITY CONSULTING	DIAL 1100 BEFORE YOU DIG www.dialbeforeyoudig.com.au	1:200 SCALE @ A4	GEORGE STREET CYCLEWAY - PACKAGE 1 SIGNAGE & LINEMARKING PROJECT DRAWINGS NO. 9_08


APPROVAL	NAME	ROLE
HW	NAME	DRAFTSMAN
HW	NAME	DRAFTING CHECK
HW	NAME	DESIGNER
HW	NAME	DESIGN CHECK
HW	NAME	PROJECT MANAGER
HW	NAME	PROJECT DIRECTOR

DATE	REVISION / REVISION DESCRIPTION	APPROVAL	NAME	ROLE
9_07	CONSTRUCTION ISSUE	HW	NAME	NAME
9_08	WORKS AS EXECUTED	HW	NAME	NAME



CIVIL ENGINEERING - ADVISORY CONSULTING ENGINEERS
 TRAFFIC ENGINEERING, TRANSPORT AND TRAFFIC PLANNING ASSOCIATES
 URBAN CONSULTANTS - URBAN PLANNING, ART & SCIENCE
 CYCLE CONSULTING - SUSTAINABLE TRANSPORT CONSULTANTS
 ACCESS CONSULTANT - ACCESS URBAN ACCESSIBILITY CONSULTING

APPROVAL	NAME	ROLE
HW	NAME	DRAFTSMAN
HW	NAME	DRAFTING CHECK
HW	NAME	DESIGNER
HW	NAME	DESIGN CHECK
HW	NAME	PROJECT MANAGER
HW	NAME	PROJECT DIRECTOR

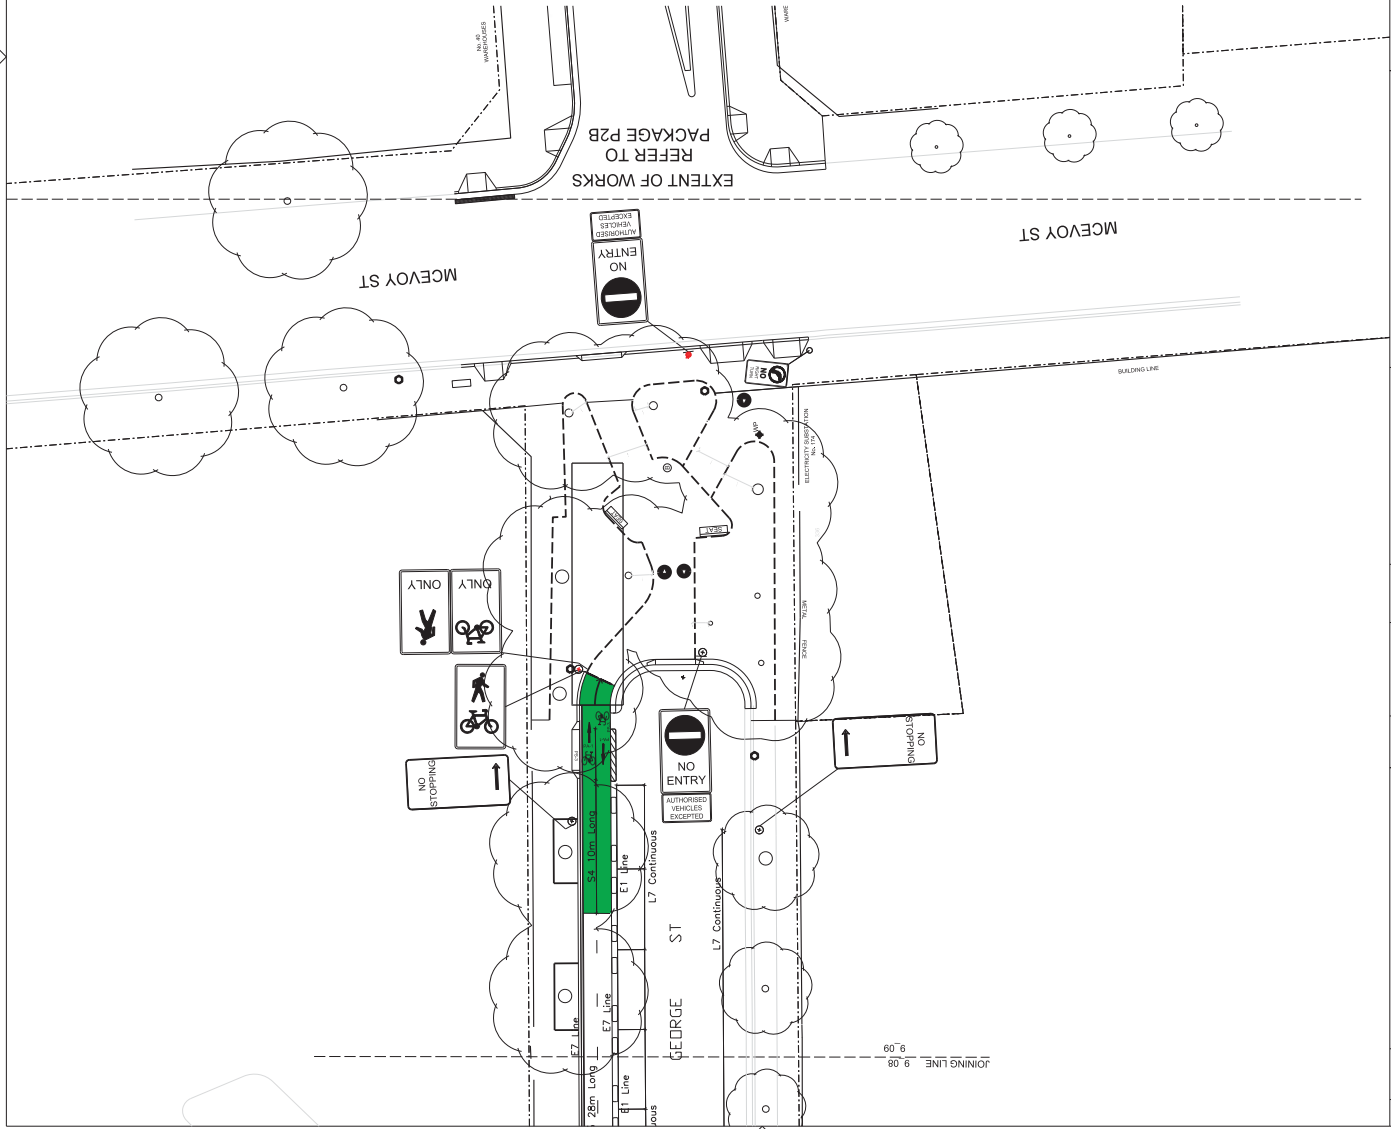


REV	DATE	AMENDMENT / REVISION / DESCRIPTION	APPROVAL	NAME	ROLE
A	2023.13	CONSTRUCTION	REV	FAB	NAME
B	2023.14	WORKS AS EXECUTED	FOR	SH	DRAFTSMAN
C	2023.14	WORKS AS EXECUTED	FOR	TTPA	DRAFTING CHECK
				SH	DESIGNER
				SH	DESIGN CHECK
				RS	PROJECT MANAGER
				RS	PROJECT DIRECTOR


CONSULTANTS	LEAD CONSULTANT / LANDSCAPE ARCHITECT
CHIL ENGINEERING - URBANSHIP CONSULTING ENGINEERS TRAFFIC ENGINEERING, TRANSPORT AND TRADING PLANNING ASSOCIATES URBAN CONSULTANTS - URBAN PLANNING, ART & SCIENCE CYCLE CONSULTANTS - SUSTAINABLE TRANSPORT CONSULTANTS ACCESS CONSULTANT - ACCESS URBAN ACCESSIBILITY CONSULTING	GROUP USA pod architecture interior design urban design landscape P: +61 2 8322 3137 F: +61 2 8322 2668 101 William Street East Sydney NSW

CLIENT	SCALE @ A1	PROJECT TITLE
	1:200	GEORGE STREET CYCLEWAY - PACKAGE 1

DRAWING TITLE	DRAWING STATUS	PROJECT DRAWING NO.	REVISION
SIGNAGE & LINEMARKING	WORKS AS EXECUTED	9_09	C

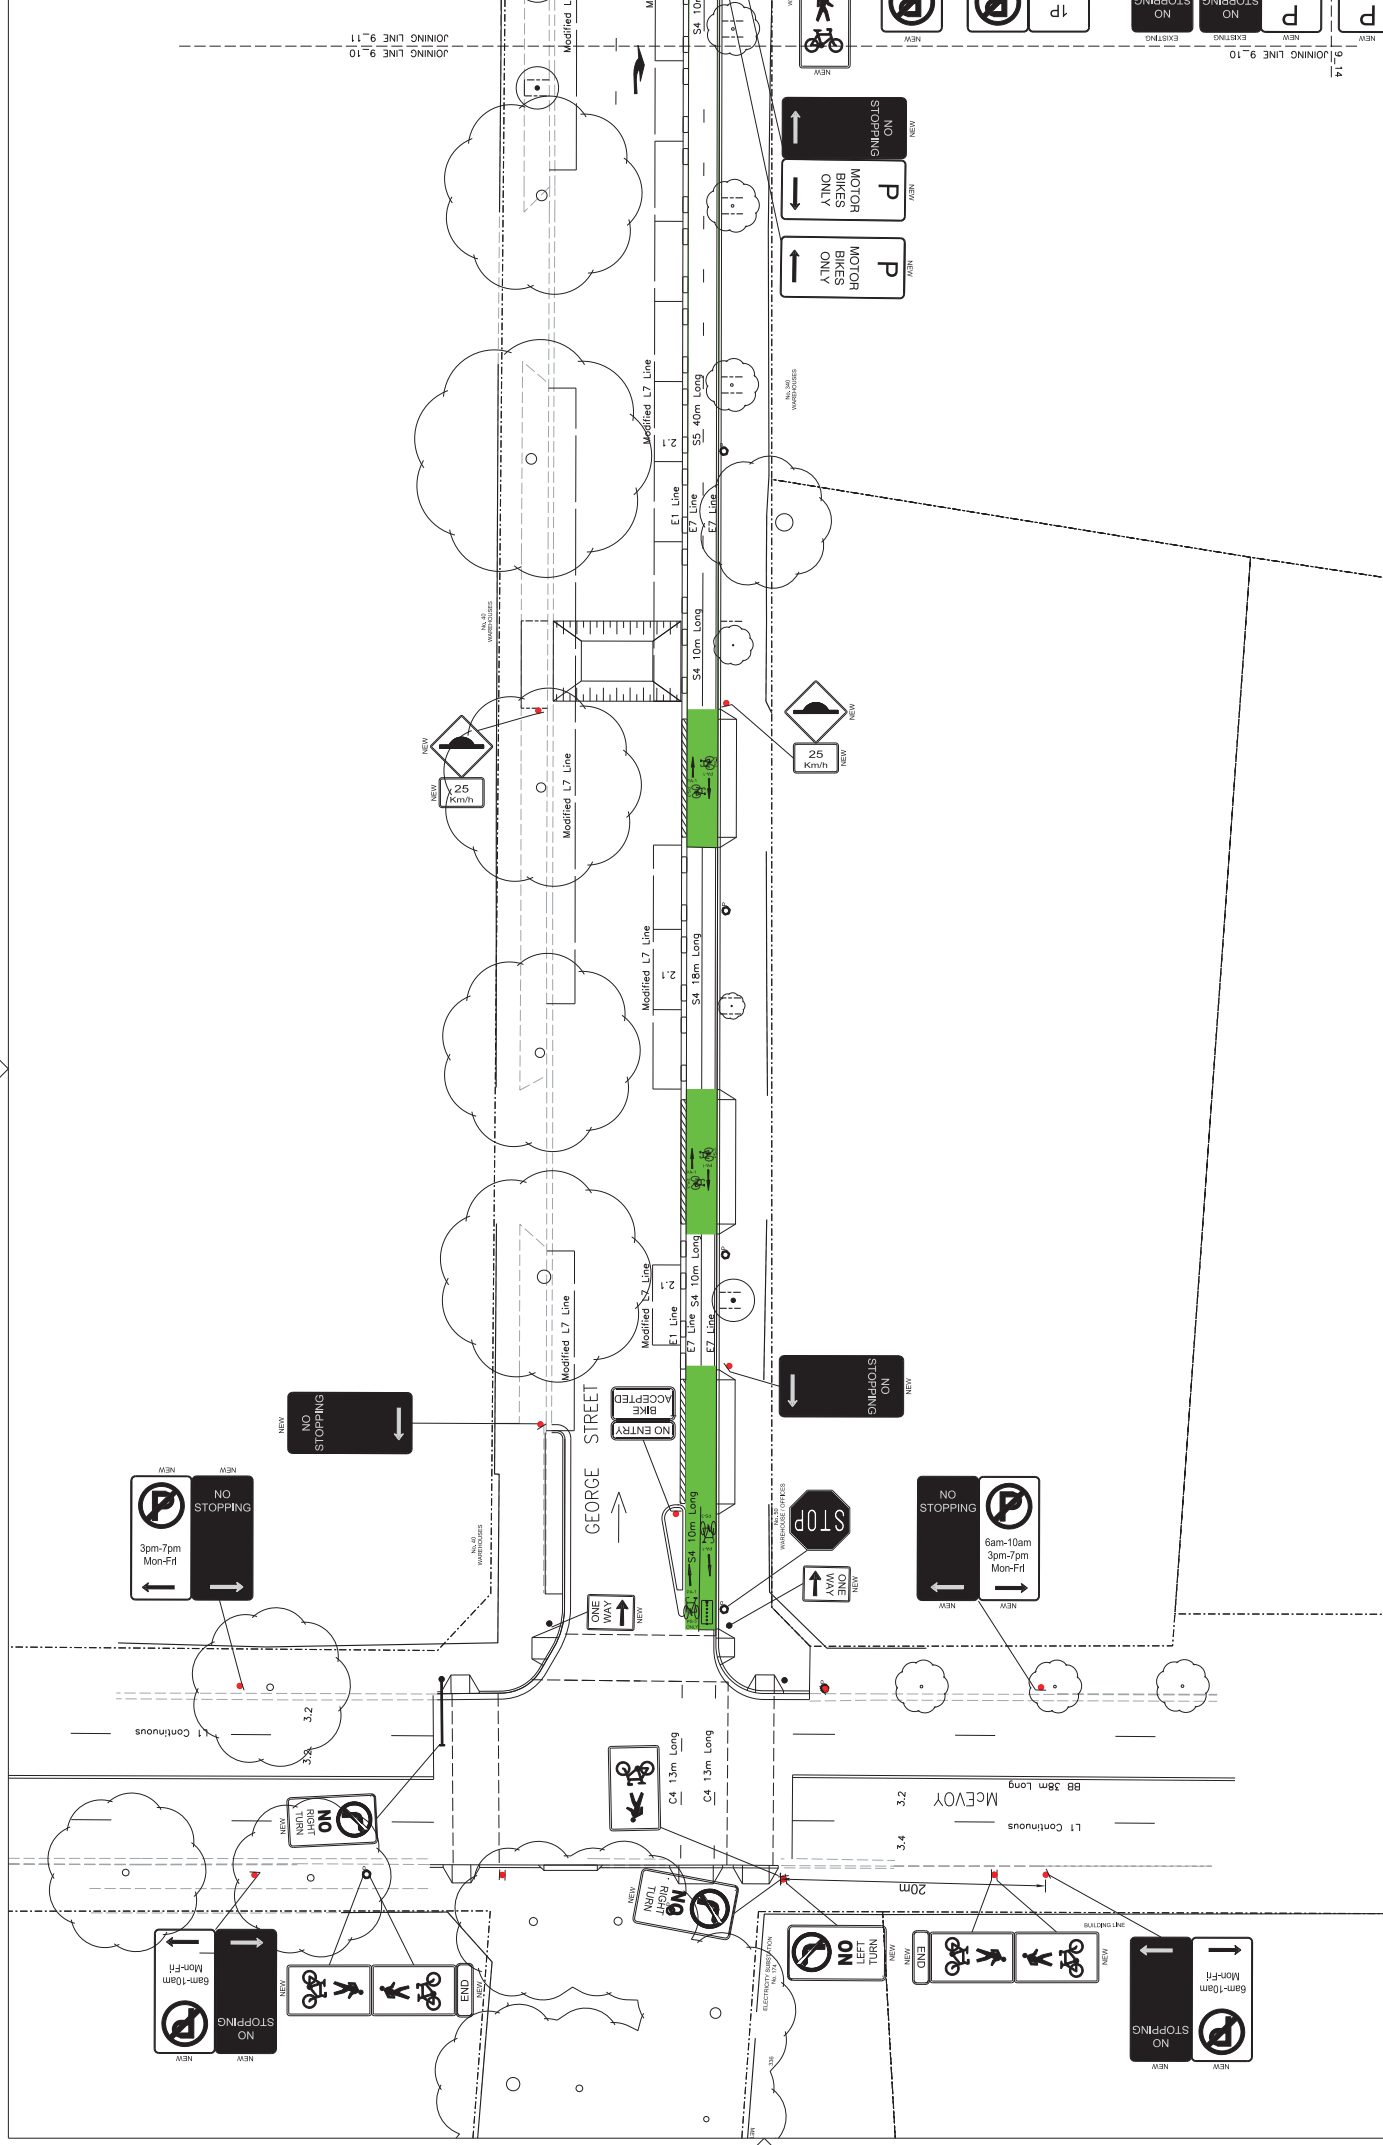

REV	DATE	DESCRIPTION	APPROVAL	NAME	ROLE	LEAD CONSULTANT / LANDSCAPE ARCHITECT	CONSULTANTS	CLIENT	SCALE	PROJECT TITLE
A	06/01/13	CONSTRUCTION	DRIFTSMAN	FAB	GROUP SA pod	ONLINE ENGINEERING, ARCHITECTURE CONSULTING ENGINEERS	SCALE: A4 1:200	GEORGE STREET CYCLEWAY - PACKAGE 2B		
B	01/01/13	AMEND CONSTRUCTION	DRAFTING CHECK	SH	www.dialbeforeyoudig.com.au	TRAFFIC ENGINEERING, TRANSPORT AND TRAFFIC PLANNING ASSOCIATES				
C	01/01/13	AMEND CONSTRUCTION	DESIGNER	TPA	DIAL 1100 BEFORE YOU DIG	LANDSCAPE CONSULTANTS, PLANNING, ART & SCIENCE				
D	24/01/14	WORKS AS EXECUTED	DESIGN CHECK	SH	www.dialbeforeyoudig.com.au	CYCLE CONSULTANTS, SUSTAINABLE TRANSPORT CONSULTANTS				
			PROJECT MANAGER	SH	www.dialbeforeyoudig.com.au	ACCESS CONSULTANTS, URBAN ACCESSIBILITY CONSULTANTS				
			PROJECT DIRECTOR	SH	www.dialbeforeyoudig.com.au					

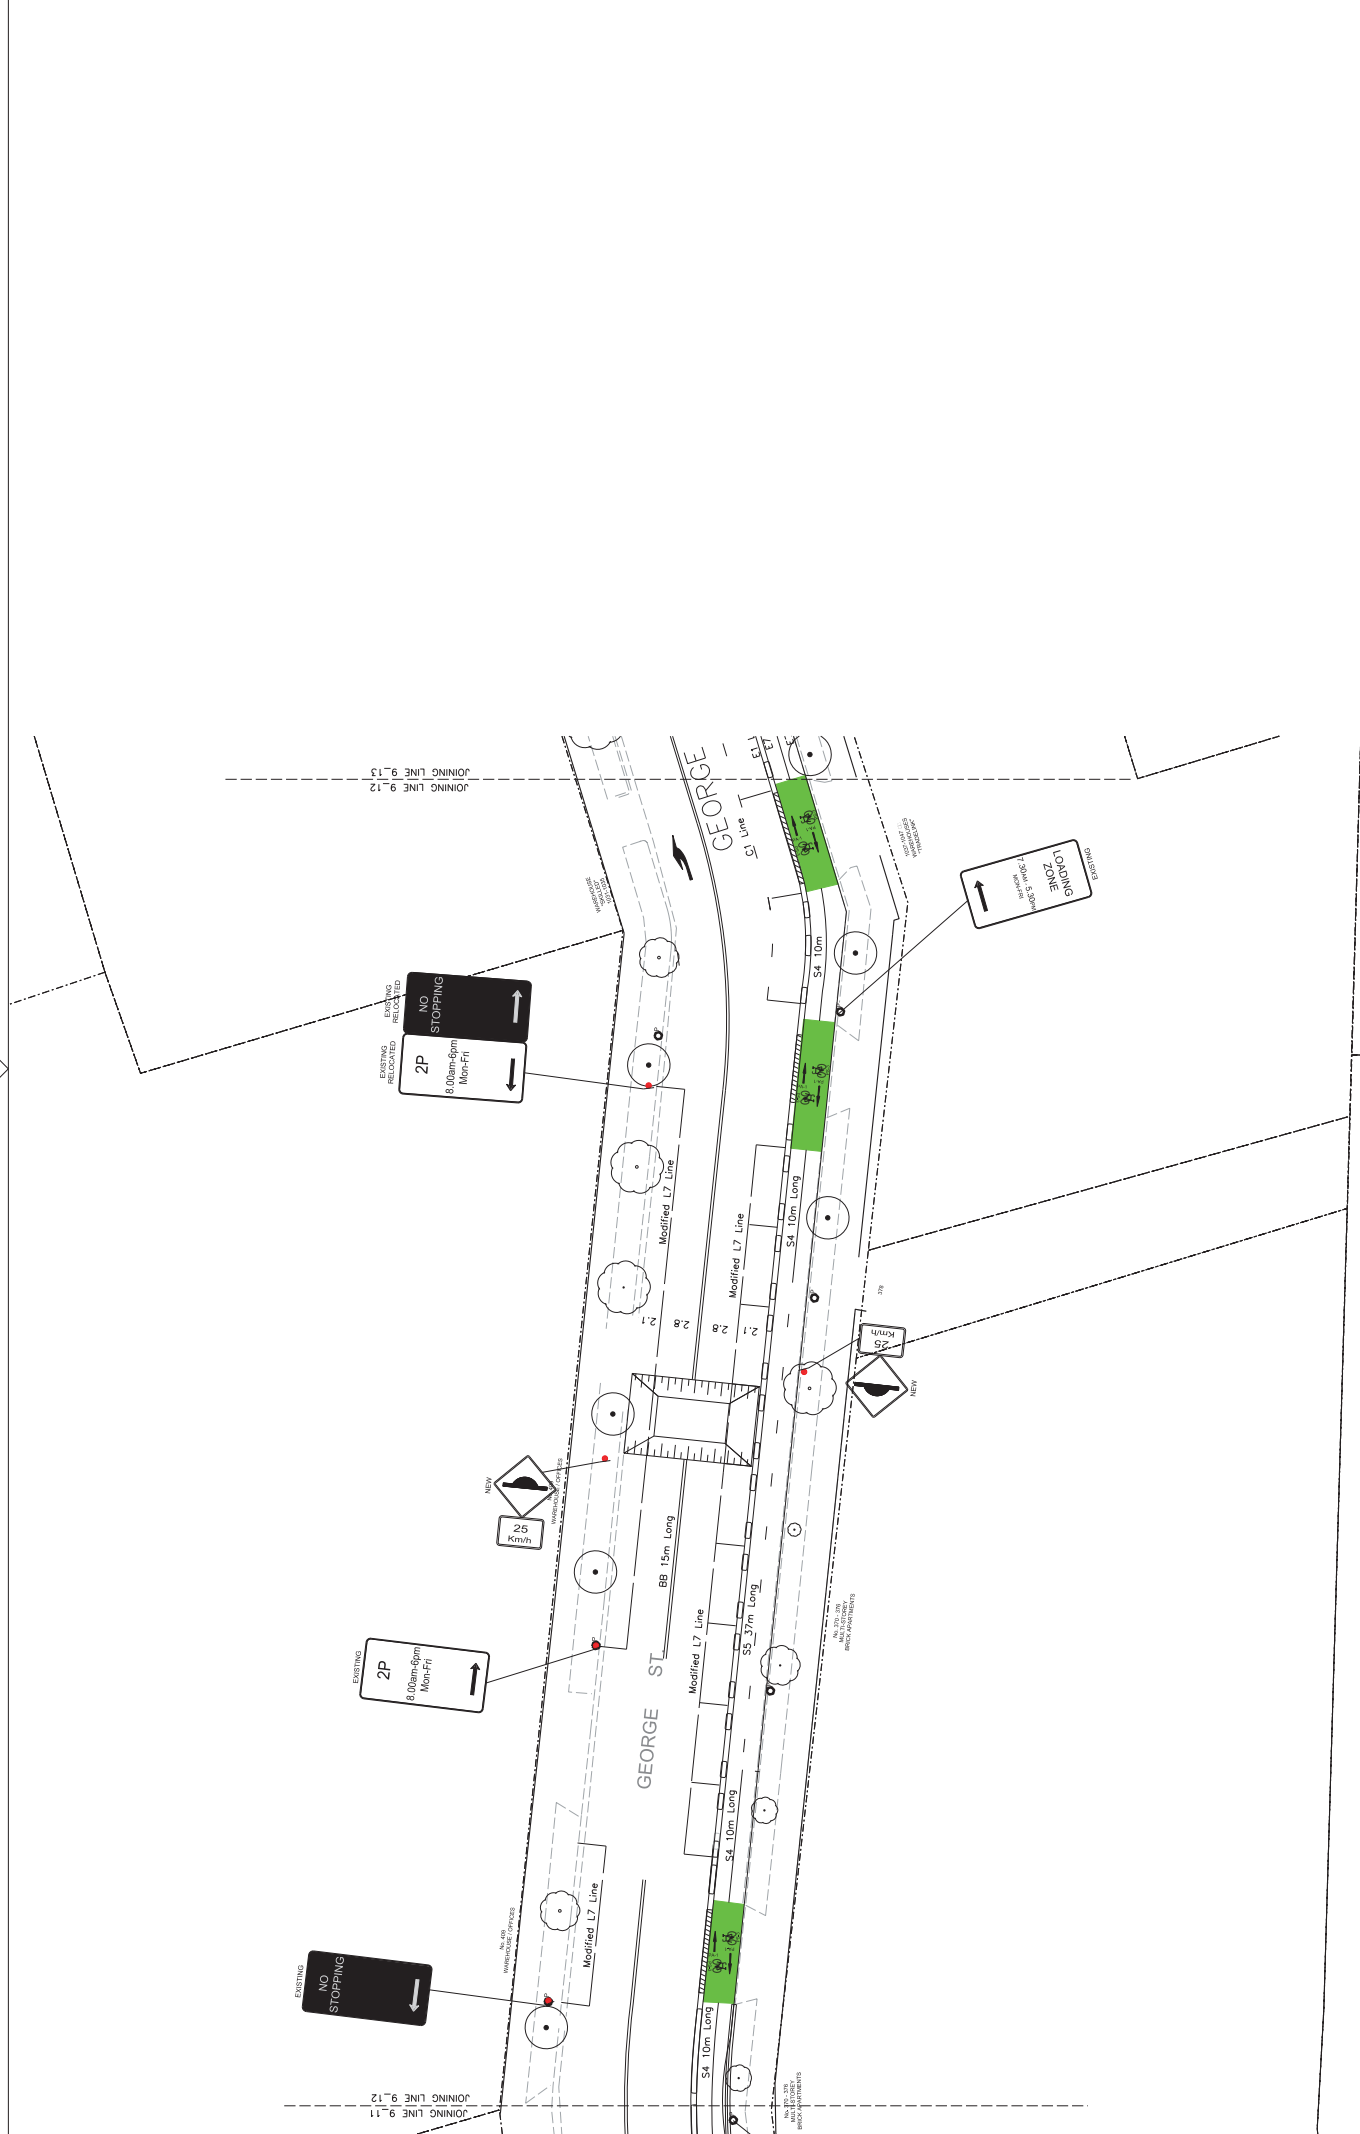


REV	DATE	AMENDMENT / REVISION DESCRIPTION	APPROVAL	NAME	ROLE	CONSULTANTS	CLIENT	SCALE @ A1	PROJECT TITLE
A	06/04/13	CONSTRUCTION ISSUE	PH	DRAFTSMAN	FAB	CIVIL ENGINEERING - ARCHITECTURE CONSULTING ENGINEERS TRAFFIC ENGINEERING, TRANSPORT AND TRADING ASSOCIATES URBAN CONSULTANTS - URBANING, ART & SCIENCE CYCLE CONSULTANTS - SUSTAINABLE TRANSPORT CONSULTANTS ACCESS CONSULTANTS - ACCESS URBAN ACCESSIBILITY CONSULTING	 www.dialbeforeyoudig.com.au	1:200	GEORGE STREET CYCLEWAY - PACKAGE 2B
B	07/04/13	WORKS CONSTRUCTION ISSUE	PH	DRAFTING CHECK	SH				
C	08/04/13	WORKS AS EXECUTED	PH	DESIGNER	TTPA				
			PH	DESIGN CHECK	SH				
			PH	PROJECT MANAGER	RS				
			PH	PROJECT DIRECTOR	RS				



GROUP USA pod
 architecture
 interior design
 project design
 landscape
 P: +61 2 9202 2127
 F: +61 2 9202 2608
 151 William Street
 East Sydney NSW

PROJECT TITLE	SCALE @ A1	PROJECT DRAWINGS NO.	REVISION
GEORGE STREET CYCLEWAY - PACKAGE 2B	1:200		C
SIGNAGE & LINEMARKING			
WORKS AS EXECUTED			

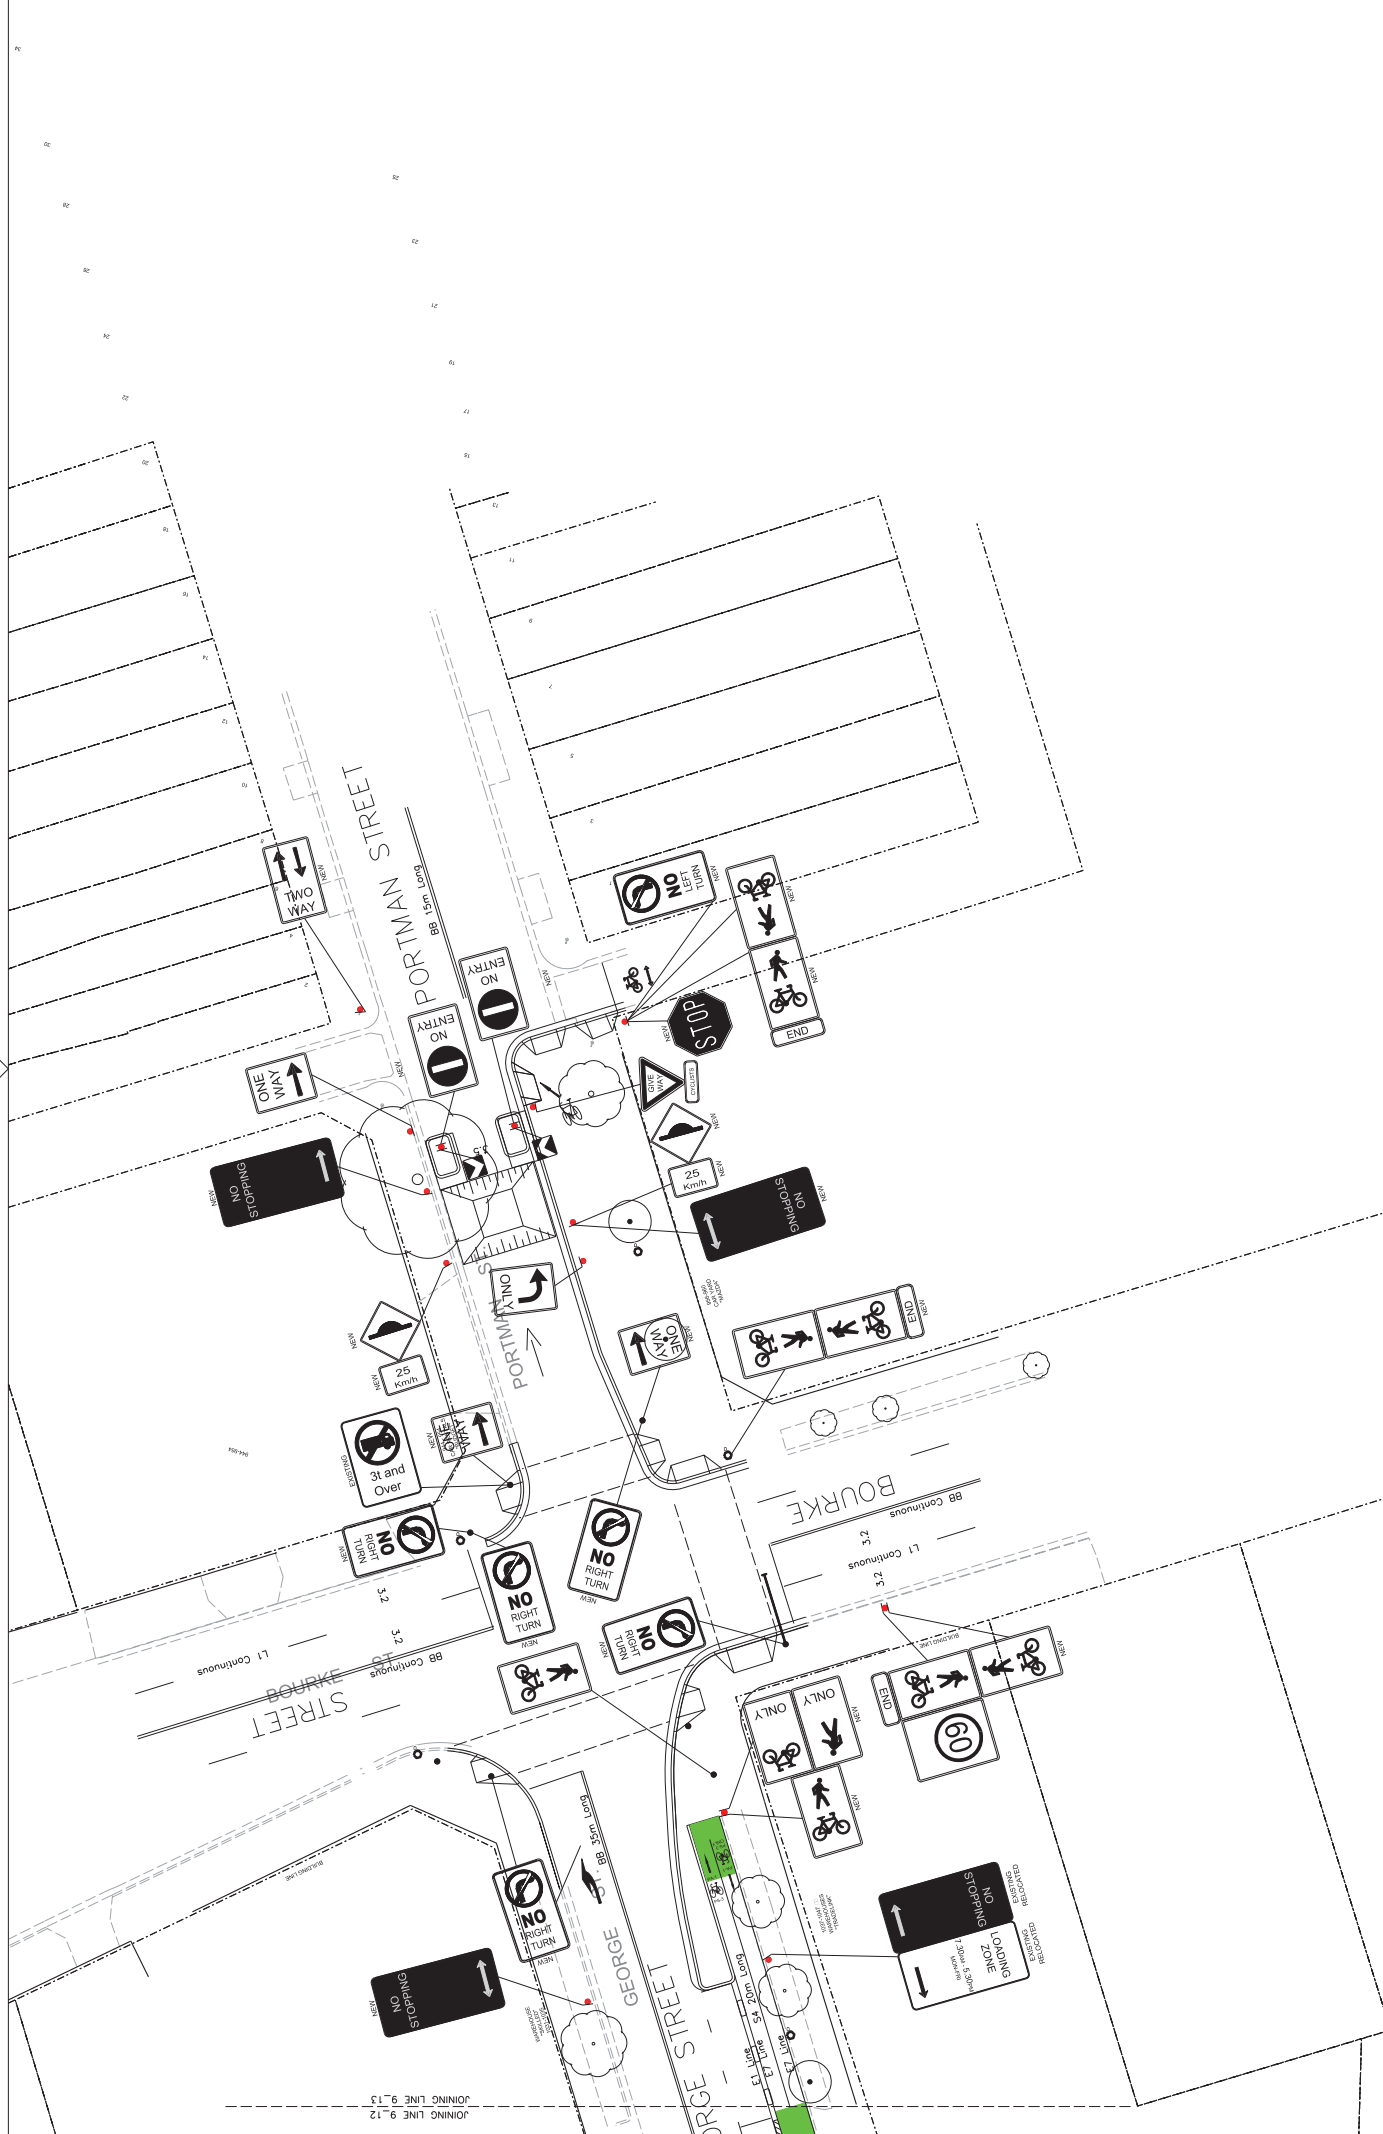

JOINING LINE 9.12
JOINING LINE 9.13


REV	DATE	REVISION / REVISION DESCRIPTION	APPROVAL	NAME	ROLE
A	06/01/13	CONSTRUCTION ISSUE	PH	DRAFTSMAN	FAB
B	07/01/13	REVISED CONSTRUCTION ISSUE	PH	DRAFTING CHECK	SH
C	08/01/13	WORKS AS EXECUTED	PH	DESIGNER	TTPA
				DESIGN CHECK	SH
				PROJECT MANAGER	RS
				PROJECT DIRECTOR	FAC

LEAD CONSULTANT / LANDSCAPE ARCHITECT	CONSULTANTS
GROUP USA pod architecture interior design urban design landscape 4/403 BROADWAY SYDNEY NSW 2009	CHIL ENGINEERING - STRUCTURAL CONSULTING ENGINEERS TRIPLE ENGINEERING - STRUCTURE AND TRAFFIC PLANNING ASSOCIATES LIGHTING CONSULTANTS - LIGHTING, ART & SCIENCE CYCLE CONSULTANTS - SUSTAINABLE TRANSPORT CONSULTANTS ACCESS CONSULTANT - ACCESS DESIGN ACCESSIBILITY CONSULTANTS

CLIENT	SCALE @ A4
 www.dialbeforeyoudig.com.au DIAL 1100 BEFORE YOU DIG	1:200

PROJECT TITLE	PROJECT DRAWINGS NO.
GEORGE STREET CYCLEWAY - PACKAGE 2B	

DRAWING TITLE	DRAWING STATUS	PROJECT DRAWINGS NO.	REVISION
SIGNAGE & LINEMARKING	WORKS AS EXECUTED	9_13	C

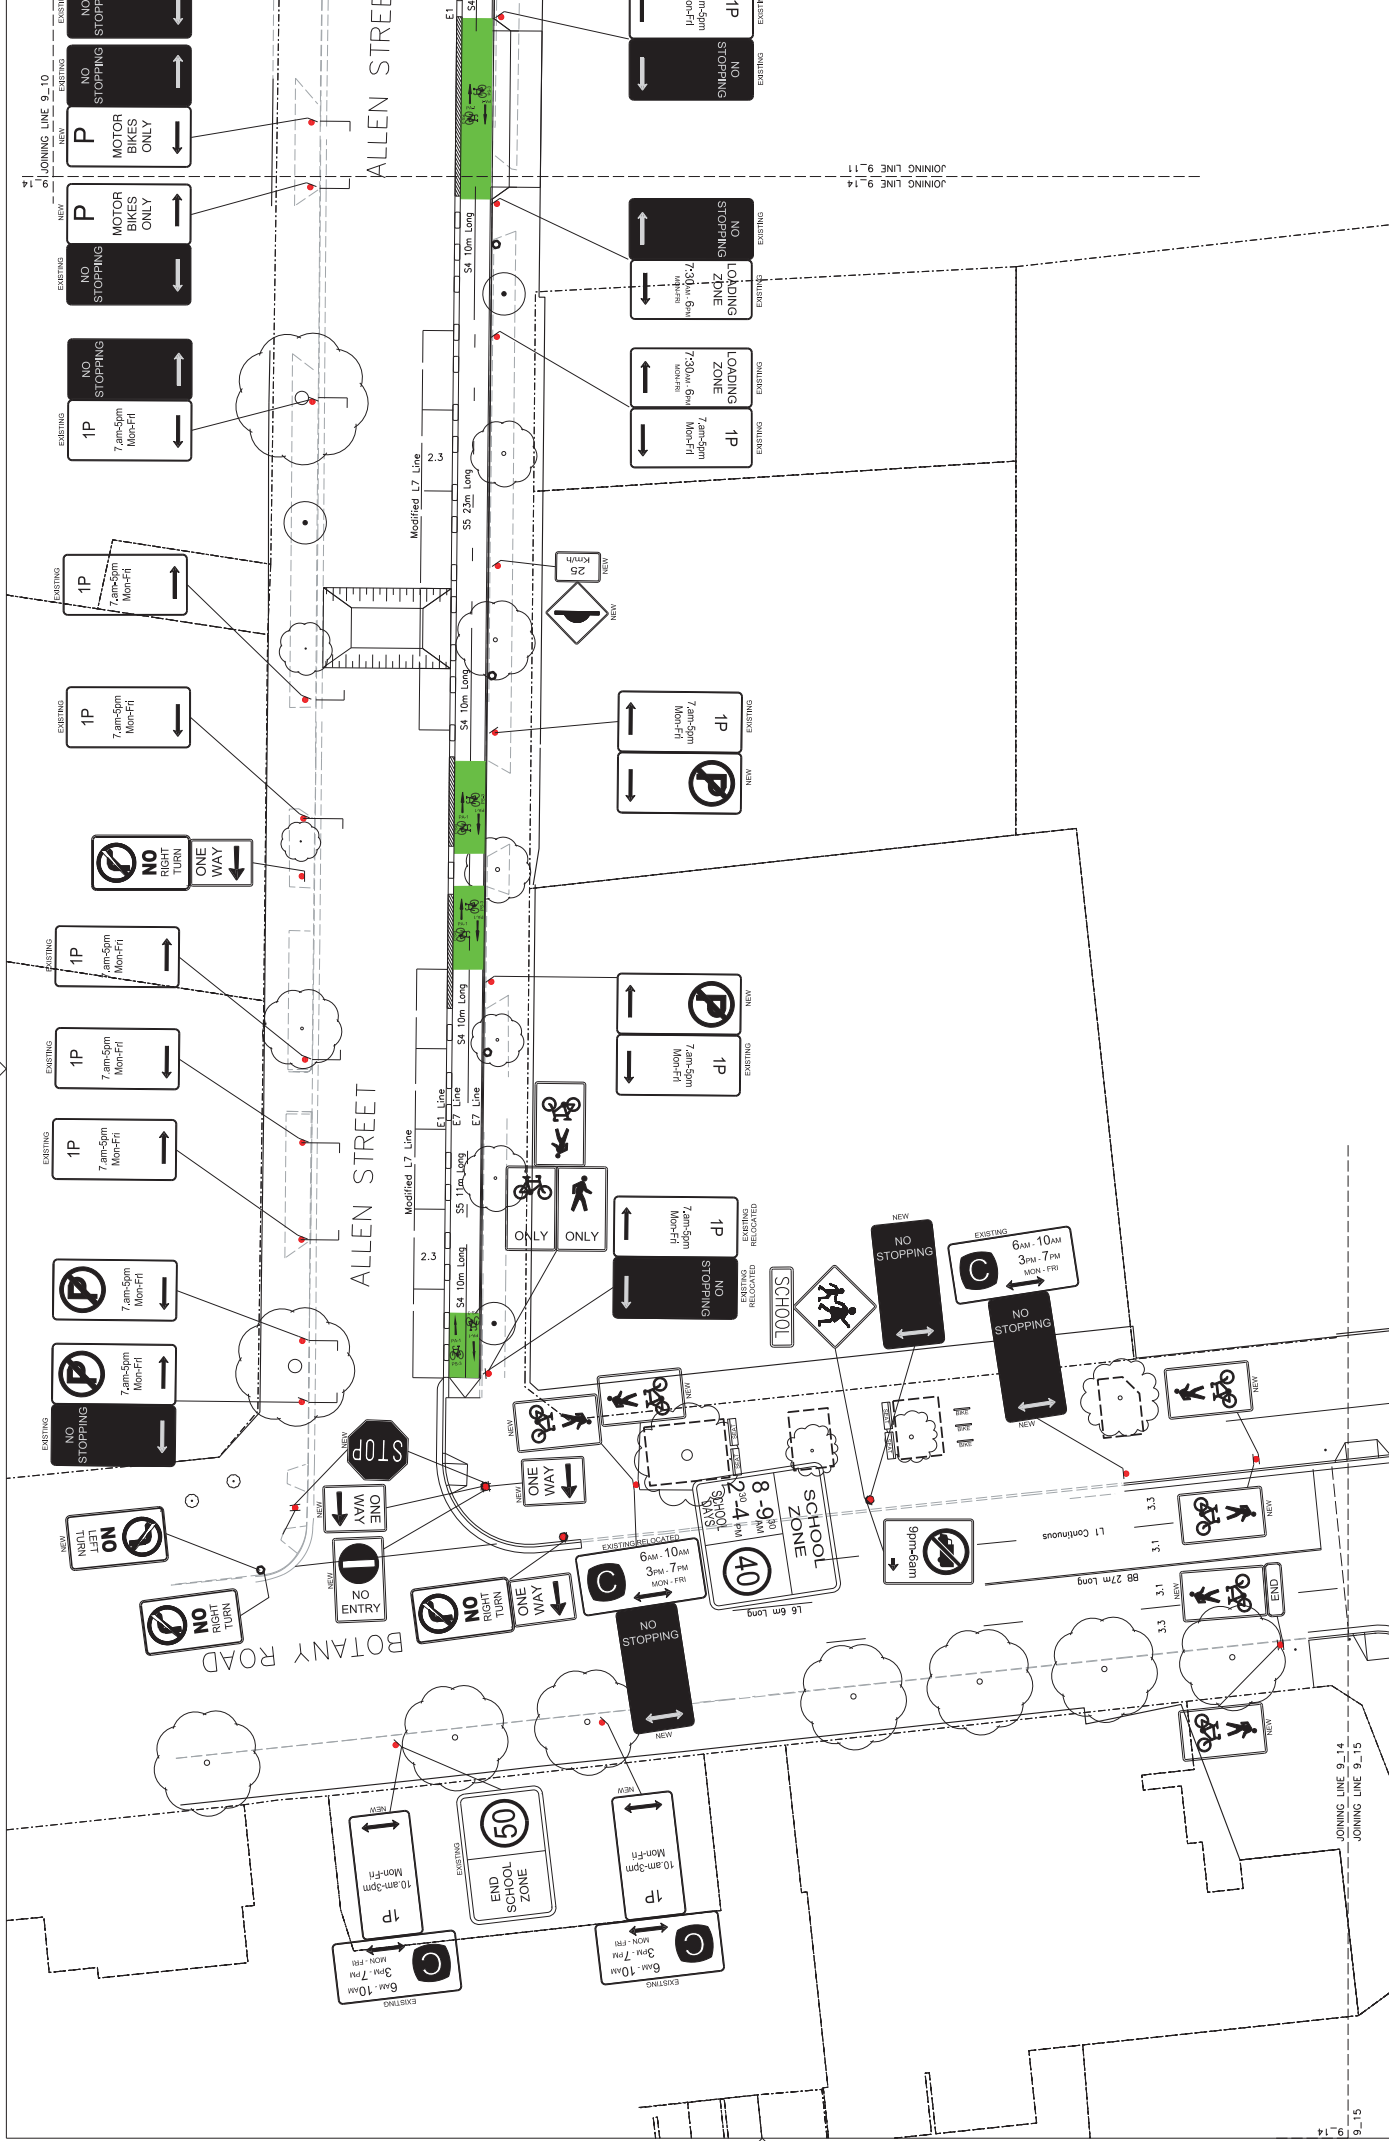


REV	DATE	REVISION / REVISION DESCRIPTION	APPROVAL	NAME	TITLE
A	09/04/15	CONSTRUCTION ISSUE	DATE	NAME	TITLE
B	01/05/15	AMENDED CONSTRUCTION ISSUE	DATE	NAME	TITLE
C	24/07/14	WORKS AS EXECUTED	DATE	NAME	TITLE

LEAD CONSULTANT / LANDSCAPE ARCHITECT	CONSULTANTS
vgroup.com.au 2/401 Pitt Street West Sydney NSW 2000 P: +61 2 9232 3327 F: +61 2 9232 3618 Sydney, NSW East Sydney NSW	GILL ENGINEERING - ARCHITECTURAL CONSULTING ENGINEERS TRISTAN ENGINEERING, CONSULTING AND TRADING ASSOCIATES LEPTON CONSULTANTS - LIGHTING, ART & SCIENCE CYCLE CONSULTING - SUSTAINABLE TRANSPORT CONSULTANTS ACCESS CONSULTING - ACCESS POINT ACCESSIBILITY CONSULTING

PROJECT TITLE	SCALE @ A4	CLIENT
GEORGE STREET CYCLEWAY - PACKAGE 2B	1:200	TRANS SYDNEY

DRAWING TITLE	DRAWING STATUS	PROJECT DRAWING NO.	REVISION
SIGNAGE & LINEMARKING	WORKS AS EXECUTED	9_14	D

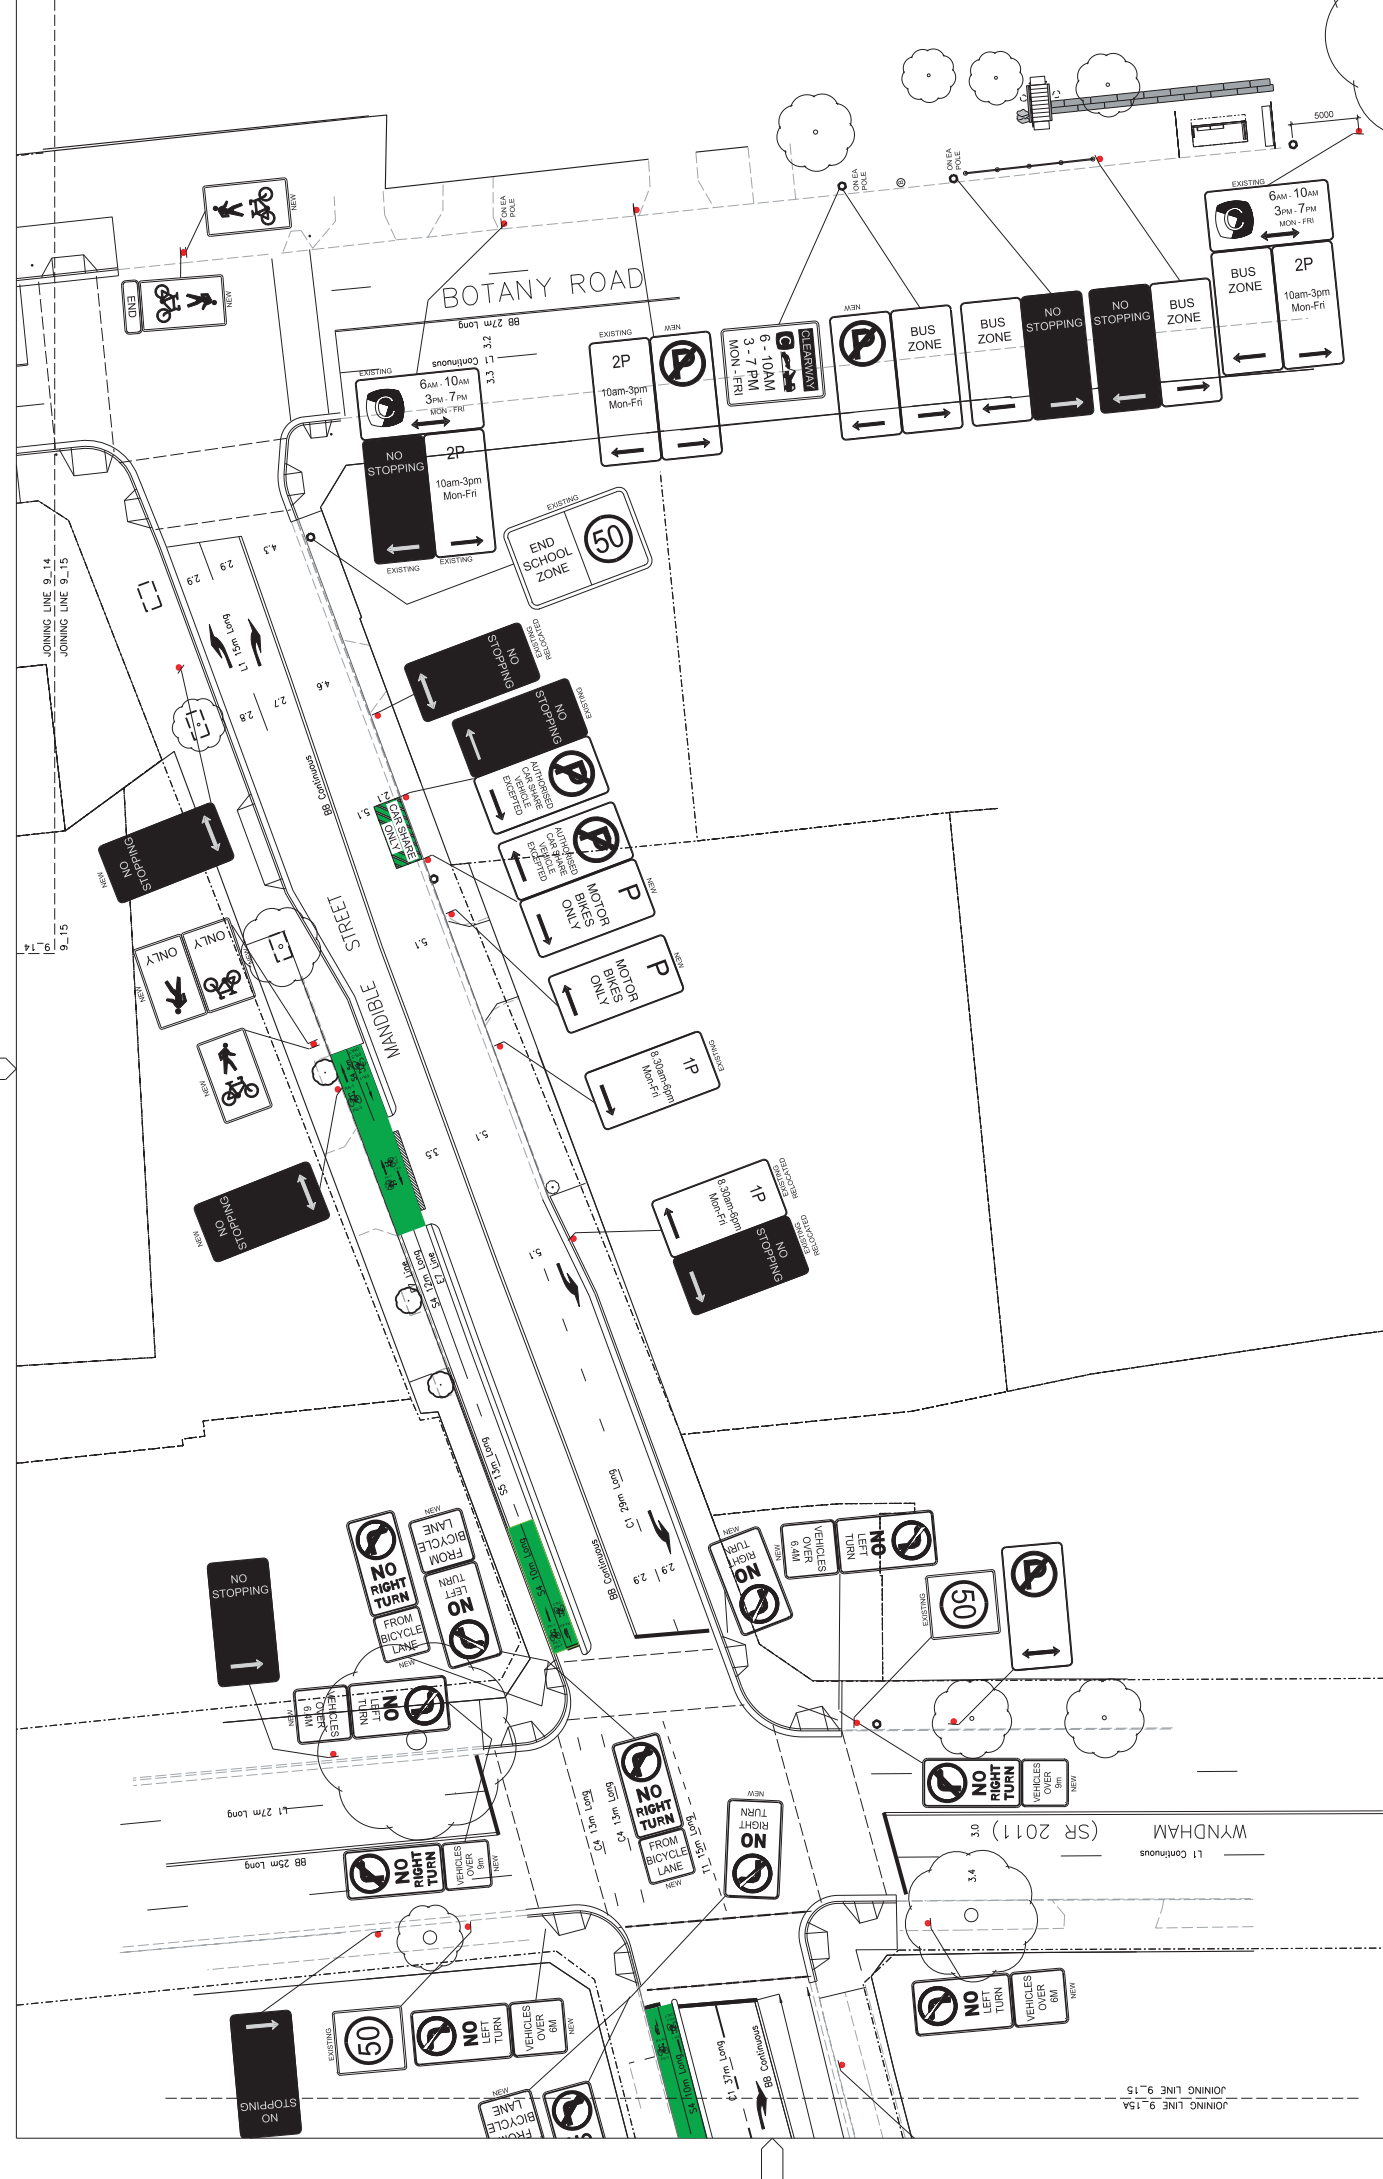


REV	DATE	REVISION / REVISION DESCRIPTION	APPROVAL	NAME	ROLE
A	09.04.13	CONSTRUCTION ISSUE	PM	DRAFTSMAN	AB
B	09.04.13	AMENDED CONSTRUCTION ISSUE	PH	DRAFTING CHECK	SH
C	09.04.14	AMENDED CONSTRUCTION ISSUE	PH	DESIGNER	TPPA
D	04.04.14	AMENDED CONSTRUCTION ISSUE	PH	DESIGN CHECK	SH
E	14.04.14	AMENDED CONSTRUCTION ISSUE	PH	PROJECT MANAGER	RIS
F	24.07.14	WORKS AS EXECUTED	PH	PROJECT DIRECTOR	RAC
G	31.07.14	WORKS AS EXECUTED	PH		

LEAD CONSULTANT / LANDSCAPE ARCHITECT	CONSULTANTS
GROUP USA pod architects P: +61 8 832 2137 F: +61 8 832 2618 35 Wren Street East Sydney NSW	CIVIL ENGINEERING - INTERIM CONSULTING ENGINEERS TRAFFIC ENGINEERING, TRANSPORT AND TRAMPOLINE ASSOCIATES LIGHTING CONSULTANT - LIGHTING ART & SCIENCE CYCLE CONSULTING - SUSTAINABLE TRANSPORT CONSULTANTS ACCESS CONSULTANT - ADAPTIVE URBAN ACCESSIBILITY CONSULTING

PROJECT TITLE	SCALE @ A4	CLIENT
GEORGE STREET CYCLEWAY - PACKAGE 2B	1:200	 CITY OF SYDNEY

DRAWING TITLE	DRAWING STATUS	PROJECT DRAWING NO.	REVISION
SIGNAGE & LINEMARKING	WORKS AS EXECUTED	9_15	H

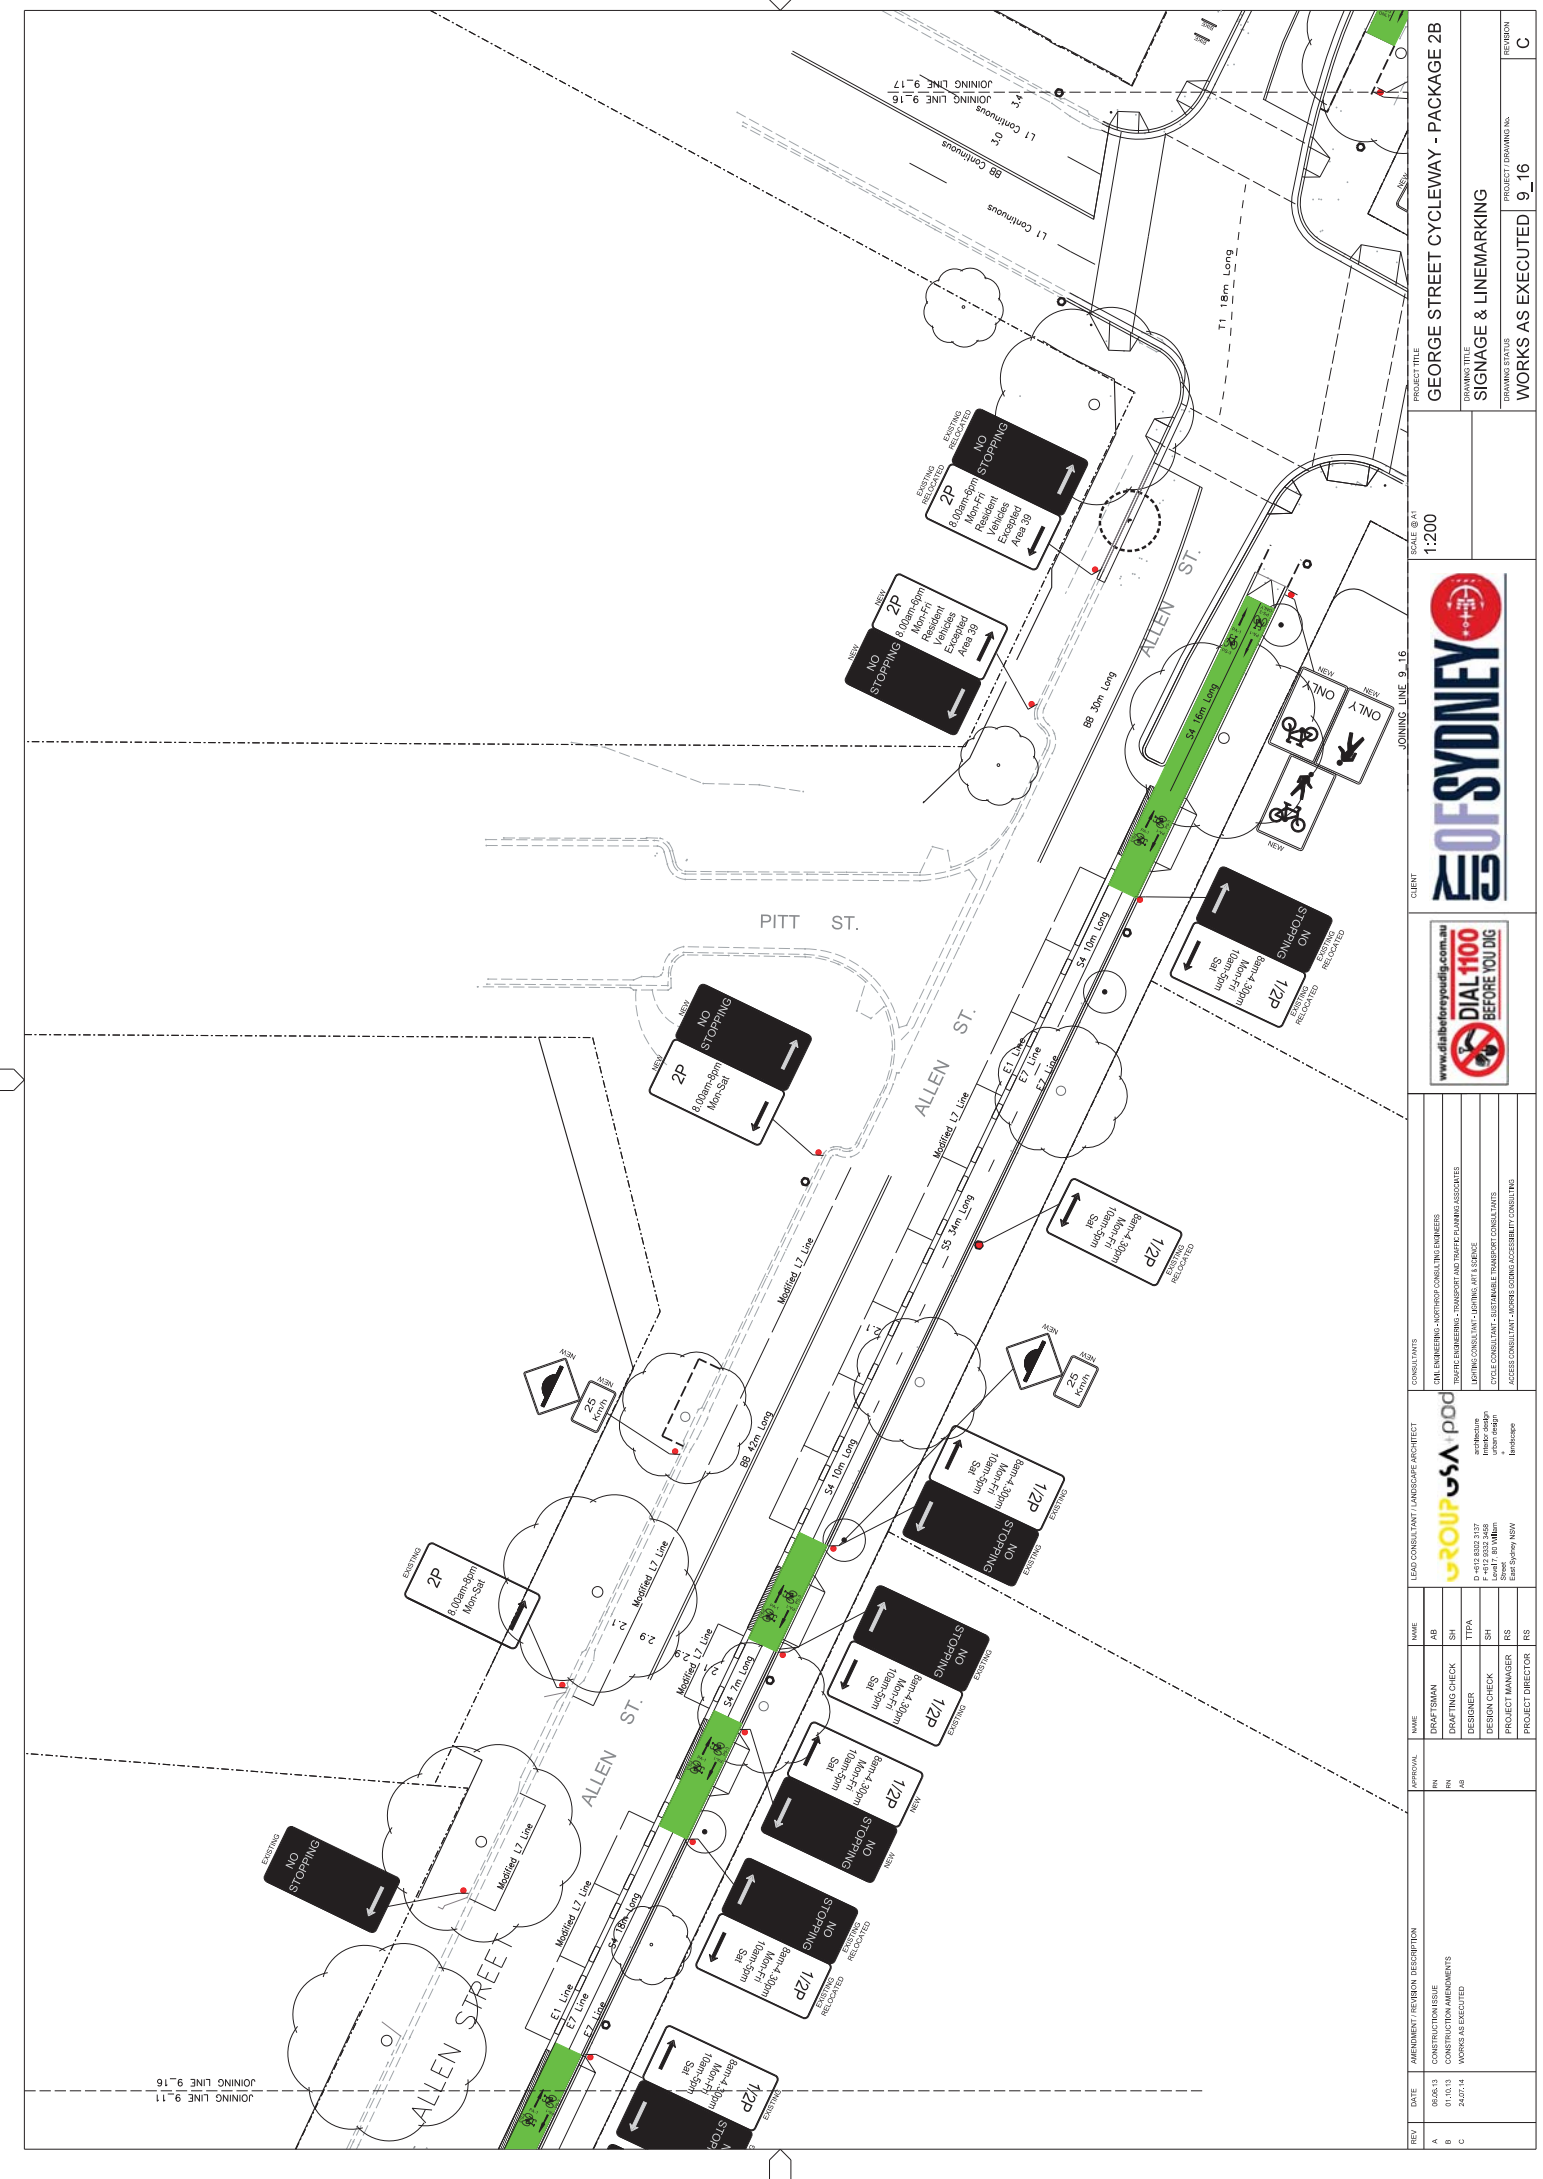

JOINING LINE 9_11

JOINING LINE 9_16

PROJECT TITLE
GEORGE STREET CYCLEWAY - PACKAGE 2B

DRAWING TITLE
SIGNAGE & LINEMARKING

DRAWING STATUS
WORKS AS EXECUTED

PROJECT DRAWING NO.
9_16

REVISION
C

SCALE: 1:200

CLIENT
City of Sydney

www.dialbeforeyoudig.com.au
DIAL 1100 BEFORE YOU DIG

CONSULTANTS
 CIVIL ENGINEERING, ARCHITECTURE CONSULTING ENGINEERS
 TRAFFIC ENGINEERING, SIGNAGE AND TRAFFIC PLANNING ASSOCIATES
 LIGHTING CONSULTANTS - LIGHTING, ART & SCIENCE
 CYCLE CONSULTING - SUSTAINABLE TRANSPORT CONSULTANTS
 ACCESS CONSULTANT / ACCESS POINT ACCESSIBILITY CONSULTING


LEAD CONSULTANT / LANDSCAPE ARCHITECT
GROUP USA pod

ARCHITECT
 prehabitat
 timber design
 green design
 landscape

P-412 8322 3137
 F-412 9312 2618
 111 White Street
 East Sydney NSW

APPROVAL	NAME	ROLE
DATE	DESCRIPTION	
06/01/13	CONSTRUCTION/ISSUE	NAME
01/01/14	WORKS AS EXECUTED	DATE
02/01/14	WORKS AS EXECUTED	DATE

DATE	REVISION / DESCRIPTION	APPROVAL	NAME	ROLE
06/01/13	CONSTRUCTION/ISSUE	DATE	NAME	ROLE
01/01/14	WORKS AS EXECUTED	DATE	NAME	ROLE
02/01/14	WORKS AS EXECUTED	DATE	NAME	ROLE

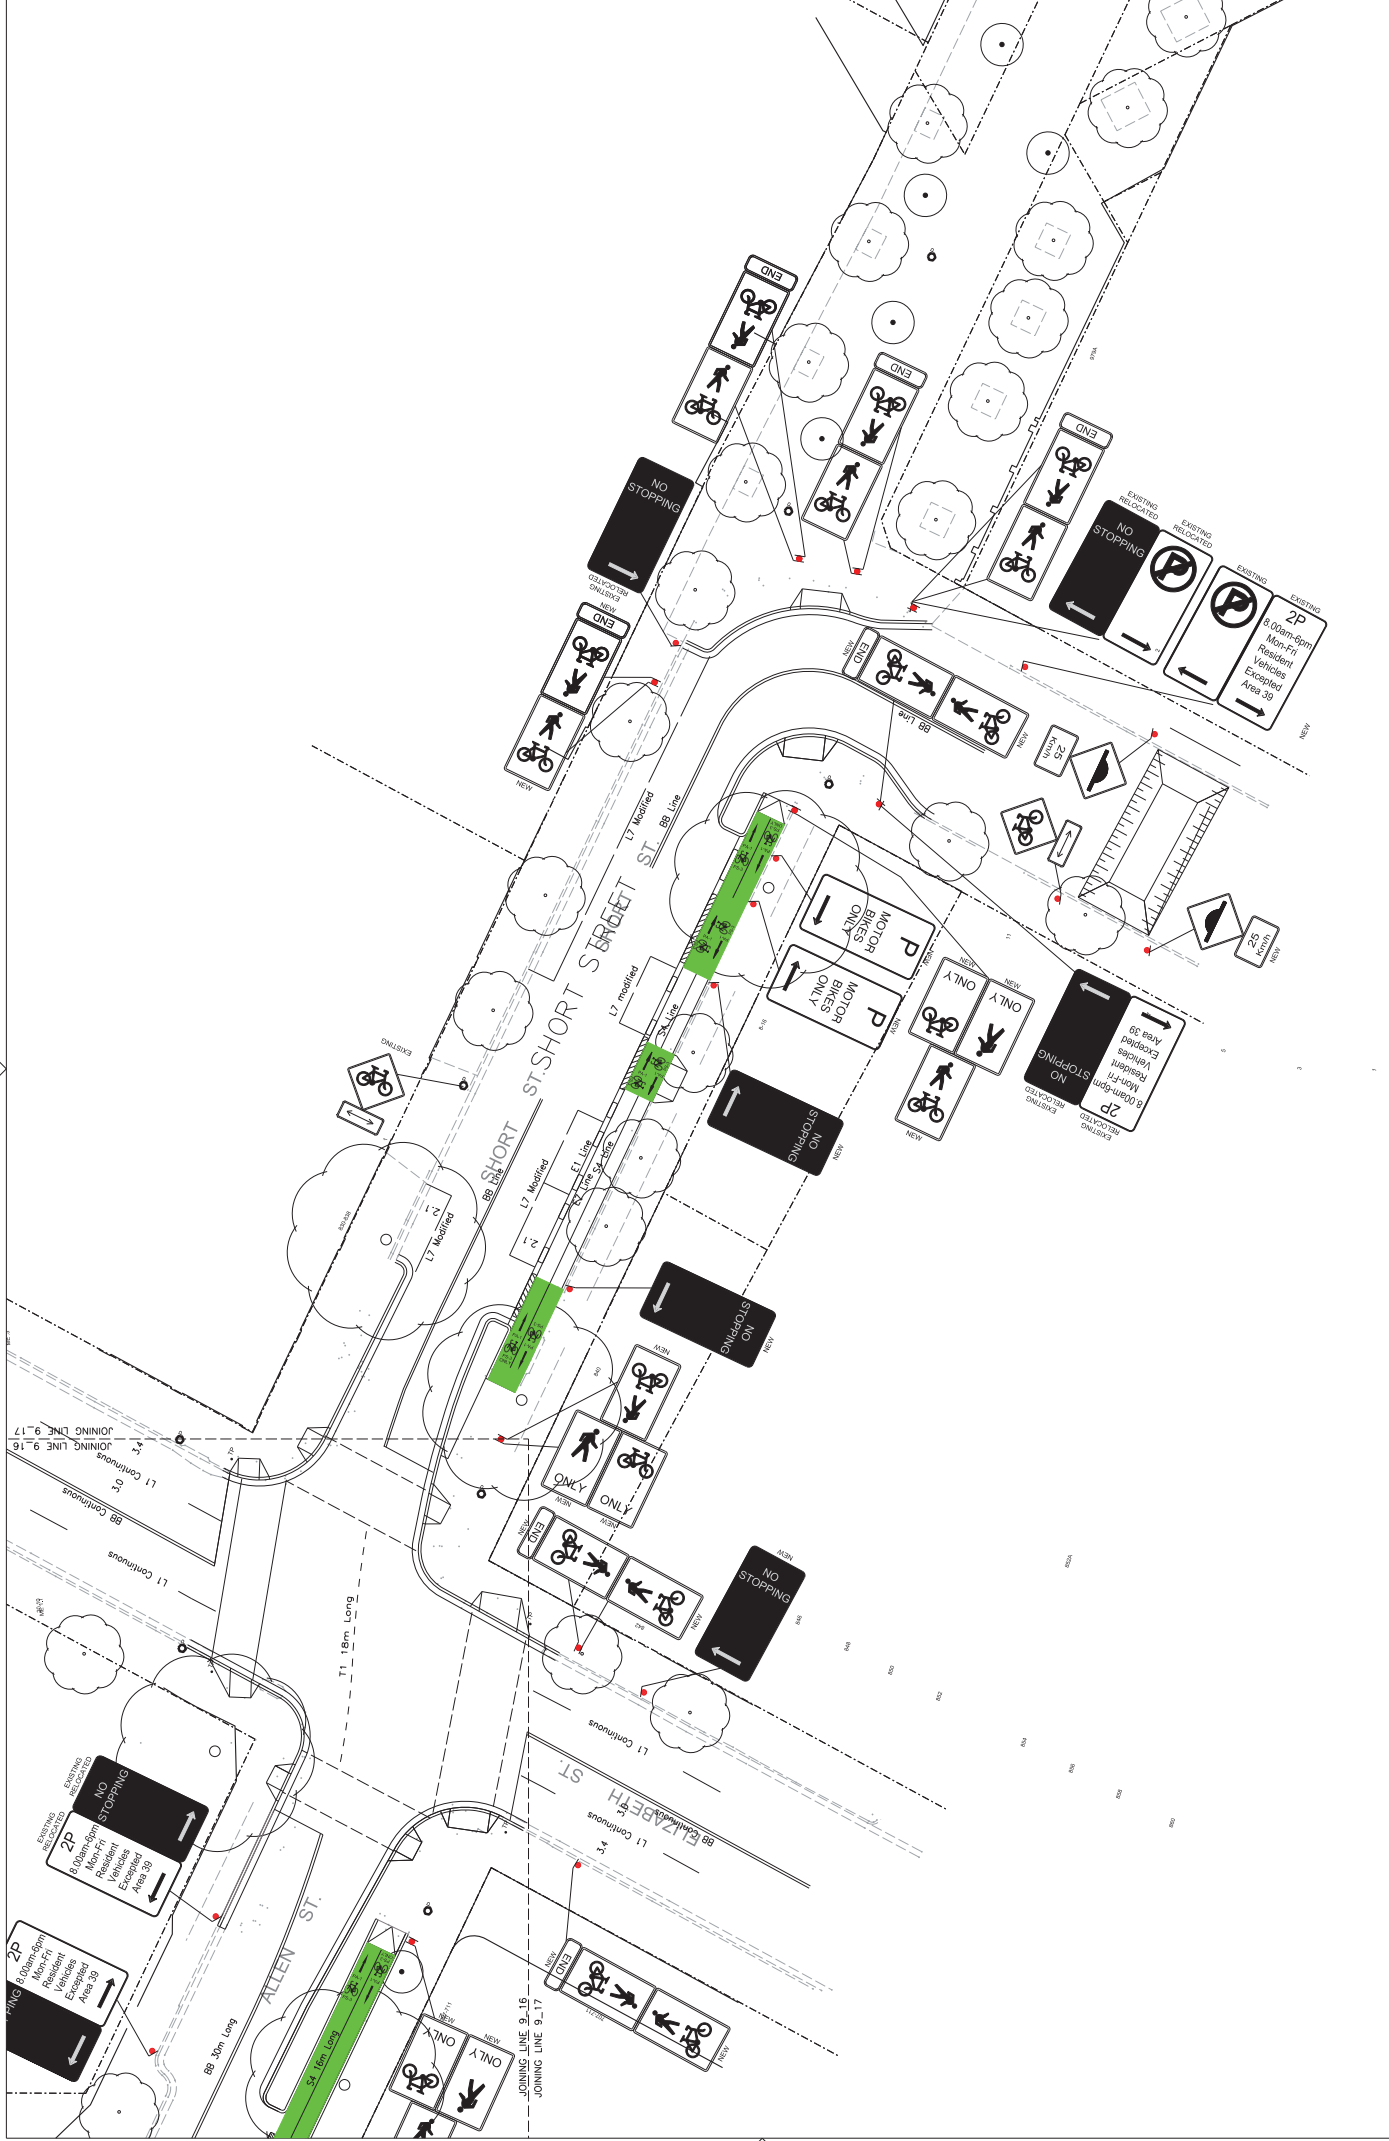

REV	DATE	REVISION / REVISION DESCRIPTION	APPROVAL	NAME	ROLE	NAME	ROLE
A	06/01/13	CONSTRUCTION ISSUE	PH	DAVID MANNING	FAB	DAVID MANNING	FAB
B	01/04/13	WORKING DRAWINGS COMMENTS	PH	DAVID MANNING	SH	DAVID MANNING	SH
C	04/01/14	WORKING DRAWINGS COMMENTS	PH	DAVID MANNING	SH	DAVID MANNING	SH

CONSULTANTS	LEAD CONSULTANT / LANDSCAPE ARCHITECT	PROJECT DIRECTOR
CHL ENGINEERING - URBAN DESIGN CONSULTANTS TRIPLEX ENGINEERING - TRANSPORT AND TRAFFIC PLANNING ASSOCIATES URBAN DESIGN CONSULTANTS - URBAN DESIGN CYCLE CONSULTING - SUSTAINABLE TRANSPORT CONSULTANTS ACCESS CONSULTING - ACCESSIBILITY ACCESSIBILITY CONSULTANTS	GROUP USA pod groupusa.com.au P + 612 8322 2127 F + 612 8322 2618 25 Wren Street East Sydney NSW	DAVID MANNING

CLIENT	SCALE	PROJECT TITLE
DIAL 1100 www.dialbeforeyoudig.com.au BEFORE YOU DIG	1:200	GEORGE STREET CYCLEWAY - PACKAGE 2B

PROJECT TITLE	DRAWING TITLE	DRAWING STATUS	PROJECT DRAWING NO.	REVISION
GEORGE STREET CYCLEWAY - PACKAGE 2B	SIGNAGE & LINEMARKING	WORKS AS EXECUTED	9_17	C

