

Attachment B

Selected Drawings

SJB Architects
Level 2, 490 Crown Street
Surry Hills NSW
2010 Australia
T 61 2 9380 9911
F 61 2 9380 9922


Project Number: 7166
Date: 20.04.2026
Client: DAVID BROWN
Issue: DA SUBMISSION





Architectural Drawing List

Sheet Number	Sheet Name	Current Revision	Current Revision Date
DA-0000	COVER	4	20.04.2026
DA-0001	EXISTING PLANS	4	20.04.2026
DA-0007	DEMOLITION PLANS	4	20.04.2026
DA-0057	3D OVERALL AXONOMETRIC - SHEET 1	4	20.04.2026
DA-0061	3D OVERALL AXONOMETRIC - SHEET 2	4	20.04.2026
DA-1007	FLOOR PLAN - LEVEL 06	4	20.04.2026
DA-1008	FLOOR PLAN - LEVEL 08	4	20.04.2026
DA-1009	FLOOR PLAN - ROOF	4	20.04.2026
DA-1010	ELEVATIONS - SHEET 1	4	20.04.2026
DA-1022	ELEVATIONS - SHEET 2	4	20.04.2026
DA-1033	SECTIONS - SHEET 1	4	20.04.2026
DA-1034	SECTIONS - SHEET 2	4	20.04.2026
DA-1035	COMPLIANCE DRAWINGS - SHADOW DIAGRAMS - SHEET 1	4	20.04.2026
DA-1036	COMPLIANCE DRAWINGS - SHADOW DIAGRAMS - SHEET 2	4	20.04.2026
DA-8004	COMPLIANCE DRAWINGS - EYE OF THE SUN	4	20.04.2026
DA-8007	COMPLIANCE DRAWINGS - HEIGHT PLANE	4	20.04.2026
DA-8008	COMPLIANCE DRAWINGS - HEIGHT PLANE	4	20.04.2026
DA-8009	AREA PLANS - GFA	4	20.04.2026
DA-8001	PHOTOMONTAGE - CHALMERS STREET	4	20.04.2026
DA-8002	PHOTOMONTAGE - RANDLE STREET	4	20.04.2026
DA-8703	MATERIAL BOARD	4	20.04.2026

BASIS ENERGY COMMITMENTS		BASIS WATER COMMITMENTS		NATHERS COMMITMENTS	
BASIS Page: 12 December 12		BASIS Page: 40 December 40		BASIS Page: 40 December 40	
HEATING AND COOLING SYSTEMS	HEATING SYSTEM	ELECTRICAL, HEAT PUMP	SHOWER/BAZON	WINDOWS & GLAZED DOORS	U VALUE 1.88, SHGC 0.59
	COOLING SYSTEM	ELECTRICAL, COOLING & COVER	TOILETS	SKYLIGHTS	U VALUE 2.03, SHGC 0.31
	APPLIANCES	ELECTRICAL, COOLING & COVER	KITCHEN, BATHROOM, LAUNDRY	EXTERNAL WALLS	REGULATION R 3.0
	VENTILATION SYSTEM	ELECTRICAL, COOLING & COVER	ALTERNATIVE ENERGY	INTERNAL WALLS	REGULATION R 0.6
FRESH AIR VENTILATION	CLIMATE CONTROL	YES	CLIMATE CONTROL	FLOORS	REGULATION R 0.6
	CLIMATE CONTROL	YES	CLIMATE CONTROL	CEILING	REGULATION R 0.6
ALTERNATIVE ENERGY	ALTERNATIVE ENERGY	YES	ALTERNATIVE ENERGY	BALCONIES & ROOFS	REGULATION R 0.6
	ALTERNATIVE ENERGY	YES	ALTERNATIVE ENERGY	BALCONIES & ROOFS	REGULATION R 0.6

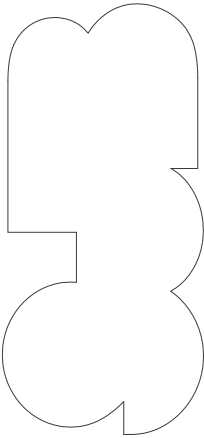

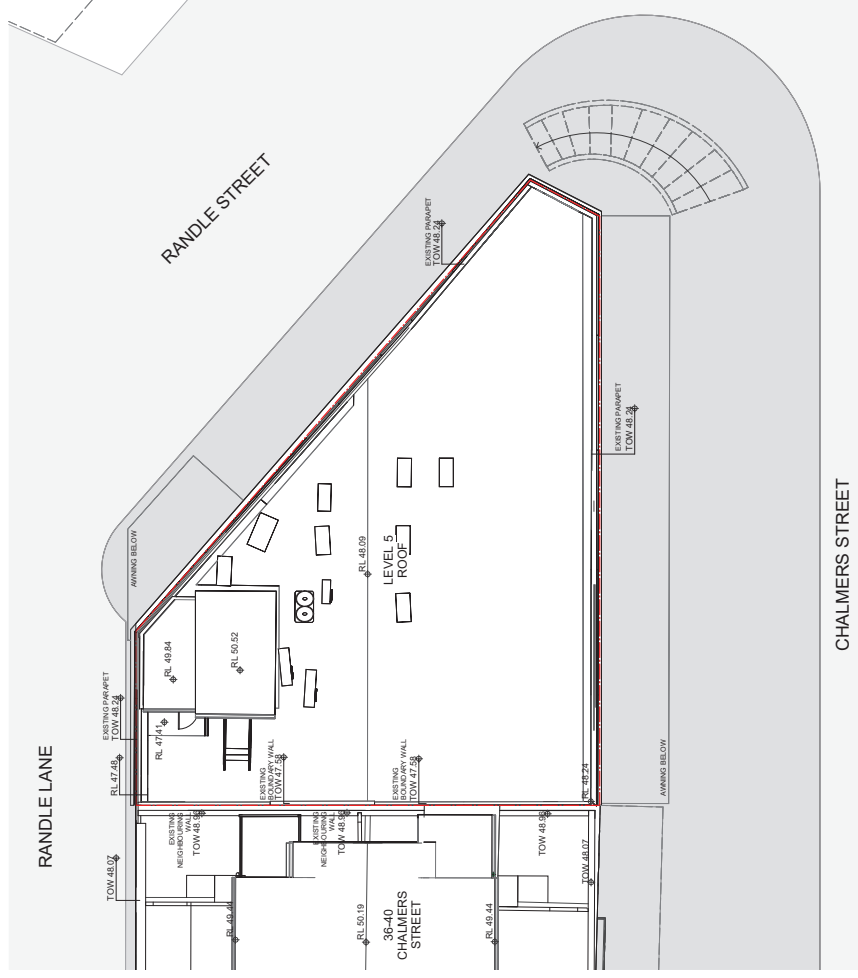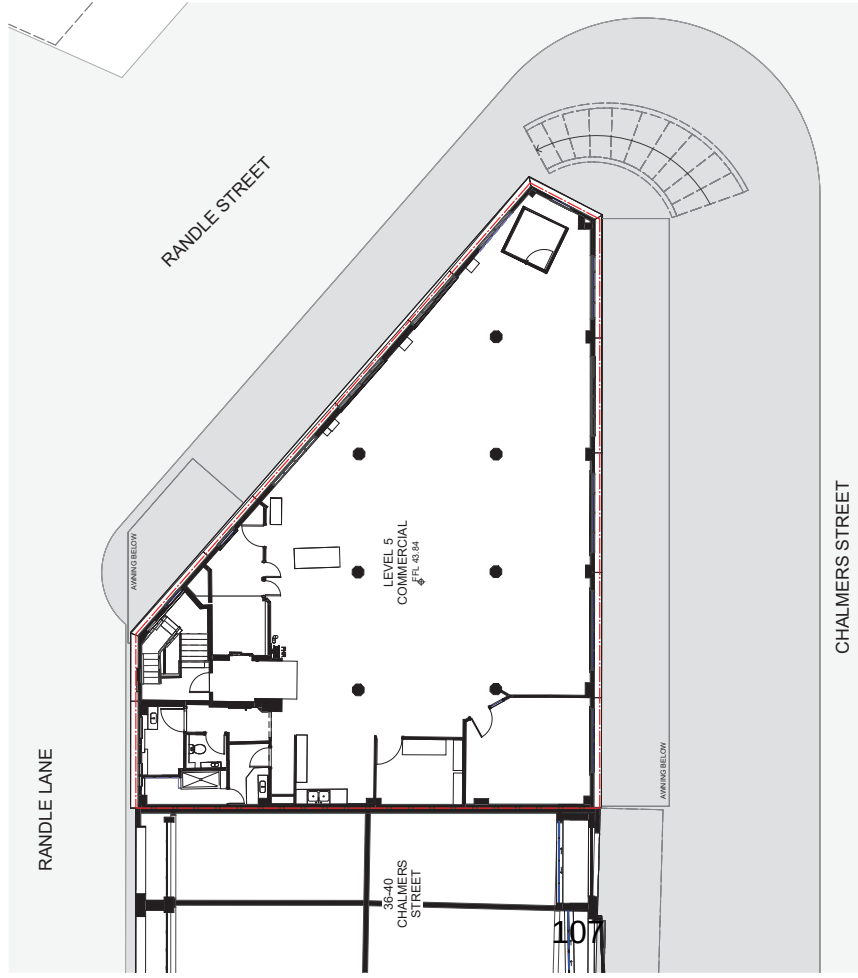

1 EXISTING - LEVEL 5
SCALE 1 : 100

2 EXISTING - ROOF
SCALE 1 : 100

In accepting and affixing this document, the recipient agrees that S.B. Architects (NSW) Pty. Ltd. ACHN 01 094 731 /A/SB Architects, retain all common law, statutory law and other rights including copyright and intellectual property rights. The recipient agrees to waive all claims against S.B. Architects resulting from its involvement in the project. This agreement shall survive termination or completion of the contract. S.B. Architects make no warranties or representations about the design or construction of the building. All drawings and documents are deemed a sale. S.B. Architects make no warranties or fitness for any purpose. The Buyer/Contractor will verify plot dimensions prior to any work commencing as shown by figures dimensioned only. Do not scale drawings.

FOR APPROVAL

[illegible]

NOTE: MINOR CHANGES TO FORM AND CONFIGURATION MAY BE REQUIRED WHEN DRAWINGS ARE SUBSEQUENTLY PREPARED FOR CONSTRUCTION PURPOSES AFTER THE GRANT OF DEVELOPMENT CONSENT.

Client

~~X~~COMMERCIAL

Client


Project
AYU'S PENTHOUSE
17 RANDLE STREET, SURRY HILLS, 2010, NSW

Date	Scale	Sheet Size
20.04.2026	1 : 100	A1
Drawn	Chk.	Job No.
BD	GS	7166
Drawing No.	Revision	
DA-0207	/ 4	


NOT FOR CONSTRUCTION




SJB Architects
Level 2, 490 Crown Street
Surry Hills NSW 2010
T 61 2 9350 9911
www.sjb.com.au

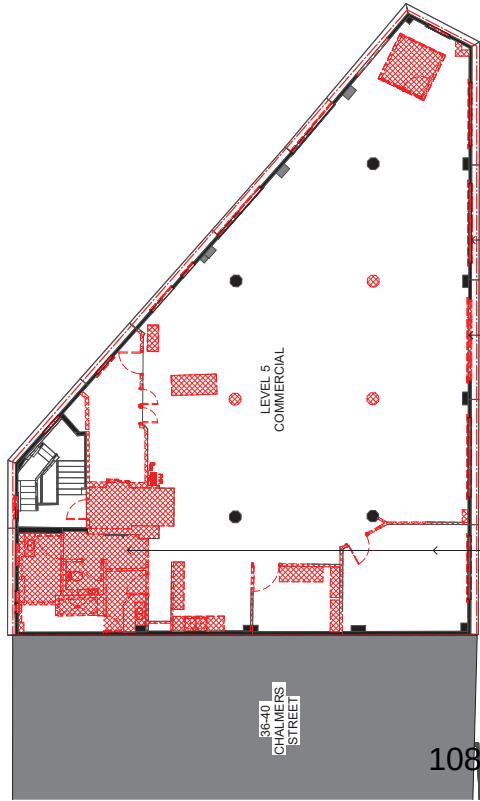


1 LEVEL 5 EXISTING - DEMOLITION PLAN
SCALE 1:100

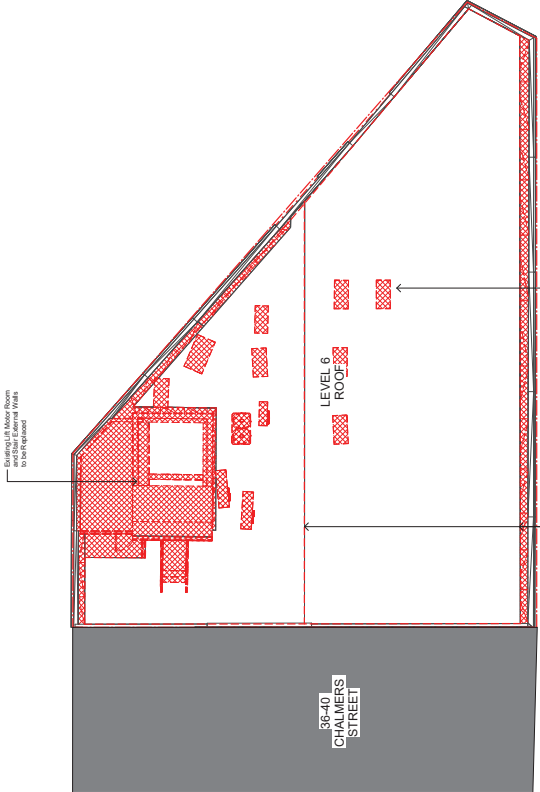


2 ROOF - DEMOLITION PLAN
SCALE 1:100

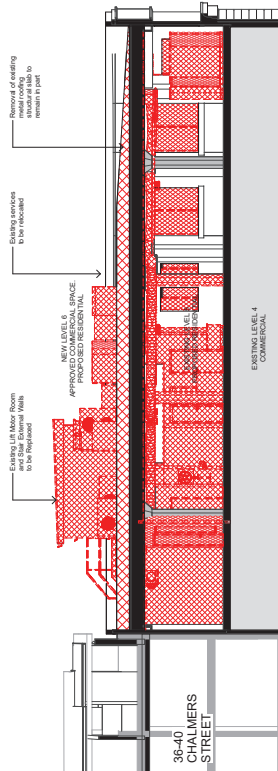

3 EXISTING - DEMOLITION SECTION
SCALE 1:100

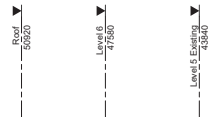

FOR APPROVAL

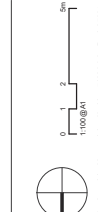

Rev	Date	Revision	By	CHK
1	10.10.2020	FOR APPROVAL	BD	GS
2	10.10.2020	FOR APPROVAL	BD	GS
3	10.10.2020	FOR APPROVAL	BD	GS
4	10.10.2020	FOR APPROVAL	BD	GS

NOTE: THIS DOCUMENT IS FOR INFORMATION PURPOSES ONLY. IT IS NOT TO BE USED FOR CONSTRUCTION PURPOSES WITHOUT THE GRANT OF DEVELOPMENT CONSENT.

XCOMMERCIAL

Project: AYU'S PENTHOUSE
17 RANGLE STREET, SURRY HILLS, 2010, NSW

Date	Scale	Sheet Size
20.04.2026	1:100	A1
Drawn	CHK	Job No.
BD	GS	7166
Client No.	Revision	Drawn No.
DA-0257	1/4	

NOT FOR CONSTRUCTION





Rev	Date	Revision	By	Chk.
1	12.02.2026	FOR INFORMATION	BD	GS
2	09.03.2026	FOR INFORMATION	BD	GS
3	20.03.2026	FOR INFORMATION - DRAFT	BD	GS
4	20.04.2026	DA SUBMITTAL	BD	GS

NOTE: MINOR CHANGES TO FORM AND CONFIGURATION MAY BE REQUIRED WHEN DRAWINGS ARE SUBSEQUENTLY PREPARED FOR CONSTRUCTION PROPOSALS AFTER THE GRANT OF DEVELOPMENT CONSENT.

Client _____

~~NON-CONFIDENTIAL~~


Project: YAYUS PENTHOUSE
7 RANDLE STREET, SURRY HILLS, 2010, NSW
Drawing Name: OVERALL AXONOMETRIC - SHEET 2



Date	Scale	Sheet Size
20.04.2026		A1
Drawn	CHK	Job No.
BD	GS	7166
Drawing No.	Revision	
DA-0802	/ 4	

JB Architects
Level 2, 490 Crown Street
Sydney NSW 2010
61 2 9360 9911
www.jb.com.au

NOT FOR CONSTRUCTION

Rev	Date	Revision	By	Ck
1	10.12.2025	FOR INFORMATION ONLY	BD	GS
2	08.03.2026	FOR INFORMATION ONLY	BD	GS
3	08.03.2026	FOR INFORMATION ONLY	BD	GS
4	08.03.2026	FOR INFORMATION ONLY	BD	GS
5	11.06.2026	FOR INFORMATION ONLY	BD	GS

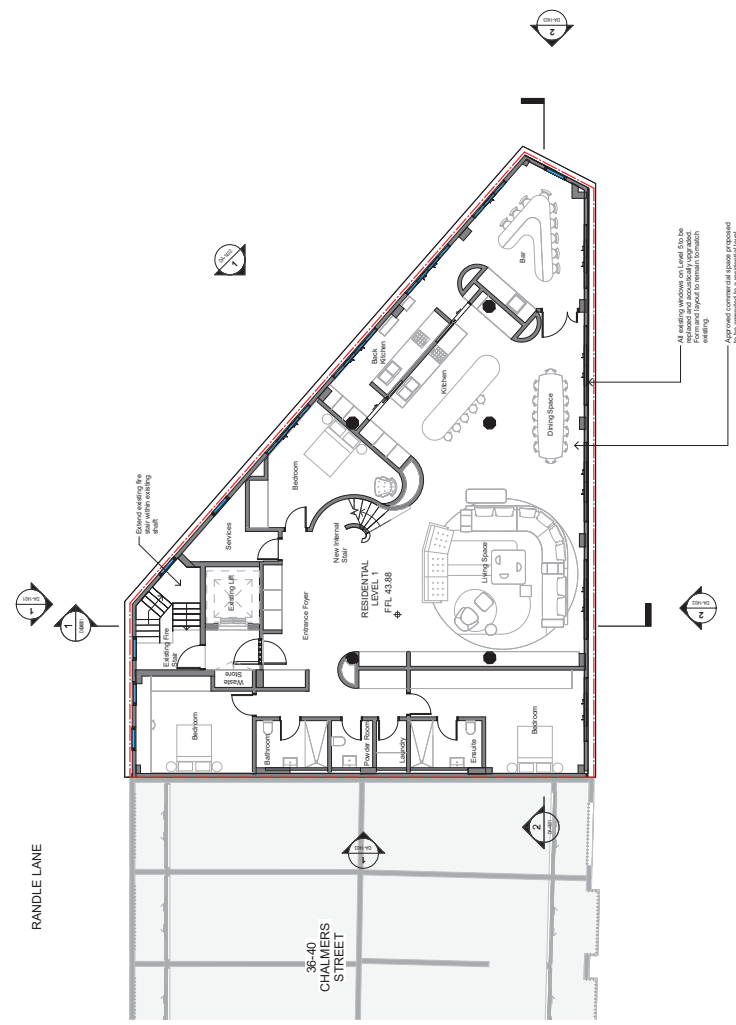

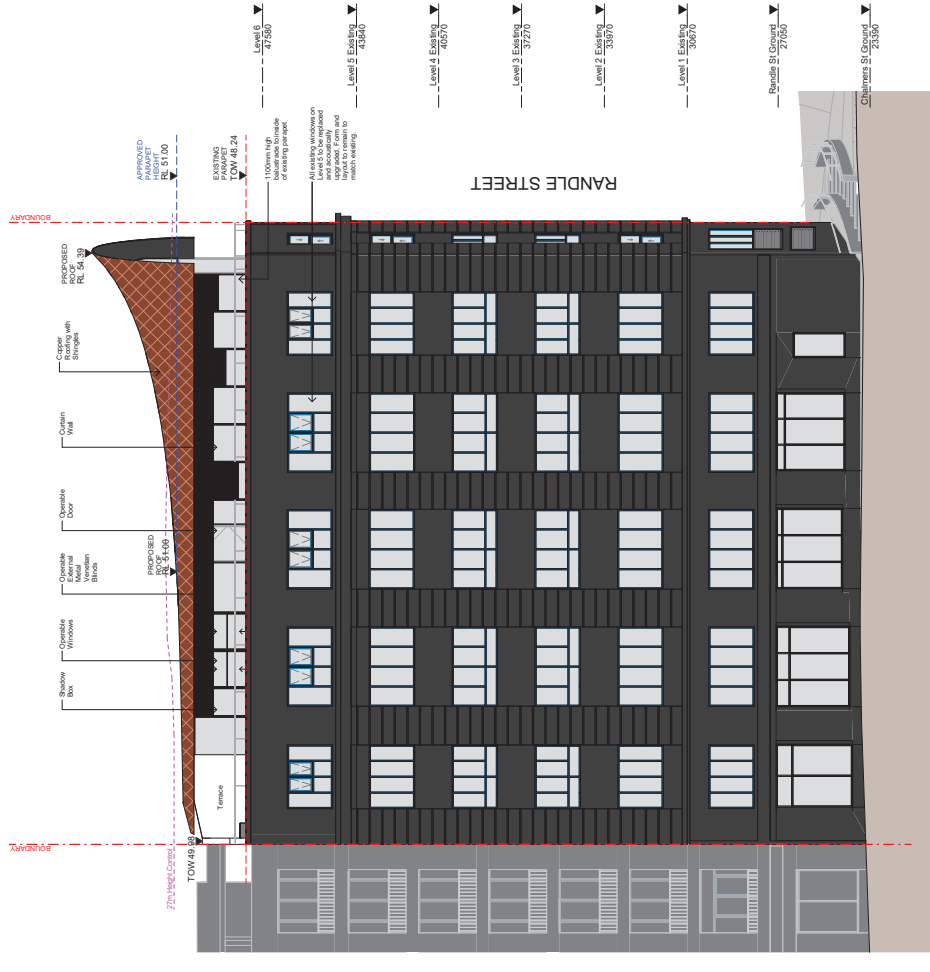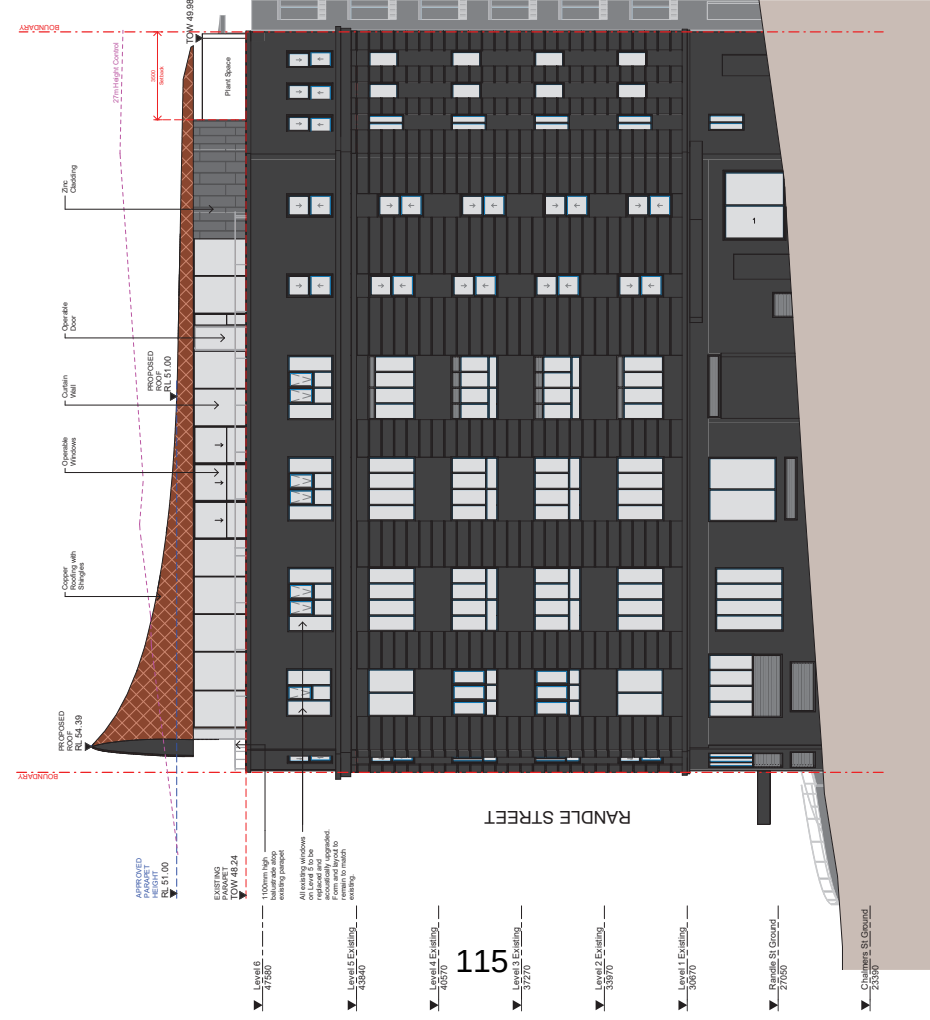

1 SOUTH EAST ELEVATION
SCALE 1:100

2 WESTERN ELEVATION
SCALE 1" = 100'

NOT FOR CONSTRUCTION

By signing this document, the recipient agrees not to use this document for any purpose other than the intended use, to waive all claims against S&B Architects resulting from unauthorised changes or to reuse the document on other projects without the written consent from S&B Architects. Under no circumstances shall transfer of this document be deemed a sale. S&B Architects makes no warranties or representations for any purpose. The Bidder/Contractor that verify bid dimensions prior to any work commencing, is figured dimensions only. Do not use drawings.

FOR APPROVAL

Micronized Arabidopsis: Adams Molecular Weight = 6000000
MW 100000

Row	Date	Revision	By	Chk
1	03/03/20	FOR INFORMATION	BD	GS
2	03/03/20	FOR INFORMATION	BD	GS
3	20/03/20	IN A SUBMISSION DRAFT	BD	GS
4	20/04/20	IN A SUBMISSION	BD	GS
5	05/05/20	COUNCIL REF. DRAFT	BD	GS
6	11/05/20	COUNCIL 10%	BD	GS

NOTE: MINOR CHANGES TO FORM AND CONFIGURATION MAY BE REQUIRED WHEN DRAWINGS ARE SUBSEQUENTLY PREPARED FOR CONSTRUCTION PURPOSES AFTER THE GRANT OF DEVELOPMENT CONSENT.

Client _____


Project
AYU'S PENTHOUSE
17 RANDI E STREET SURRY HILLS 2010 NSW

Drawing Name
ELEVATIONS - SHEET 2


Date	Scale	Sheet Size
11.06.2026	1 : 100	A1
Drawn	CHK.	Job No.
BD	GS	7166
Drawing No.	Revision	
DA-1402	/6	

SJB Architects
Level 2, 490 Crown
Surrey Hills NSW 20
T 61 2 9380 9911
www.sjb.com.au




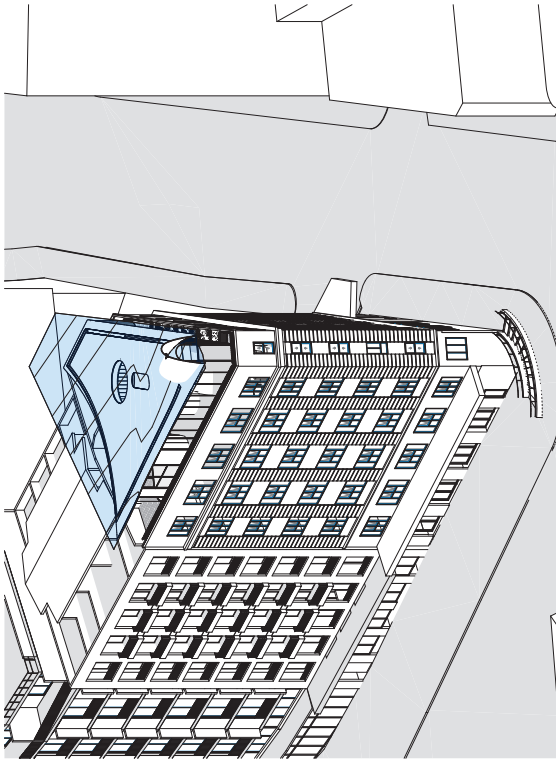

LEP PROPOSED HEIGHT - SOUTH WEST

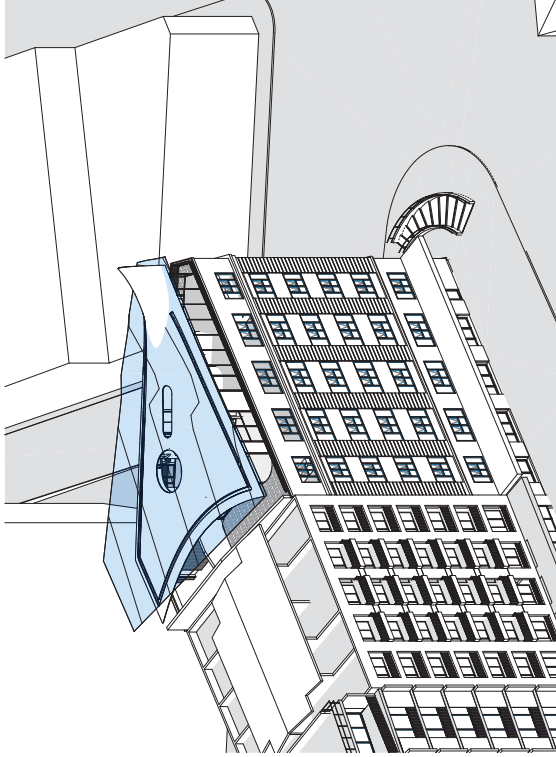

LEP PROPOSED HEIGHT - NORTH WEST

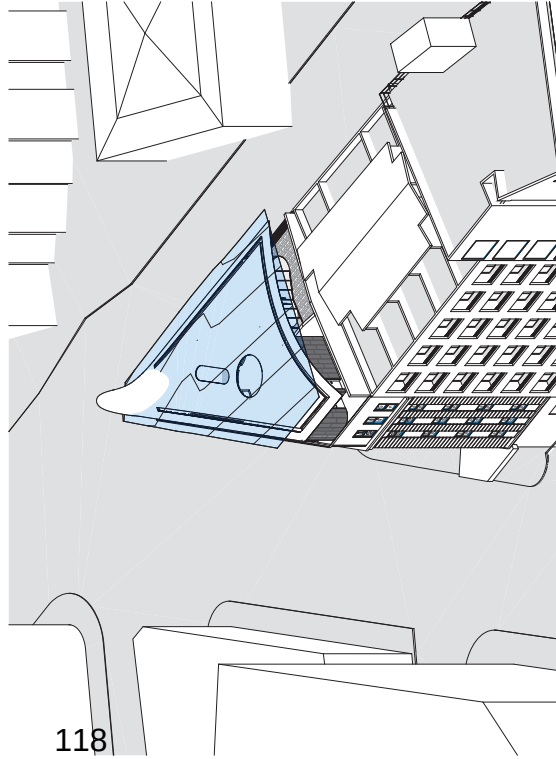

LEP PROPOSED HEIGHT - NORTH EAST



LEP PROPOSED HEIGHT - EAST

NOT FOR CONSTRUCTION

Rev	Date	Revision	By	Ck
3	20.03.2026	DR 0.000.000000 - 26.02	BD	GS
4	20.03.2026	DR 0.000.000000	BD	GS

1:100 @ A1

Date	Scale	Sheet Size
20.04.2026	A1	

Project
AYU'S PENTHOUSE
17 RANDLE STREET, SURRY HILLS, 2010, NSW

Client
XCOMMERCIAL

NOTE: THESE DRAWINGS ARE FOR INFORMATION ONLY AND ARE NOT TO BE USED FOR CONSTRUCTION PURPOSES WITHOUT THE GRANT OF DEVELOPMENT CONSENT.

Drawing No.	Revision
BD	GS
7166	

Normalized Architects Adam Fiddler P188 | John Pridie P264

FOR APPROVAL



SJP Architects
Level 2, 480 Gower Street
Surry Hills NSW 2010
T 61 2 9360 9911
www.sjp.com.au



Rev	Date	Revision	By	CHK
3	2013.03.08	LA SUBMISSION - DRAFT	BO	GS
4	2014.07.08	LA SUBMISSION	BO	GS

NOTE: MINOR CHANGES TO FORM AND CONFIGURATION MAY BE REQUIRED WHEN DRAWINGS ARE SUBSEQUENTLY PREPARED FOR CONSTRUCTION PURPOSES AFTER THE GRANT OF DEVELOPMENT CONSENT.

Client _____

~~EXCOMMERCIAL~~

Project	YU'S PENTHOUSE 17 RANDLE STREET, SURRY HILLS, 2010, NSW
Drawing Name	COMPLIANCE DRAWINGS - HEIGHT PLANE

Date	Scale	Sheet Size
20.04.2026	A1	
Drawn	CHK.	Job No.
BD	GS	7166
Drawing No.	Revision	
DA-8008	/ 4	

JB Architects
Level 2, 490 Crown Street
Curry Hills NSW 2010
61 2 9380 9911
www.sjb.com.au



NOT FOR CONSTRUCTION



FOR APPROVAL

Architects of this project are not responsible for the accuracy of the information provided in this document. The information is provided for your information only and is not intended to be used for any other purpose. The information is provided for your information only and is not intended to be used for any other purpose. The information is provided for your information only and is not intended to be used for any other purpose.

Notwithstanding to whomsoever, the architect shall not be responsible for the accuracy of the information provided in this document. The information is provided for your information only and is not intended to be used for any other purpose. The information is provided for your information only and is not intended to be used for any other purpose.

Rev	Date	Revision	By	CN
3	20.03.2020	05.03.2020, 24.02	BD	GS
4	20.03.2020	05.03.2020	BD	GS

NOTE: THESE DRAWINGS ARE FOR INFORMATION ONLY AND ARE NOT TO BE USED FOR ANY OTHER PURPOSES WITHOUT THE WRITTEN CONSENT OF THE ARCHITECT. THE ARCHITECT IS NOT RESPONSIBLE FOR THE ACCURACY OF THE INFORMATION PROVIDED IN THIS DOCUMENT.

Client

XCOMMERCIAL

Project

AYU'S PENTHOUSE
17 RANDLE STREET, SURRY HILLS, 2010, NSW

Date	Scale	Sheet Size
20.04.2020	A1	


NOT FOR CONSTRUCTION

DA-8702


7/4




Material Palette

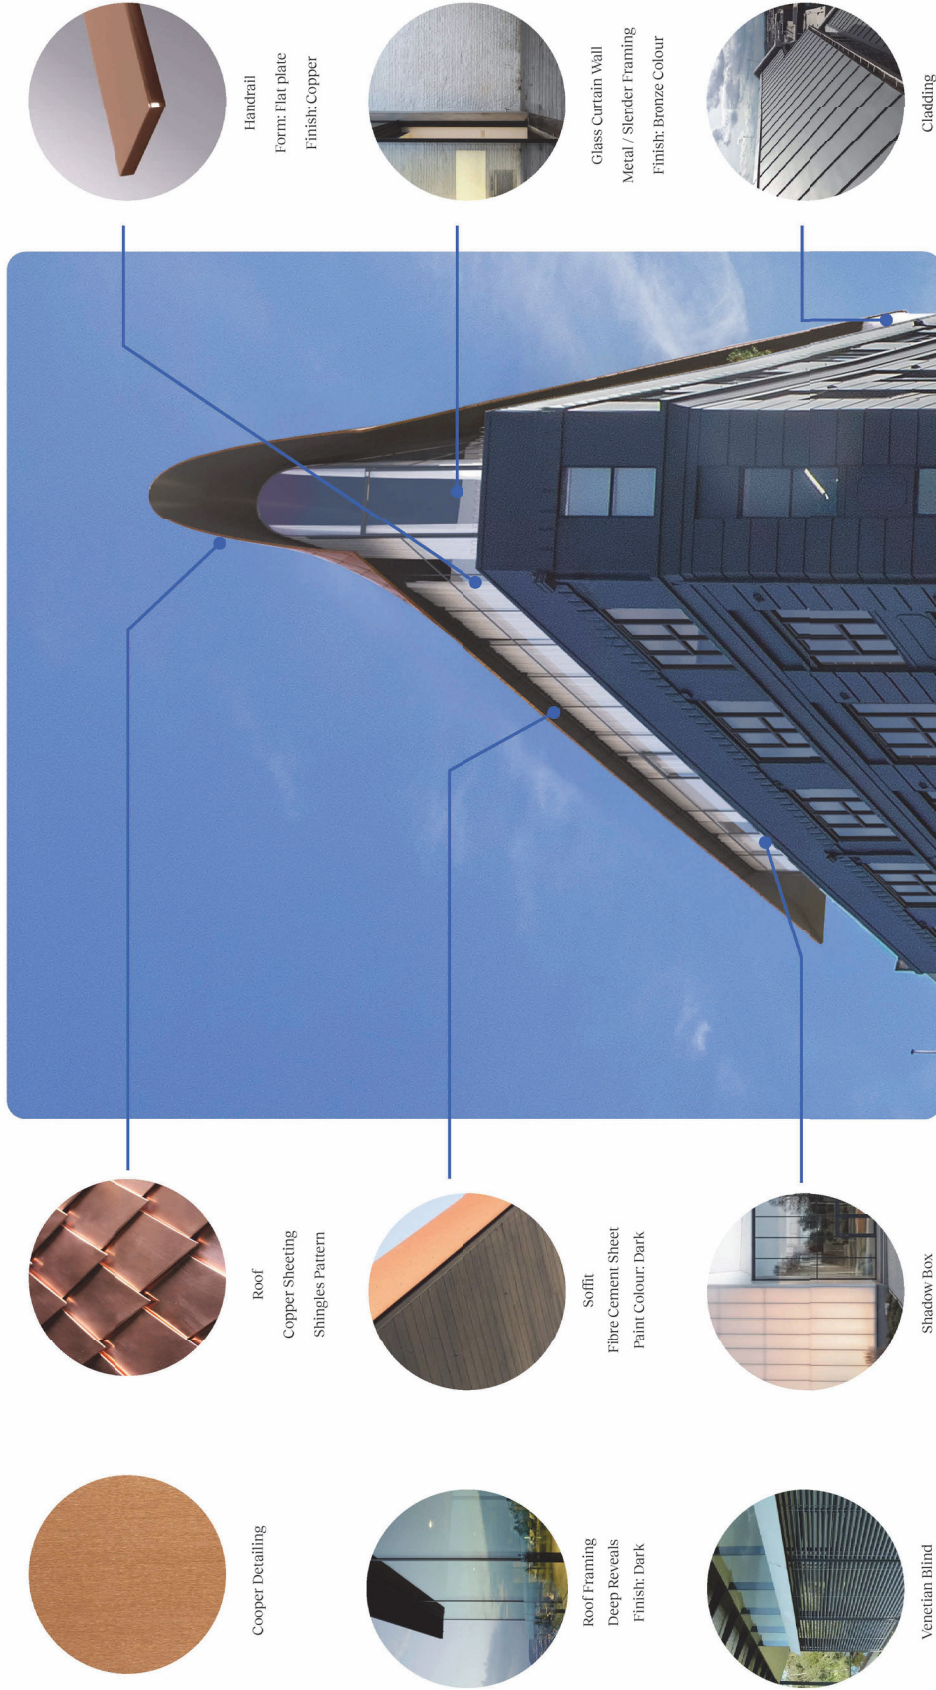

Copper Detailing

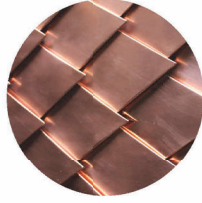


Roof
Copper Sheeting
Shingles Pattern

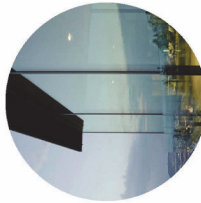

Roof Framing
Deep Reveals
Finish: Dark



Soffit
Fibre Cement Sheet
Paint Colour: Dark

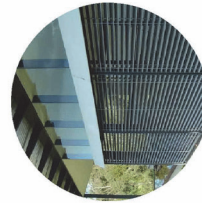

Venetian Blind
Metal
Finish: to match Curtain Wall



Shadow Box
Obscure Glass
Glass Colour: Frosted/White

SJB

The Penthouse

FOR APPROVAL

Architectural drawings are the property of SJB Architects Pty Ltd. All rights reserved. No part of this drawing may be reproduced, stored in a retrieval system, or transmitted in any form or by any means, electronic, mechanical, photocopying, recording, or by any information storage and retrieval system, without the prior written permission of SJB Architects Pty Ltd. This drawing is for your information only and is not to be used for any other purpose. It is not to be used for construction or for any other purpose without the prior written permission of SJB Architects Pty Ltd. This drawing is for your information only and is not to be used for any other purpose without the prior written permission of SJB Architects Pty Ltd.



Normalised Architecture Adam Fiddler P188 | John Pridie P204

Rev	Date	Revision	By	Ck
1	20.10.20	01.01.2020	BD	GS
2	20.10.20	01.01.2020	BD	GS
3	20.10.20	01.01.2020	BD	GS
4	20.10.20	01.01.2020	BD	GS
5	20.10.20	01.01.2020	BD	GS
6	20.10.20	01.01.2020	BD	GS
7	20.10.20	01.01.2020	BD	GS
8	20.10.20	01.01.2020	BD	GS
9	20.10.20	01.01.2020	BD	GS
10	20.10.20	01.01.2020	BD	GS

NOTE: THESE DRAWINGS ARE FOR INFORMATION ONLY AND ARE NOT TO BE USED FOR CONSTRUCTION. WHEN DRAWINGS ARE SUBMITTED, PREPARED FOR CONSTRUCTION PURPOSES AFTER THE GRANT OF DEVELOPMENT CONSENT.

XCOMMERCIAL

Project
AYUS PENTHOUSE
17 RANDLE STREET, SURRY HILLS, 2010, NSW

Client

Material Board

Date	Scale	Sheet Size
11.06.2026	A1	
Drawn	Ck	Job No.
BD	GS	7166
Drawing No.	Revised	
DA-8703	/6	

 
NOT FOR CONSTRUCTION

SJB Architects
Level 2, 480 Cowi Street
Surry Hills NSW 2010
Tel: 02 9000 9911
www.sjb.com.au



Scale: 1:100

Scale: 1:100




PLANT IMAGES

[illegible]

NOTE:
*Terrace planter to achieve a minimum soil depth of 500-600 mm for the establishment of grasses, groundcovers, and shrubs.
*Terrace walls to achieve a minimum soil depth of 700 mm for established plants.

984,410.00

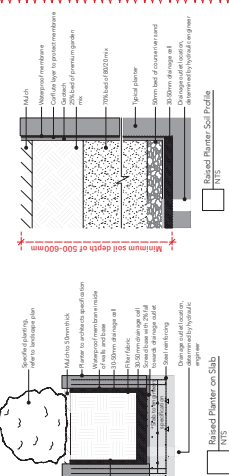

NOTES:	5. Drawing remains the property of Nelson Thomas. 6. All work scales from drawings. 7. Verify all measurements on site. 8. Notify Nelson Thomas of any inconsistencies. 9. Copyright Nelson Thomas. All rights reserved.
	9. For finishing purposes only. NOT FOR CONSTRUCTION UNLESS SPECIFIED. 10. Nelson Thomas must be present for on-site for the positioning of ALL PLANTS. 11. Contact designer if discrepancies occur between indicators & consultants. 12. All work to be performed by suitably qualified personnel.

	CLIENT DAVID BROWN	PROJECT ADDRESS 47 RANDLE ST, SURREY HILLS
---	---	---

DRAWING TITLE LANDSCAPE PLAN	DATE DRAWN 5/6/2026	SCALE 1:100 @ A1
	DRAWN BY SM	SHEET NO. DA001