


Proposal

Pitt and Albert Streets, Redfern Proposed parking changes

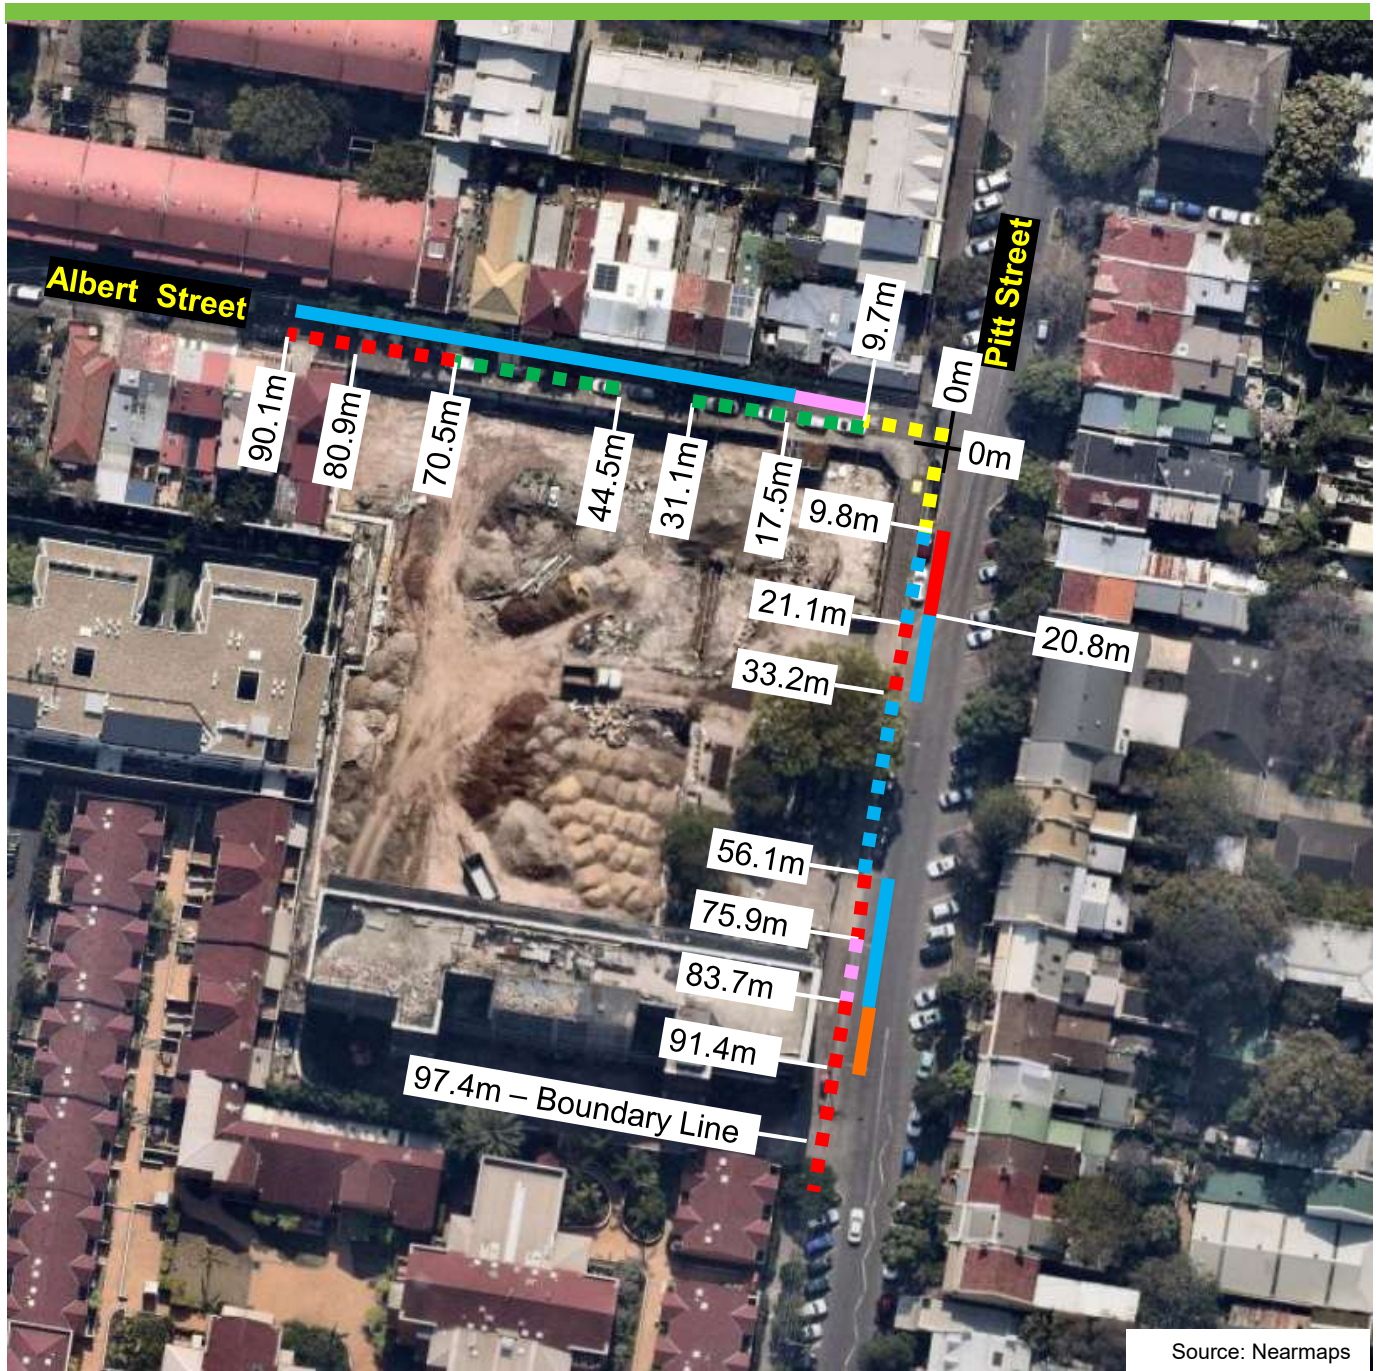

Existing

- Yellow line: "No Stopping"
- Red line: "No Parking"
- Green line: "2P 8am-8pm Mon-Fri, Permit Holders Excepted Area 41"
- Blue line: "2P 8am-10pm Mon-Fri, Permit Holders Excepted Area 41"

Existing

- Pink line: "No Parking Authorised Disabled Persons Vehicle Excepted"

Proposed

- Blue line: "2P 8am-10pm Mon-Fri, Permit Holders Excepted Area 41"
- Red line: "No Parking"
- Orange line: "Mail Zone"
- Pink line: "Disability Parking Only"

