


Attachment B

Selected Drawings

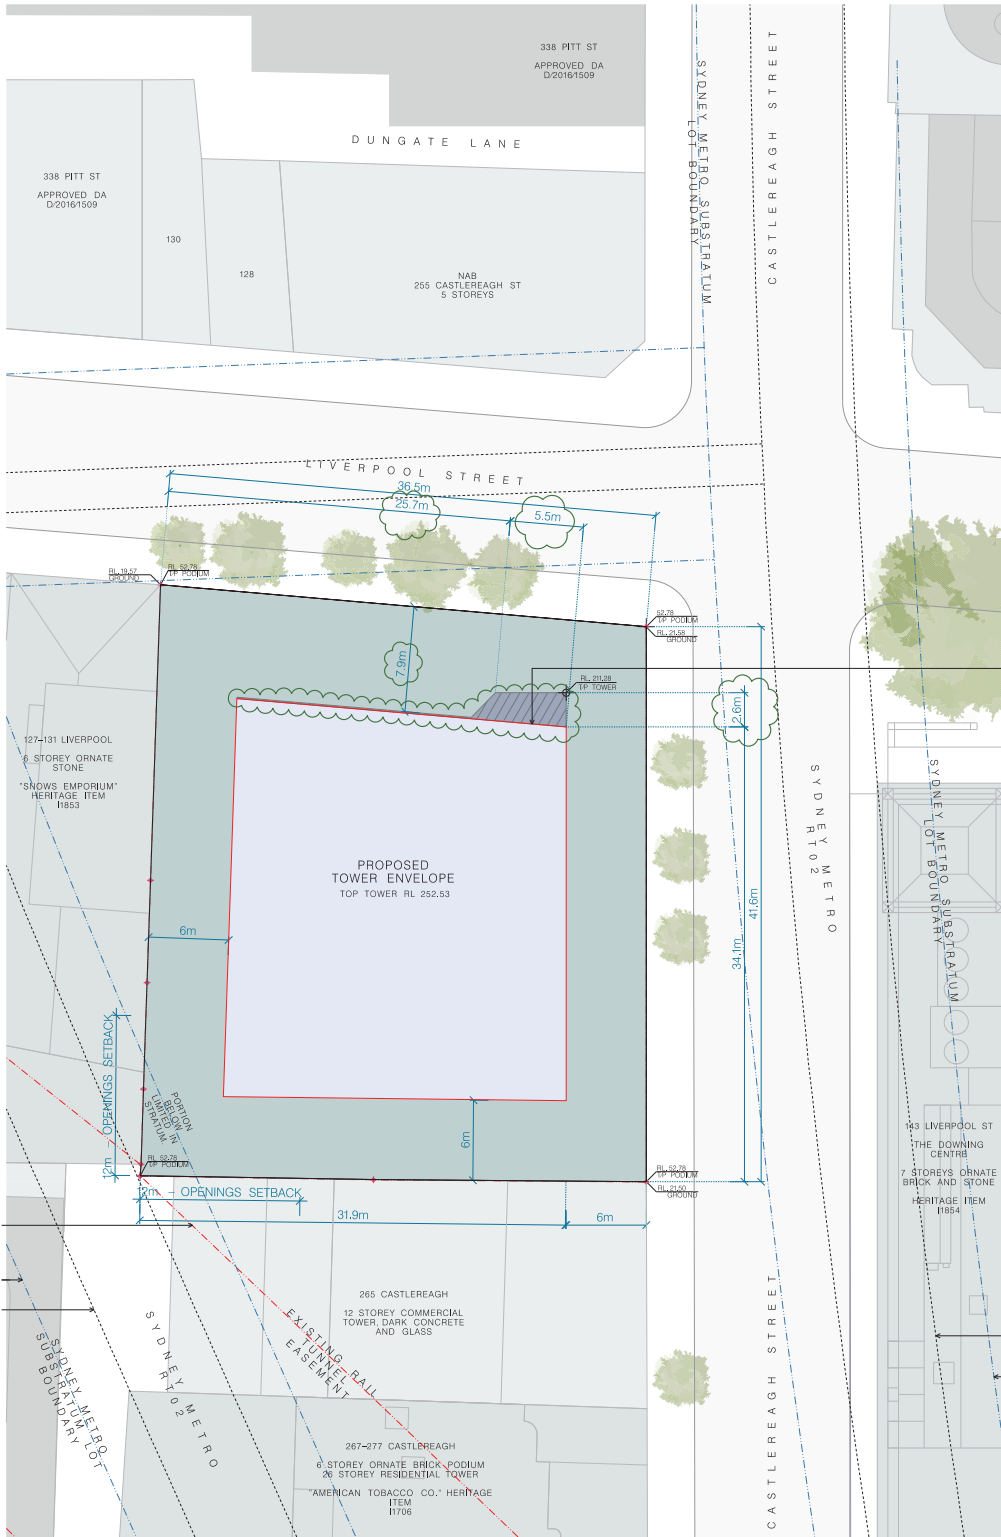

APPROVED TOWER ENVELOPE SHOWN IN RED

01 PLAN - BUILDING ENVELOPE
1:200 @ A1

- LEGEND:
- APPROVED TOWER ENVELOPE
 - APPROVED PODIUM ENVELOPE
 - EXISTING BUILDING TO BE DEMOLISHED
 - SITE BOUNDARIES
 - APPROVED TOWER ENVELOPE
 - PROPOSED MODIFICATION TO CONCEPT DA APPROVED TOWER ENVELOPE.

S4.55 ISSUE M
- SCHEDULE OF KEY AMENDMENTS

1. INFORMATION RELATING TO RAIL EASEMENTS & SUBSTATION LOTS SOURCED FROM PROJECT SURVEY PREPARED BY VEIRS DATED 05.04.2019
 2. INFORMATION RELATING TO EXISTING RAIL INFRASTRUCTURE SOURCED FROM PROJECT SURVEY PREPARED BY VEIRS DATED 05.04.2019 (REF: 2000098).
 3. INFORMATION RELATING TO PROPOSED SYDNEY METRO TUNNELS SOURCED FROM DRAWINGS SUPPLIED BY TRANSPORT FOR NSW, DATED 02.05.2018
- MINOR MODIFICATION OF TOWER ENVELOPE TO NORTH FACADE:


FOR STAGE 1 DA ONLY
NOT FOR CONSTRUCTION
COPYRIGHT
30

PROJECT: 133 LIVERPOOL STREET, SYDNEY
ARCHITECT: CANDALEPAS ASSOCIATES
309 SUSSEX STREET
SYDNEY NSW 2008
CLIENT: DEICORP
SCALE: 1:500 (B&A) / 1:500 (B&G)
DATE: JUNE 2022
CHKD BY: BM
CHWD SHIPPED: ACU
DRAWN BY: BM


DATE: JUNE 2022
CHKD BY: BM
CHWD SHIPPED: ACU
DRAWN BY: BM

DRAWING No. DA -1 - 1100
ISSUE M
JOB No. 5087



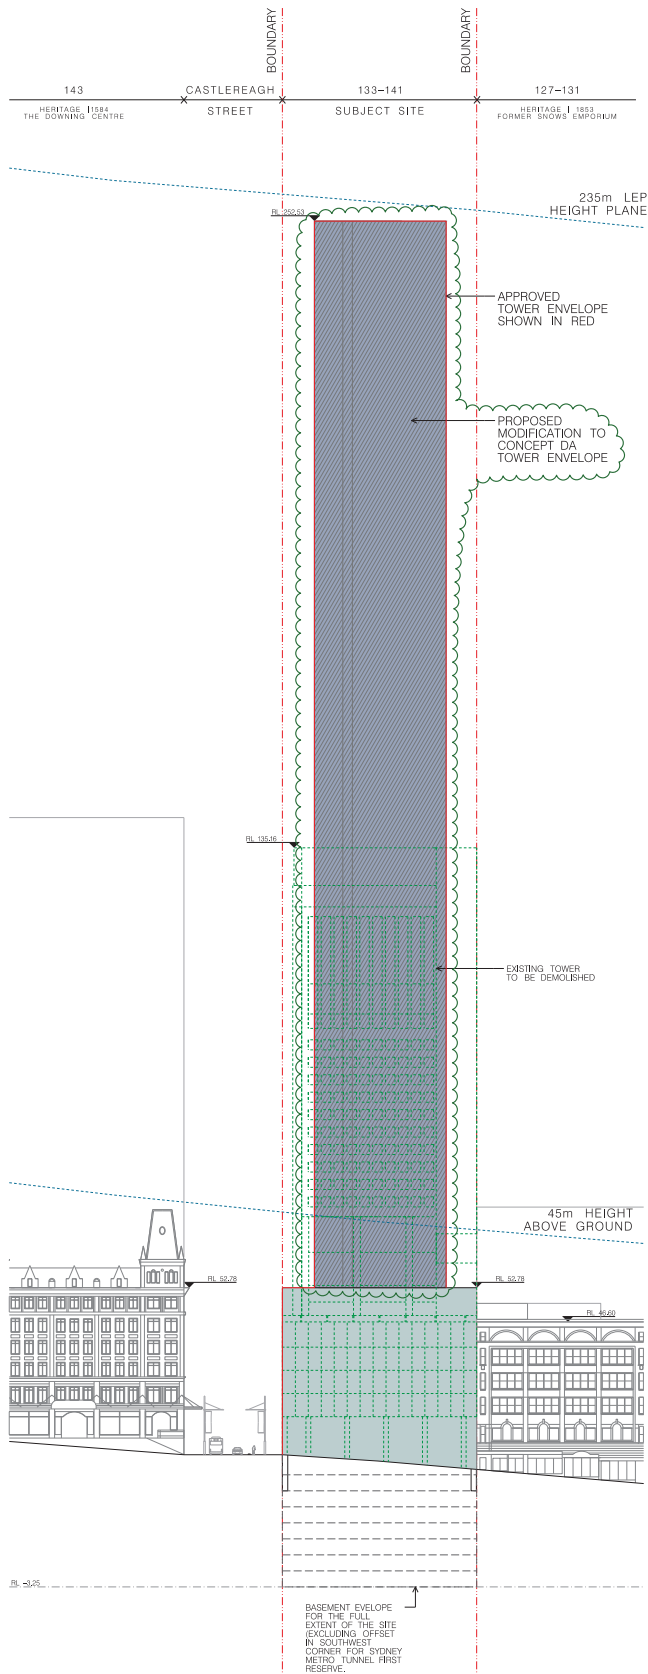

01 ENVELOPE ELEVATION - NORTH
1:500 @ A1

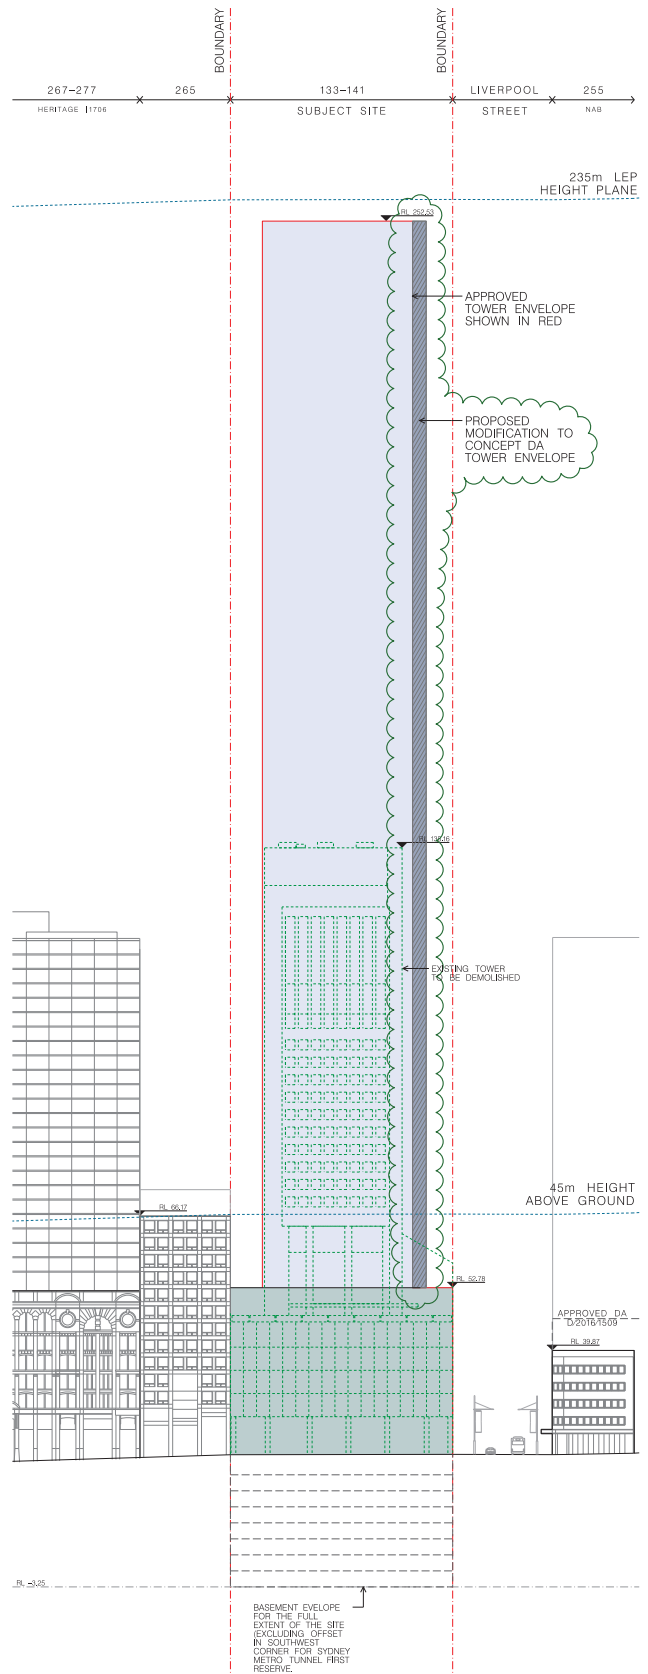

02 ENVELOPE ELEVATION - EAST
1:500 @ A1

- LEGEND:
- PROPOSED TOWER ENVELOPE
 - APPROVED PODIUM ENVELOPE
 - EXISTING BUILDING TO BE DEMOLISHED
 - SITE BOUNDARIES
 - APPROVED TOWER ENVELOPE
 - PROPOSED MODIFICATION TO CONCEPT DA APPROVED TOWER ENVELOPE.

S4.55 ISSUE M
- SCHEDULE OF KEY AMENDMENTS

MINOR MODIFICATION OF TOWER ENVELOPE TO NORTH FACADE:

FOR STAGE 1 DA ONLY
NOT FOR CONSTRUCTION
COPYRIGHT

31


ARCHITECT:
CANDALEPAS
ASSOCIATES
309 SUSSEX STREET
SYDNEY NSW 2000
TEL: 002 9233 7755
TEL: 002 9233 7417
E: can@canpas.com.au
WWW: ARCHITECTS.NSW.NZ

PROJECT:
133 LIVERPOOL STREET, SYDNEY
CLIENT:
DEICORP
SCALE: 1:500 @ A1/1:1000 @ A3


DATE:
JUNE 2022
CHKD BY:
CHND 28/06/22
ACU:
DRAWING No.
DA -1- 1301

DRAWING:
BUILDING
ENVELOPE -
NORTH & EAST
ELEVATION
ISSUE
M

5087

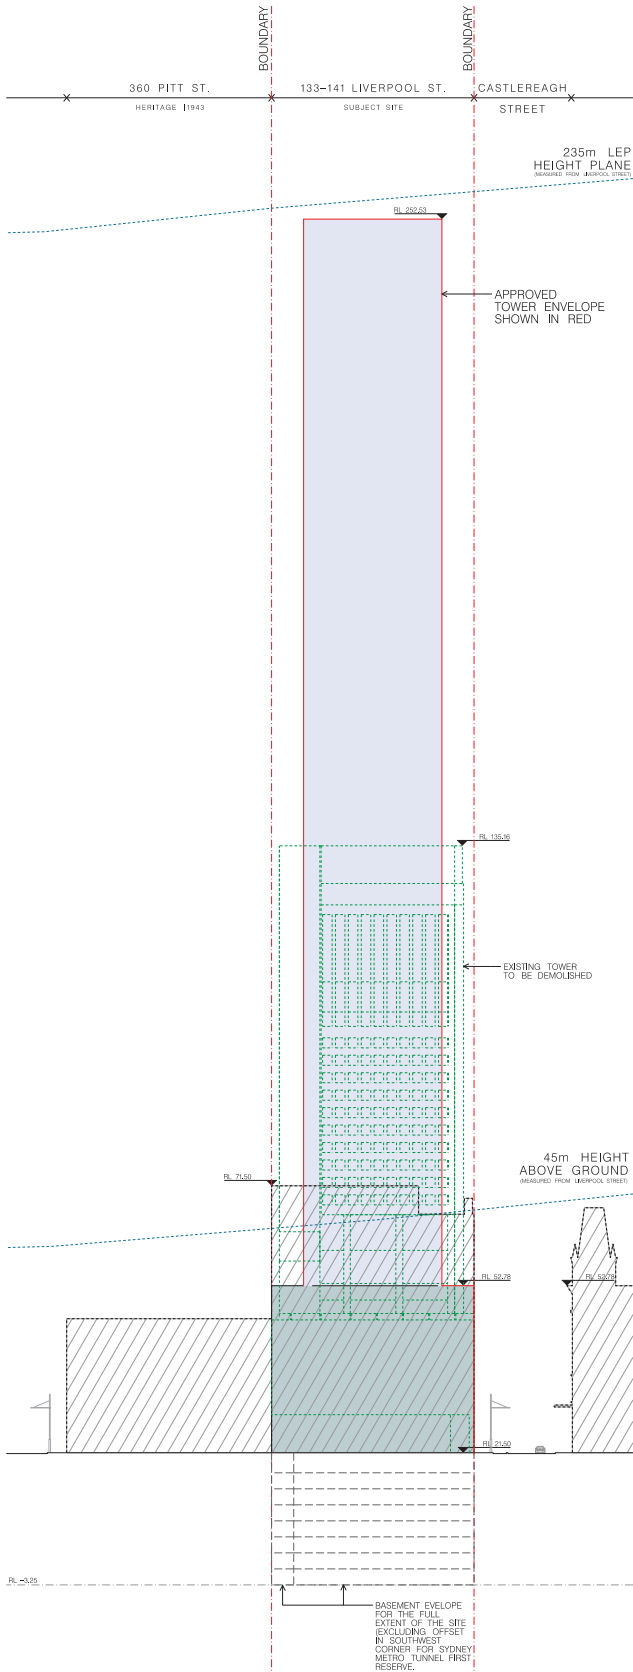

01 SOUTH ELEVATION
1:500 @ A1

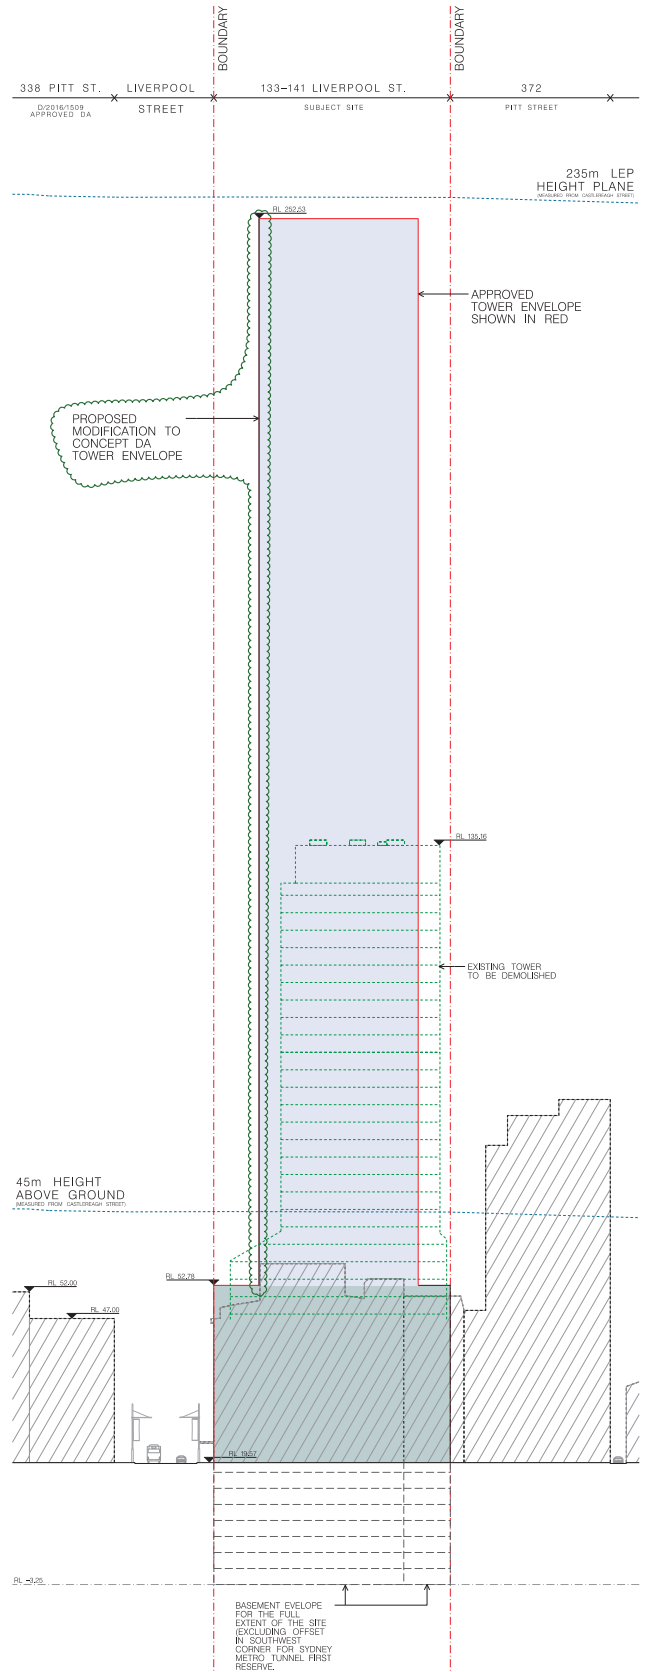

02 WEST ELEVATION
1:500 @ A1

- LEGEND:
- PROPOSED TOWER ENVELOPE
 - APPROVED PODIUM ENVELOPE
 - EXISTING BUILDING TO BE DEMOLISHED
 - SITE BOUNDARIES
 - APPROVED TOWER ENVELOPE
 - PROPOSED MODIFICATION TO CONCEPT DA APPROVED TOWER ENVELOPE.

S4.55 ISSUE M
- SCHEDULE OF KEY AMENDMENTS

M MINOR MODIFICATION OF TOWER ENVELOPE TO NORTH FACADE:

32

FOR STAGE 1 DA ONLY
NOT FOR CONSTRUCTION
COPYRIGHT

ARCHITECT:
CANDALEPAS
ASSOCIATES
309 SUSSEX STREET
SYDNEY NSW 2009
TEL: 6053 7755
TEL: 6053 7411
E: candalepas@cadalepas.com.au
WWW.ARCHITECTSREB.NSW.AU

PROJECT:
133 LIVERPOOL STREET, SYDNEY
CLIENT:
DEICORP
SCALE: 1:500 @ A1/1:1000 @ A3

DATE:
JUNE 2022
CHKD BY:
BM
CHKD 28/06/22
ACU
DRAWING No.
DA -1 - 1302
ISSUE
M

DRAWING
BUILDING
ENVELOPE -
SOUTH & WEST
ELEVATIONS
JOB No.
5087