## **Attachment B1**

## **Selected Drawings**

## THE MINERVA



A 000 GE	NERAL INFORMATION		Scale @ A1	Current Revis	ion ID
A-000 GEI	COVER PAGE			F	7
A-001	SITE PLAN		1:500		<del>/</del>
A-002	SITE ANALYSIS		1:500	-	
A 050 DEN	NOLITION PLANS				
A-050	BASEMENT 3 & 4 DEMOLITION I	PLAN	1:100	А	
A-051	BASEMENT 2 DEMOLITION PLA	N	1:100	В	
A-052	BASEMENT 1 DEMOLITION PLA	N	1:100	В	
A-053	GROUND DEMOLITION PLAN		1:100	С	
A-054	LEVEL 1 DEMOLITION PLAN		1:100	С	
A-055	LEVEL 2 DEMOLITION PLAN		1:100	-	
A-056	LEVEL 3 DEMOLITION PLAN		1:100	-	
A-057 A-058	LEVEL 4 DEMOLITION PLAN  LEVEL 5 DEMOLITION PLAN		1:100	-	
A-056 A-059	ROOF DEMOLITION PLAN		1:100	-	
	MOLITION REFLECTED CEILING PLA	ΔNS	1.100		
A-060	GROUND RCP DEMOLITION	1110	1:100	A	
A-061	LEVEL 1 RCP DEMOLITION		1:100	-	
A-062	LEVEL 3 RCP DEMOLITION		1:100	-	
A 070 DEN	MOLITION ELEVATIONS				
A-070	DEMOLITION SOUTH ELEVATIO	N	1:100	А	
A-071	DEMOLITION NORTH ELEVATIO	N	1:100	А	
A-072	DEMOLITION EAST ELEVATION		1:100	В	
A-073	DEMOLITION WEST ELEVATION		1:100	-	
A 080 DE	MOLITION SECTIONS				
A-080	LONG SECTION DEMOLITION		1:100	С	
A-081	CROSS SECTION A DEMOLITION	V	1:100	С	
	NERAL ARRANGEMENT PLANS				
A-100	BASEMENT 4 FLOOR PLAN		1:100	A	
A-101	BASEMENT 3 FLOOR PLAN		1:100	C E	<del></del>
A-102	BASEMENT 2 FLOOR PLAN		1:100	F	<u>)                                    </u>
A-103	BASEMENT 1 FLOOR PLAN		1:100	E .	<del></del>
A-104	GROUND FLOOR PLAN		1:100		$\leftarrow$
A-105	LEVEL 1 PLAN		1:100	G	$\rightarrow$
A-106 A-107	LEVEL 2 PLAN LEVEL 3 PLAN		1:100	D	$\rightarrow$
A-108	LEVEL 4 PLAN		1:100	E	<del>)</del>
A-109	LEVEL 5 PLAN		1:100	F	<del></del>
A-110	LEVEL 6 PLAN		1:100	F E	$\rightarrow$
A-111	ROOF PLAN		1:100	- D	$\dashv$
	POSED CEILING PLANS			The state of the s	7
A-121	AUDITORIUM RCP PROPOSED (	GROUND FI	LOOR - LEVEL 3 1:100	С	
A 200 ELE	VATIONS				
A-200	SOUTH ELEVATION		1:100	D	
A-201	SOUTH ELEVATION FLYTOWER	FACADE	1:100	<b>△</b> ►	
A-202	NORTH ELEVATION		1:100	E	
A-203	NORTH ELEVATION FLYTOWER	FACADE	1:100	F F	<u> </u>
A-204	EAST ELEVATION		1:100	E	₹
A-205	EAST ELEVATION FLYTOWER FA	ACADE	1:100	E	<del>}</del>
A-206	WEST ELEVATION		1:100		
A-207	WEST ELEVATION FLYTOWER F		1:100	С	
A-208	WEST ELEVATION INNER FACAI	DE	1:100	D	
	EVATION SIGNAGE	TI EVATION	4.400		
A-210	SIGNAGE STRATEGY - SOUTH E		1:100	C	
A-211 <b>A 300 SE</b> 0	SIGNAGE STRATEGY - EAST EL	EVAITON	1:100	D	
A-300 SEC	LONGITUDINAL SECTION 1		1:100	E	
A-300 A-301	CROSS SECTION 1		1:100		
A-302	CROSS SECTION 2		1:100		
A-303	LONGITUDINAL SECTION 2		1:100	F	<del>)                                    </del>
A-304	LONGITUDINAL SECTION 3		1:100	LEV	<del>)</del>
A-305	CROSS SECTION 3		1:100	E	
A-306	SECTION: SUN SHADOW ANALY	'SIS	1:1	Α	
A 400 PEF	RSPECTIVES & SAMPLE BOARD				
A-403	PERSPECTIVE IMAGES - 4			-	
A 500 SHA	ADOW DIAGRAMS				
A-500	SHADOW DIAGRAMS - 21 JUNE	- 1 of 2		В	
A-501	SHADOW DIAGRAMS - 21 JUNE	- 2 of 2		В	
	HEDULES & DIAGRAMS			$\sim$	<b></b>
A-600	GFA DIAGRAMS			E	
A-601	MATERIALS BOARD				
A-602	FLYTOWER WINDOW SCHOULE		1:100	E	
A-603	FLYTOWER WINDOW SCHEDUL	.∟ KOOM AI	REA PLANS 1:200	B	
A-604	LED VO DDODOGED HEIGHT CO	MDADIOO		-	<b>—</b>
A-605 A-606	LEP VS PROPOSED HEIGHT CC 22m HEIGHT PLANE	//VIFAKISUN		A .	<del></del>
				ζ,	7
LEGE					<u> </u>
Code CO2	Description  Class 2 off form concrete	GL3 LWC1	Glass, privacy	PF3 PF4	Paint Finish, ty
FH	Fire hydrant	LWC2	Lightweight cladding, type 1  Lightweight cladding, type 2	PF4 RDP	Paint Finish, ty Roller door, pe
FHR	Fire hose reel	MB	Metal, brass	SPP	Steel plate, pa
GCB	Glass, colour backed	MLF	Louvre, metal, fixed	X	Existing
GDS	Glass door	MLO	Louvre, metal, operable	XD	Existing door

DATE	REV	DESCRIPTION:
22.JUL.2021	-	DEVELOPMENT APPLICATION
17.SEP.2021	Α	DEVELOPMENT APPLICATION
03.JUN.2022	В	DEVELOPMENT APPLICATION
18.NOV.2022	С	DEVELOPMENT APPLICATION
29.NOV.2022	D	DEVELOPMENT APPLICATION
01 MAR 2023	E	DEVELOPMENT APPLICATION
16 AUG 2023	F	DEVELOPMENT APPLICATION

NOTES: Do not scale off drawings. Use figured dimensions only. Report any discrepencies Email: michael@abeconsulting.com.au Email: benw@pwna.com.au to the architect. These designs, plans, specifications and the copyright therein are Sky Monkey the property of Tonkin Zulaikha Greer Architects Pty Ltd, and must not be reproduced or copied wholly or in part without written permission of Tonkin Zulaikha

Polygenic
Phone: 0404 616 473 Greer Architects Pty Ltd.

ABE Consulting Phone: 0415 522 533 DRONE PHOTOGRAPHER MODELMAKER (DIGITAL/PHYSICAL) SERVICES ENGINEERS

Email: sgreen@polygenic.com.au

Pulse White Noise Acoustics Phone: 0408 728 303 ESD CONSULTANT Phone: 0404 025 747 Email: Kelvin.Ong@skymonkey.com.au | Email: digby@climatewisedesign.com.au | Email: jason@innovaservices.com.au

**Evolved Engineering** 

Phone: 0409 398 832

Phone: 9568 6093

FIRE ENGINEERING

Innova Fire Engineering

Phone: 1300 88 22 62

Phone: 0455 513 077

Phone: 02 9418 1444 GEOTECHNICAL ENGINEER Phone: 02 9516 0722 Email: richard.sanchez@eiaustralia.com.au STRUCTURAL/CIVIL ENGINEER SURVEYOR Phone: 0412 335 173 Email: henry@evolvedengineering.com.au Email: george.agamalis@bgeng.com Email: nik@geosurv.com.au

Mogamma Phone: 0430 394 645 **Concise Certification** Polymer Studios Phone: 0423 424 161 Phone: 1300 259 732 Email: peter@mogamma.com.au HERITAGE Tonkin Zulaikha Greer Certified Energy Phone: 9215 4900 Phone: 02 9159 3932 Phone: 02 8571 2900 Email: jobs@certifiedenergy.com.au Email: julie@tzg.com.au TRANSPORT ENGINEER TOWN PLANNER The Transport Planning Partnership Planning Lab Phone: 0447 755 799 Phone: 0418 601 094 Phone: 0435 338 245

Email: jason.rudd@ttpp.net.au

Email: giovanni@planninglab.com

Email: andy@polymerstudios.com.au LANDSCAPE ARCHITECT Email: liamm@arcadiala.com.au VIEW LOSS ASSESSMENT WASTE CONSULTANT

Email: dan@urbaine.com.au

Elephant's Foot

Phone: 02 9780 3573

Email: whitney.brunson@elephantsfoot.com.au

**Central Element** Phone: (02) 9957 5019 Email: dlavigne@centralelement.com.au

PROJECT NO: 20024

THE MINERVA TONKIN ZULAIKHA GREER ARCHITECTS 117 Reservoir Street ABN: 46002722349 P: (02) 9215 4900 F: (02) 9215 4901 EMAIL info@tzg.com.au WEB www.tzg.com.au

Glass door, sliding

Glass, clear


Glass, tinted


Existing paint finish Metal screen, brass, perforated Paint finish, type 1, to match existing XW Existing window Paint finish, type 2, to match existing DRAWN BY DRAWING TITLE TS, TL COVER PAGE CHECKED 16/8/2023


DRAWING NO


DEVELOPMENT APPLICATION


REV

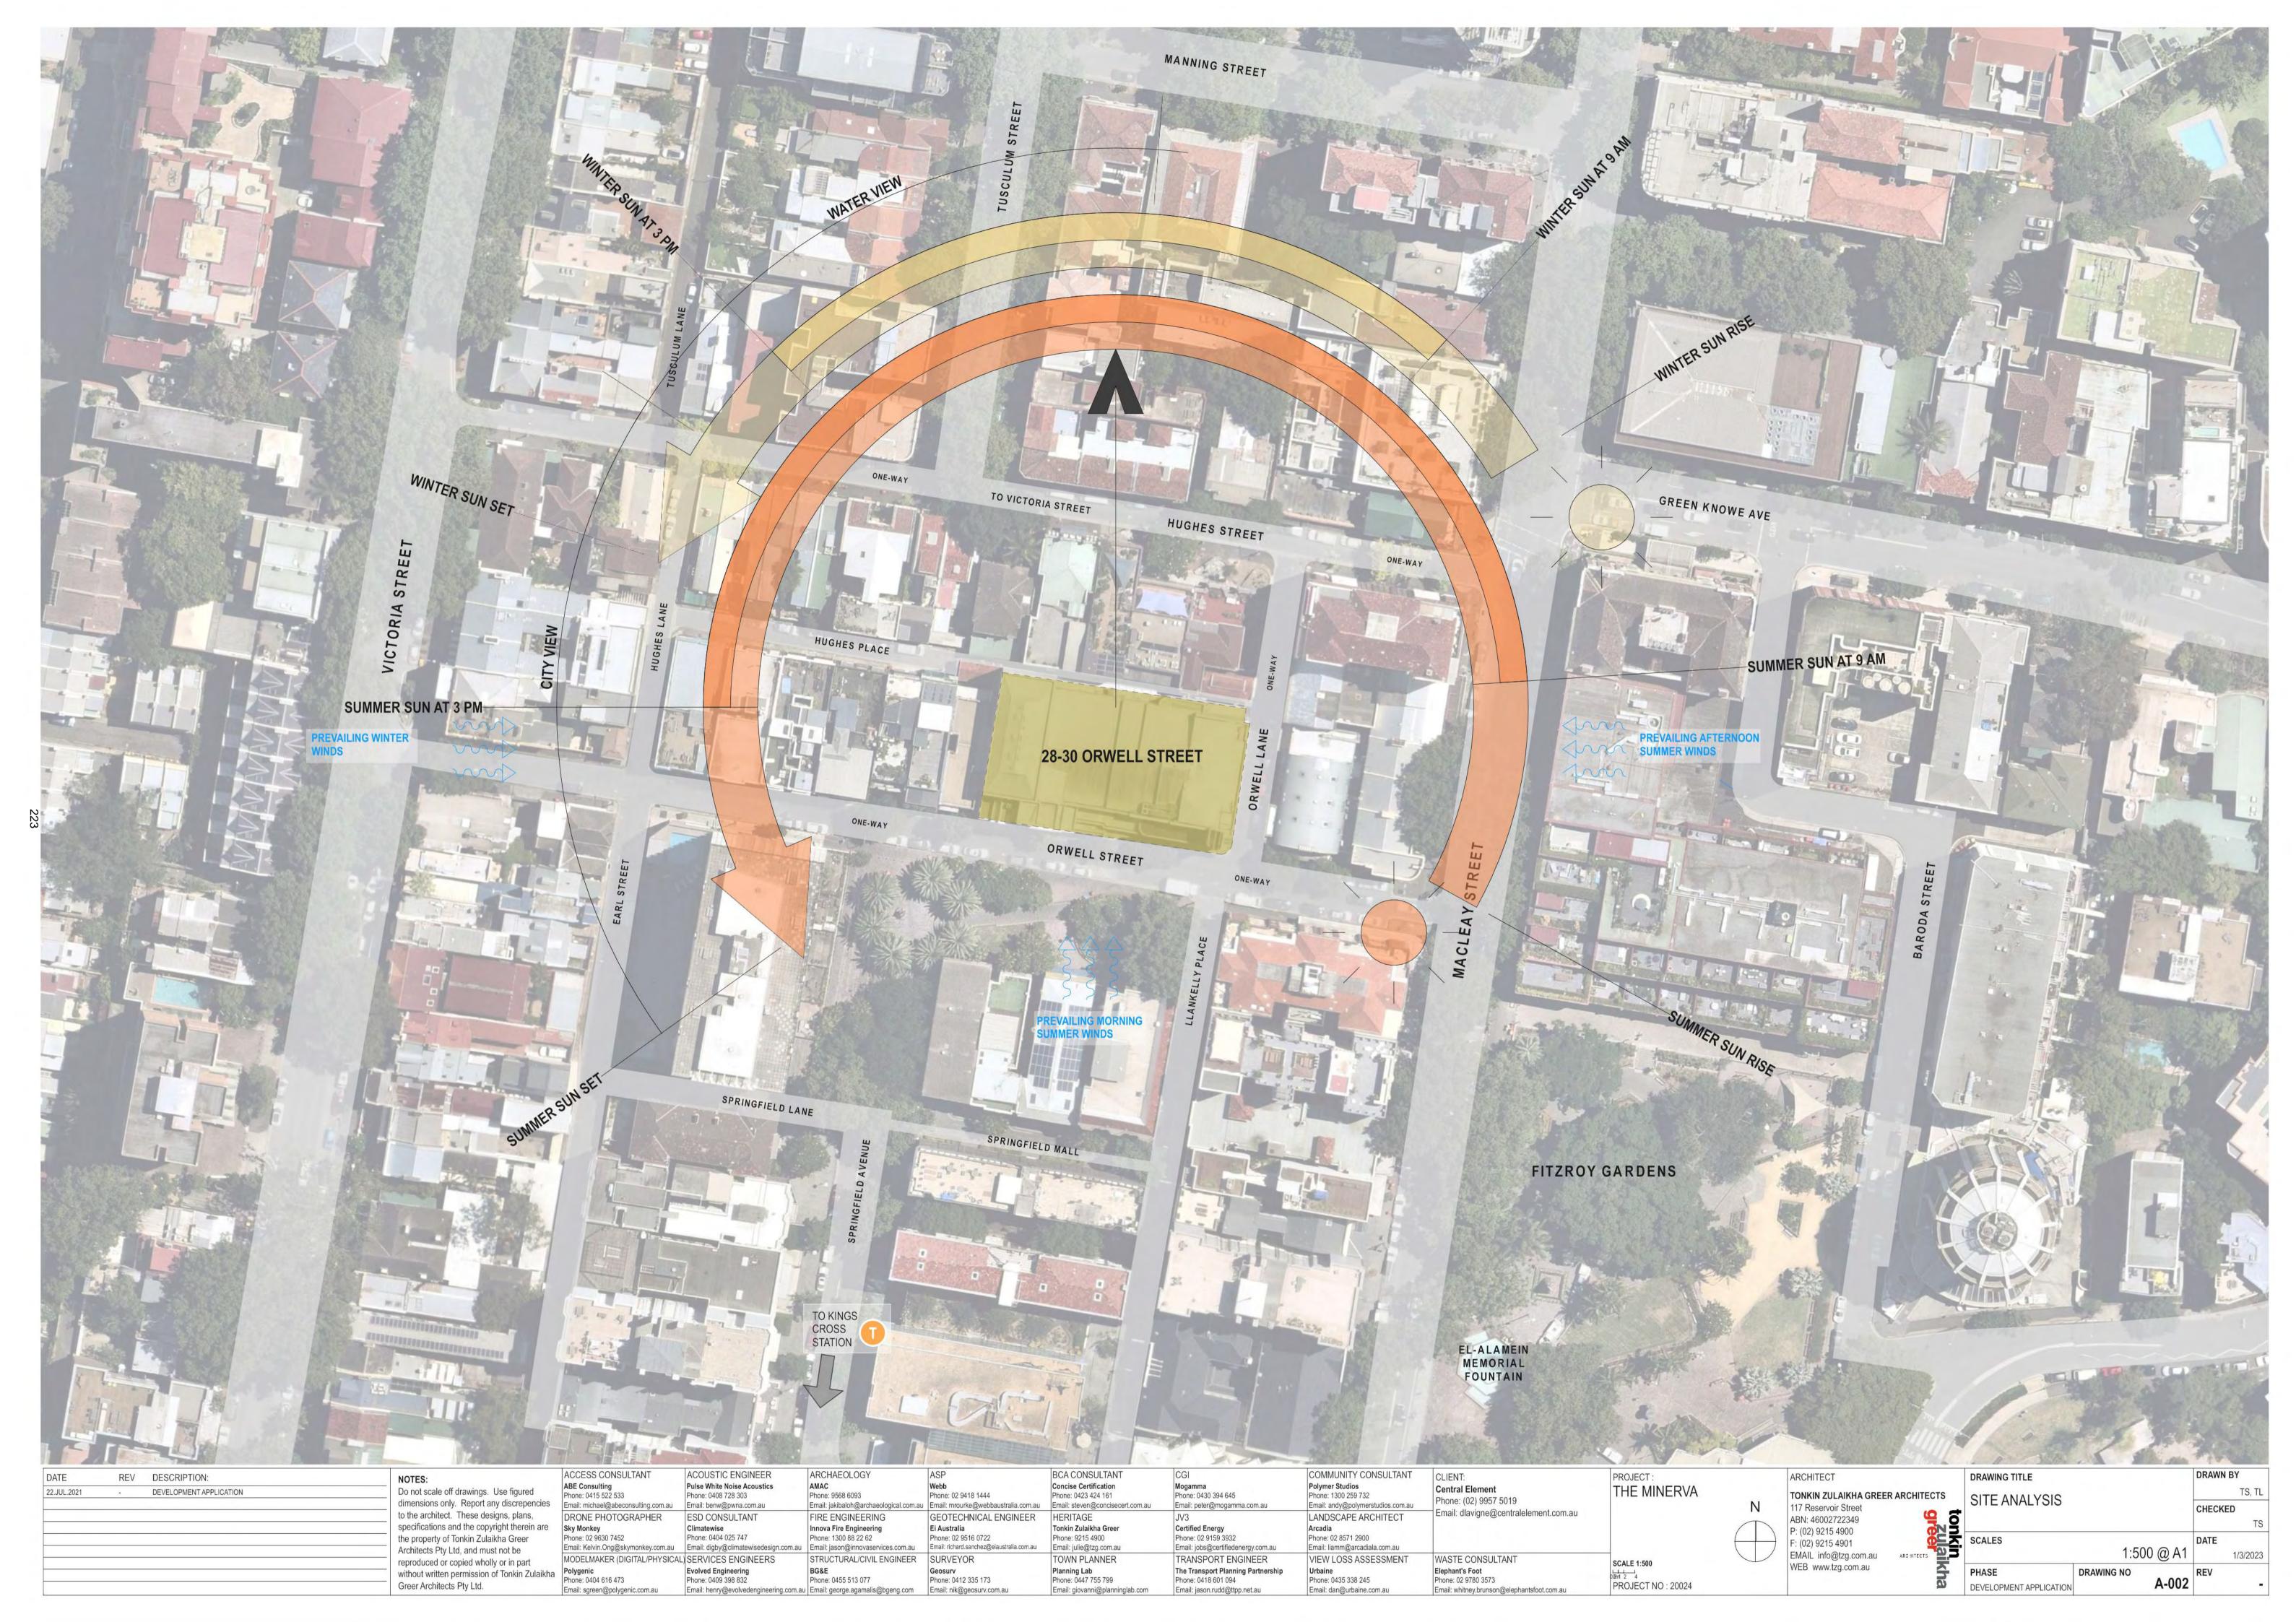


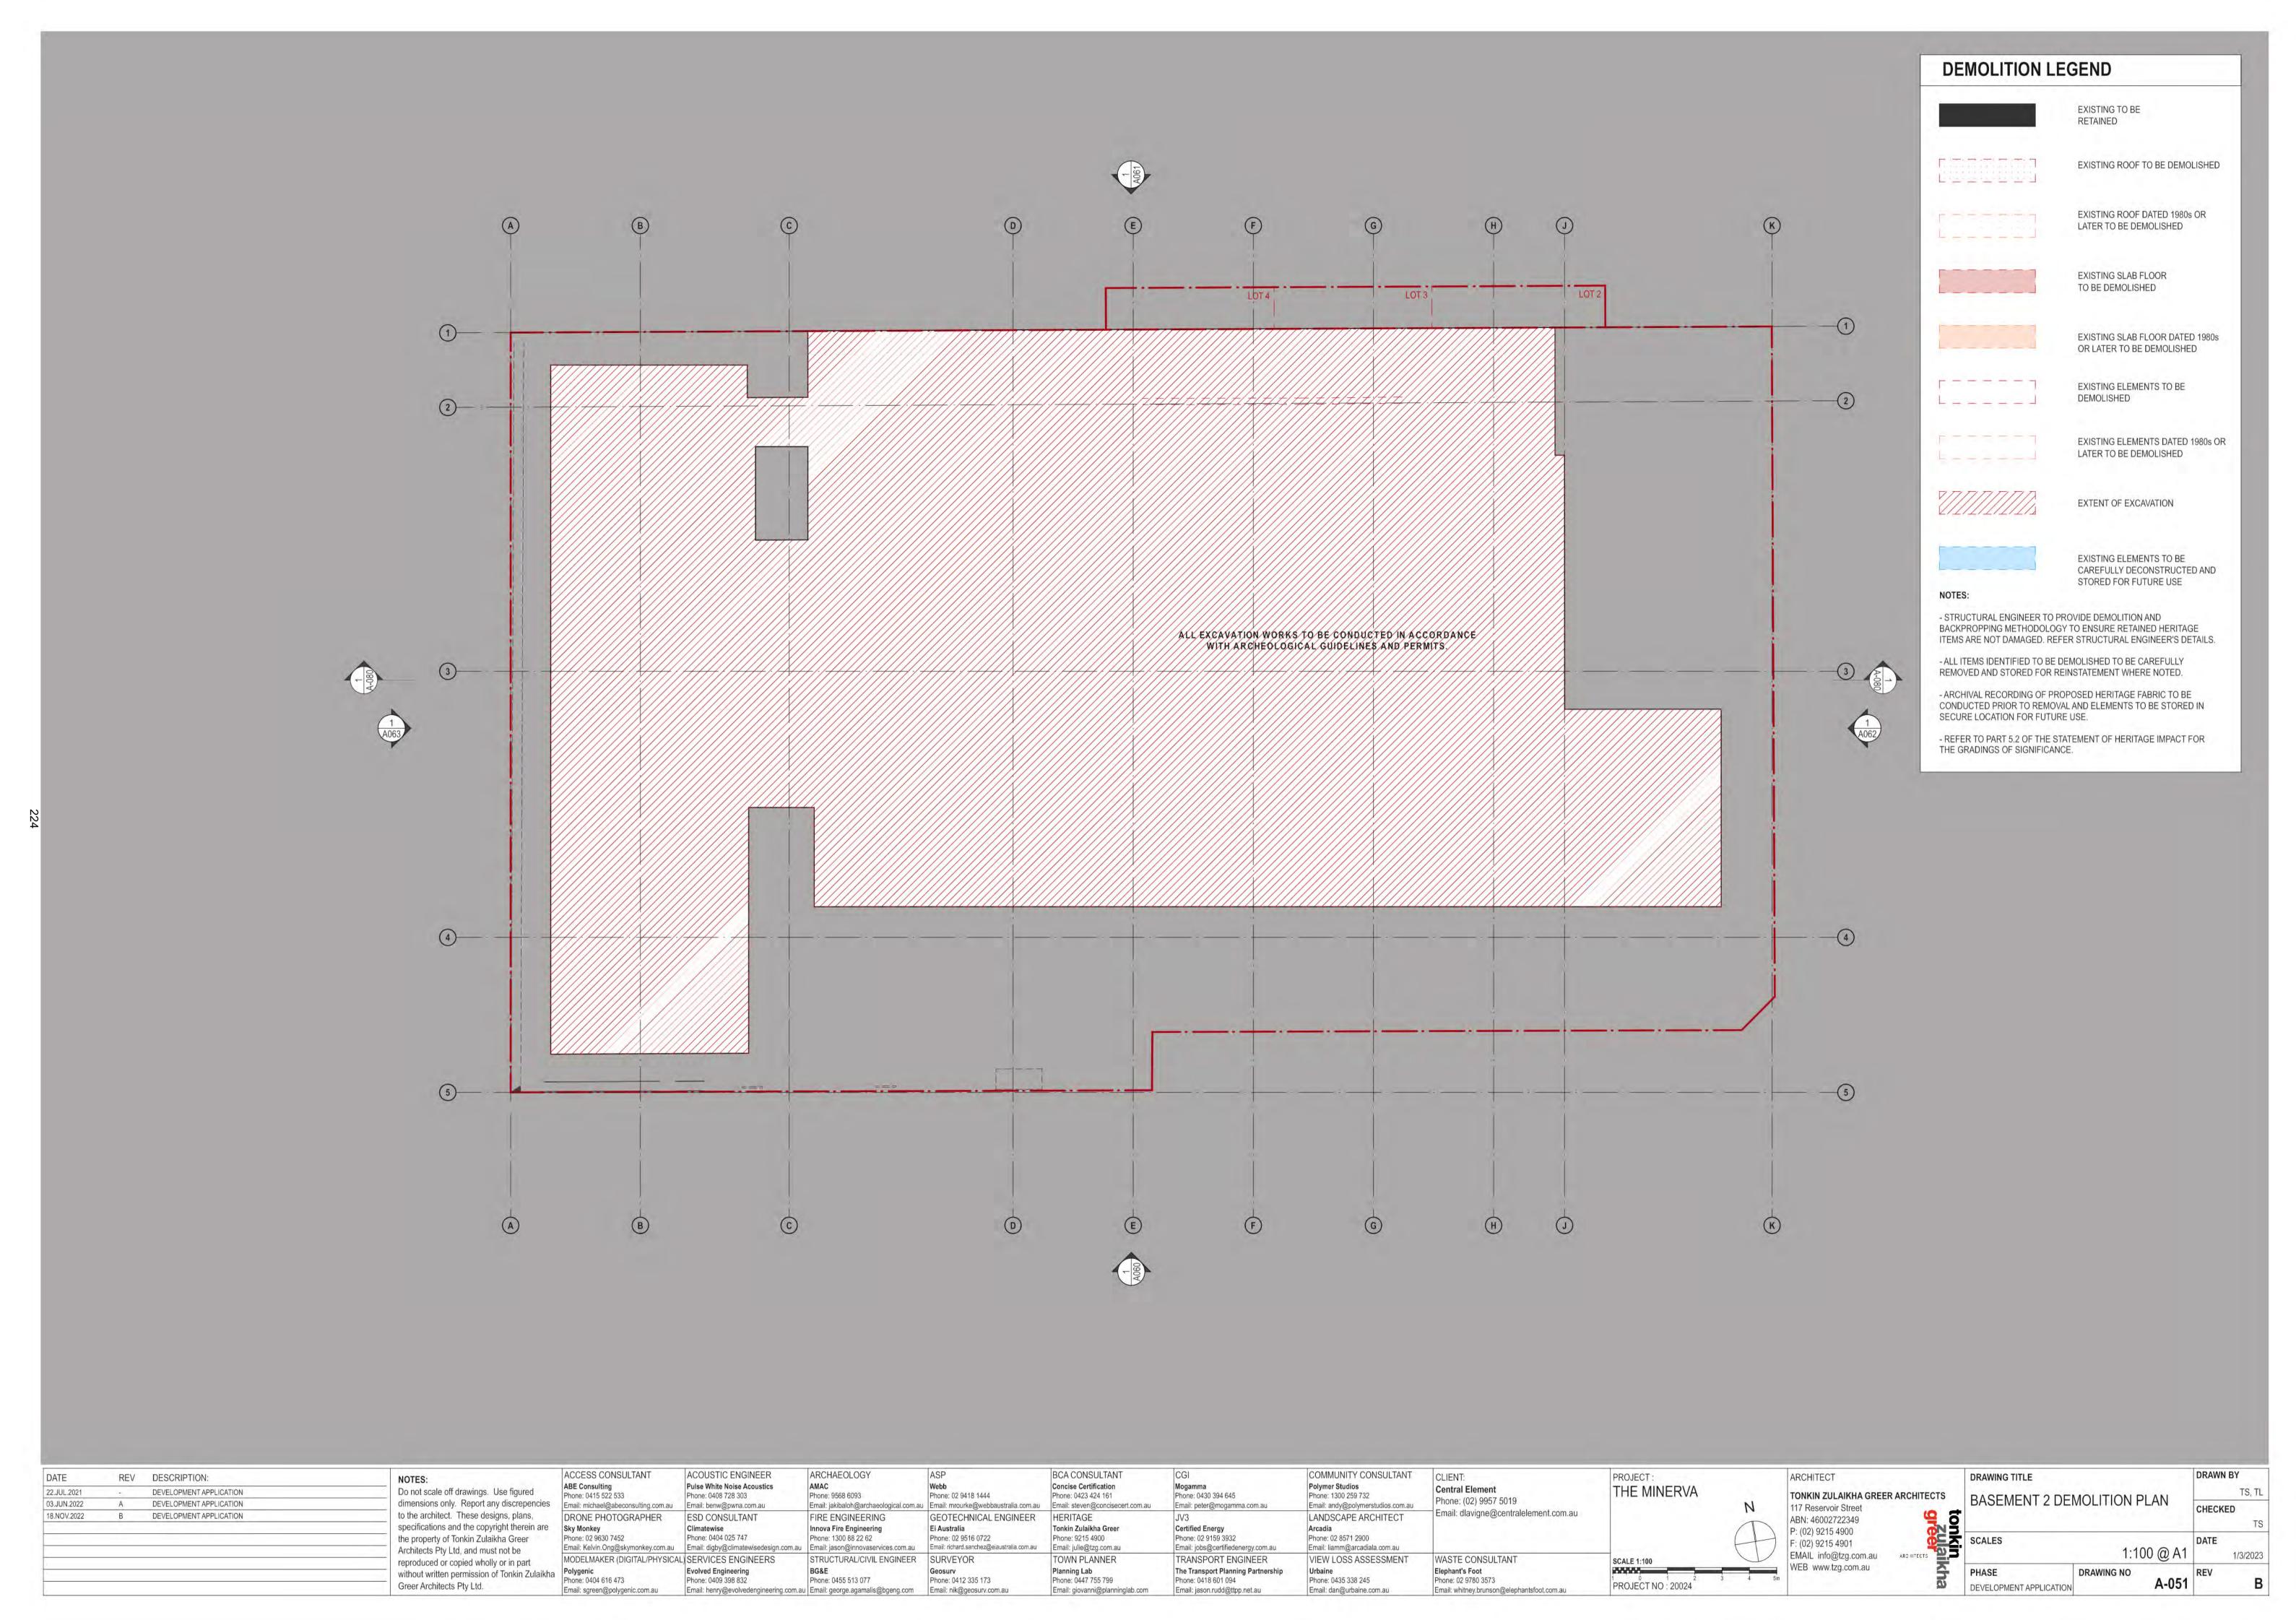


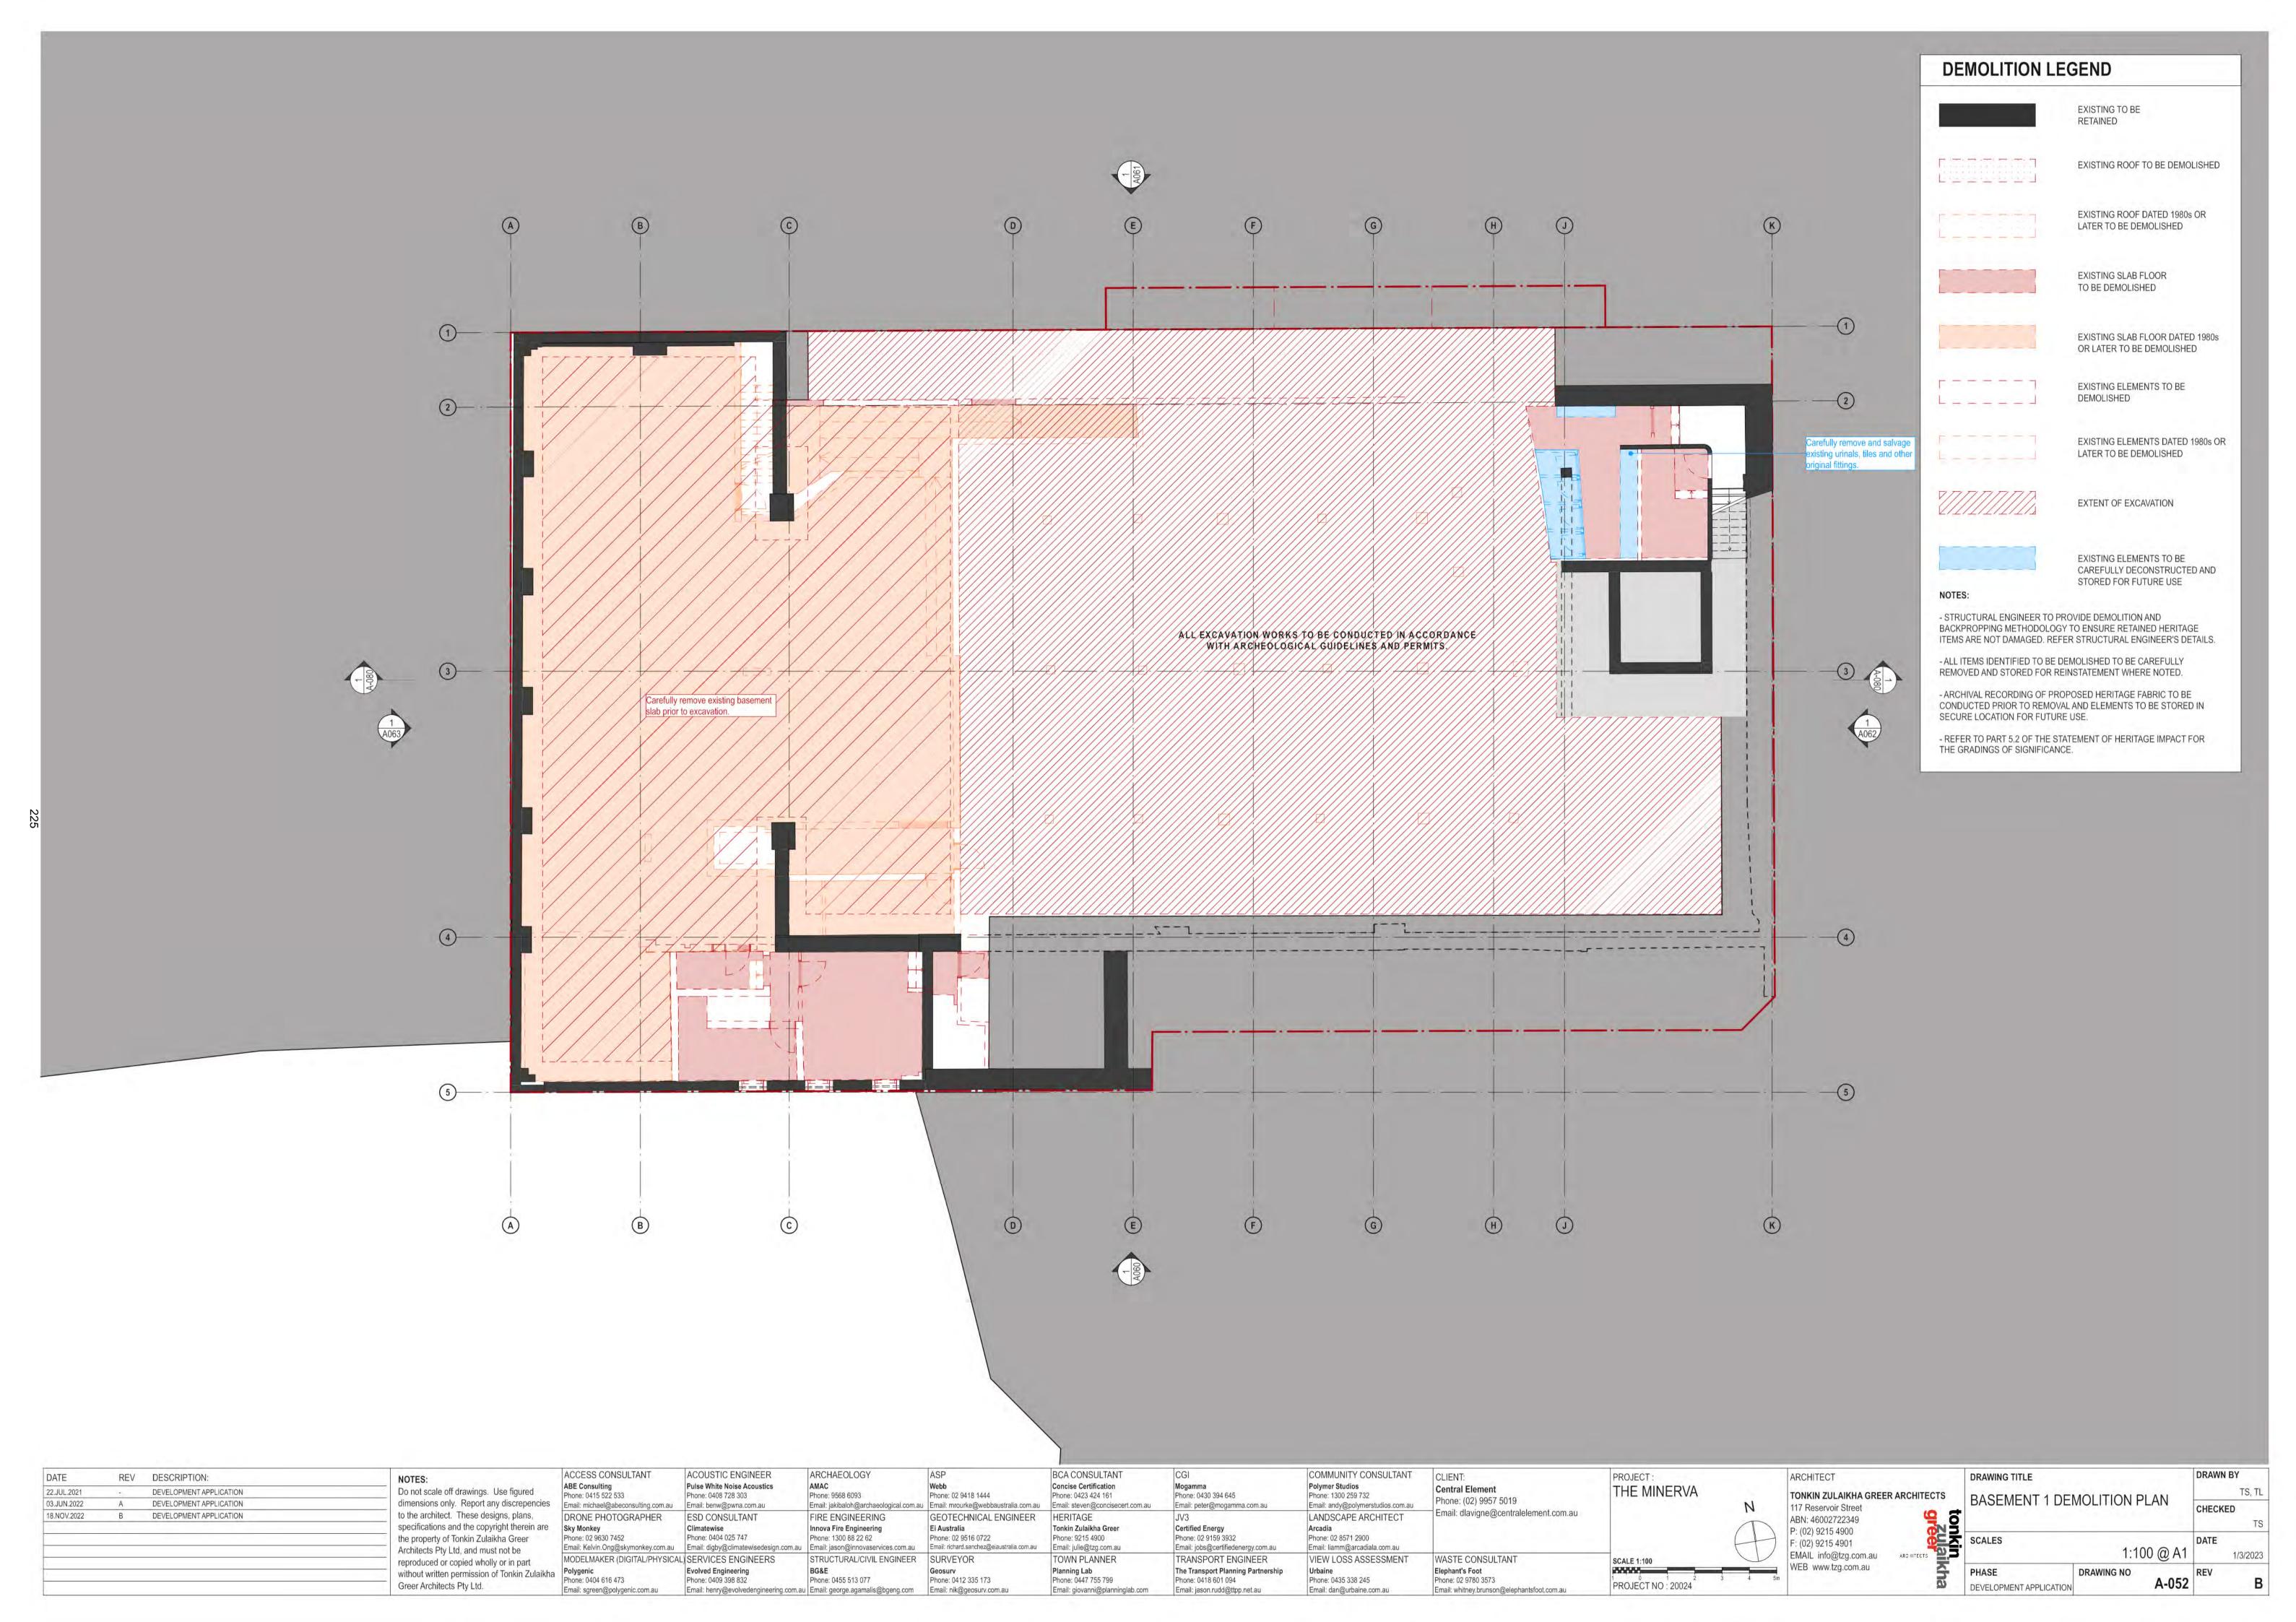


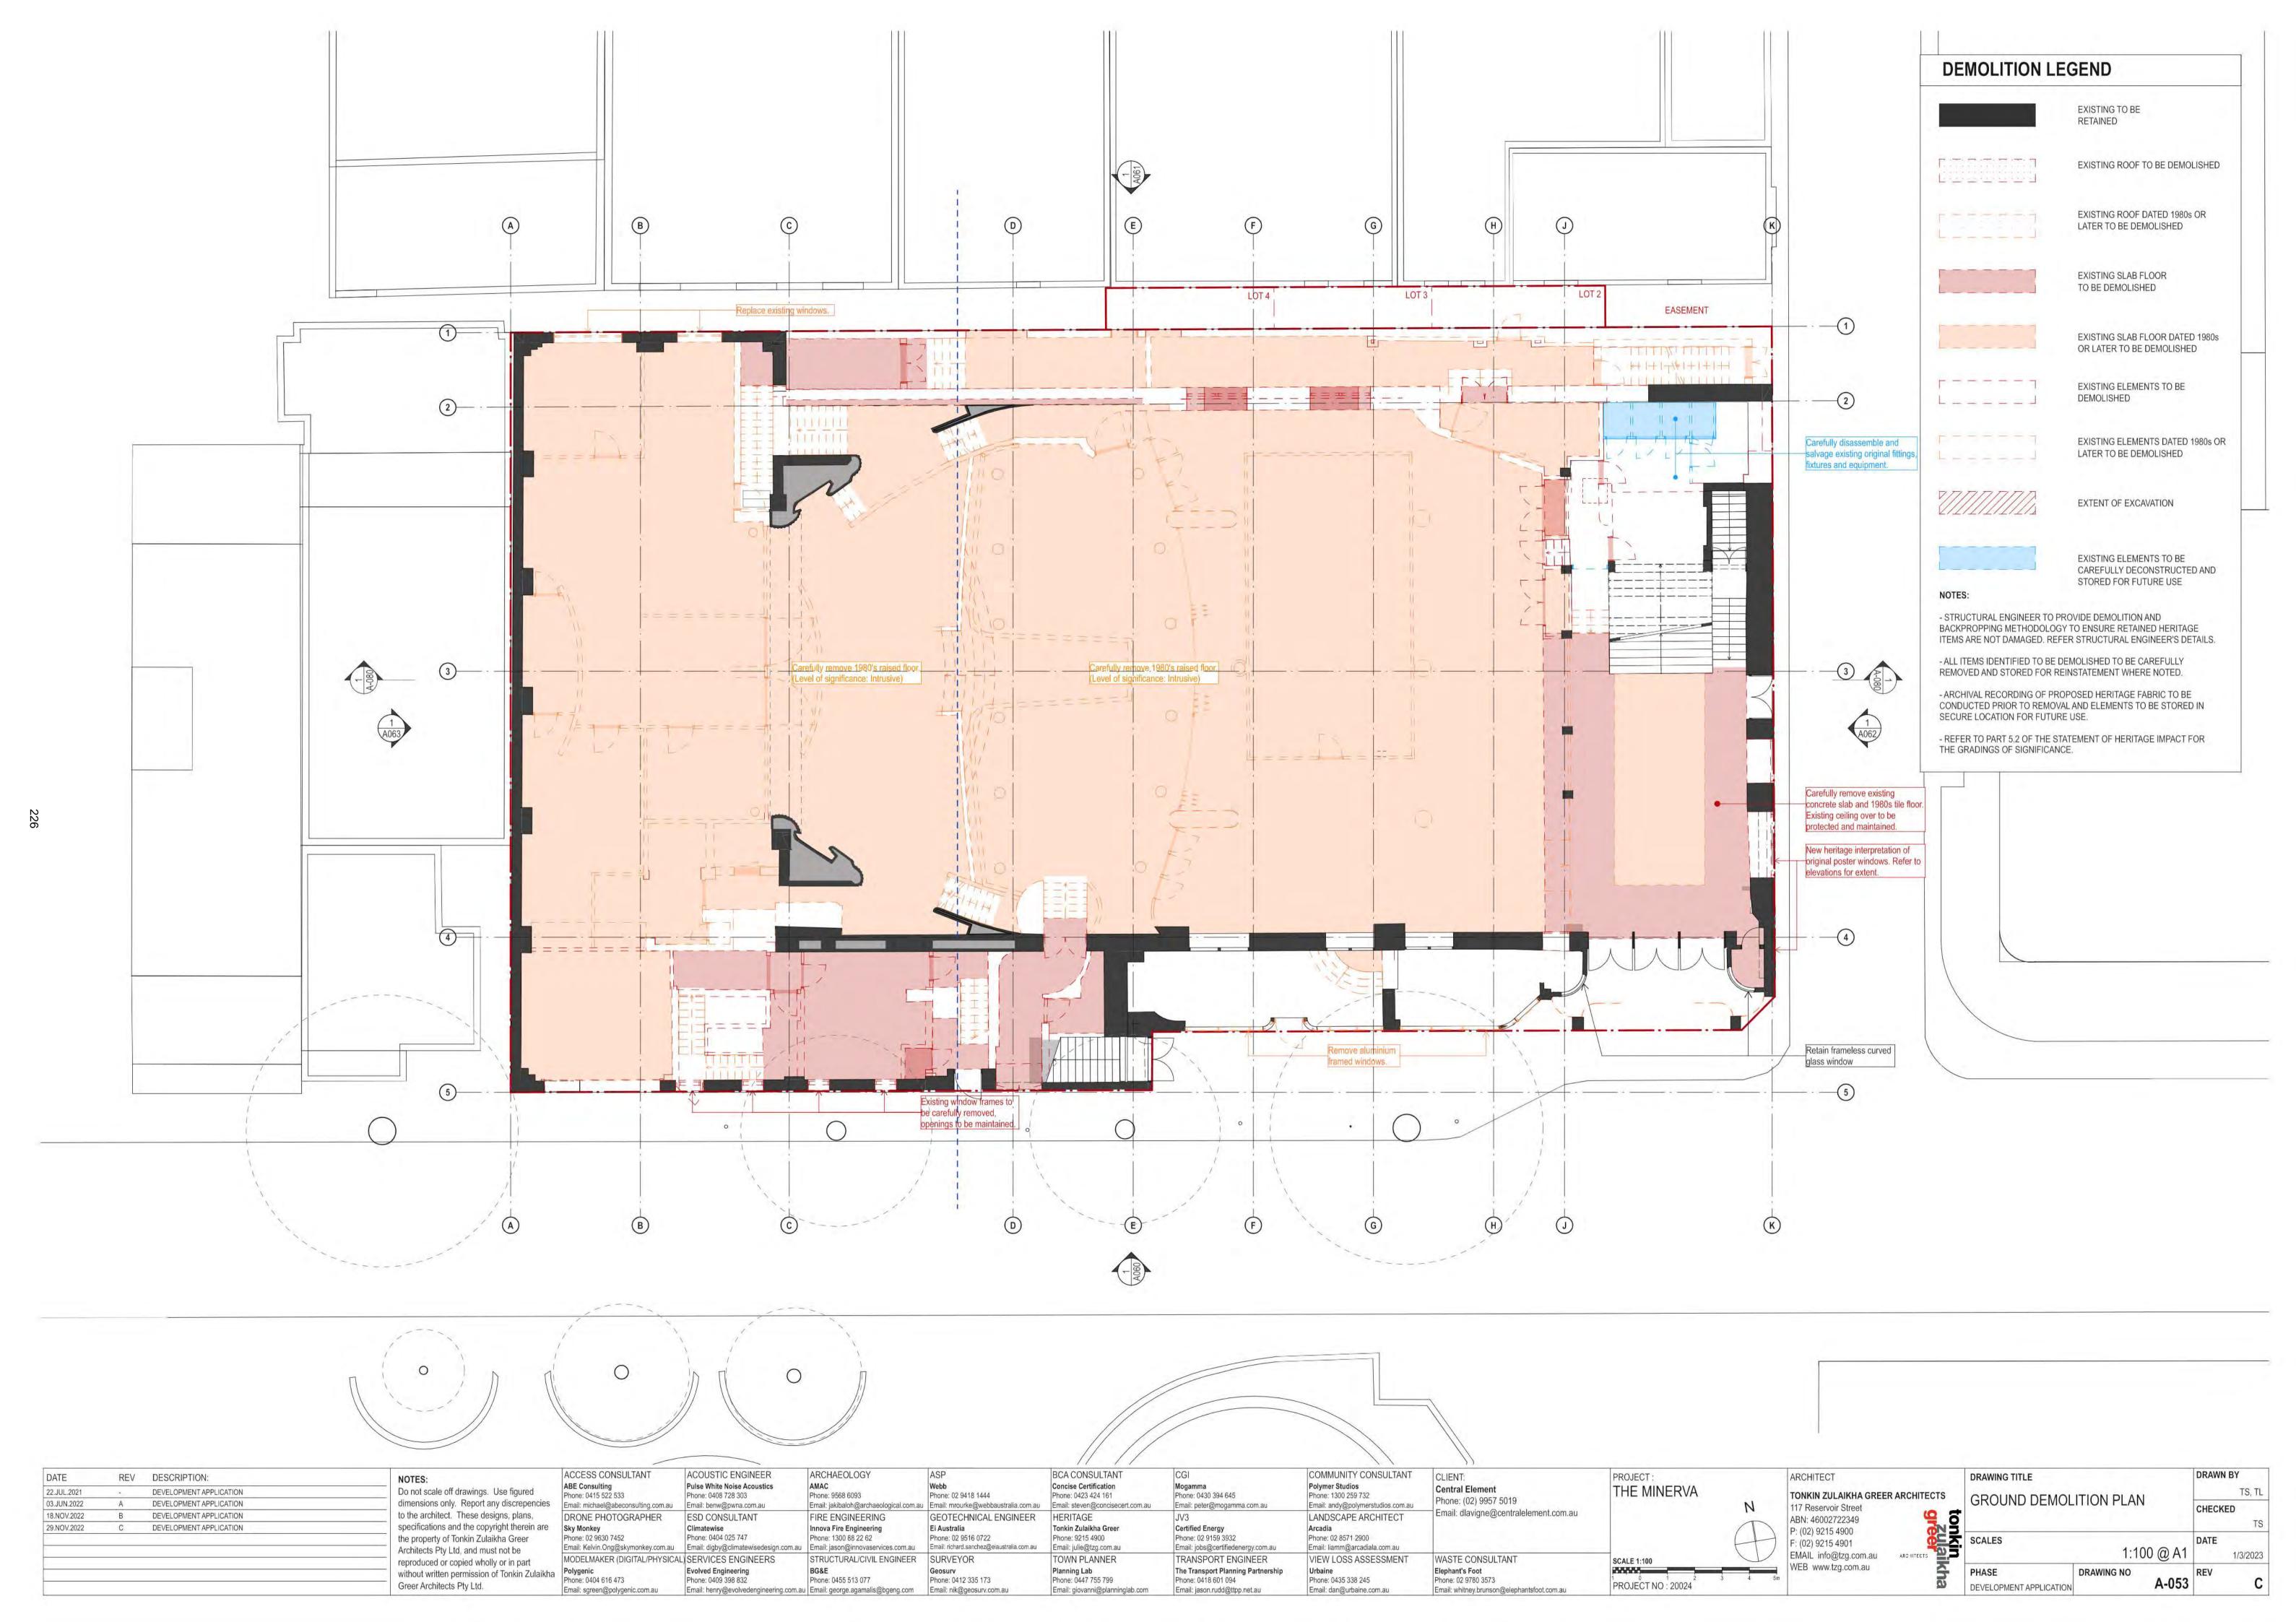

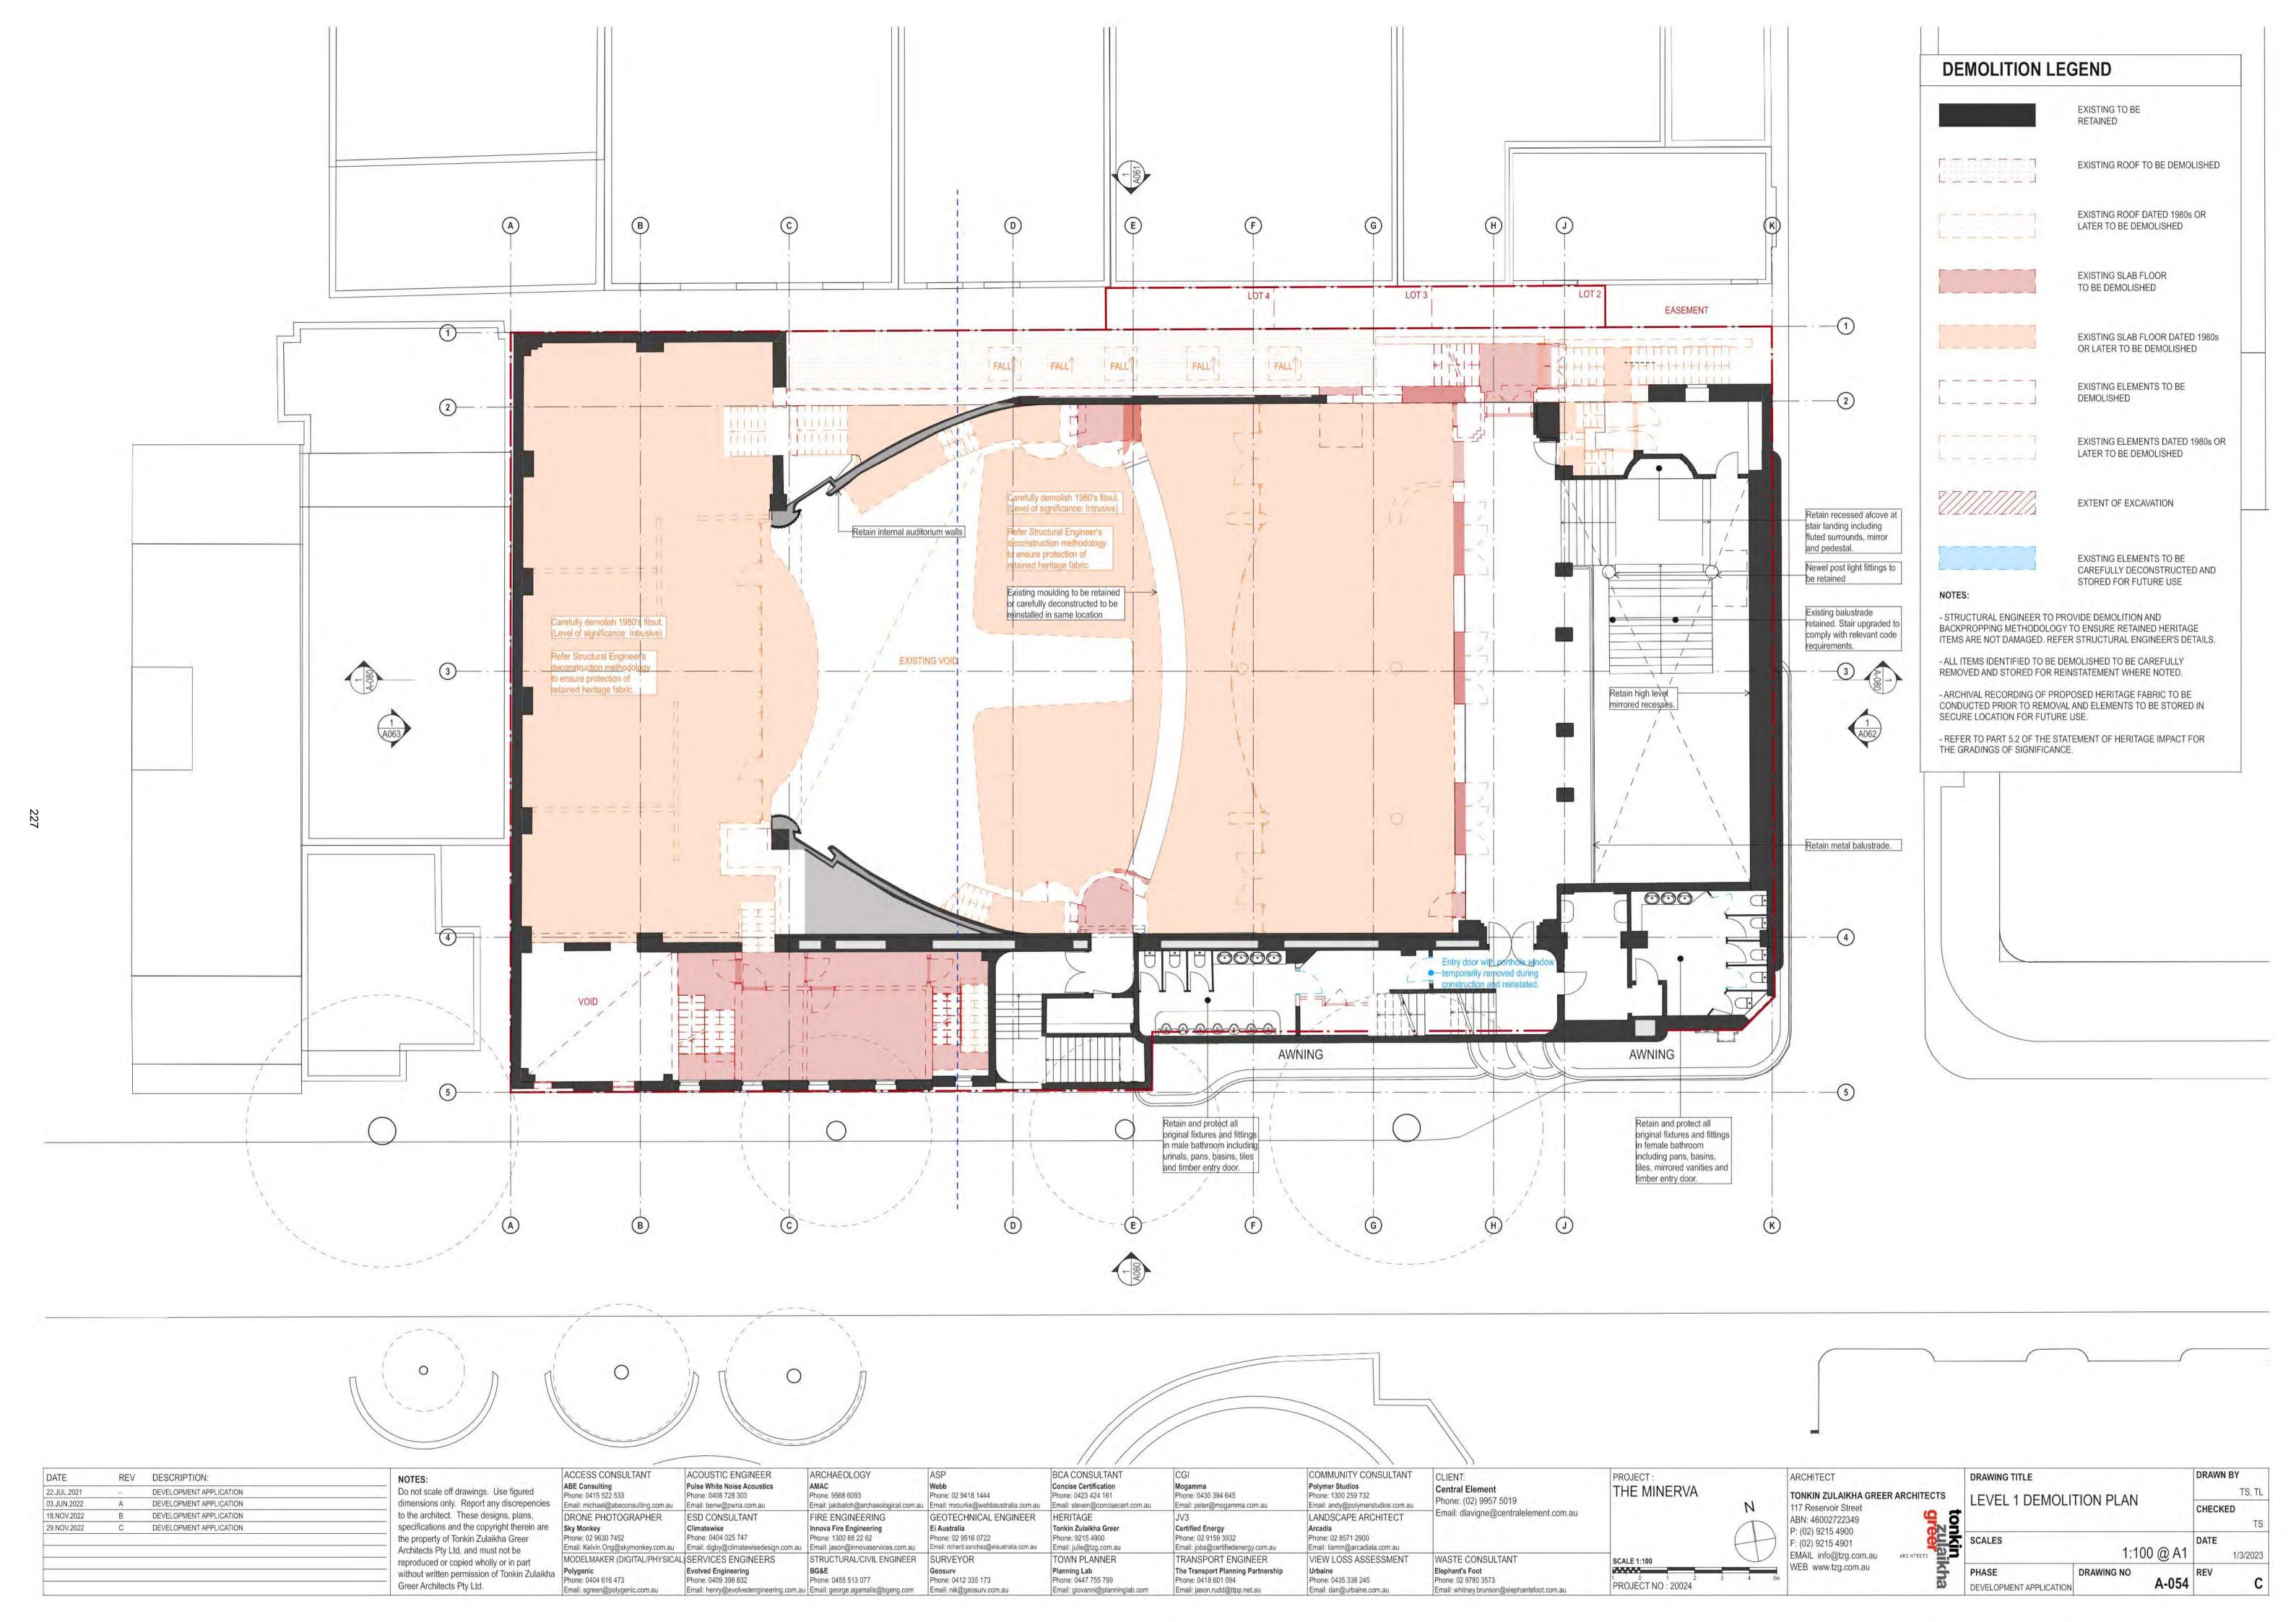


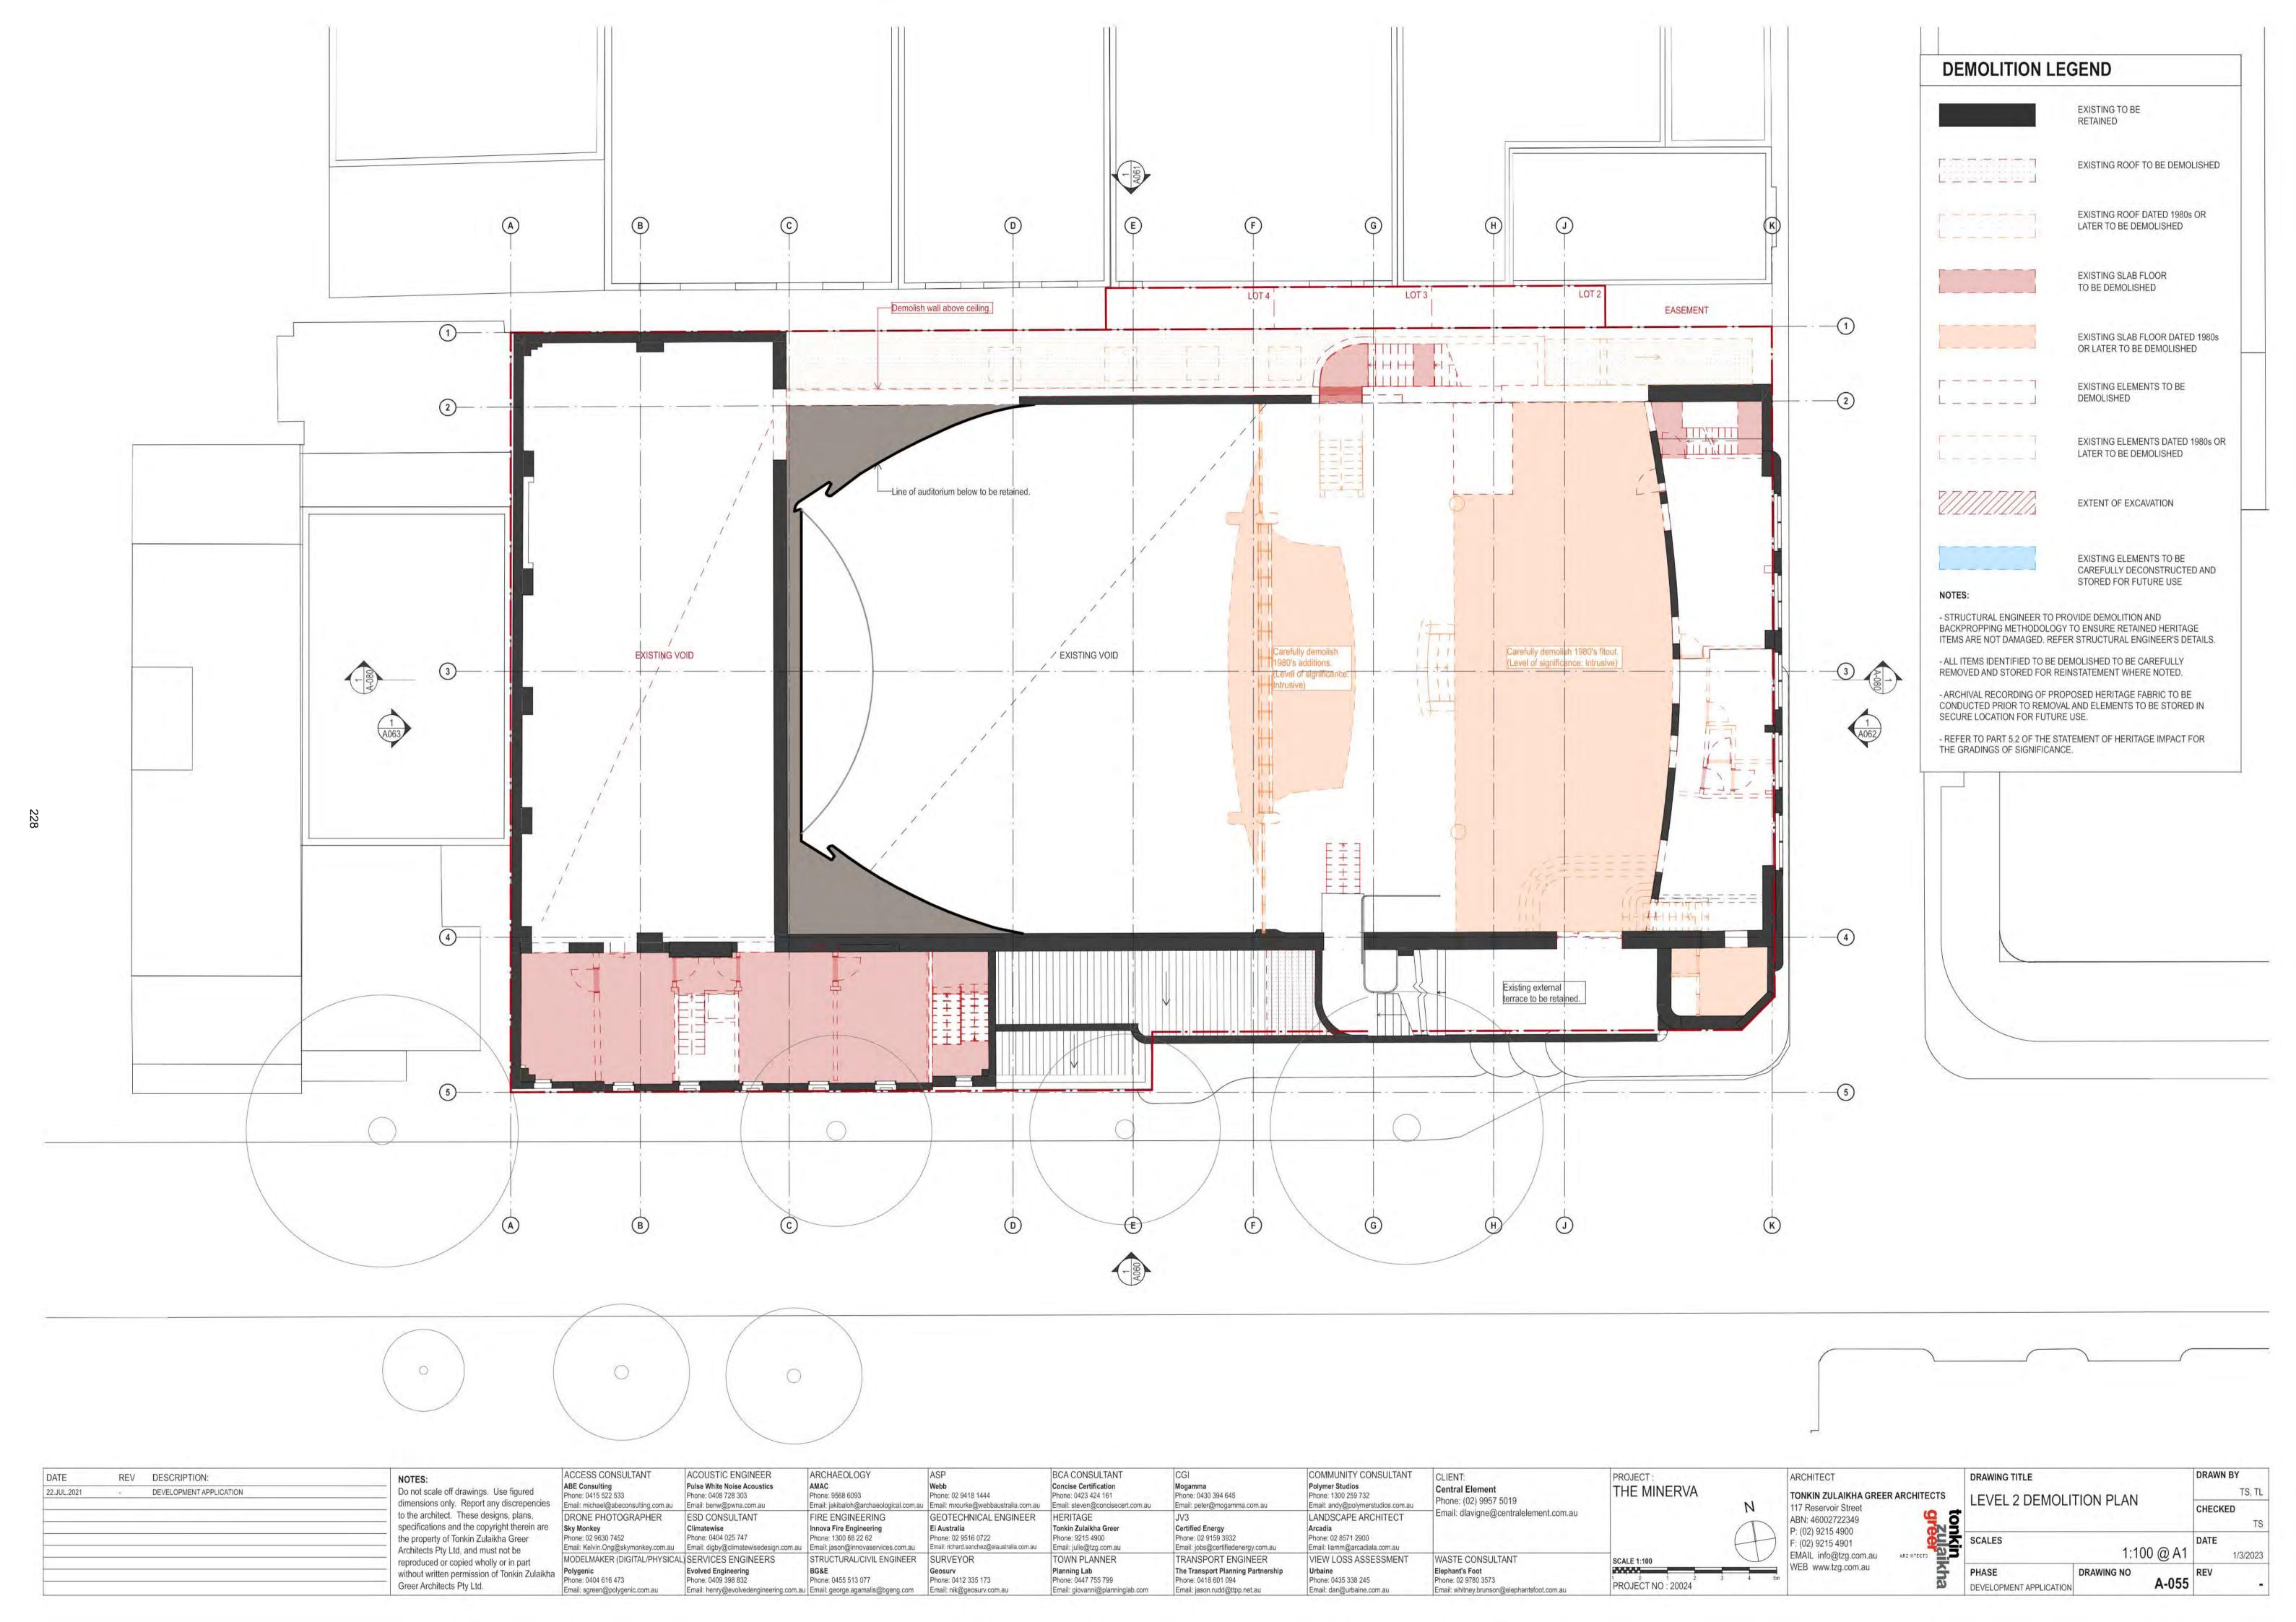

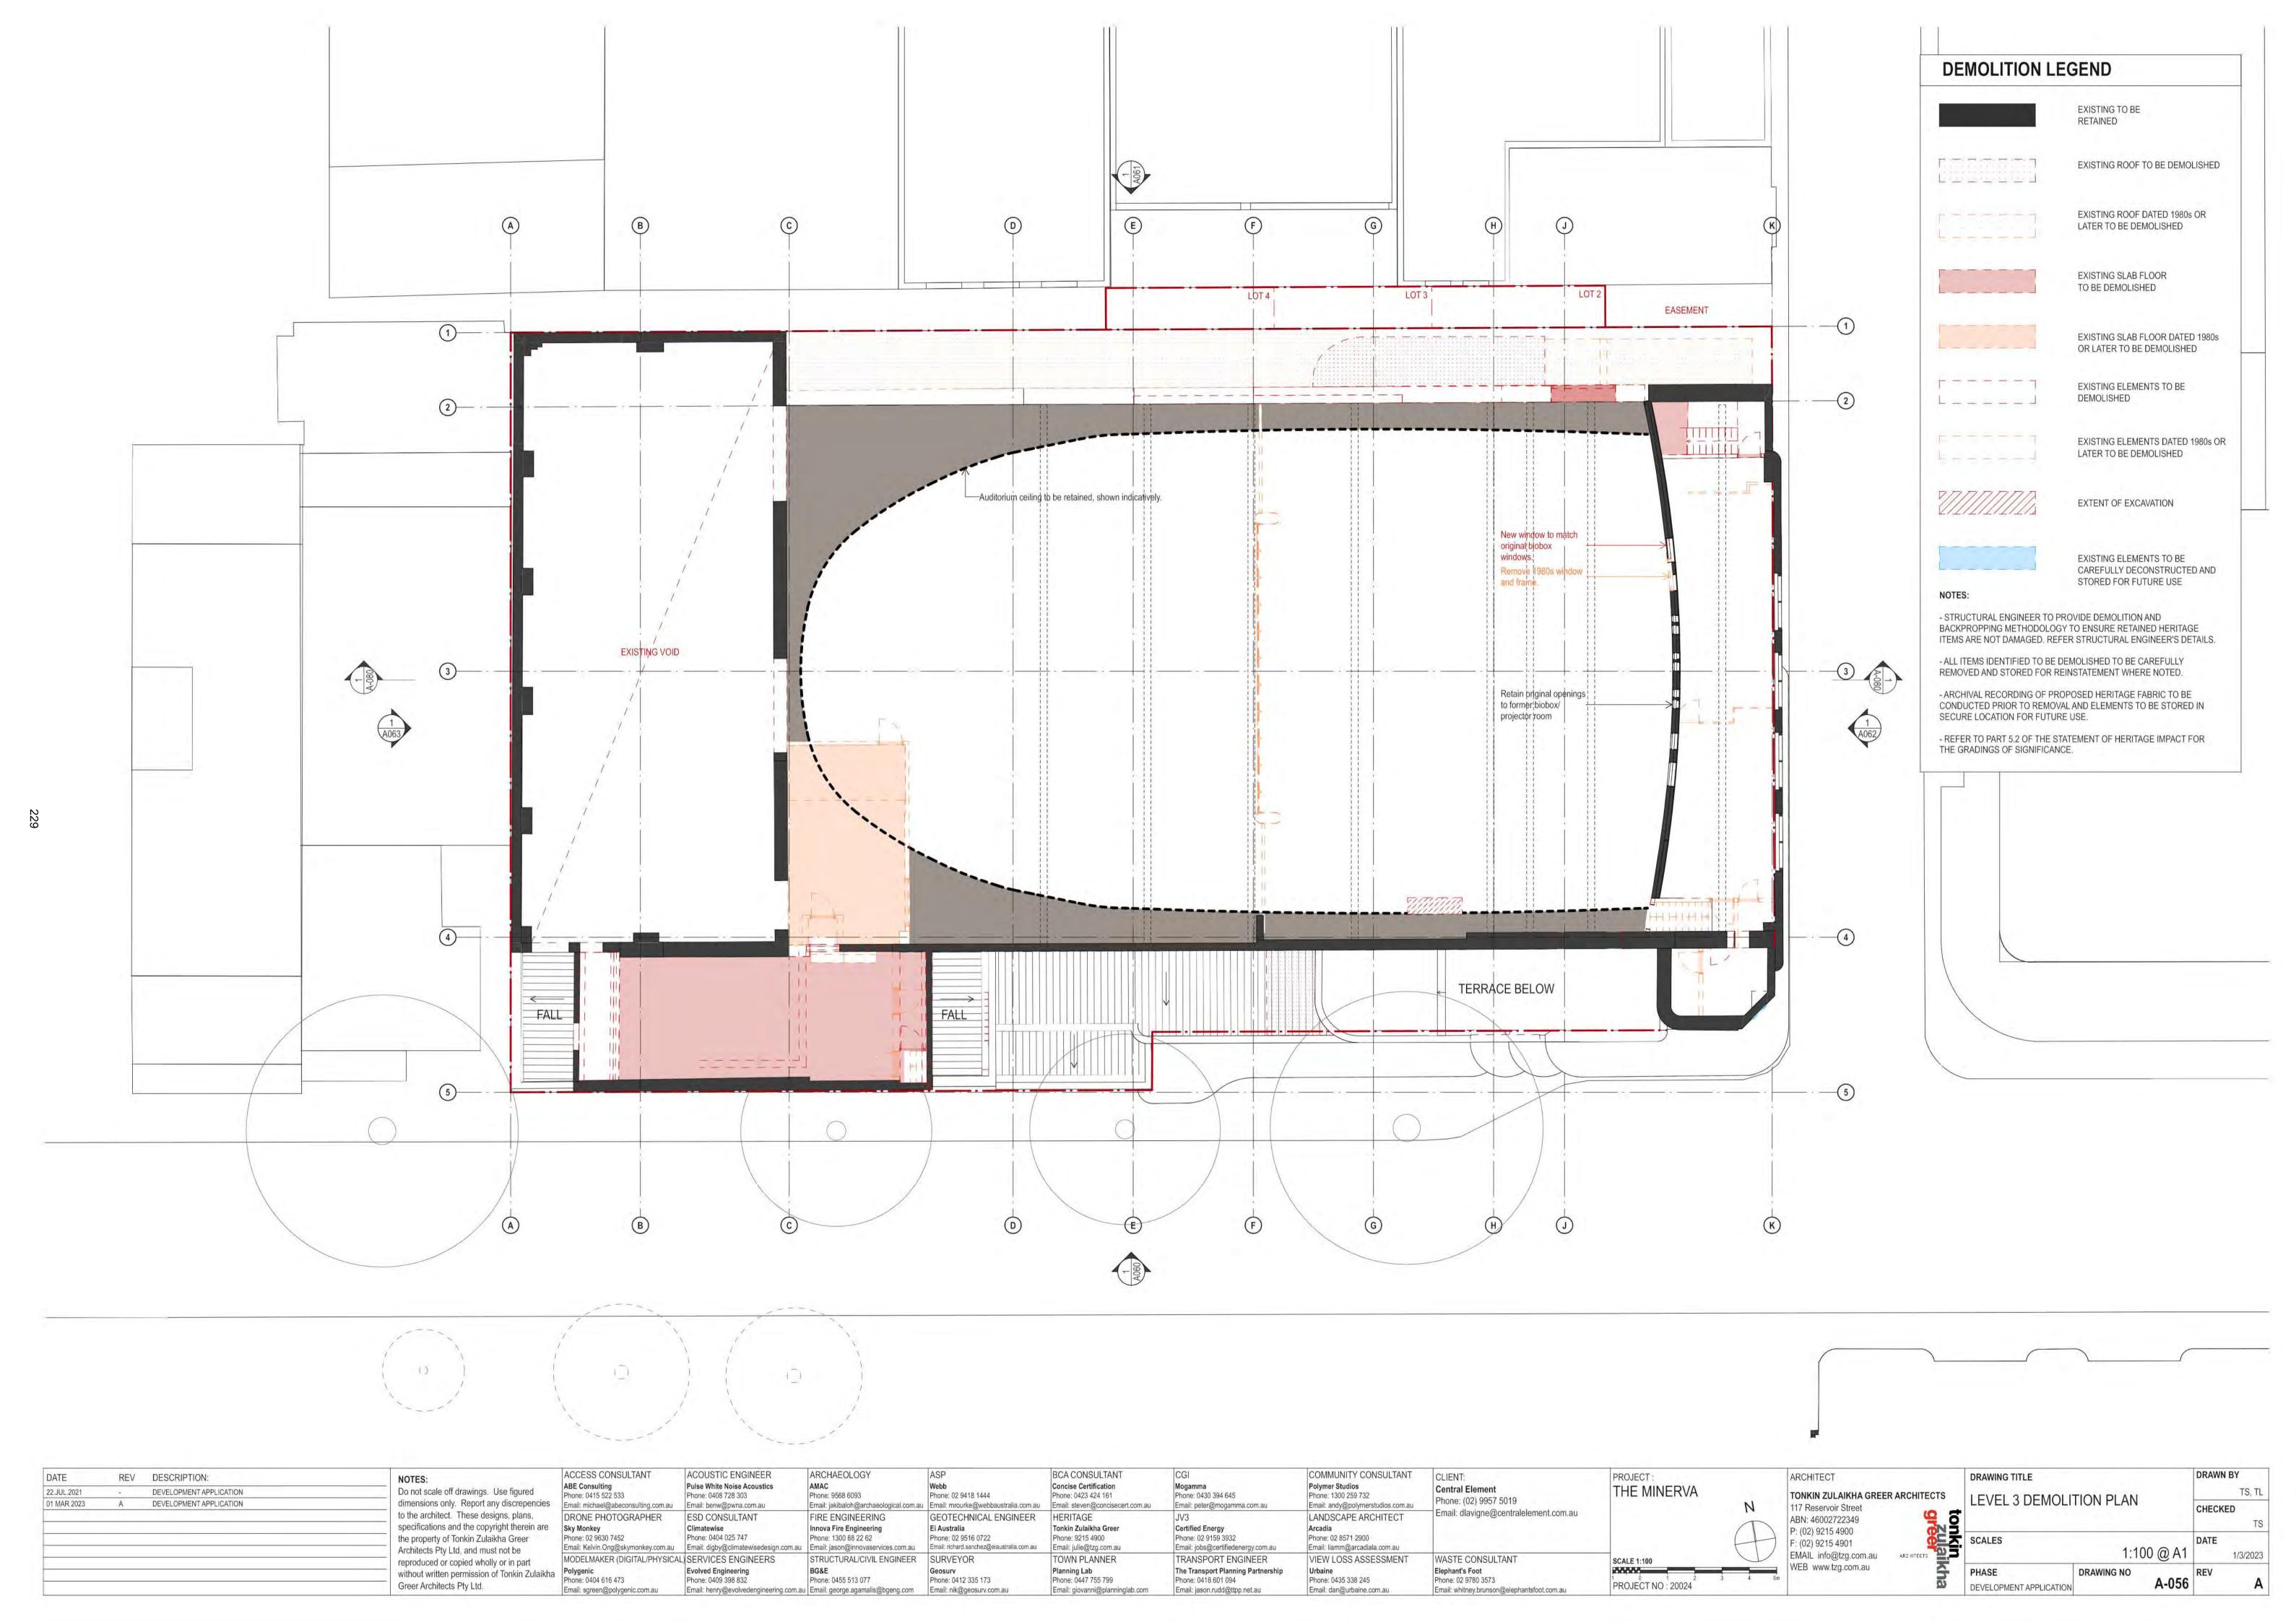

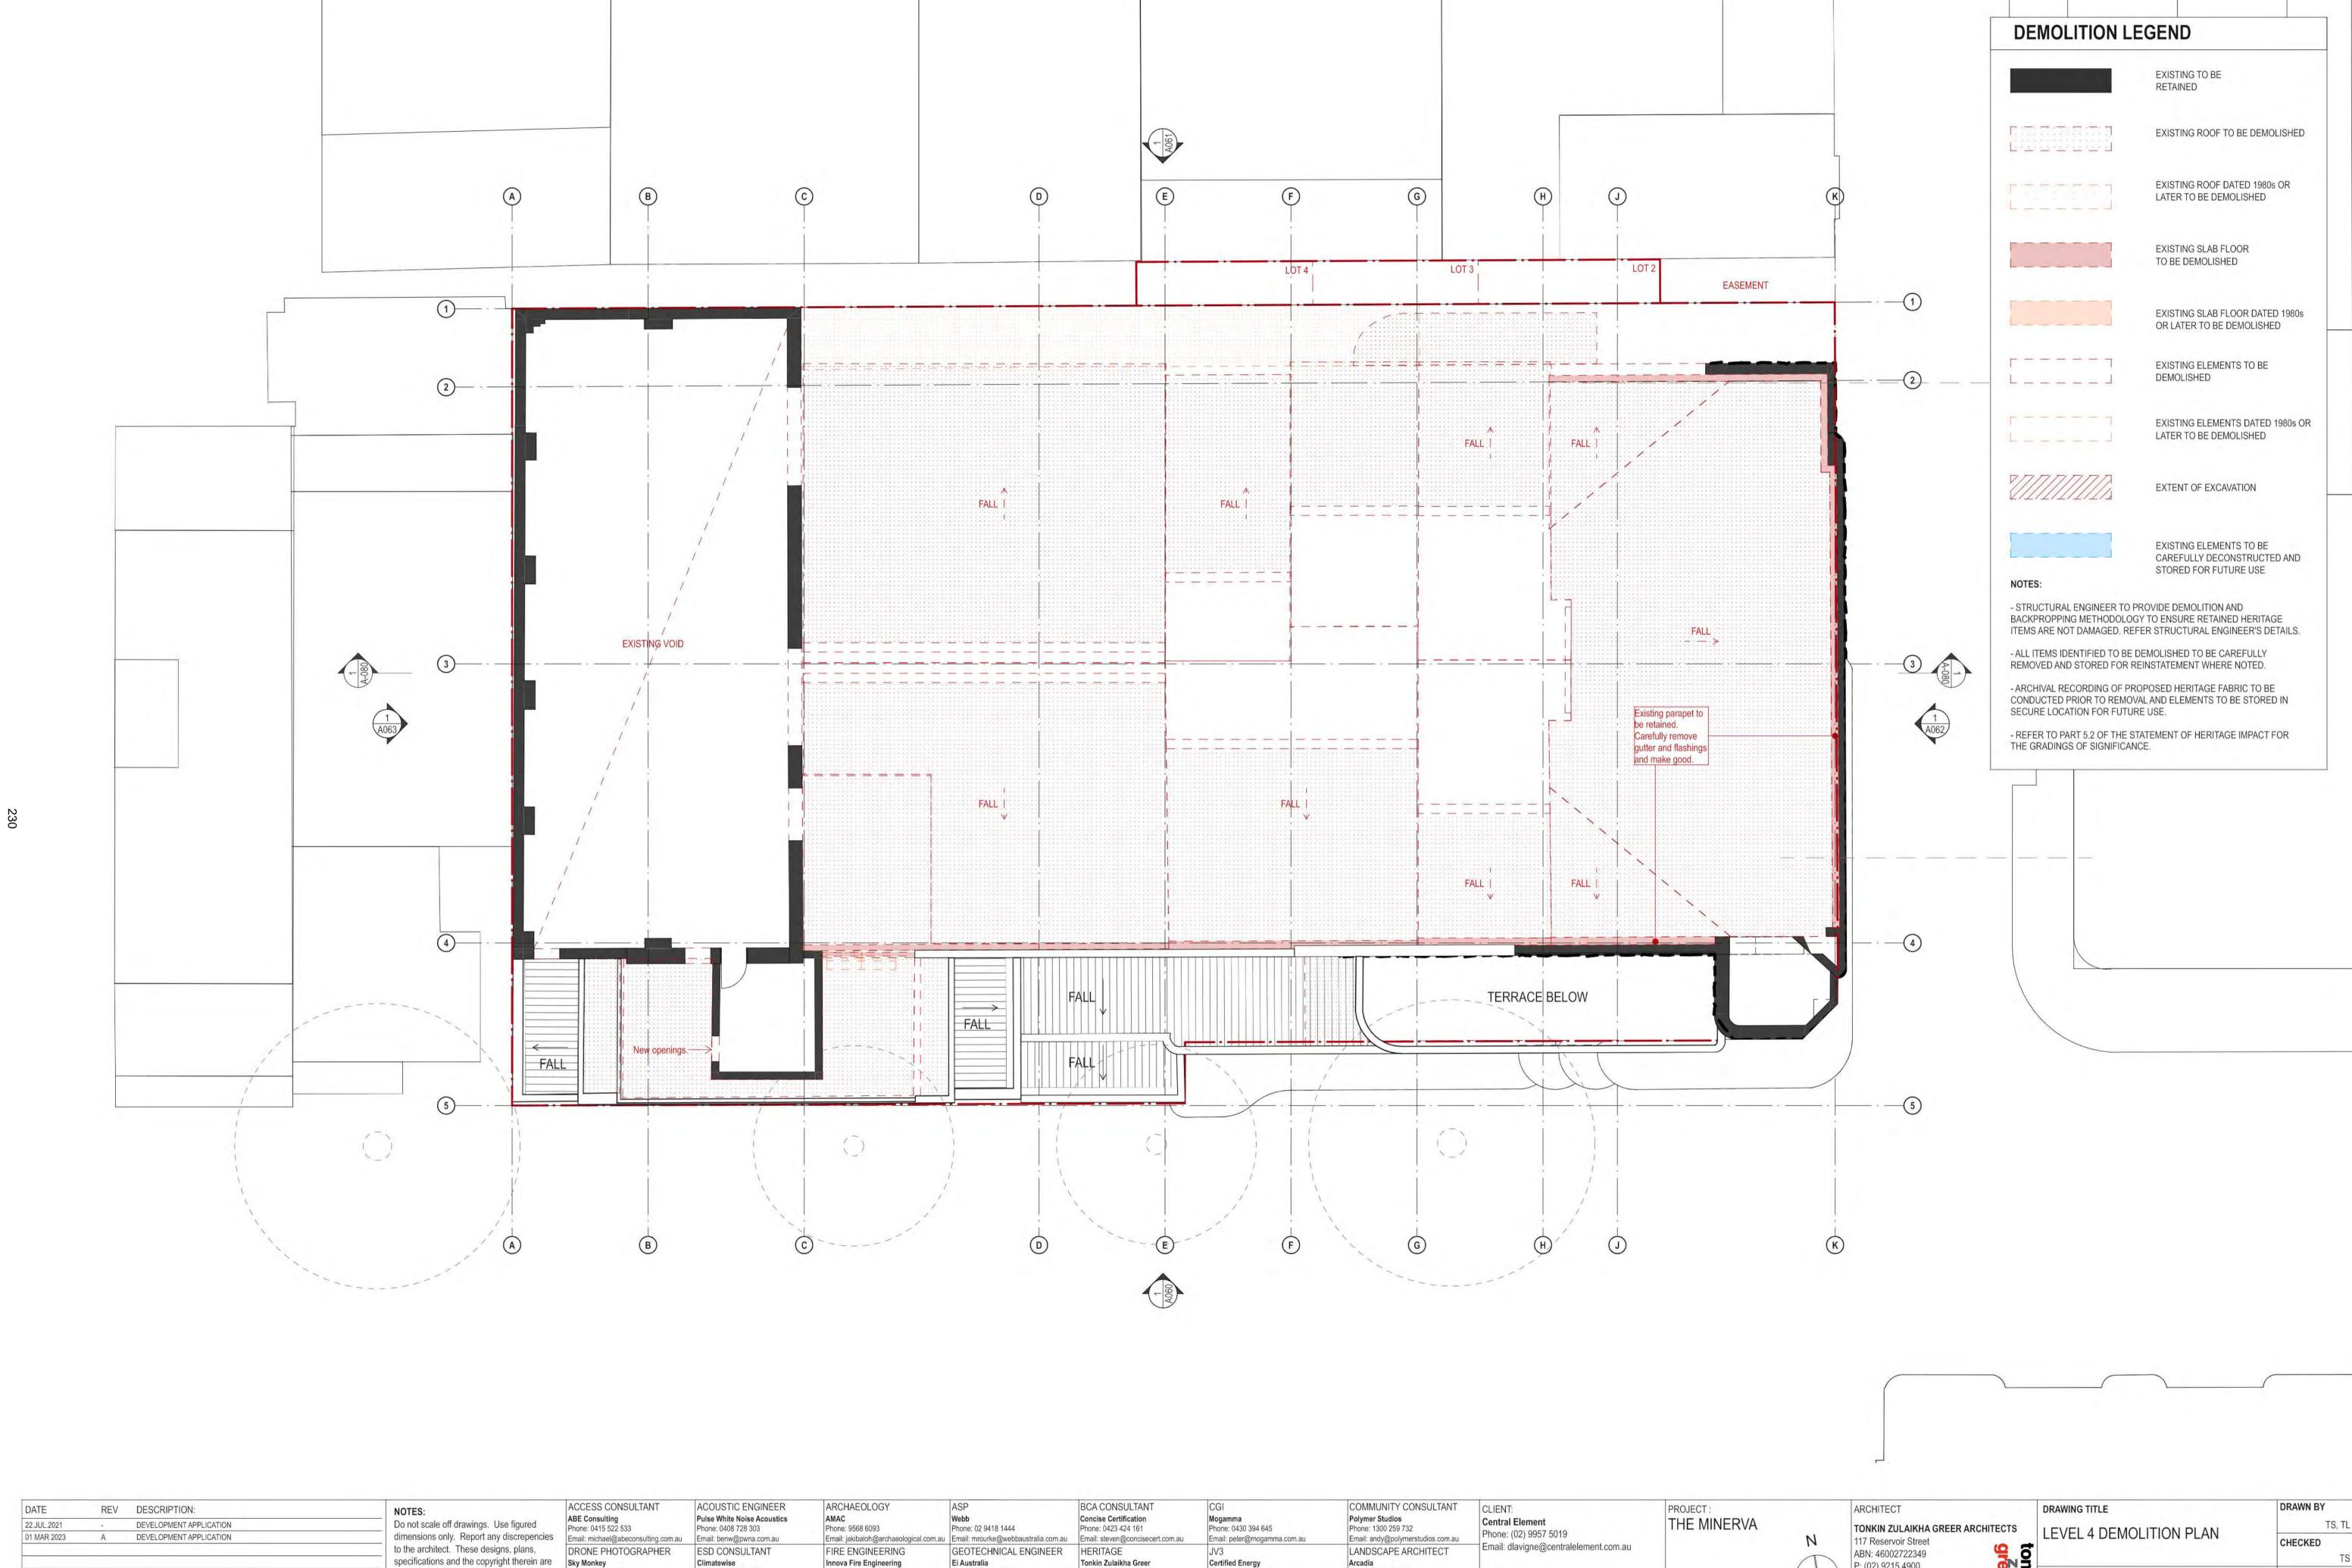

P: (02) 9215 4900 Phone: 02 8571 2900 Email: liamm@arcadiala.com.au Phone: 0404 025 747 Phone: 1300 88 22 62 Phone: 02 9516 0722 Phone: 02 9159 3932 the property of Tonkin Zulaikha Greer Phone: 02 9630 7452 Phone: 9215 4900 F: (02) 9215 4901 Email: richard.sanchez@eiaustralia.com.au Email: Kelvin.Ong@skymonkey.com.au Email: digby@climatewisedesign.com.au Email: julie@tzg.com.au Email: jobs@certifiedenergy.com.au Architects Pty Ltd, and must not be Email: jason@innovaservices.com.au 1:100 @ A1 EMAIL info@tzg.com.au VIEW LOSS ASSESSMENT WASTE CONSULTANT MODELMAKER (DIGITAL/PHYSICAL) SERVICES ENGINEERS STRUCTURAL/CIVIL ENGINEER SURVEYOR TOWN PLANNER TRANSPORT ENGINEER SCALE 1:100 reproduced or copied wholly or in part WEB www.tzg.com.au without written permission of Tonkin Zulaikha
Polygenic
Phone: 0404 616 473 **Evolved Engineering** The Transport Planning Partnership Elephant's Foot 100,000 Planning Lab DRAWING NO A-057 Phone: 0409 398 832 Phone: 0455 513 077 Phone: 0412 335 173 Phone: 0447 755 799 Phone: 0418 601 094 Phone: 0435 338 245 Phone: 02 9780 3573 Greer Architects Pty Ltd. PROJECT NO: 20024 DEVELOPMENT APPLICATION Email: whitney.brunson@elephantsfoot.com.au Email: henry@evolvedengineering.com.au Email: george.agamalis@bgeng.com Email: nik@geosurv.com.au Email: dan@urbaine.com.au Email: sgreen@polygenic.com.au Email: giovanni@planninglab.com Email: jason.rudd@ttpp.net.au

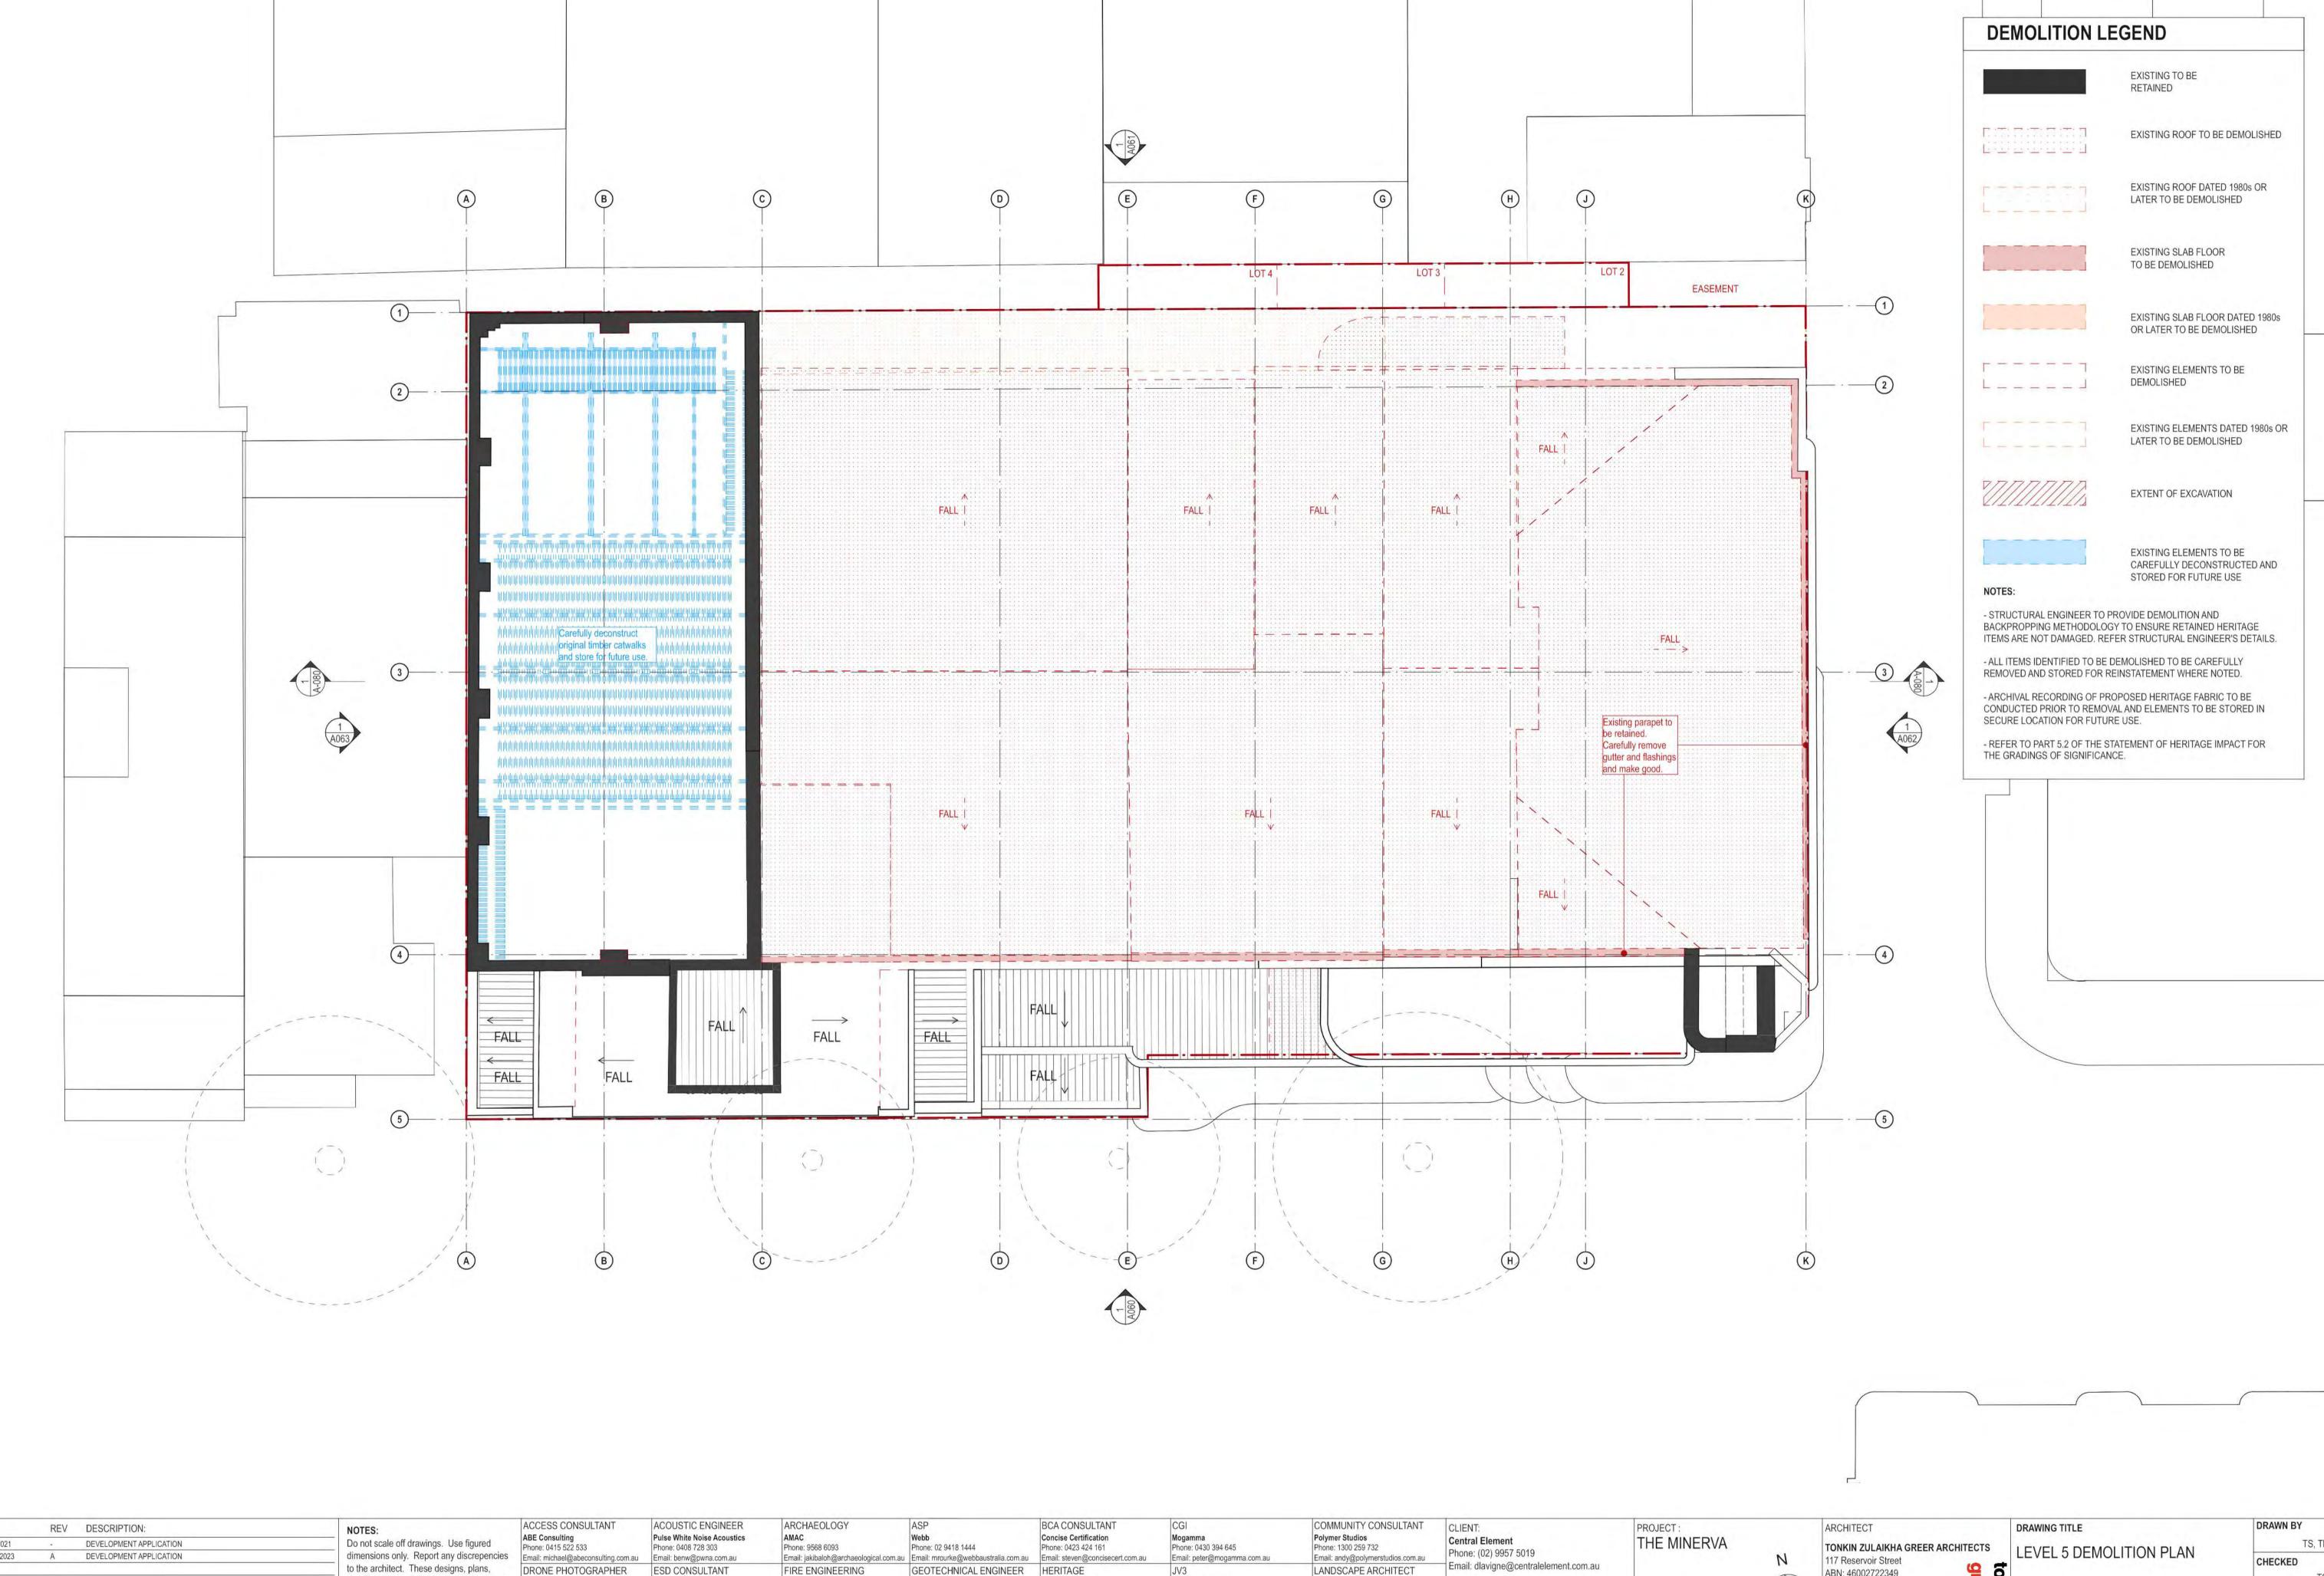

specifications and the copyright therein are Sky Monkey the property of Tonkin Zulaikha Greer Architects Pty Ltd, and must not be reproduced or copied wholly or in part without written permission of Tonkin Zulaikha
Polygenic
Phone: 0404 616 473 Greer Architects Pty Ltd.

DRONE PHOTOGRAPHER Phone: 02 9630 7452 MODELMAKER (DIGITAL/PHYSICAL) SERVICES ENGINEERS

Email: sgreen@polygenic.com.au

FIRE ENGINEERING Innova Fire Engineering Phone: 0404 025 747 Phone: 1300 88 22 62 Phone: 02 9516 0722 Email: jason@innovaservices.com.au STRUCTURAL/CIVIL ENGINEER SURVEYOR **Evolved Engineering** Phone: 0409 398 832 Phone: 0455 513 077 Phone: 0412 335 173

Email: henry@evolvedengineering.com.au Email: george.agamalis@bgeng.com Email: nik@geosurv.com.au

HERITAGE Tonkin Zulaikha Greer Phone: 9215 4900 Email: richard.sanchez@eiaustralia.com.au Email: julie@tzg.com.au TOWN PLANNER Planning Lab Phone: 0447 755 799 Email: giovanni@planninglab.com

Certified Energy Phone: 02 9159 3932 Email: jobs@certifiedenergy.com.au TRANSPORT ENGINEER The Transport Planning Partnership Phone: 0418 601 094 Phone: 0435 338 245 Email: dan@urbaine.com.au Email: jason.rudd@ttpp.net.au

Phone: 02 8571 2900 Email: liamm@arcadiala.com.au VIEW LOSS ASSESSMENT WASTE CONSULTANT

Elephant's Foot

Phone: 02 9780 3573

Email: whitney.brunson@elephantsfoot.com.au

SCALE 1:100 100,000

PROJECT NO: 20024


ABN: 46002722349 P: (02) 9215 4900 F: (02) 9215 4901


EMAIL info@tzg.com.au

WEB www.tzg.com.au

1:100 @ A1 DRAWING NO A-058

DEVELOPMENT APPLICATION

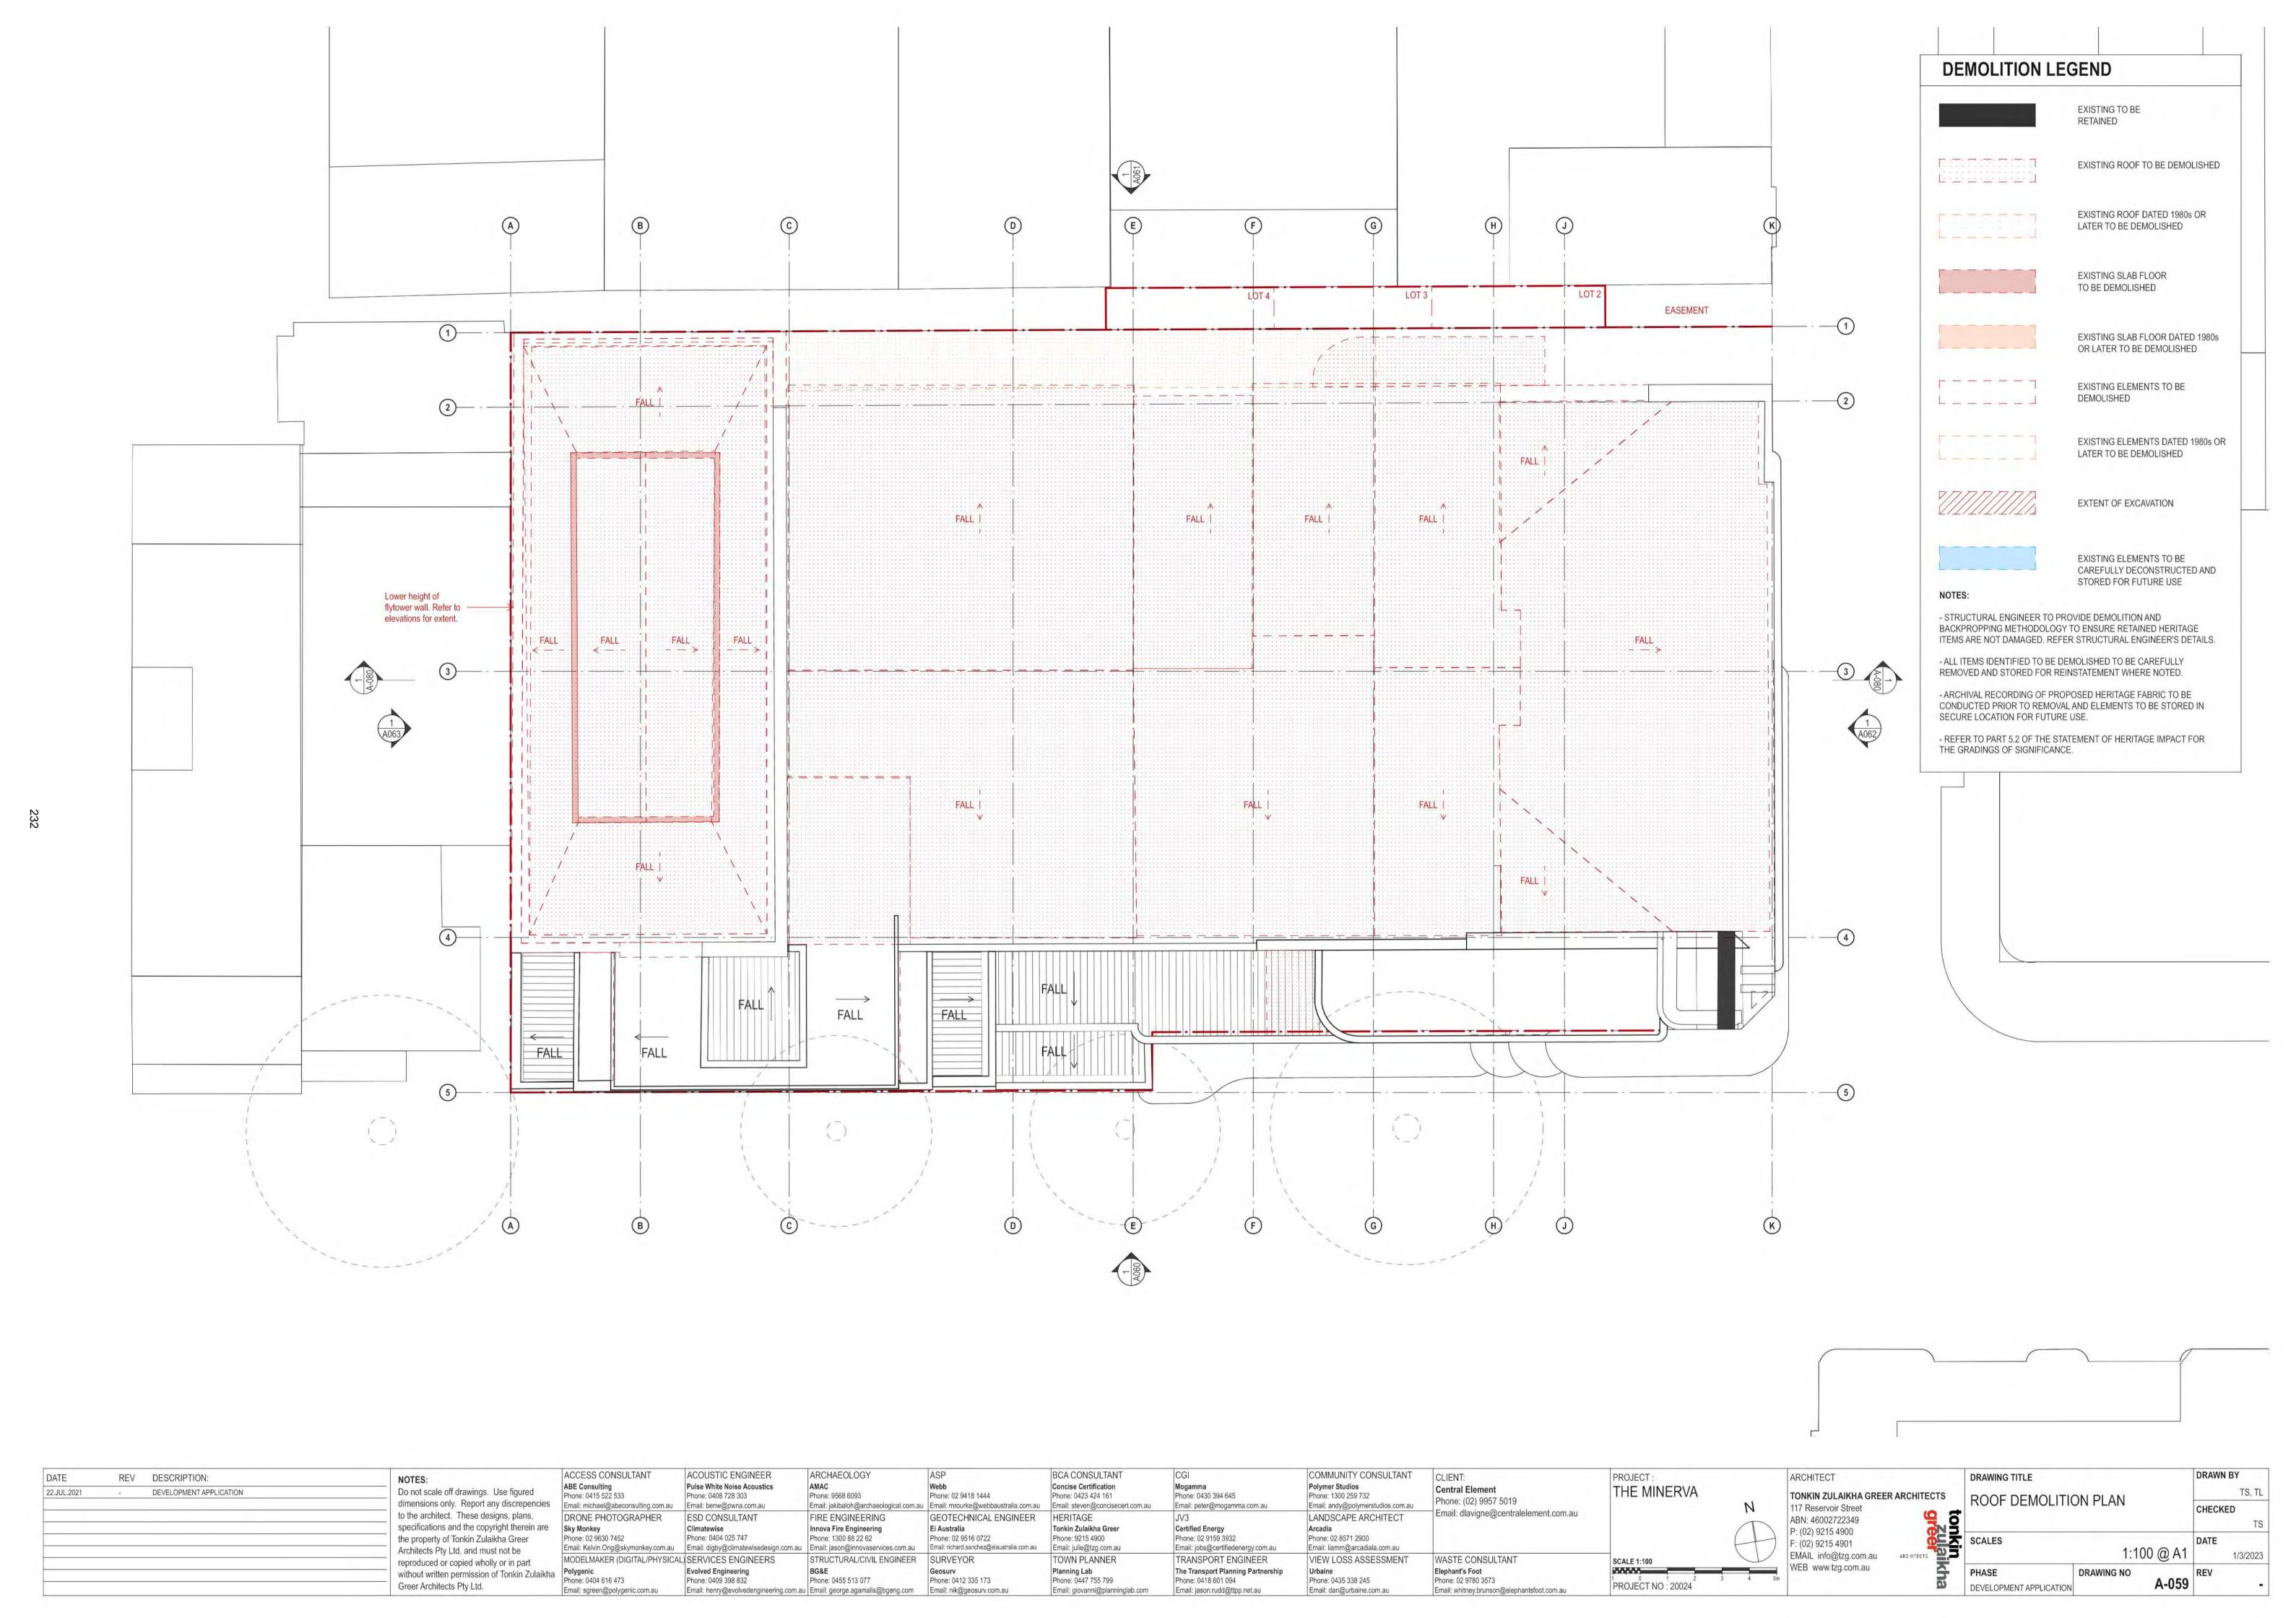

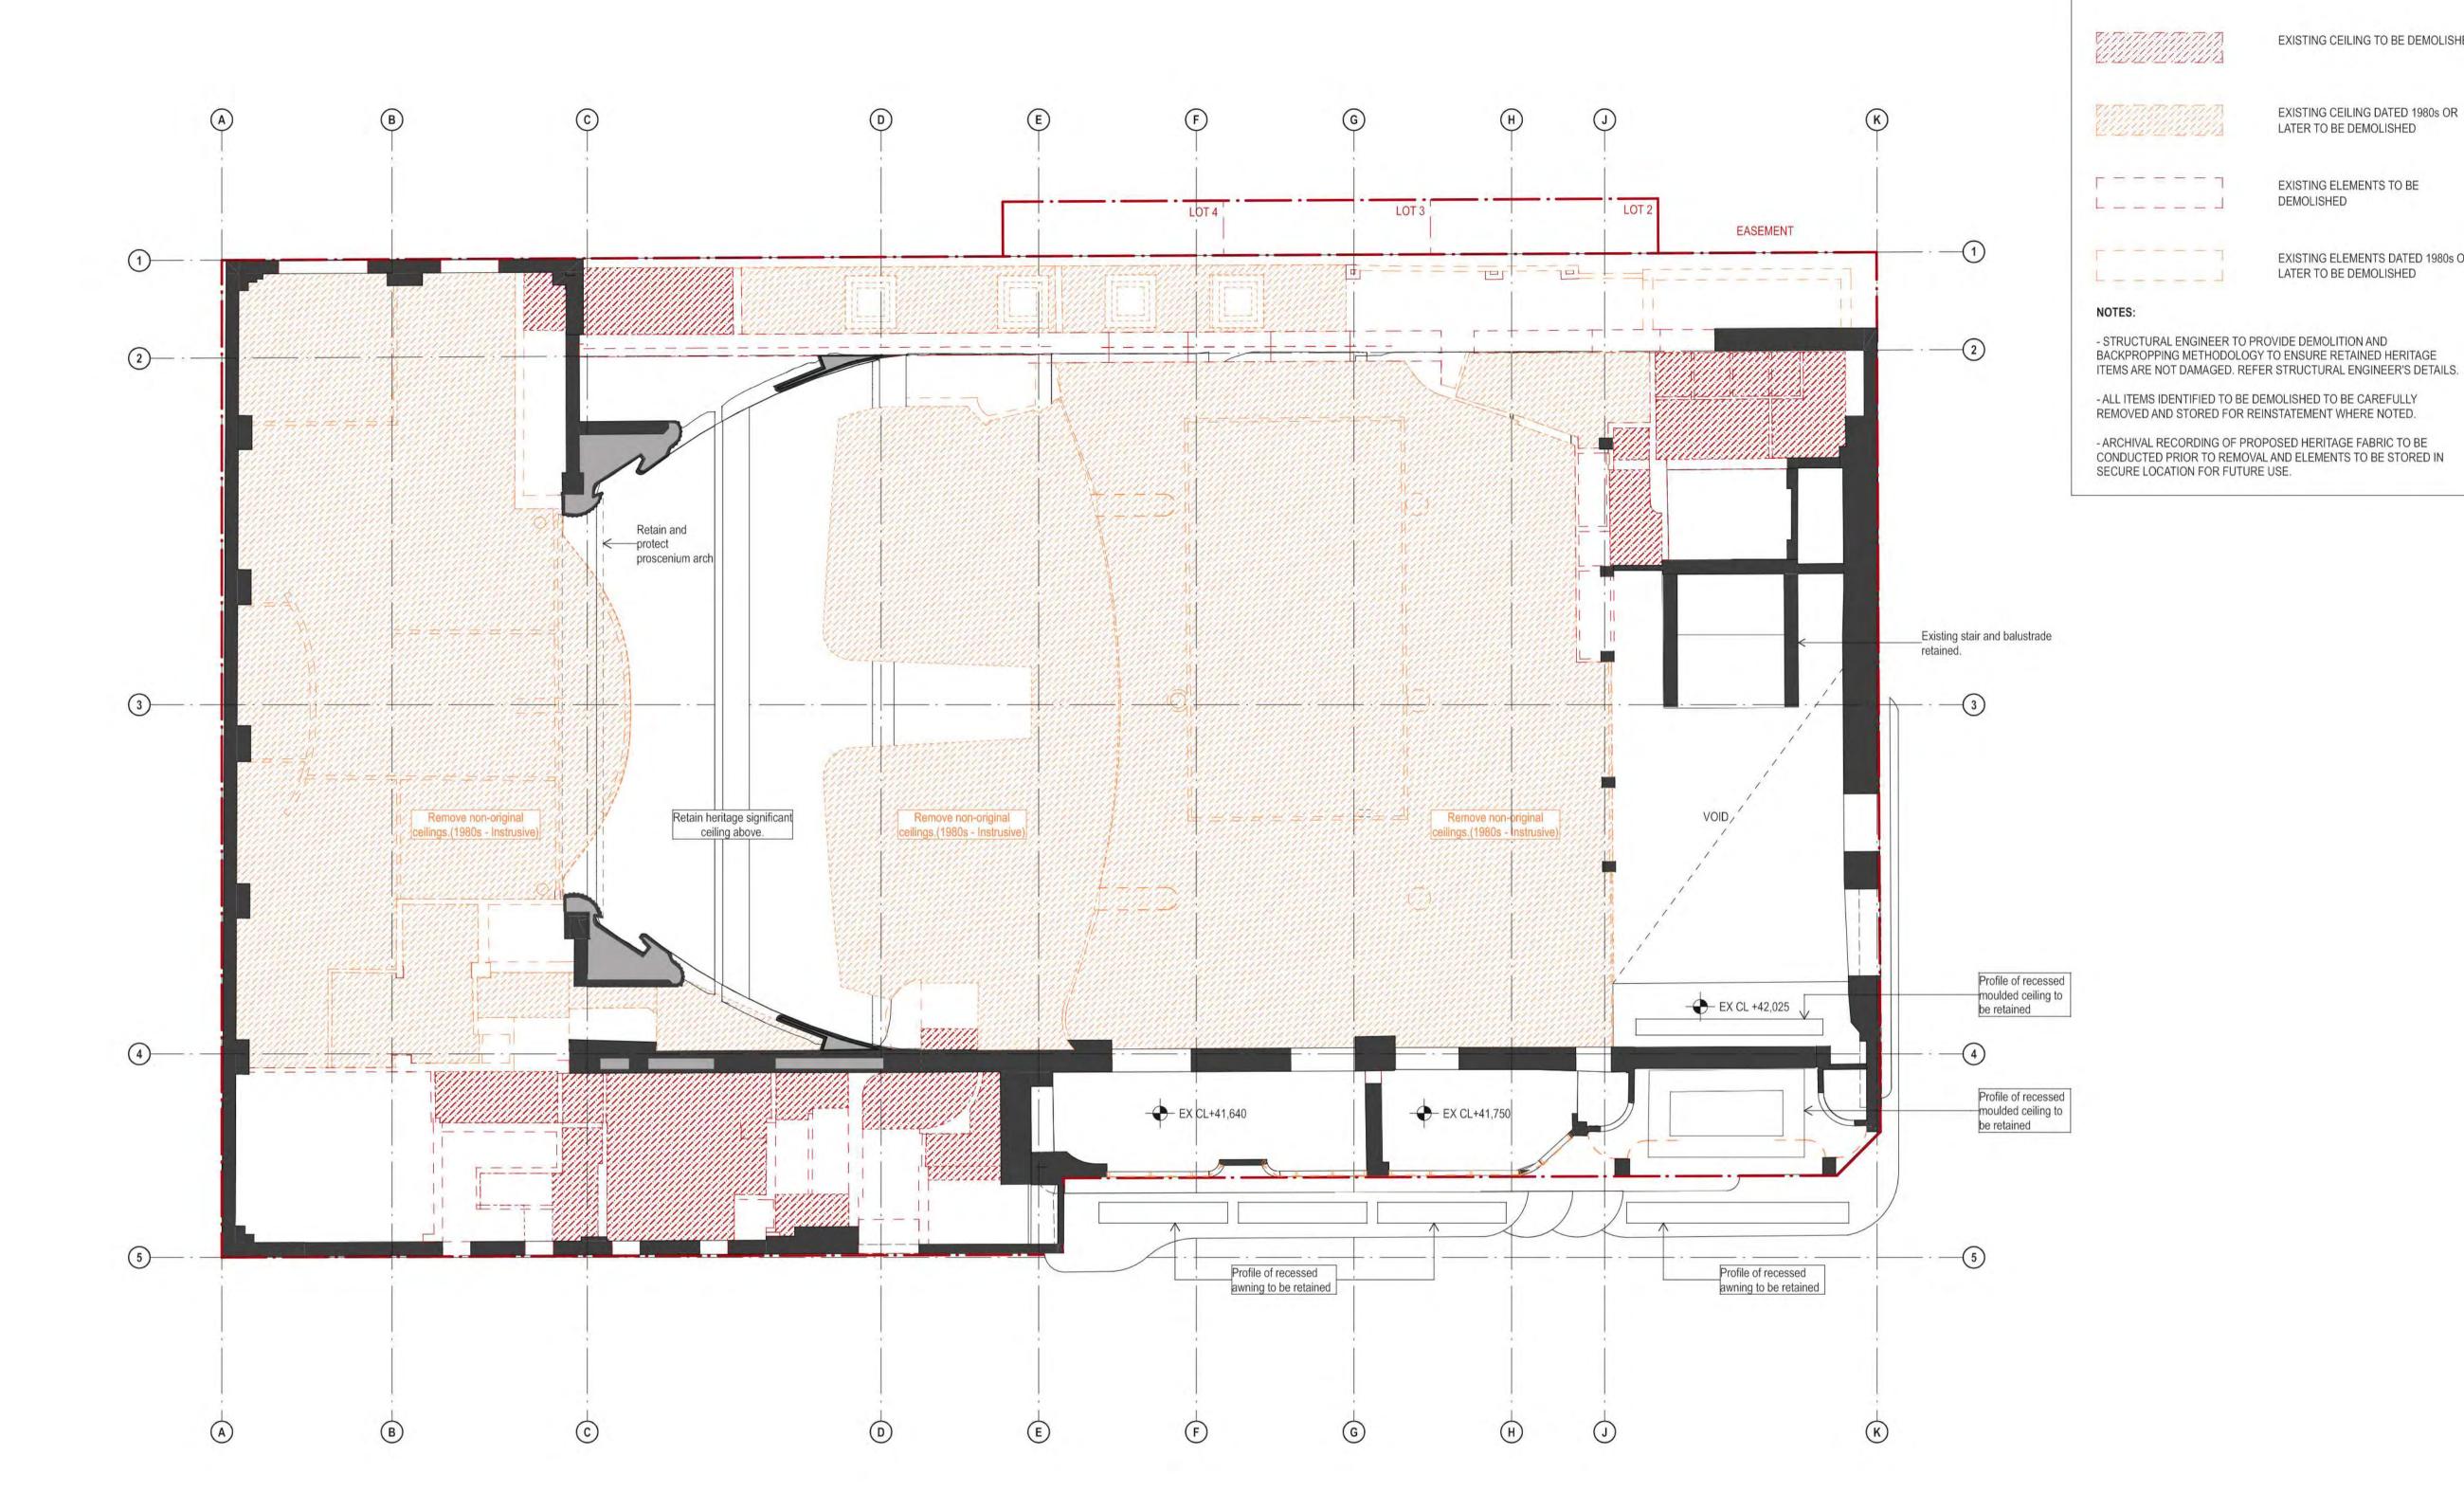

**DEMOLITION LEGEND** 

**EXISTING TO BE** RETAINED

EXISTING CEILING TO BE DEMOLISHED

EXISTING CEILING DATED 1980s OR

EXISTING ELEMENTS DATED 1980s OR


LATER TO BE DEMOLISHED

EXISTING ELEMENTS TO BE

LATER TO BE DEMOLISHED

**DEMOLISHED** 

Έ	RE	V DESCRIPTION:	NOTES:	ACCESS CONSULTANT	ACOUSTIC ENGINEER	ARCHAEOLOGY	ASP	BCA CONSULTANT	CGI	COMMUNITY CONSULTANT	CLIENT:	PROJECT:		ARCHITECT	DRAWING TITLE	DRAWN BY
2021	-	DEVELOPMENT APPLICATION	Do not scale off drawings. Use figured	ABE Consulting Phone: 0415 522 533	Pulse White Noise Acoustics Phone: 0408 728 303	Phone: 9568 6093	Phone: 02 9418 1444	Phone: 0423 424 161	Phone: 0430 394 645	Polymer Studios Phone: 1300 259 732	Central Element	THE MINERVA		TONKIN ZULAIKHA GREER ARCHITECTS	ODOLIND DOD DEMOLITION	
V.2022	Α	DEVELOPMENT APPLICATION	dimensions only. Report any discrepencies	Email: michael@abeconsulting.com.au	Email: benw@pwna.com.au	Email: jakibaloh@archaeological.com.a	Email: mrourke@webbaustralia.com.au	Email: steven@concisecert.com.au	Email: peter@mogamma.com.au	Email: andy@polymerstudios.com.au	Phone: (02) 9957 5019		N	117 Reservoir Street	GROUND RCP DEMOLITION	CHECKED
			to the architect. These designs, plans,	DRONE PHOTOGRAPHER	ESD CONSULTANT	FIRE ENGINEERING	GEOTECHNICAL ENGINEER	HERITAGE	JV3	LANDSCAPE ARCHITECT	Email: dlavigne@centralelement.com.au			ABN: 46002722349	5	OHLONED
			specifications and the copyright therein are	Sky Monkey	Climatewise	Innova Fire Engineering	Ei Australia	Tonkin Zulaikha Greer	Certified Energy	Arcadia				P: (02) 9215 4900	5	
			the property of Tonkin Zulaikha Greer	Phone: 02 9630 7452	Phone: 0404 025 747	Phone: 1300 88 22 62	Phone: 02 9516 0722	Phone: 9215 4900	Phone: 02 9159 3932	Phone: 02 8571 2900				F: (02) 9215 4901	SCALES	DATE
		Architects Pty Ltd, and must not be	Email: Kelvin.Ong@skymonkey.com.au	Email: digby@climatewisedesign.com.au	Email: jason@innovaservices.com.au	Email: richard.sanchez@eiaustralia.com.au	Email: julie@tzg.com.au	Email: jobs@certifledenergy.com.au	Email: liamm@arcadiala.com.au	WASTE CONSULTANT			EMAIL info@tzg.com.au ARCHITECTS	1:100 @	a) A1 1/3/	
			reproduced or copied wholly or in part	MODELMAKER (DIGITAL/PHYSICA	LISERVICES ENGINEERS	STRUCTURAL/CIVIL ENGINEER	SURVEYOR	TOWN PLANNER	TRANSPORT ENGINEER	VIEW LOSS ASSESSMENT	WASTE CONSULTANT	SCALE 1:100			11.100 @	9.11
			without written permission of Tonkin Zulaikha	Polygenic	Evolved Engineering	BG&E	Geosurv	Planning Lab	The Transport Planning Partnership	Urbaine	Elephant's Foot Phone: 02 9780 3573	Name -		WEB www.tzg.com.au	PHASE DRAWING NO	REV
			Greer Architects Pty Ltd.	Phone: 0404 616 473	Phone: 0409 398 832	Phone: 0455 513 077	Phone: 0412 335 173	Phone: 0447 755 799	Phone: 0418 601 094	Phone: 0435 338 245	Phone: 02 9780 3573	PROJECT NO : 20024	3 4 5	··· 🕠	DEVELOPMENT APPLICATION	<b>\-060</b>
			Greet Architects Fty Ltd.	Email: sgreen@polygenic.com.au	Email: henry@evolvedengineering.com.ar	u Email: george.agamalis@bgeng.com	Email: nik@geosurv.com.au	Email: giovanni@planninglab.com	Email: jason.rudd@ttpp.net.au	Email: dan@urbaine.com.au	Email: whitney.brunson@elephantsfoot.com.au	FROJECT NO . 20024			DEVELOPMENT APPLICATION	. 00

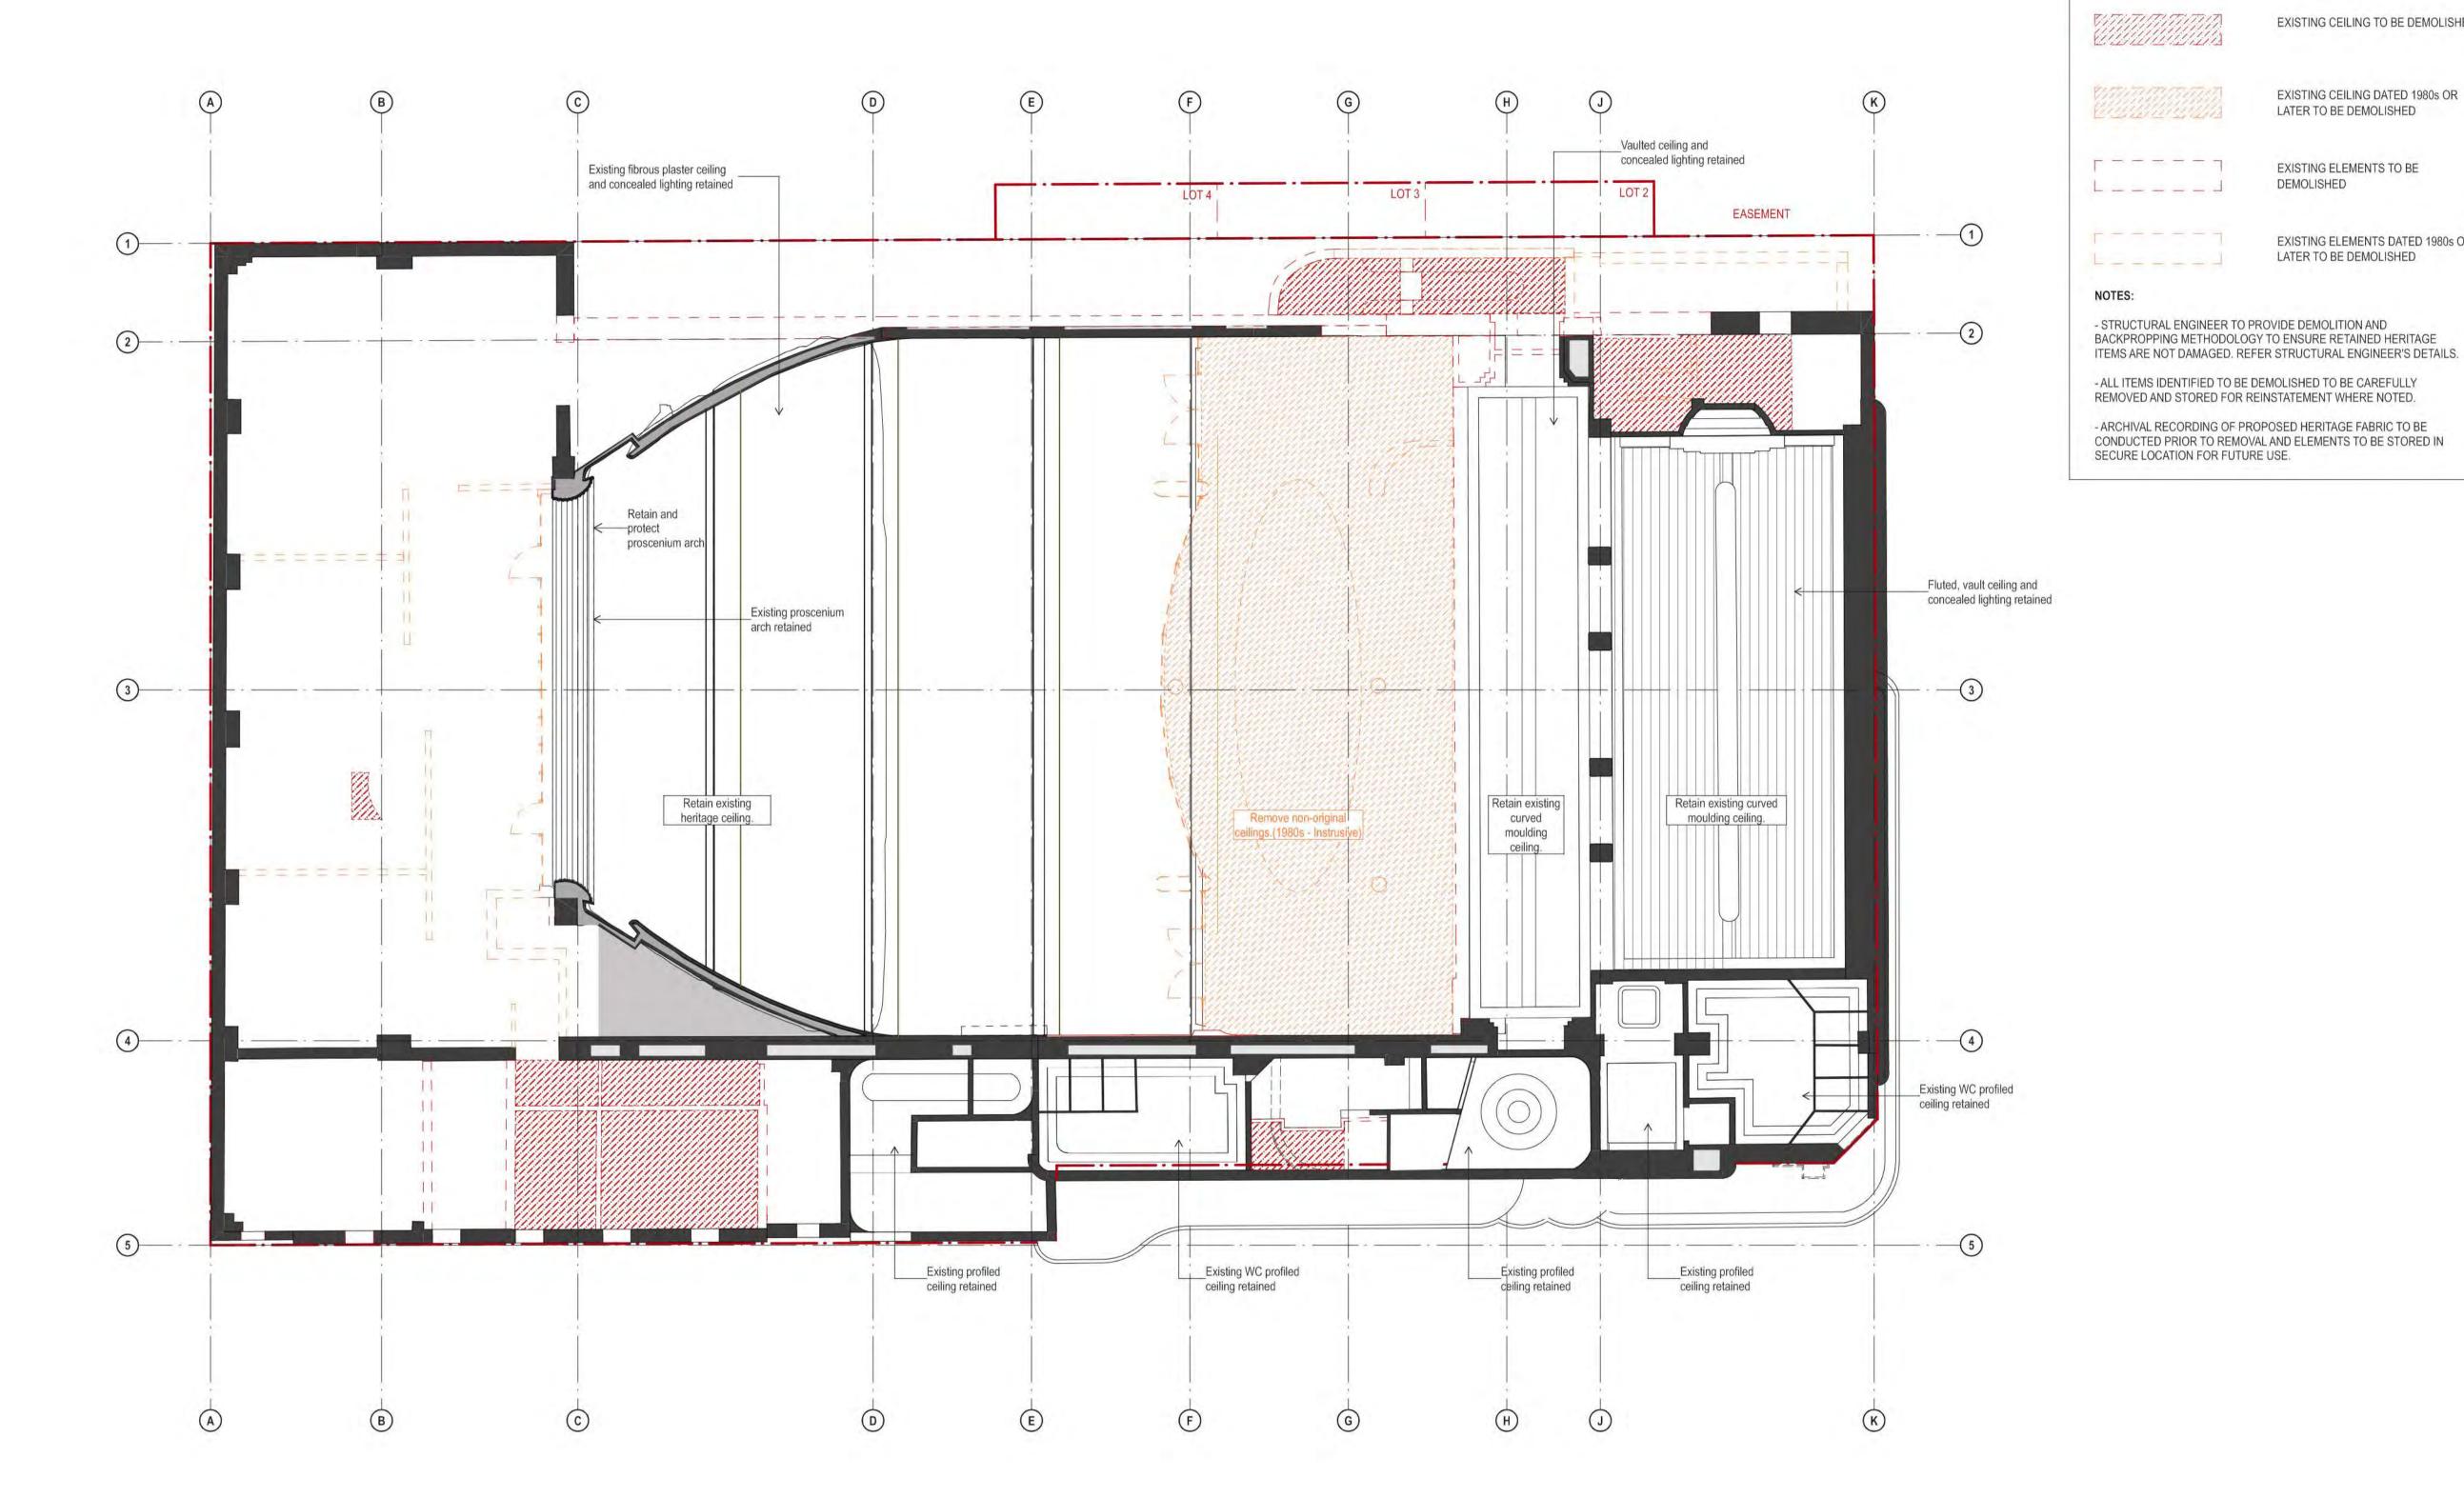

**DEMOLITION LEGEND** 

**EXISTING TO BE** RETAINED

EXISTING CEILING TO BE DEMOLISHED

EXISTING CEILING DATED 1980s OR

EXISTING ELEMENTS DATED 1980s OR


LATER TO BE DEMOLISHED

EXISTING ELEMENTS TO BE

LATER TO BE DEMOLISHED

DEMOLISHED

DATE	REV DESCRIPTION:	NOTES:		ACOUSTIC ENGINEER	ARCHAEOLOGY	ASP	BCA CONSULTANT	CGI	COMMUNITY CONSULTANT	CLIENT:	PROJECT:	ARCHITECT	DRAWING TITLE	DRAWN BY
2.JUL.2021	DEVELOPMENT APPLICATION	Do not scale off drawings. Use figured dimensions only. Report any discrepencies	ABE Consulting Phone: 0415 522 533 Email: michael@abeconsulting.com.au	Pulse White Noise Acoustics Phone: 0408 728 303 Email: benw@pwna.com.au	AMAC Phone: 9568 6093 Email: jakibaloh@archaeological.com.ai	Webb Phone: 02 9418 1444 Email: mrourke@webbaustralia.com.au	Concise Certification Phone: 0423 424 161 Email: steven@concisecert.com.au	Mogamma Phone: 0430 394 645 Email: peter@mogamma.com.au	Polymer Studios Phone: 1300 259 732 Email: andy@polymerstudios.com.au	Central Element Phone: (02) 9957 5019	THE MINERVA	TONKIN ZULAIKHA GREER ARCHITECTS 117 Reservoir Street	LEVEL 1 RCP DEMOLITION	CHECKED
		to the architect. These designs, plans, specifications and the copyright therein are the property of Tonkin Zulaikha Greer Architects Pty Ltd, and must not be	DRONE PHOTOGRAPHER Sky Monkey Phone: 02 9630 7452 Email: Kelvin.Ong@skymonkey.com.au	ESD CONSULTANT Climatewise Phone: 0404 025 747 Email: digby@climatewisedesign.com.au	FIRE ENGINEERING Innova Fire Engineering Phone: 1300 88 22 62 Email: jason@innovaservices.com.au	GEOTECHNICAL ENGINEER Ei Australia Phone: 02 9516 0722 Email: richard.sanchez@eiaustralia.com.au	HERITAGE Tonkin Zulaikha Greer Phone: 9215 4900 Email: julie@tzg.com.au	JV3 Certified Energy Phone: 02 9159 3932 Email: jobs@certifiedenergy.com.au	LANDSCAPE ARCHITECT Arcadia Phone: 02 8571 2900 Email: liamm@arcadiala.com.au	Email: dlavigne@centralelement.com.au		ABN: 46002722349	scales 1:100 @	DATE
		reproduced or copied wholly or in part without written permission of Tonkin Zulaikha Greer Architects Pty Ltd.	MODELMAKER (DIGITAL/PHYSICAL Polygenic Phone: 0404 616 473 Email: sgreen@polygenic.com.au	SERVICES ENGINEERS  Evolved Engineering  Phone: 0409 398 832  Email: henry@evolvedengineering.com.a	STRUCTURAL/CIVIL ENGINEER  BG&E Phone: 0455 513 077  u Email: george.agamalis@bgeng.com	SURVEYOR  Geosurv  Phone: 0412 335 173  Email: nik@geosurv.com.au	TOWN PLANNER Planning Lab Phone: 0447 755 799 Email: giovanni@planninglab.com	TRANSPORT ENGINEER The Transport Planning Partnership Phone: 0418 601 094 Email: jason.rudd@ttpp.net.au	VIEW LOSS ASSESSMENT Urbaine Phone: 0435 338 245 Email: dan@urbaine.com.au	WASTE CONSULTANT  Elephant's Foot  Phone: 02 9780 3573  Email: whitney.brunson@elephantsfoot.com.au	SCALE 1:100 PROJECT NO : 20024	EMAIL info@tzg.com.au  WEB www.tzg.com.au  ARCHITECTS	PHASE DRAWING NO	W A 1 1/3

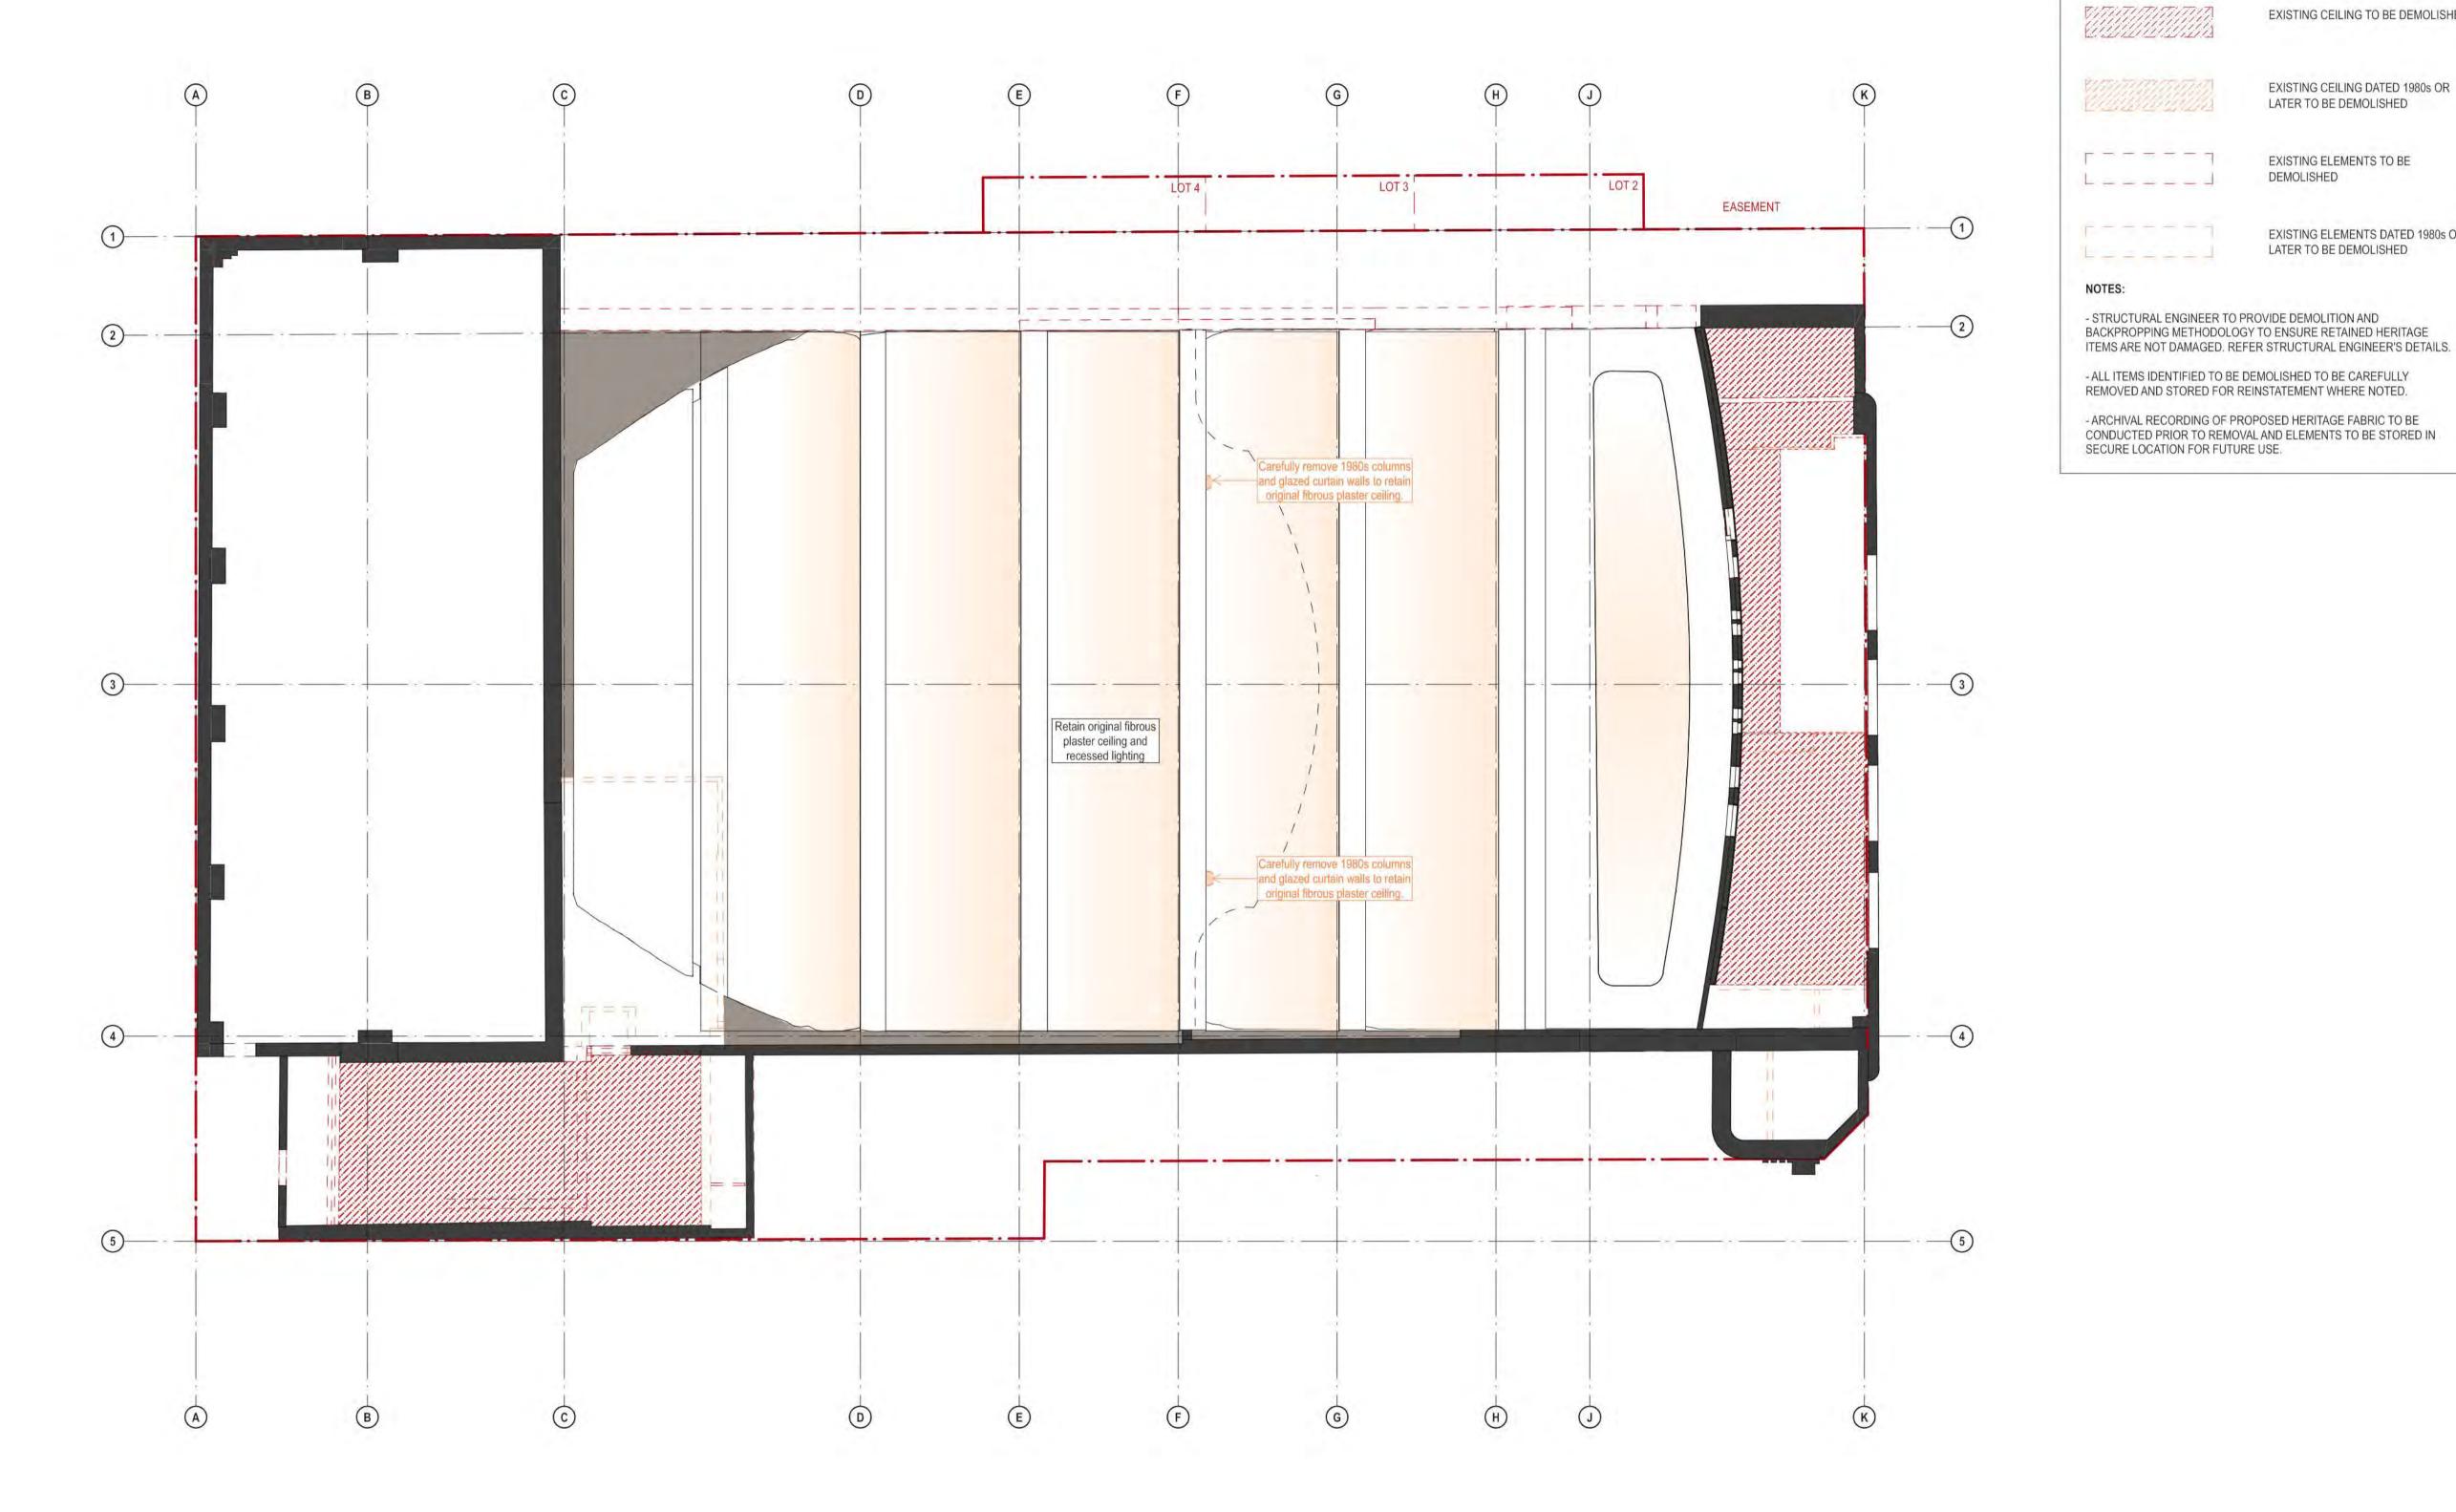

DRAWING TITLE	MOUTION.	DRAWN BY
LEVEL 3 RCP DE	CHECKED	
SCALES	DATE 1/3/202	
PHASE DEVELOPMENT APPLICATION	1:100 @ A1  DRAWING NO A-062	REV

**DEMOLITION LEGEND** 

**EXISTING TO BE** RETAINED

EXISTING CEILING TO BE DEMOLISHED

EXISTING CEILING DATED 1980s OR

EXISTING ELEMENTS DATED 1980s OR

LATER TO BE DEMOLISHED

EXISTING ELEMENTS TO BE

LATER TO BE DEMOLISHED

DEMOLISHED

DATE	REV	DESCRIPTION:	NOTES:	ACCESS
22.JUL.2021		DEVELOPMENT APPLICATION	Do not scale off drawings. Use figured	ABE Consul Phone: 0415
01 MAR 2023	A	DEVELOPMENT APPLICATION	dimensions only. Report any discrepencies	Email: micha
			to the architect. These designs, plans,	DRONE P
			specifications and the copyright therein are	Sky Monkey
			the property of Tonkin Zulaikha Greer	Phone: 02 96 Email: Kelvin
			Architects Pty Ltd, and must not be	MODELMA
			reproduced or copied wholly or in part	Polygenic
			without written permission of Tonkin Zulaikha Greer Architects Pty Ltd.	Phone: 0404 Email: scree

5	ACCESS CONSULTANT  ABE Consulting Phone: 0415 522 533  Email: michael@abeconsulting.com.au	ACOUSTIC ENGINEER Pulse White Noise Acoustics Phone: 0408 728 303 Email: benw@pwna.com.au	ARCHAEOLOGY  AMAC  Phone: 9568 6093  Email: jakibaloh@archaeological.com,au	ASP Webb Phone: 02 9418 1444 Email: mrourke@webbaustralia.com
9	DRONE PHOTOGRAPHER Sky Monkey Phone: 02 9630 7452 Email: Kelvin.Ong@skymonkey.com.au	ESD CONSULTANT Climatewise Phone: 0404 025 747 Email: digby@climatewisedesign.com.au	FIRE ENGINEERING Innova Fire Engineering Phone: 1300 88 22 62 Email: jason@innovaservices.com.au	GEOTECHNICAL ENGINEER Ei Australia Phone: 02 9516 0722 Email: richard.sanchez@eiaustralia.com.a
na	MODELMAKER (DIGITAL/PHYSICAL) Polygenic Phone: 0404 616 473 Email: sgreen@polygenic.com.au	SERVICES ENGINEERS Evolved Engineering Phone: 0409 398 832 Email: henry@evolvedengineering.com.au	STRUCTURAL/CIVIL ENGINEER  BG&E Phone: 0455 513 077 Email: george.agamalis@bgeng.com	SURVEYOR Geosurv Phone: 0412 335 173 Email: nik@geosurv.com.au

	ASP	BCA CONSULTANT	CGI
	Webb	Concise Certification	Mogamma
	Phone: 02 9418 1444	Phone: 0423 424 161	Phone: 0430 394 645
n,au	Email: mrourke@webbaustralia.com.au	Email: steven@concisecert.com.au	Email: peter@mogamma.c
	GEOTECHNICAL ENGINEER	HERITAGE	JV3
	Ei Australia	Tonkin Zulaikha Greer	Certified Energy
	Phone: 02 9516 0722	Phone: 9215 4900	Phone: 02 9159 3932
1	Email: richard.sanchez@eiaustralia.com.au	Email: julie@tzg.com.au	Email: jobs@certifiedenerg
7	SURVEYOR	TOWN PLANNER	TRANSPORT ENGIN
	Geosurv	Planning Lab	The Transport Planning
	Phone: 0412 335 173	Phone: 0447 755 799	Phone: 0418 601 094
	Email: nik@googun/com au	Email: gigyanni@nlanninglah.com	Email: iacon rudd@ttnn no

COMMUNITY CONSULTANT Polymer Studios Phone: 1300 259 732 Email: andy@polymerstudios.com.au	CLIENT: Central Element Phone: (02) 9957 5019
LANDSCAPE ARCHITECT Arcadia Phone: 02 8571 2900 Email: liamm@arcadiala.com.au	Email: dlavigne@centralelement.com
VIEW LOSS ASSESSMENT Urbaine Phone: 0435 338 245	WASTE CONSULTANT Elephant's Foot Phone: 02 9780 3573

Email: whitney.brunson@elephantsfoot.com.au


N	TONKIN Z 117 Reser ABN: 4600
	P: (02) 92° F: (02) 92° EMAIL inf WEB www
	Z

PROJECT NO : 20024


ARCHITECT		
TONKIN ZULAIKHA GREE	R ARCHITECTS	
117 Reservoir Street	10	
ABN: 46002722349	Q	
P: (02) 9215 4900	ON	
F: (02) 9215 4901	<u> </u>	
EMAIL info@tzg.com.au	ARCHITECTS	
WEB www.tzg.com.au		
the specific of a series of a series of a series of the se		ř

TECTS	DRAWING TILL	121 121 271	
<sup>ල</sup>	LEVEL 3 RCP DE	MOLITION	CHECKED
PUNITE PRINT	SCALES	1:100 @ A1	DATE 1/3
Kha	PHASE DEVELOPMENT APPLICATION	DRAWING NO A-062	REV



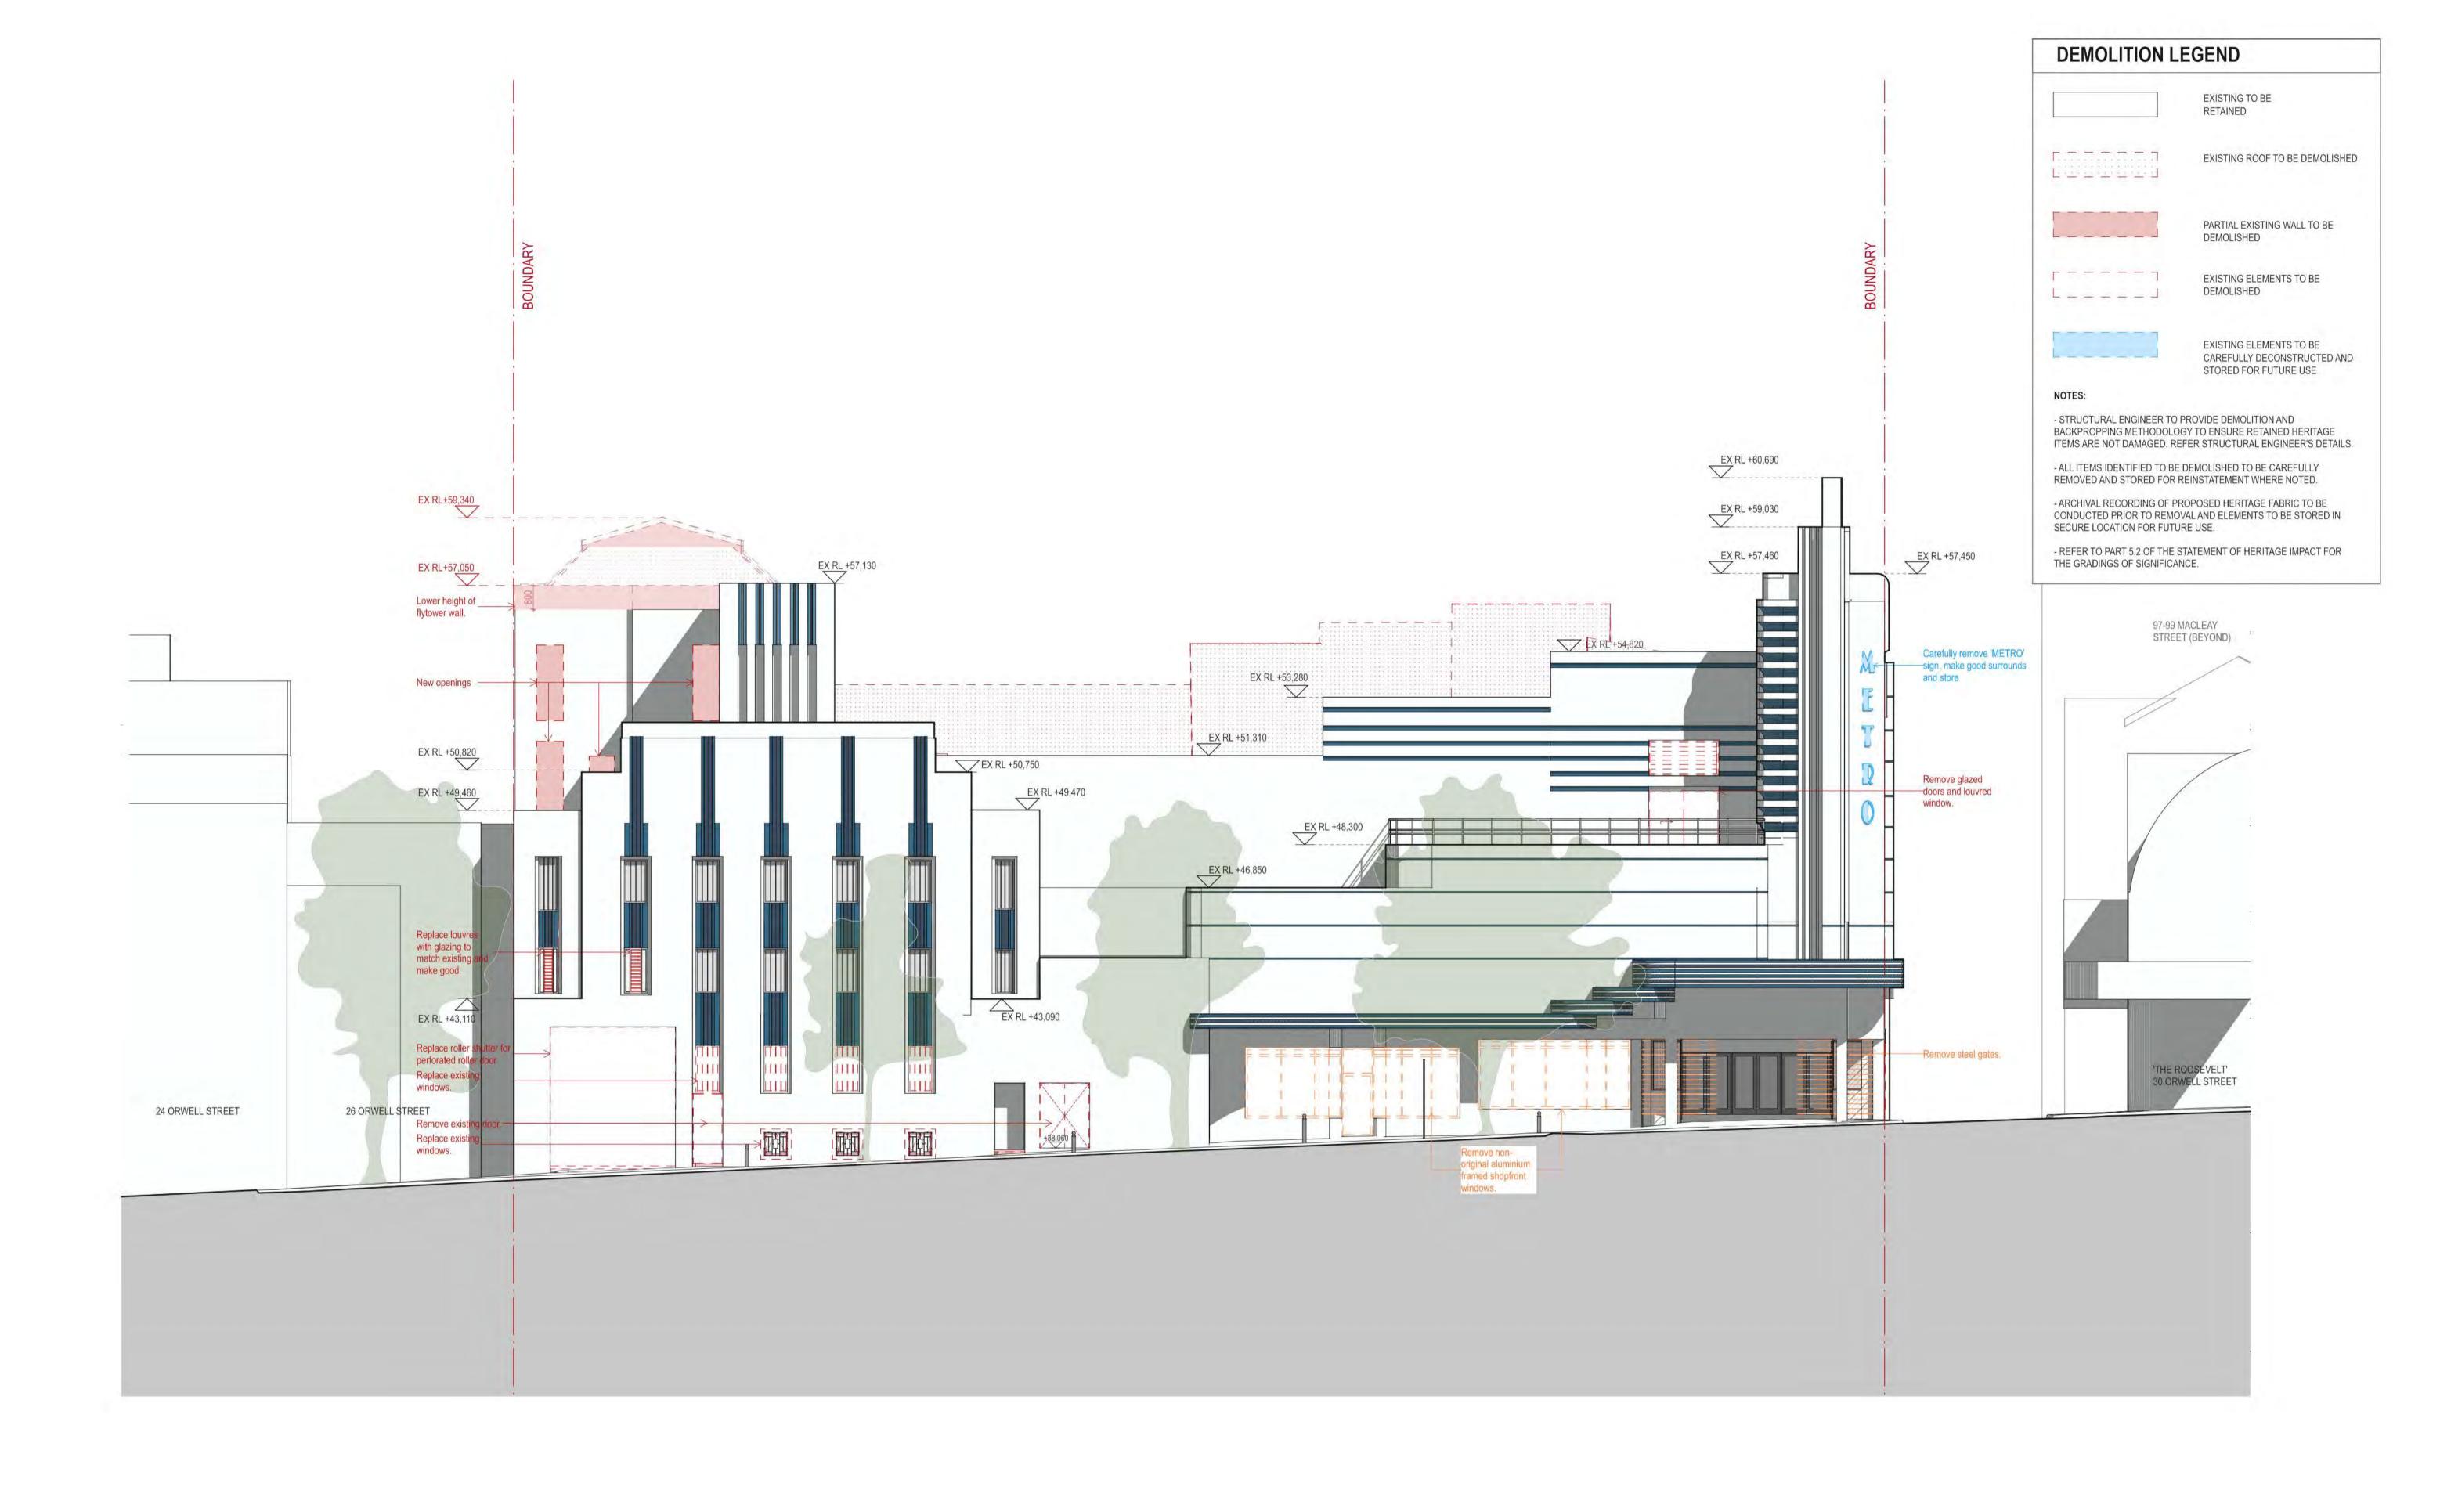


DATE	REV	DESCRIPTION:	NOTES:	ACCESS CONSULTANT	ACOUSTIC ENGINEER	ARCHAEOLOGY	ASP	BCA CONSULTANT	CGI	COMMUNITY CONSULTANT	CLIENT:	PROJECT:	ARCHITECT	DRAWING TITLE	DRAWN BY
22.JUL.2021	(*)	DEVELOPMENT APPLICATION	Do not scale off drawings. Use figured	Phone: 0415 522 533	Pulse White Noise Acoustics	Phone: 9568 6093	Phone: 02 9418 1444	Concise Certification Phone: 0423 424 161	Phone: 0430 394 645	Phone: 1300 259 732	Central Element	THE MINERVA	TONKIN ZULAIKHA GREER ARCHITECTS	DEMOLITICAL COLUTILIES EL CLATICAL	TS, T
29.NOV.2022	Α	DEVELOPMENT APPLICATION	dimensions only. Report any discrepencies	Email: michael@abeconsulting.com.au	Email: benw@pwna.com.au	Email: jakibaloh@archaeological.com.ar	u Email: mrourke@webbaustralia.com.au	Email: steven@concisecert.com.au	Email: peter@mogamma.com.au	Email: andy@polymerstudios.com.au	Phone: (02) 9957 5019	-2 (3- ) (3- )	117 Reservoir Street	DEMOLITION SOUTH ELEVATION	CHECKED
01 MAR 2023	В	DEVELOPMENT APPLICATION	to the architect. These designs, plans, specifications and the copyright therein are	DRONE PHOTOGRAPHER Sky Monkey	ESD CONSULTANT Climatewise	FIRE ENGINEERING Innova Fire Engineering	GEOTECHNICAL ENGINEER Ei Australia	HERITAGE Tonkin Zulaikha Greer	JV3 Certified Energy	LANDSCAPE ARCHITECT	Email: dlavigne@centralelement.com.au		ABN: 46002722349		T
			the property of Tonkin Zulaikha Greer Architects Pty Ltd, and must not be	Phone: 02 9630 7452 Email: Kelvin.Ong@skymonkey.com.au	Phone: 0404 025 747 Email: dígby@climatewisedesign.com.au	Phone: 1300 88 22 62 Email: jason@innovaservices.com.au	Phone: 02 9516 0722 Email: richard.sanchez@eiaustralia.com.au	Phone: 9215 4900 Email: julle@tzg.com.au	Phone: 02 9159 3932 Email: jobs@certifiedenergy.com.au	Phone: 02 8571 2900 Email: liamm@arcadiala.com.au			P: (02) 9215 4900 F: (02) 9215 4901	scales 1:100 @ A	DATE
			reproduced or copied wholly or in part	MODELMAKER (DIGITAL/PHYSIC	CAL SERVICES ENGINEERS	STRUCTURAL/CIVIL ENGINEER	SURVEYOR	TOWN PLANNER	TRANSPORT ENGINEER	VIEW LOSS ASSESSMENT	WASTE CONSULTANT	SCALE 1:100	EMAIL info@tzg.com.au ARCHITECTS	1.100 @ F	A 1 1/3/2027
			without written permission of Tonkin Zulaikha Greer Architects Pty Ltd.	Polygenic Phone: 0404 616 473 Email: screen@polygenic.com.au	Evolved Engineering Phone: 0409 398 832 Email: henry@evolvedengineering.com.au	BG&E Phone: 0455 513 077 Fmail: george agamalis@bgeog.com	Geosurv Phone: 0412 335 173 Email: nik@geosury.com.au	Planning Lab Phone: 0447 755 799 Email: niovanni@planninglab.com	The Transport Planning Partnership Phone: 0418 601 094	Urbaine Phone: 0435 338 245 Email: dan@urbaine.com.au	Elephant's Foot Phone: 02 9780 3573 Email: whitney.brunson@elephantsfoot.com.au	PROJECT NO : 20024	WEB www.tzg.com.au	PHASE DRAWING NO A-0	070 REV B

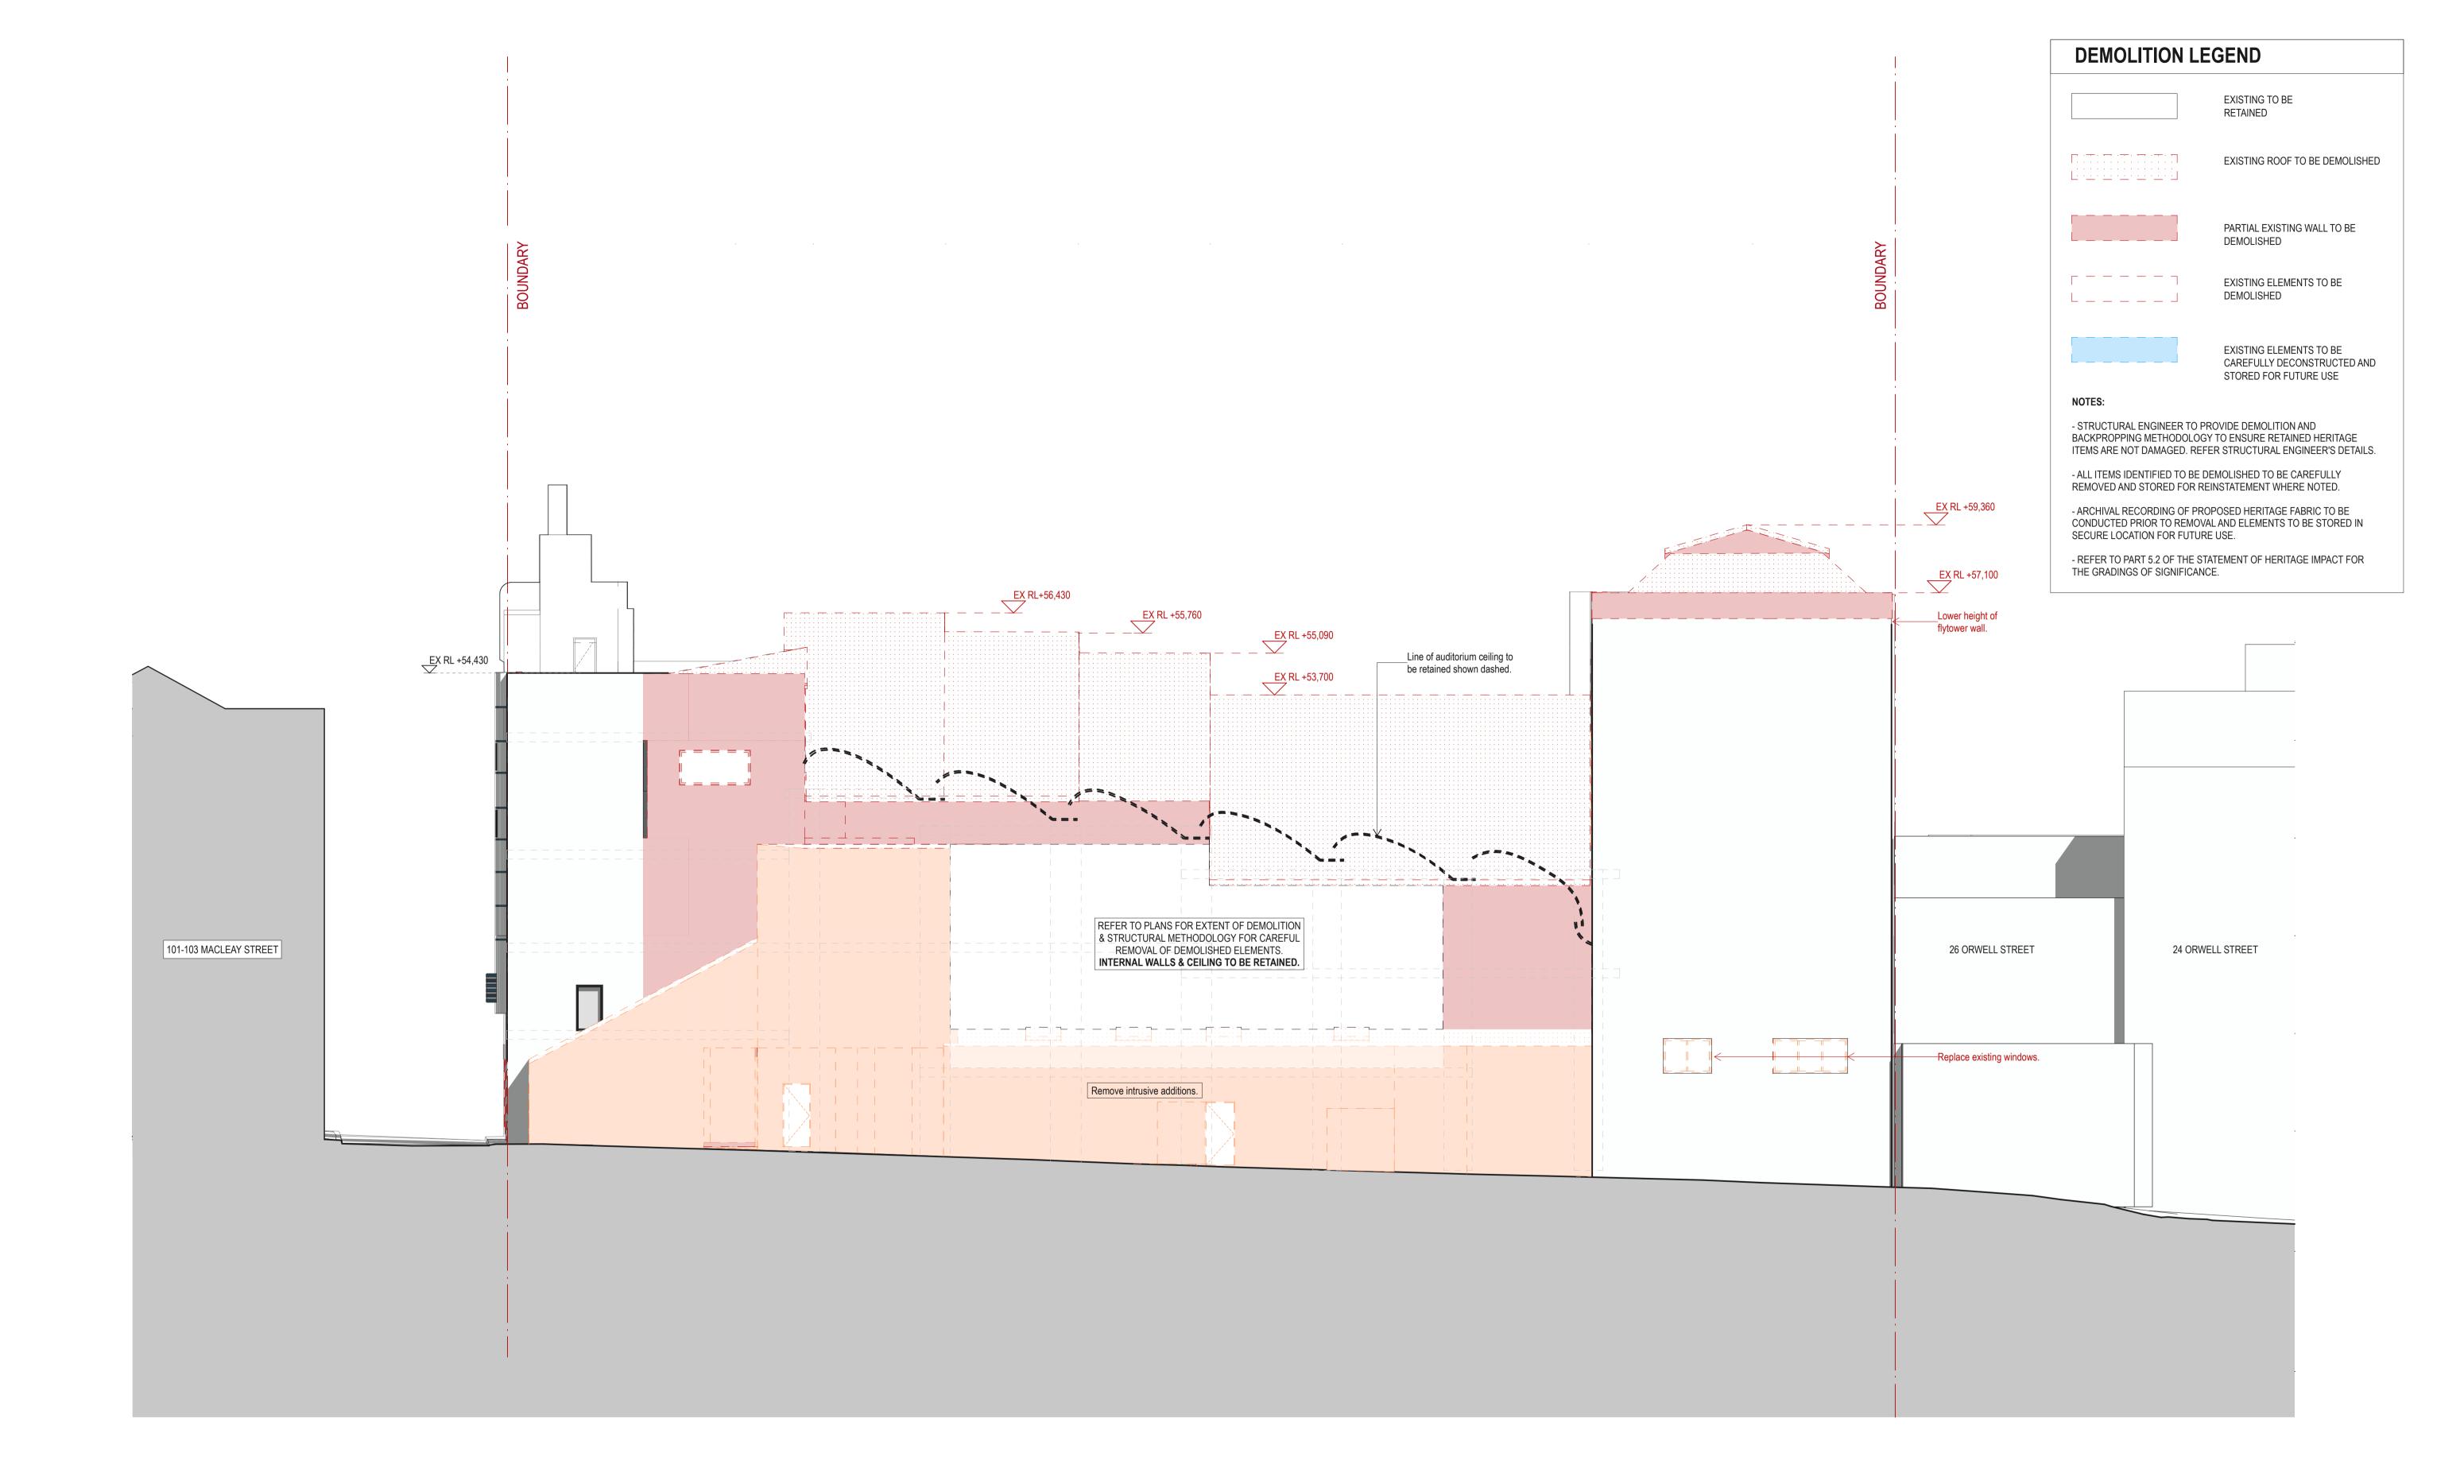

DATE	REV	/ DESCRIPTION:	NOTES:	ACCESS CONSULTANT	ACOUSTIC ENGINEER	ARCHAEOLOGY	ASP	BCA CONSULTANT	CGI	COMMUNITY CONSULTANT	CLIENT:	PROJECT:	ARCHITECT	DRAWING TITLE		DRAWN BY
22.JUL.2021	-	DEVELOPMENT APPLICATION	Do not scale off drawings. Use figured	ABE Consulting Phone: 0415 522 533	Pulse White Noise Acoustics Phone: 0408 728 303	AMAC Phone: 9568 6093	Webb Phone: 02 9418 1444	Concise Certification Phone: 0423 424 161	Mogamma Phone: 0430 394 645	Phone: 1300 259 732	Central Element	THE MINERVA	TONKIN ZULAIKHA GREER ARCHITECTS	DEMONITION NODE	1 E1 E) /ATION	TS, TI
29.NOV.2022	Α	DEVELOPMENT APPLICATION	dimensions only. Report any discrepencies	Email: michael@abeconsulting.com.au	Email: benw@pwna.com.au	Email: jakibaloh@archaeological.com.au	Email: mrourke@webbaustralia.com.au	Email: steven@concisecert.com.au	Email: peter@mogamma.com.au	Email: andy@polymerstudios.com.au	Phone: (02) 9957 5019		117 Reservoir Street	DEMOLITION NORTH	H ELEVATION	CHECKED
01 MAR 2023	В	DEVELOPMENT APPLICATION	to the architect. These designs, plans,	DRONE PHOTOGRAPHER	ESD CONSULTANT	FIRE ENGINEERING	GEOTECHNICAL ENGINEER	HERITAGE	JV3	LANDSCAPE ARCHITECT	Email: dlavigne@centralelement.com.au		ABN: 46002722349	7		CHLCKLD
27 APR 2023	С	DEVELOPMENT APPLICATION	specifications and the copyright therein are	Sky Monkey	Climatewise	Innova Fire Engineering	Ei Australia	Tonkin Zulaikha Greer	Certified Energy	Arcadia			P: (02) 9215 4900	§		18
			the property of Tonkin Zulaikha Greer Architects Pty Ltd, and must not be	Phone: 02 9630 7452 Email: Kelvin.Ong@skymonkey.com.au	Phone: 0404 025 747 Email: digby@climatewisedesign.com.au	Phone: 1300 88 22 62 Email: jason@innovaservices.com.au	Phone: 02 9516 0722 Email: richard.sanchez@eiaustralia.com.au	Phone: 9215 4900 Email: julie@tzg.com.au	Phone: 02 9159 3932 Email: jobs@certifiedenergy.com.au	Phone: 02 8571 2900 Email: liamm@arcadiala.com.au			F: (02) 9215 4901	SCALES	1.100 @ 11	DATE
			reproduced or copied wholly or in part	MODELMAKER (DIGITAL/PHYSICAL	L) SERVICES ENGINEERS	STRUCTURAL/CIVIL ENGINEER	SURVEYOR	TOWN PLANNER	TRANSPORT ENGINEER	VIEW LOSS ASSESSMENT	WASTE CONSULTANT	SCALE 1:100	EMAIL info@tzg.com.au ARCHITECTS	A	1:100 @ A1	1/5/2023
			without written permission of Tonkin Zulaikha	Polygenic Phone: 0404 616 473	Evolved Engineering Phone: 0409 398 832	<b>BG&amp;E</b> Phone: 0455 513 077	<b>Geosurv</b> Phone: 0412 335 173	Planning Lab Phone: 0447 755 799	The Transport Planning Partnership Phone: 0418 601 094	<b>Urbaine</b> Phone: 0435 338 245	Elephant's Foot Phone: 02 9780 3573	1 0 1 2 3 4 5i	WEB www.tzg.com.au		AWING NO A-071	REV
			Greer Architects Pty Ltd.	Email: sgreen@polygenic.com.au	Email: henry@evolvedengineering.com.au	Email: george.agamalis@bgeng.com	Email: nik@geosurv.com.au	Email: giovanni@planninglab.com	Email: jason.rudd@ttpp.net.au	Email: dan@urbaine.com.au	Email: whitney.brunson@elephantsfoot.com.au	PROJECT NO: 20024	777	DEVELOPMENT APPLICATION	A-07 I	



DATE	REV	DESCRIPTION:	NOTES:	ACCESS CONSULTANT	ACOUSTIC ENGINEER	ARCHAEOLOGY	ASP	BCA CONSULTANT	CGI	COMMUNITY CONSULTANT	CLIENT:	PROJECT:	ARCHITECT	DRAWING TITLE	DRAWN BY
2.JUL.2021		DEVELOPMENT APPLICATION	Do not scale off drawings. Use figured	Phone: 0415 522 533 Phone: 040 Email: michael@abeconsulting.com.au Email: beny	Phone: 0408 728 303 Phone: 9568 6093	AMAC Phone: 9568 6093	Phone: 02 9418 1444 au Email: mrourke@webbaustralia.com.au	Phone: 0423 424 161 Email: steven@concisecert.com.au	Phone: 0430 394 645 Email: peter@mogamma.com.au	Polymer Studios Phone: 1300 259 732 m.au Email: andy@polymerstudios.com.au	Central Element Phone: (02) 9957 5019	THE MINERVA  TONKIN ZULAIKHA GREER AR 117 Reservoir Street	TONKIN ZUI AIKHA GREER ARCHITECTS	DEMOLITION EAST ELEVATION	TS, TI
18.NOV.2022	Α	DEVELOPMENT APPLICATION	dimensions only. Report any discrepencies		Email: benw@pwna.com.au	ail: benw@pwna.com.au Email: jakibaloh@archaeological.com,au								DEMOLITION EAST ELEVATION	CHECKED
29.NOV.2022	В	DEVELOPMENT APPLICATION	to the architect. These designs, plans,	DRONE PHOTOGRAPHER	ESD CONSULTANT	FIRE ENGINEERING	GEOTECHNICAL ENGINEER	HERITAGE	JV3	LANDSCAPE ARCHITECT	Email: dlavigne@centralelement.com.au		ABN: 46002722349	<b>†</b>	CHECKED
01 MAR 2023	С	DEVELOPMENT APPLICATION	specifications and the copyright therein are the property of Tonkin Zulaikha Greer Architects Pty Ltd, and must not be	Sky Monkey Phone: 02 9630 7452 Email: Kelvin.Ong@skymonkey.com.au	Climatewise Phone: 0404 025 747 Email: digby@climatewisedesign.com.au	Innova Fire Engineering Phone: 1300 88 22 62 Email: jason@innovaservices.com.au	Ei Australia Phone: 02 9516 0722 Email: richard.sanchez@eiaustralia.com.au	Tonkin Zulaikha Greer Phone: 9215 4900 Email: julle@tzg.com.au	Certified Energy Phone: 02 9159 3932 Email: jobs@certifiedenergy.com.au	Arcadia Phone: 02 8571 2900 Email: liamm@arcadiala.com.au			P: (02) 9215 4900 F: (02) 9215 4901	SCALES 1:100 (	DATE
			reproduced or copied wholly or in part	MODELMAKER (DIGITAL/PHYSICA	L SERVICES ENGINEERS	STRUCTURAL/CIVIL ENGINEER	SURVEYOR	TOWN PLANNER	TRANSPORT ENGINEER	VIEW LOSS ASSESSMENT	WASTE CONSULTANT	SCALE 1:100	EMAIL Into@tzg.com.au ARCHITECTS	1,100 (	JU A 1 1/3/2023
			without written permission of Tonkin Zulaikha Greer Architects Pty Ltd.	Polygenic Phone: 0404 616 473 Email: sgreen@polygenic.com.au	Evolved Engineering Phone: 0409 398 832 Email: henry@evolvedengineering.com.a	BG&E Phone: 0455 513 077 Email: george.agamalis@bgeng.com	Geosurv Phone: 0412 335 173 Email: nik@geosury.com.au	Planning Lab Phone: 0447 755 799 Email: glovanni@planninglab.com	The Transport Planning Partnership Phone: 0418 601 094 Email: jason.rudd@ttop.net.au	Urbaine Phone: 0435 338 245 Email: dan@urbaine.com.au	Elephant's Foot Phone: 02 9780 3573 Email: whitney brunson@elephantsfoot.com.au	PROJECT NO : 20024 3	WEB www.tzg.com.au	PHASE DEVELOPMENT APPLICATION DRAWING NO	4-072 REV

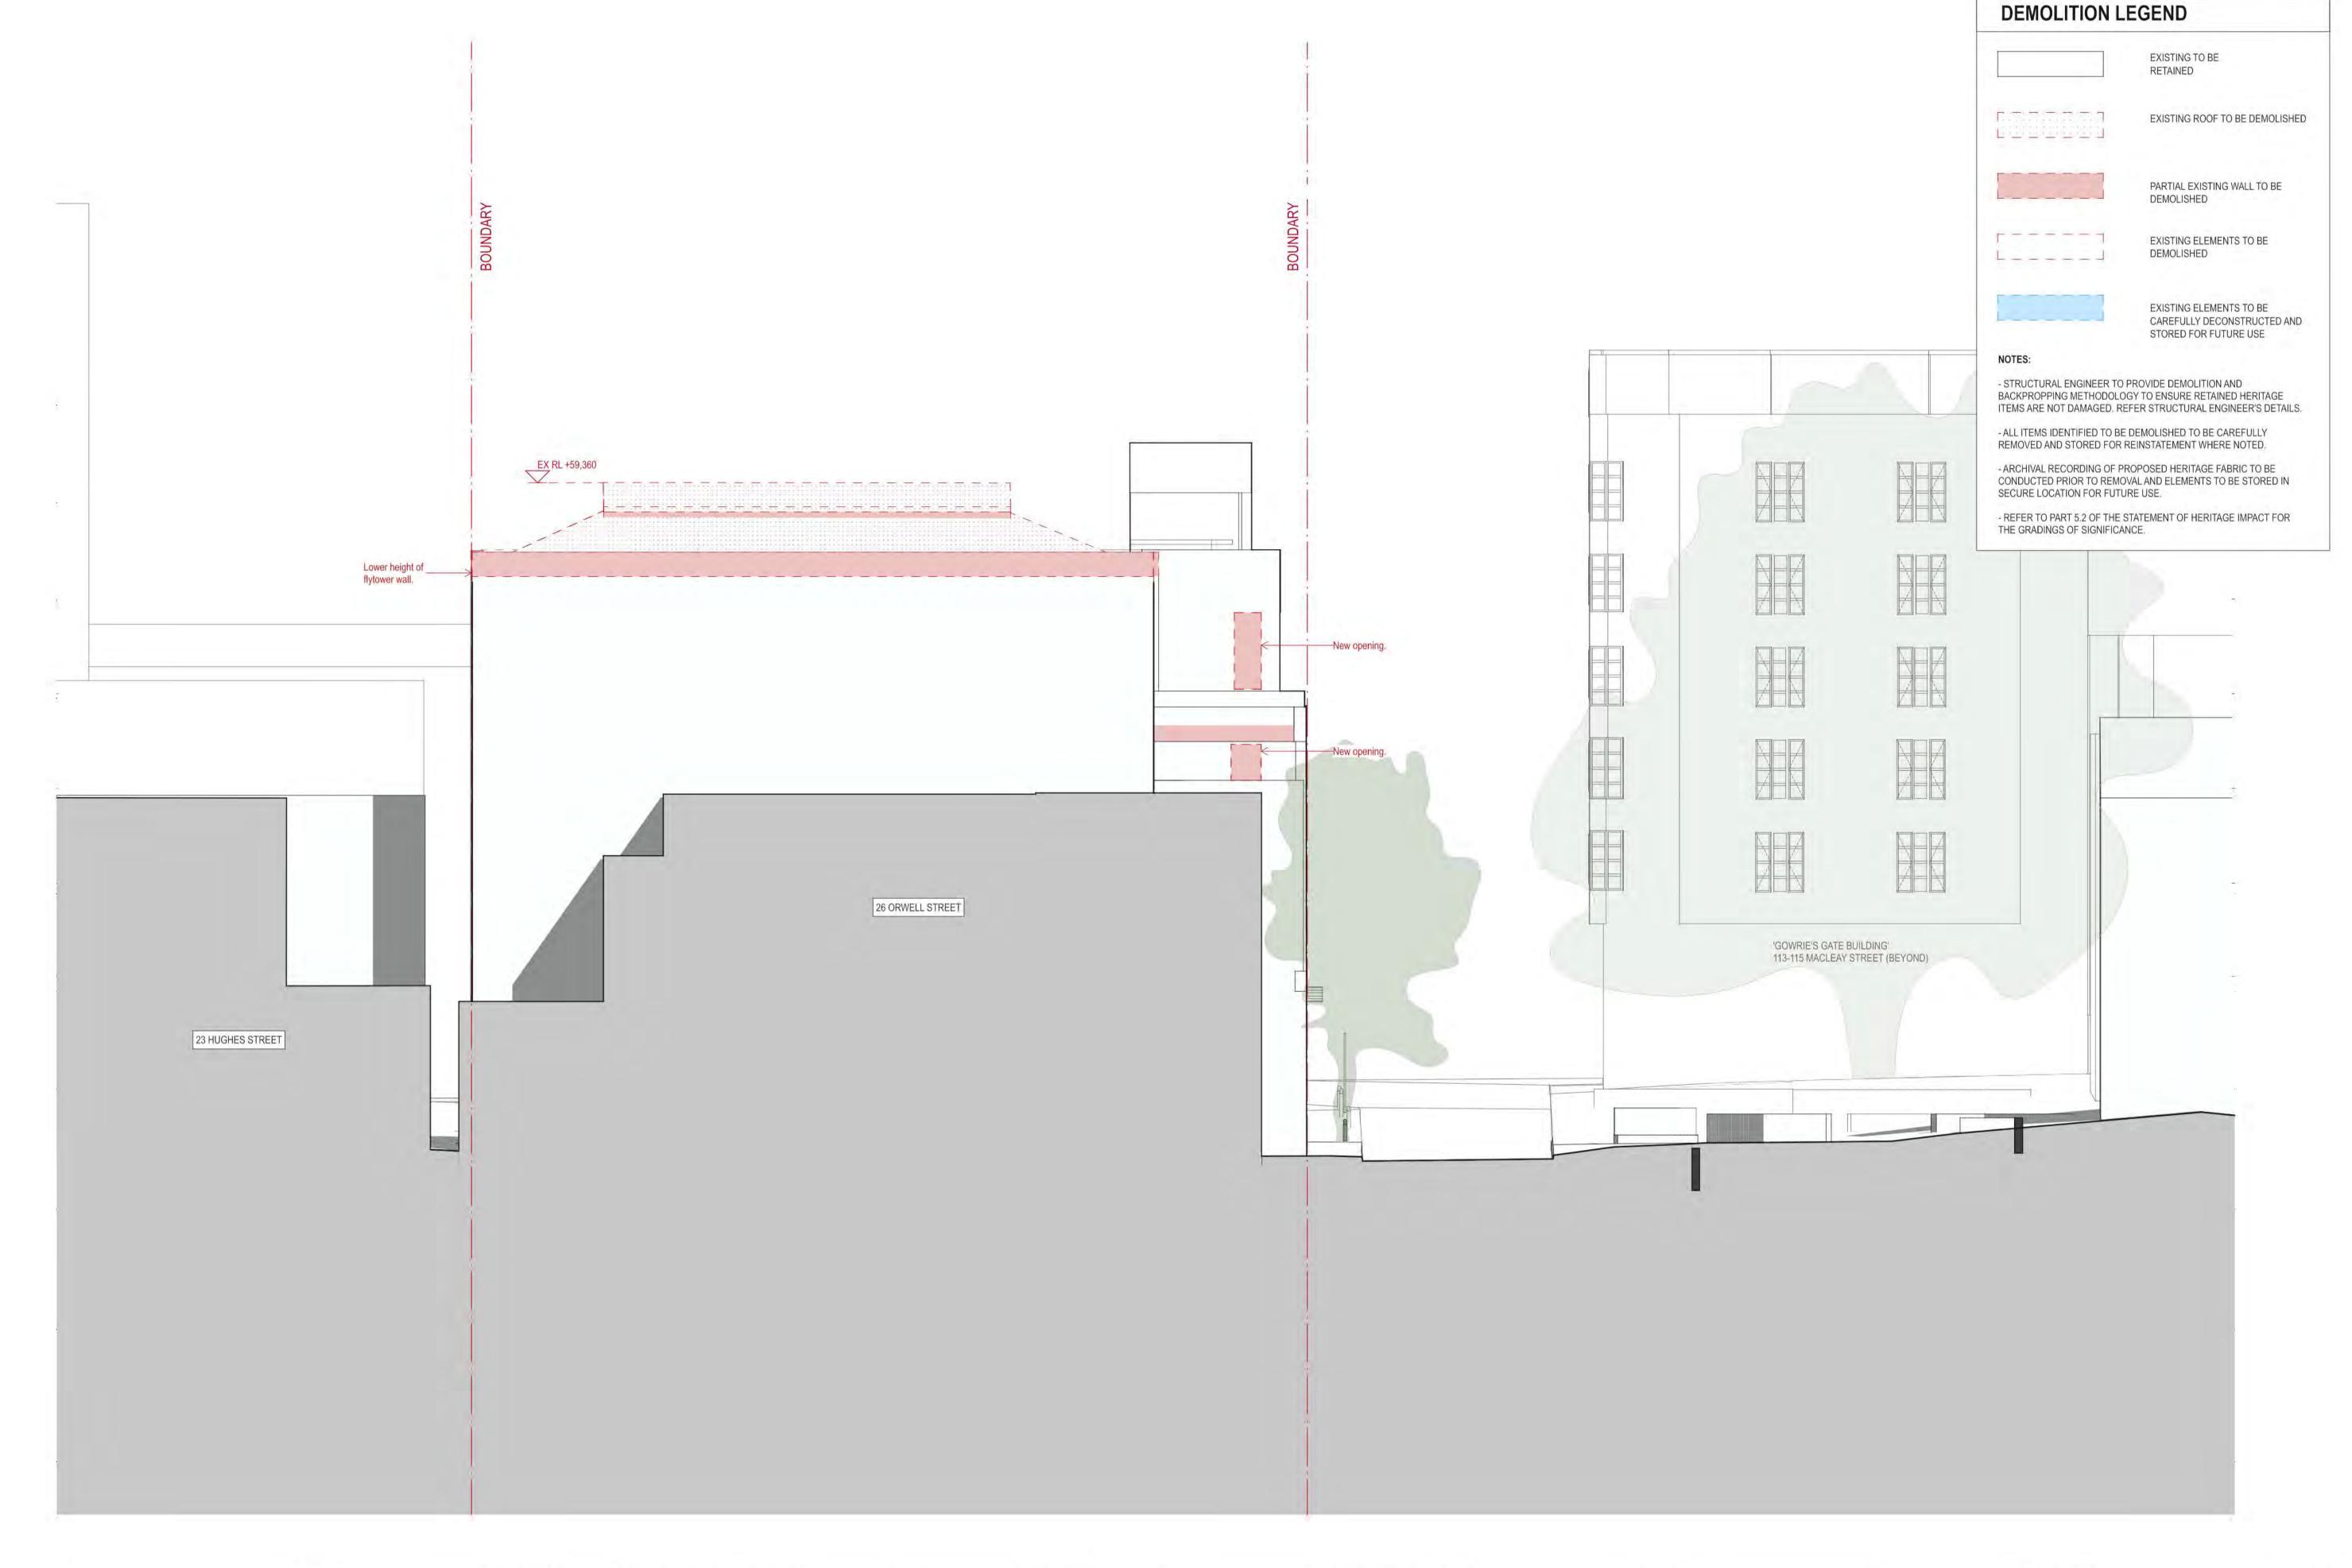

DATE	REV	DESCRIPTION:	NOTES:	ACCESS CONSULTANT	ACOUSTIC ENGINEER	ARCHAEOLOGY	ASP	BCA CONSULTANT	CGI	COMMUNITY CONSULTANT	CLIENT:	PROJECT:	ARCHITECT	DRAWING TITLE	DRAWN BY
22.JUL.2021	(4)	DEVELOPMENT APPLICATION	Do not scale off drawings. Use figured	ABE Consulting Phone: 0415 522 533	Pulse White Noise Acoustics Phone: 0408 728 303	Phone: 9568 6093	Phone: 02 9418 1444	Concise Certification Phone: 0423 424 161	Phone: 0430 394 645	Polymer Studios Phone: 1300 259 732	Central Element	THE MINERVA	TONKIN ZULAIKHA GREER ARCHITECTS	DEMOLITICAL MEGT ELEVATION	TS
01 MAR 2023	A	DEVELOPMENT APPLICATION	dimensions only. Report any discrepencies	Email: michael@abeconsulting.com.au	Email: benw@pwna.com.au	Email: jakibaloh@archaeological.com.a	u Email: mrourke@webbaustralia.com.au	Email: steven@concisecert.com.au	Email: peter@mogamma.com.au	Email: andy@polymerstudios.com.au	Phone: (02) 9957 5019		117 Reservoir Street	DEMOLITION WEST ELEVATION	CHECKED
			to the architect. These designs, plans,	DRONE PHOTOGRAPHER	ESD CONSULTANT	FIRE ENGINEERING	GEOTECHNICAL ENGINEER	HERITAGE	JV3	LANDSCAPE ARCHITECT	Email: dlavigne@centralelement.com.au		ADAL 40000700040		CHECKED
			specifications and the copyright therein are	Sky Monkey	Climatewise	Innova Fire Engineering	Ei Australia	Tonkin Zulaikha Greer	Certified Energy	Arcadia			P: (02) 9215 4900		
			the property of Tonkin Zulaikha Greer Architects Pty Ltd, and must not be	Phone: 02 9630 7452 Email: Kelvin.Ong@skymonkey.com.au	Phone: 0404 025 747 Email: digby@climatewisedesign.com.au	Phone: 1300 88 22 62 Email: jason@innovaservices.com.au	Phone: 02 9516 0722 Email: richard.sanchez@eiaustralia.com.au	Phone: 9215 4900 Email: julie@tzg.com.au	Phone: 02 9159 3932 Email: jobs@certifiedenergy.com.au	Phone: 02 8571 2900 Email: liamm@arcadiala.com.au			F: (02) 9215 4901	scales 1:100 @	DATE
			reproduced or copied wholly or in part	MODELMAKER (DIGITAL/PHYSIC	AL SERVICES ENGINEERS	STRUCTURAL/CIVIL ENGINEER	SURVEYOR	TOWN PLANNER	TRANSPORT ENGINEER	VIEW LOSS ASSESSMENT	VIEW LOSS ASSESSMENT WASTE CONSULTANT	SCALE 1:100	EMAIL info@tzg.com.au ARCHITECTS	1.100 @	J A 1 1/3/2
			without written permission of Tonkin Zulaikha	Polygenic	Evolved Engineering	BG&E	Geosurv	Planning Lab	The Transport Planning Partnership	Urbaine	Elephant's Foot Phone: 02 9780 3573	MANA A	WEB www.tzg.com.au	PHASE DRAWING NO	REV
			Greer Architects Pty Ltd.	Email: sgreen@polygenic.com.au	Email: henry@evolvedengineering.com.au	Email: george.agamalls@bgeng.com	Phone: 0412 335 173 Email: nik@geosurv.com.au	Phone: 0447 755 799 Email: giovanni@planninglab.com	Phone: 0418 601 094 Email: lason.rudd@ttpp.net.au	Phone: 0435 338 245 Email: dan@urbaine.com.au	Email: whitney.brunson@elephantsfoot.com.au	PROJECT NO: 20024	0	DEVELOPMENT APPLICATION A	A-073



REV DESCRIPTION:

03.JUN.2022


DEVELOPMENT APPLICATION

DEVELOPMENT APPLICATION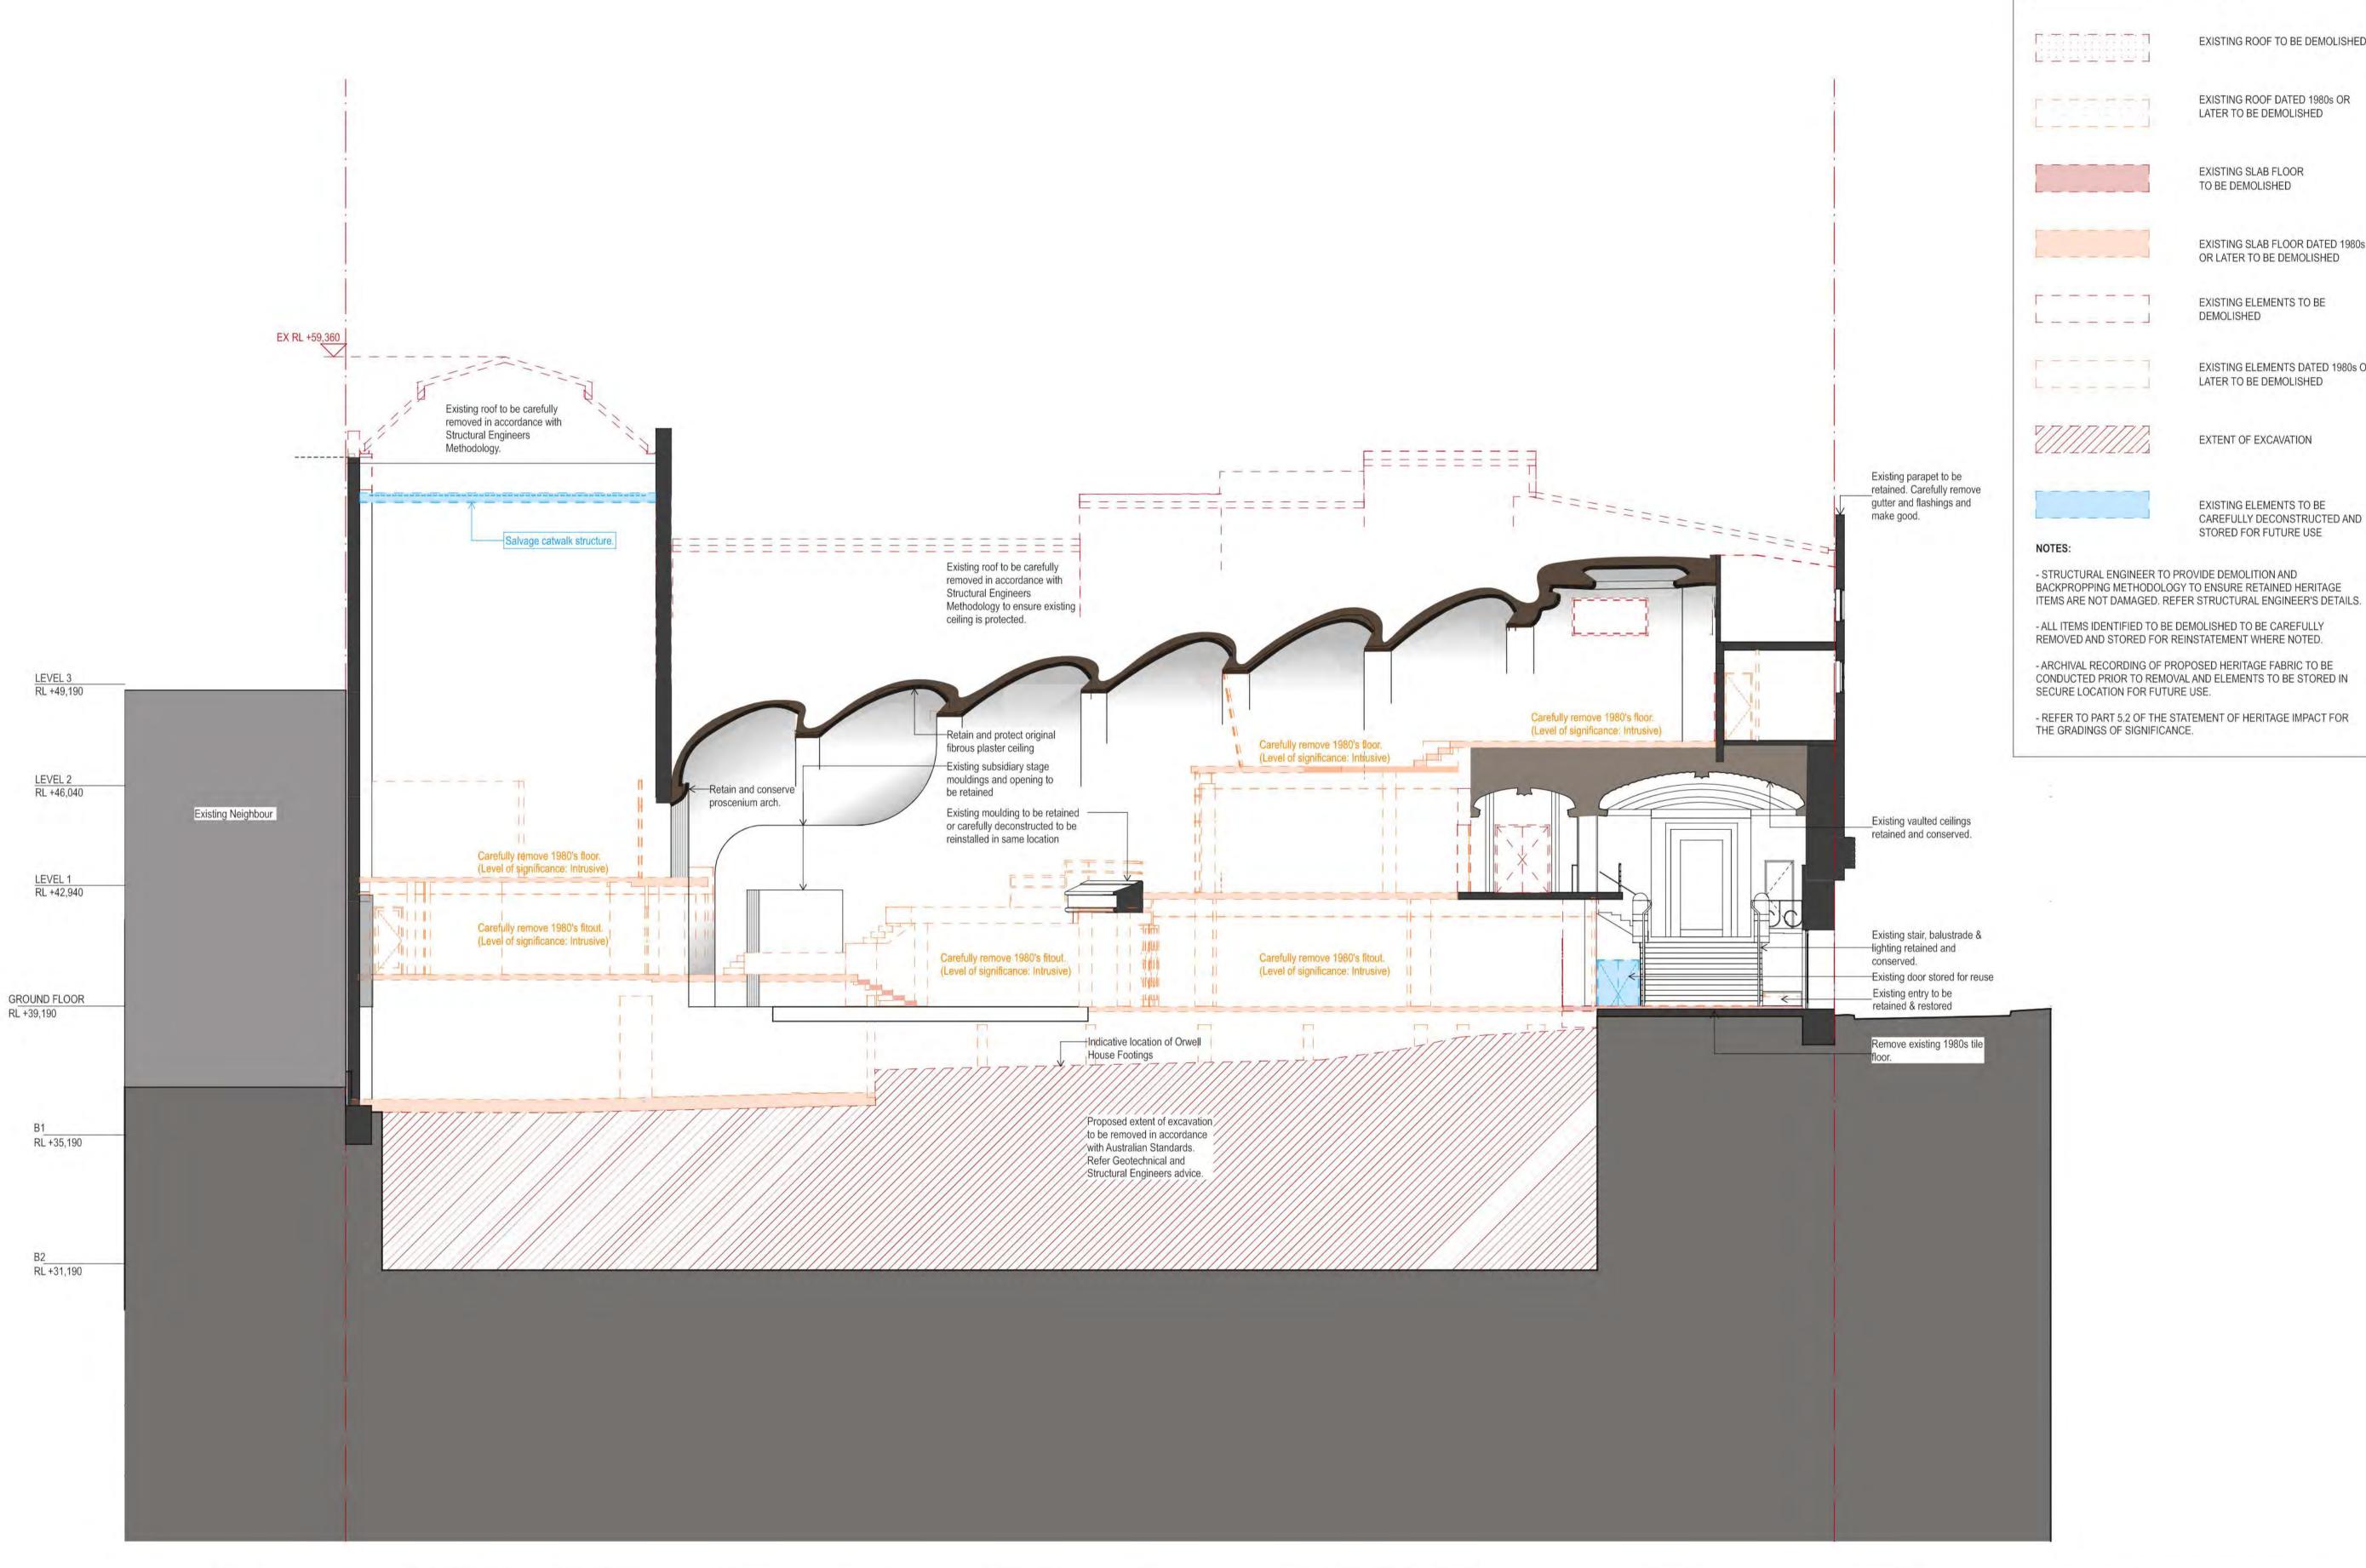

BCA CONSULTANT

Concise Certification

Phone: 0423 424 161

Tonkin Zulaikha Greer

Phone: 9215 4900

Email: julie@tzg.com.au

TOWN PLANNER

Phone: 0447 755 799

Email: giovanni@planninglab.com

HERITAGE

Planning Lab

Phone: 0430 394 645

Certified Energy

Phone: 02 9159 3932

Phone: 0418 601 094

Email: jason.rudd@ttpp.net.au

Email: peter@mogamma.com.au

Email: jobs@certifiedenergy.com.au

The Transport Planning Partnership

TRANSPORT ENGINEER

COMMUNITY CONSULTANT

Email: andy@polymerstudios.com.au

LANDSCAPE ARCHITECT

Phone: 02 8571 2900 Email: liamm@arcadiala.com.au

VIEW LOSS ASSESSMENT

Central Element

Phone: (02) 9957 5019

WASTE CONSULTANT

Elephant's Foot

Phone: 02 9780 3573

Email: dlavigne@centralelement.com.au

Email: whitney.brunson@elephantsfoot.com.au

Polymer Studios

Phone: 1300 259 732

Phone: 0435 338 245

Email: dan@urbaine.com.au

ACCESS CONSULTANT

DRONE PHOTOGRAPHER

Email: sgreen@polygenic.com.au

ABE Consulting

dimensions only. Report any discrepencies Email: michael@abeconsulting.com.au Email: benw@pwna.com.au

Phone: 0415 522 533

Phone: 02 9630 7452

NOTES:

Do not scale off drawings. Use figured

to the architect. These designs, plans,

the property of Tonkin Zulaikha Greer

reproduced or copied wholly or in part

Architects Pty Ltd, and must not be

Greer Architects Pty Ltd.

specifications and the copyright therein are Sky Monkey

without written permission of Tonkin Zulaikha
Polygenic
Phone: 0404 616 473

ACOUSTIC ENGINEER

Pulse White Noise Acoustics

Phone: 0408 728 303

**ESD CONSULTANT** 

Phone: 0404 025 747

**Evolved Engineering** 

Phone: 0409 398 832

MODELMAKER (DIGITAL/PHYSICAL) SERVICES ENGINEERS

ARCHAEOLOGY

Phone: 9568 6093

FIRE ENGINEERING

Innova Fire Engineering

Email: jason@innovaservices.com.au

STRUCTURAL/CIVIL ENGINEER

Phone: 1300 88 22 62

Phone: 0455 513 077

Email: henry@evolvedengineering.com.au Email: george.agamalis@bgeng.com Email: nik@geosurv.com.au

Phone: 02 9418 1444

Phone: 02 9516 0722

Phone: 0412 335 173

SURVEYOR

GEOTECHNICAL ENGINEER

Email: richard.sanchez@eiaustralia.com.au

ARCHITECT		DRAWING TITLE		DRAWN BY
TONKIN ZULAIKHA GR	EER ARCHITECTS	LONG SECTION D	DEMOLITION	TS, 1
117 Reservoir Street ABN: 46002722349 P: (02) 9215 4900	g		DEMOCITION	CHECKED
F: (02) 9215 4901 EMAIL info@tzg.com.au	ARCHITECTS	SCALES	1:100 @ A1	DATE 1/3/202
WEB www.tzg.com.au	kha	PHASE DEVELOPMENT APPLICATION	DRAWING NO A-080	REV

THE MINERVA

PROJECT NO: 20024

**DEMOLITION LEGEND** 

**EXISTING TO BE** RETAINED

EXISTING ROOF TO BE DEMOLISHED

EXISTING ROOF DATED 1980s OR LATER TO BE DEMOLISHED

EXISTING SLAB FLOOR DATED 1980s OR LATER TO BE DEMOLISHED

EXISTING ELEMENTS DATED 1980s OR

EXISTING ELEMENTS TO BE

LATER TO BE DEMOLISHED

EXTENT OF EXCAVATION


EXISTING ELEMENTS TO BE


STORED FOR FUTURE USE

CAREFULLY DECONSTRUCTED AND

DEMOLISHED

EXISTING SLAB FLOOR TO BE DEMOLISHED

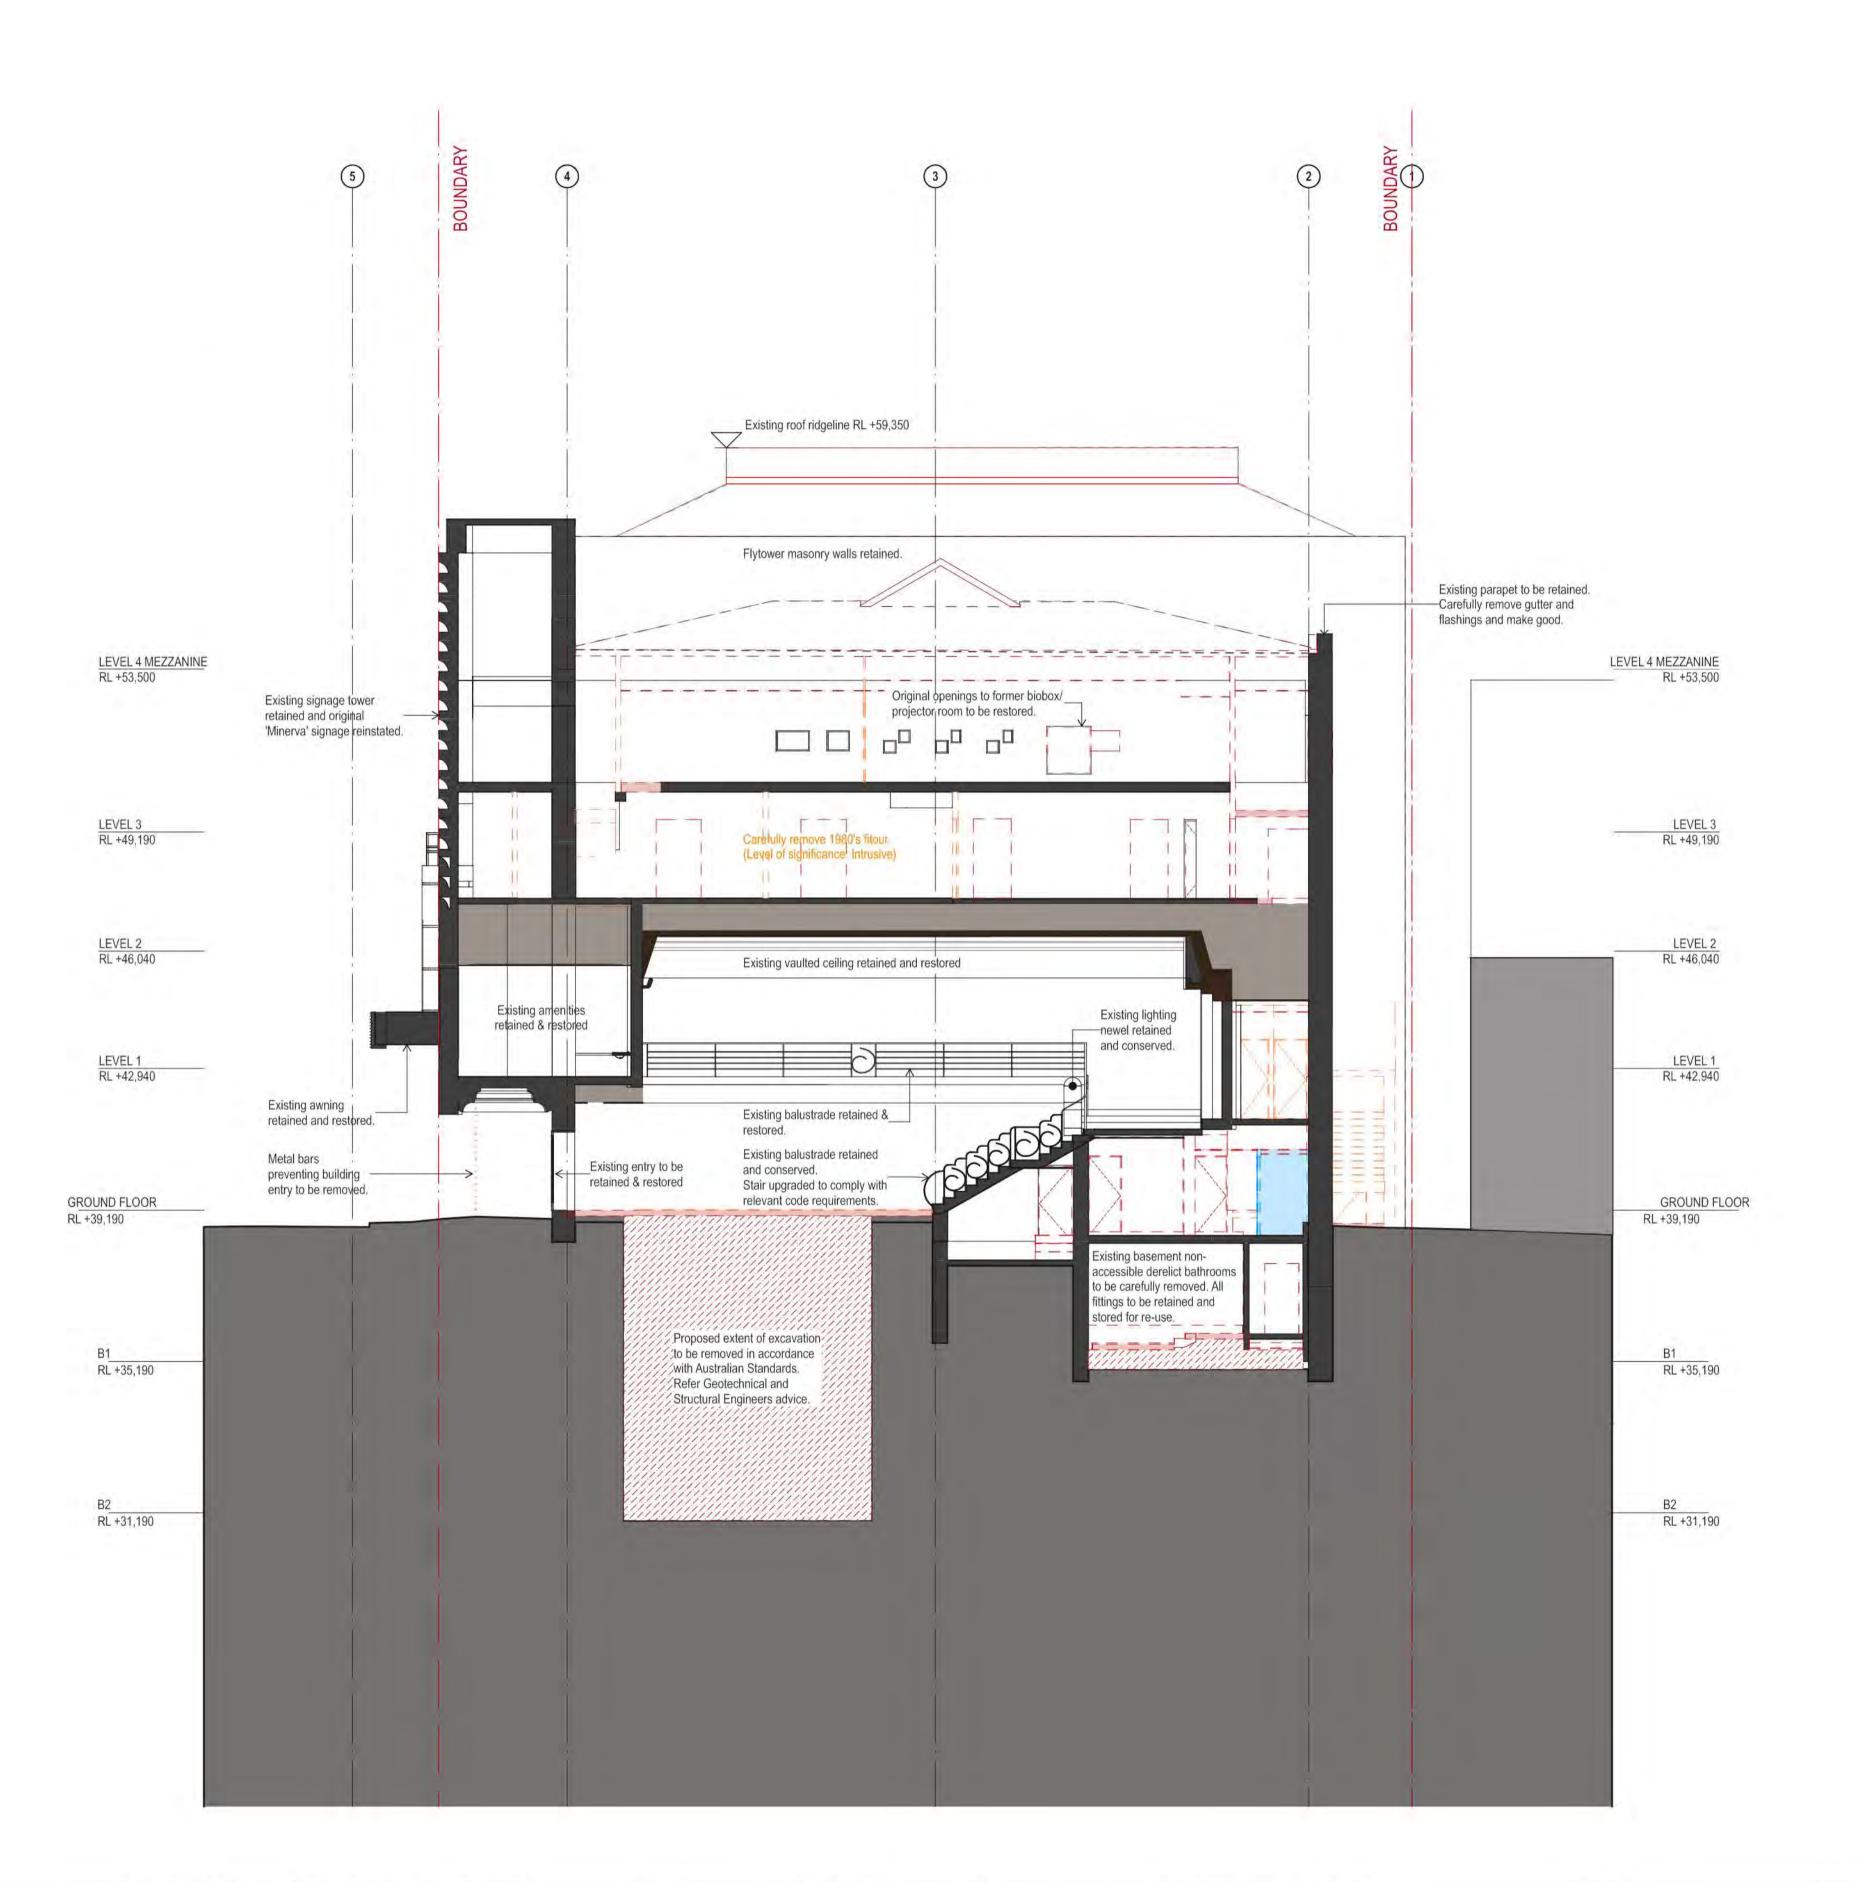

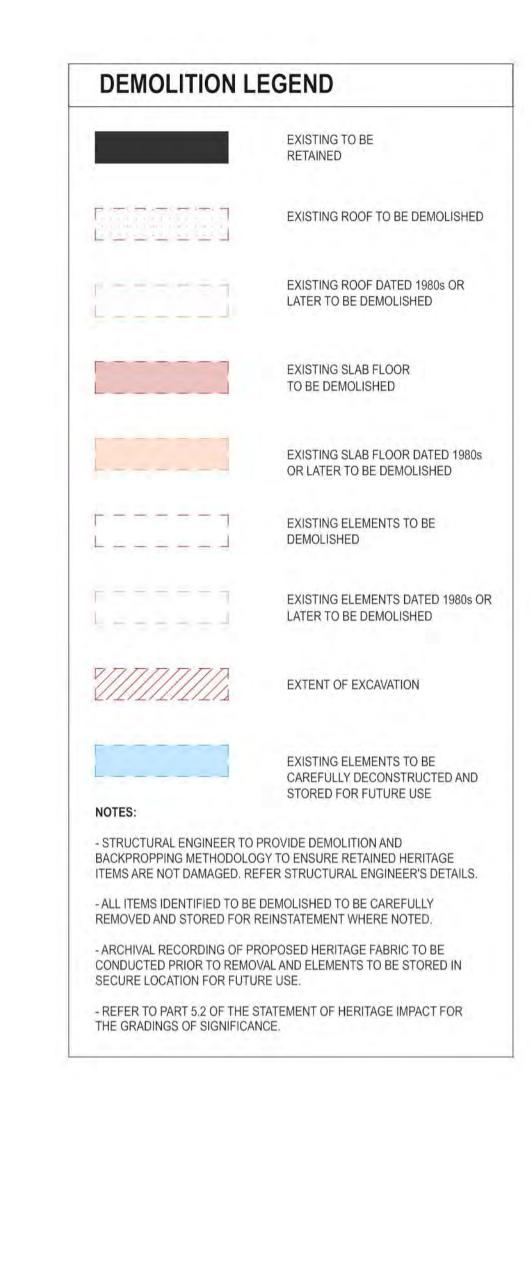

off drawings. Use figu
only. Report any discre
ect. These designs, pla
s and the copyright the of Tonkin Zulaikha Gree
ty Ltd, and must not be or copied wholly or in pa en permission of Tonkin ects Pty Ltd.
ty or er

ABE Consult Phone: 0415 Email: michae
DRONE PH Sky Monkey Phone: 02 96 Email: Kelvin.
MODELMAN Polygenic Phone: 0404

	ACCESS CONSULTANT	ACOUSTIC ENGINEER	ARCHAEOLOGY	ASP
	ABE Consulting	Pulse White Noise Acoustics	AMAC	Webb
S	Phone: 0415 522 533 Email: michael@abeconsulting.com.au	Phone: 0408 728 303 Email: benw@pwna.com.au	Phone: 9568 6093 Email: jakibaloh@archaeological.com.au	Phone: 02 9418 1444 Email: mrourke@webbaustralia.com.au
	DRONE PHOTOGRAPHER	ESD CONSULTANT	FIRE ENGINEERING	GEOTECHNICAL ENGINEER
9	Sky Monkey	Climatewise	Innova Fire Engineering	Ei Australia
	Phone: 02 9630 7452	Phone: 0404 025 747	Phone: 1300 88 22 62	Phone: 02 9516 0722
	Email: Kelvin.Ong@skymonkey.com.au	Email: digby@climatewisedesign.com.au	Email: jason@innovaservices.com.au	Email: richard.sanchez@eiaustralia.com.au
	MODELMAKER (DIGITAL/PHYSICAL)	SERVICES ENGINEERS	STRUCTURAL/CIVIL ENGINEER	SURVEYOR
na	Polygenic	Evolved Engineering	BG&E	Geosurv
	Phone: 0404 616 473	Phone: 0409 398 832	Phone: 0455 513 077	Phone: 0412 335 173
	Email: sgreen@polygenic.com.au	Email: henry@evolvedengineering.com.au	Email: george.agamalis@bgeng.com	Email: nik@geosurv.com.au

BCA CONSULTANT	CGI	
Concise Certification Phone: 0423 424 161 Email: steven@concisecert.com.au	Mogamma Phone: 0430 394 645 Email: peter@mogamma.com.au	
HERITAGE	JV3	
Tonkin Zulaikha Green	Certified Energy	
Phone: 9215 4900	Phone: 02 9159 3932	
Email: julie@tzg.com.au	Email: jobs@certifiedenergy.com.au	
TOWN PLANNER	TRANSPORT ENGINEER	
Planning Lab	The Transport Planning Partnership	

Phone: 0418 601 094

Phone: 0447 755 799

COMMUNITY CONSULTANT Polymer Studios Phone: 1300 259 732 Email: andy@polymerstudios.com.au	CLIENT: Central Element Phone: (02) 9957 5019
LANDSCAPE ARCHITECT Arcadia Phone: 02 8571 2900 Email: liamm@arcadiala.com.au	Email: dlavigne@centralelement.com.au
VIEW LOSS ASSESSMENT Urbaine	WASTE CONSULTANT Elephant's Foot

Phone: 02 9780 3573

Email: whitney.brunson@elephantsfoot.com.au


**Urbaine** Phone: 0435 338 245

JECT:	ARCHITECT
E MINERVA	TONKIN ZULAIKHA
	117 Reservoir Street
	ABN: 46002722349
	P: (02) 9215 4900
	F: (02) 9215 4901
1:100	EMAIL info@tzg.com WEB www.tzg.com.a
7 0 1 1 2 2 2 4	5-

PROJECT NO: 20024

RCHITECT		DRAWING TITLE	
ONKIN ZULAIKHA GREER 17 Reservoir Street BN: 46002722349	ARCHITECTS	CROSS SEC	CTION A D
2: (02) 9215 4900 1: (02) 9215 4901	EN P	SCALES	
:MAIL info@tzg.com.au VEB www.tzg.com.au	ARCHITECTS	DHASE	DRAL

CTS	CROSS SECTION A DEMOLITION		DRAWN BY
tonkin Zulai			CHECKED TS
	scales 1:100 @ A1		DATE 1/3/2023
kha	PHASE DEVELOPMENT APPLICATION	DRAWING NO A-081	REV D

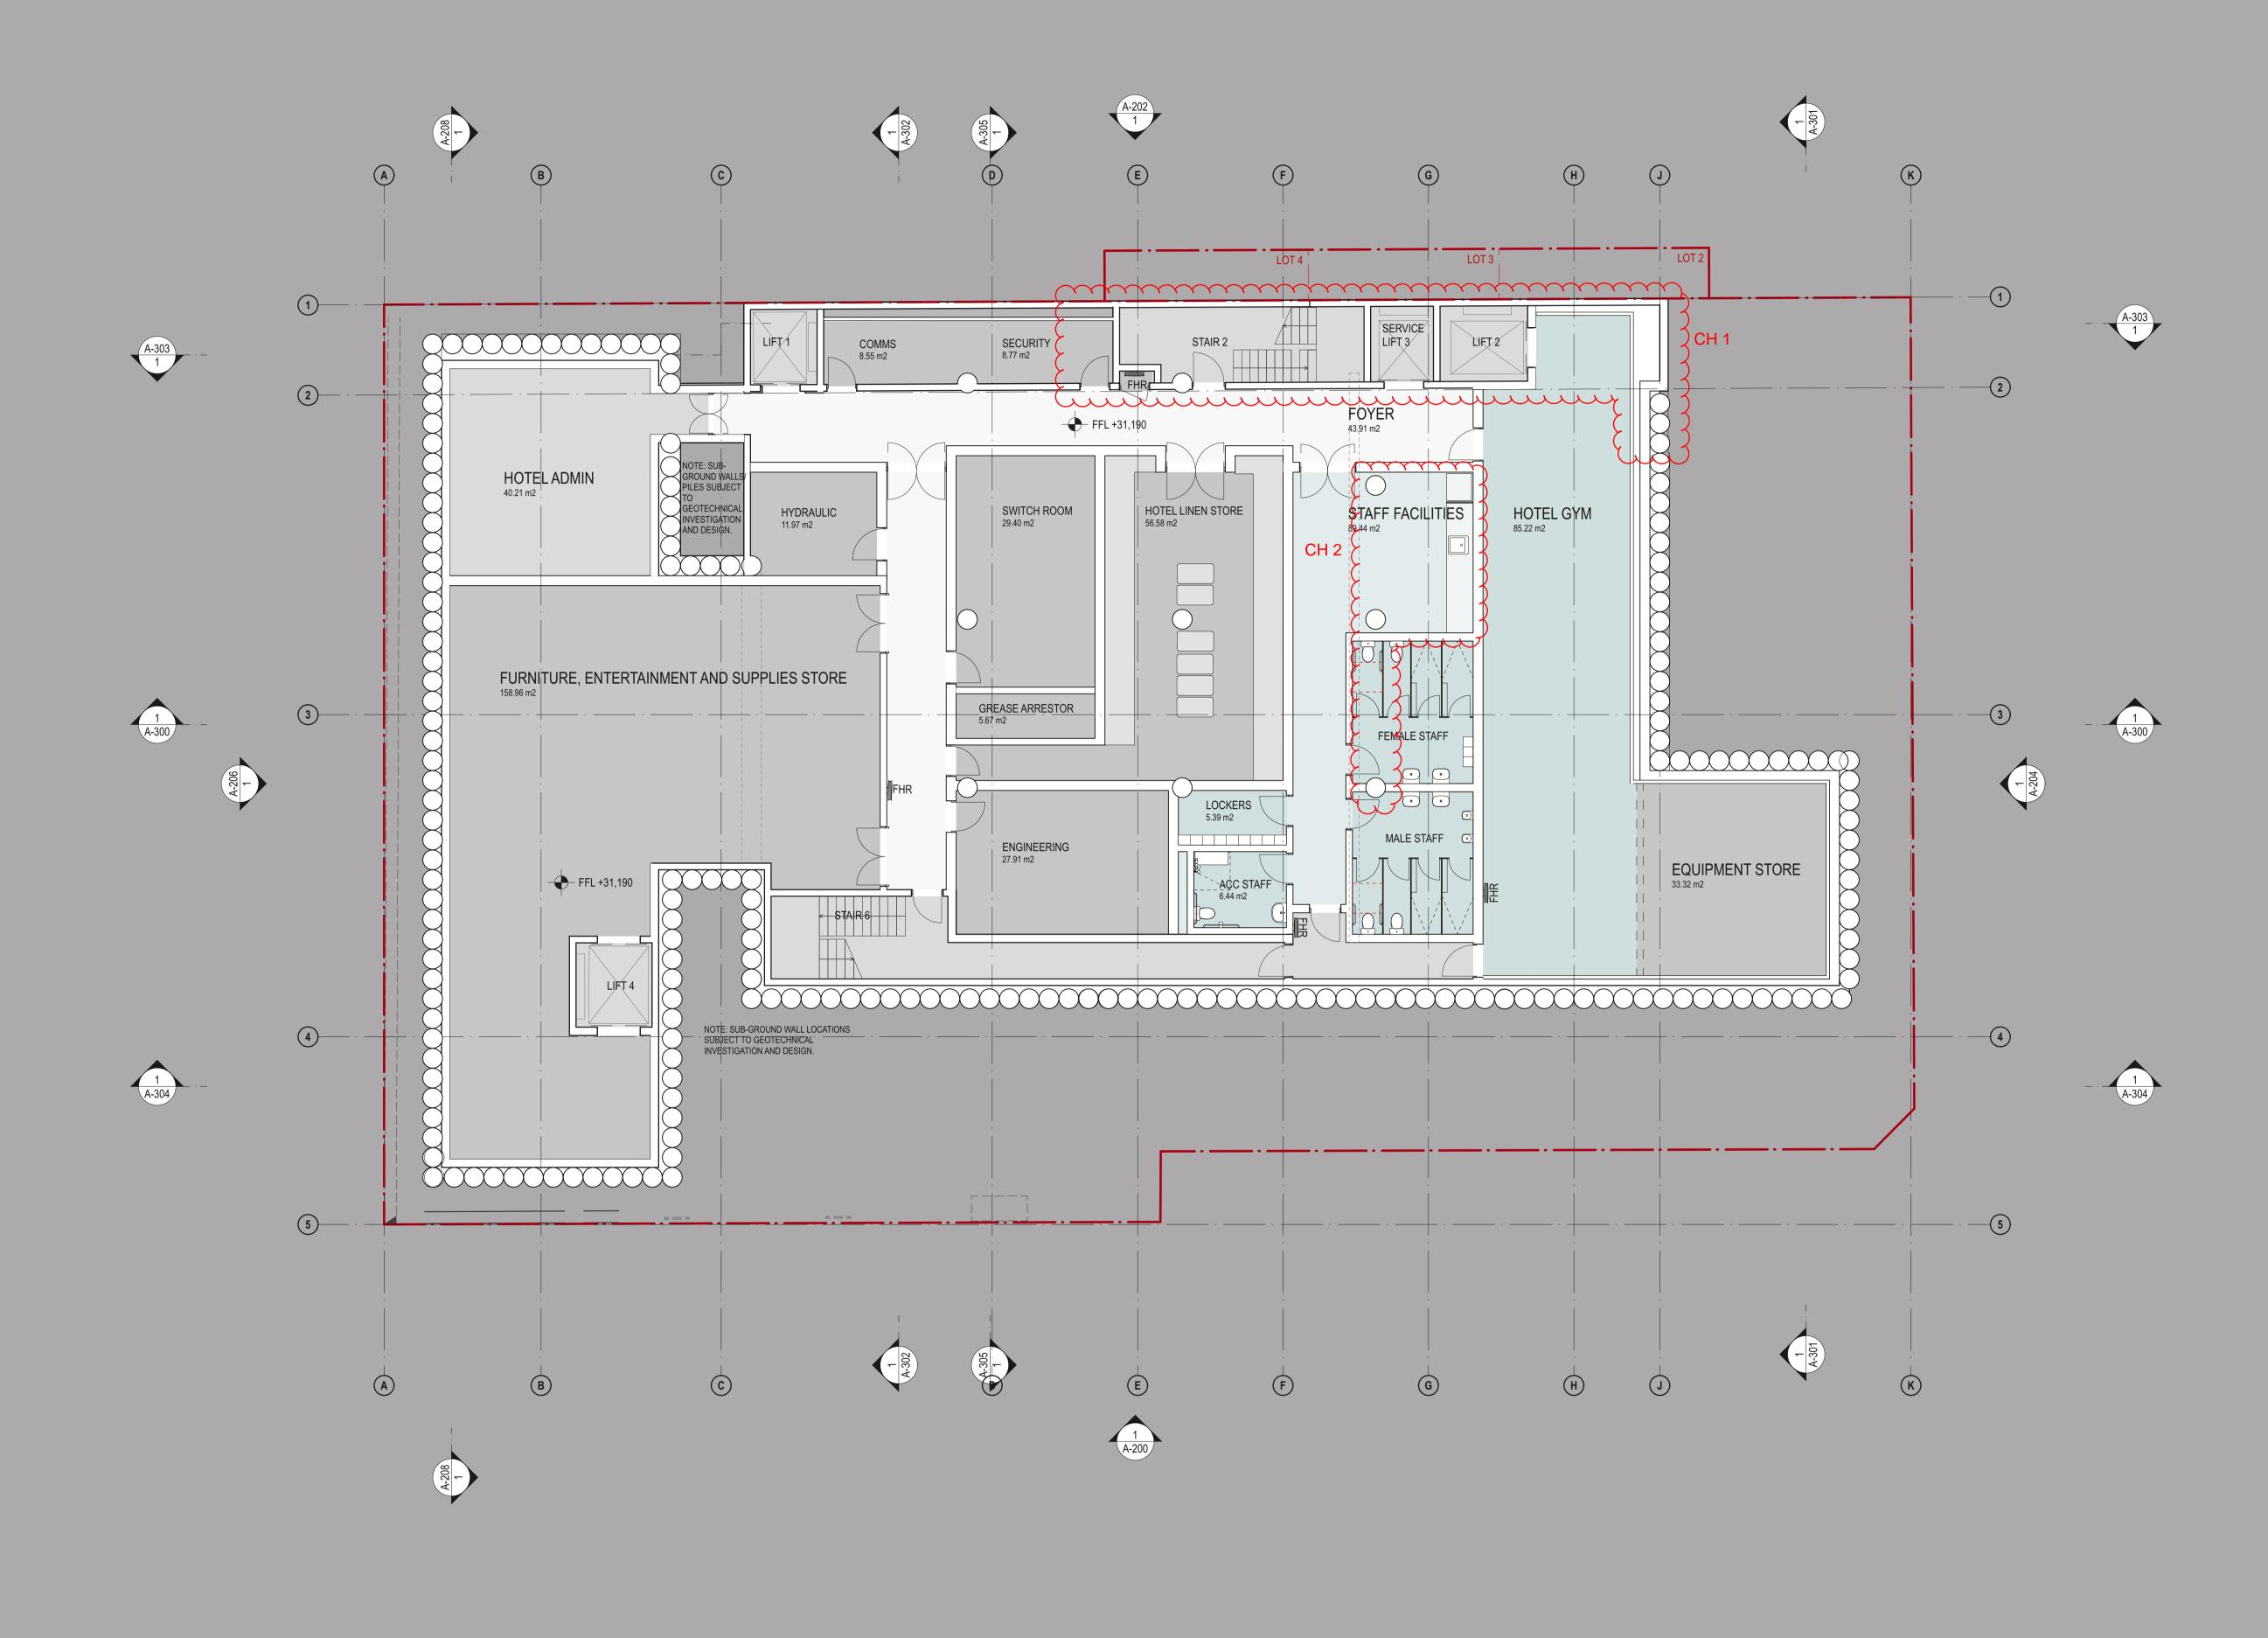

REV DESCRIPTION: 22.JUL.2021 DEVELOPMENT APPLICATION DEVELOPMENT APPLICATION 16.AUG.2021 DEVELOPMENT APPLICATION 03.JUN.2022 18.NOV.2022 DEVELOPMENT APPLICATION

16 AUG 2023

DEVELOPMENT APPLICATION

DEVELOPMENT APPLICATION

DEVELOPMENT APPLICATION

Do not scale off drawings. Use figured to the architect. These designs, plans, specifications and the copyright therein are Sky Monkey the property of Tonkin Zulaikha Greer Architects Pty Ltd, and must not be reproduced or copied wholly or in part without written permission of Tonkin Zulaikha Phone: 0404 616 473 Greer Architects Pty Ltd. Email: sgreen@polygenic.com.au

ACCESS CONSULTANT ACOUSTIC ENGINEER Pulse White Noise Acoustics ABE Consulting Phone: 0415 522 533 Phone: 0408 728 303 dimensions only. Report any discrepencies | Email: michael@abeconsulting.com.au | Email: benw@pwna.com.au DRONE PHOTOGRAPHER ESD CONSULTANT Phone: 02 9630 7452 Phone: 0404 025 747 MODELMAKER (DIGITAL/PHYSICAL) SERVICES ENGINEERS

Phone: 9568 6093 Phone: 02 9418 1444 | Email: jakibaloh@archaeological.com.au | Email: mrourke@webbaustralia.com.au | Email: steven@concisecert.com.au FIRE ENGINEERING GEOTECHNICAL ENGINEER Innova Fire Engineering Phone: 1300 88 22 62 Phone: 02 9516 0722 Email: richard.sanchez@eiaustralia.com.au STRUCTURAL/CIVIL ENGINEER SURVEYOR **Evolved Engineering** Phone: 0412 335 173 Phone: 0409 398 832 Phone: 0455 513 077 Email: henry@evolvedengineering.com.au | Email: george.agamalis@bgeng.com | Email: nik@geosurv.com.au

ARCHAEOLOGY

Concise Certification Phone: 0423 424 161 Phone: 0430 394 645 Email: peter@mogamma.com.au HERITAGE Tonkin Zulaikha Greer Certified Energy Phone: 9215 4900 Phone: 02 9159 3932 Email: jobs@certifiedenergy.com.au Email: julie@tzg.com.au TOWN PLANNER TRANSPORT ENGINEER The Transport Planning Partnership Planning Lab Phone: 0447 755 799 Phone: 0418 601 094 Email: giovanni@planninglab.com Email: jason.rudd@ttpp.net.au

BCA CONSULTANT

Polymer Studios Phone: 1300 259 732 Email: andy@polymerstudios.com.au LANDSCAPE ARCHITECT Phone: 02 8571 2900 Email: liamm@arcadiala.com.au VIEW LOSS ASSESSMENT Phone: 0435 338 245 Email: dan@urbaine.com.au

COMMUNITY CONSULTANT **Central Element** Phone: (02) 9957 5019 Email: dlavigne@centralelement.com.au WASTE CONSULTANT Elephant's Foot

Email: whitney.brunson@elephantsfoot.com.au


Phone: 02 9780 3573


THE MINERVA **SCALE 1:100** WEB www.tzg.com.au ----


PROJECT NO: 20024


ARCHITECT TONKIN ZULAIKHA GREER ARCHITECTS 117 Reservoir Street ABN: 46002722349 P: (02) 9215 4900 F: (02) 9215 4901 EMAIL info@tzg.com.au


DRAWN BY DRAWING TITLE BASEMENT 2 FLOOR PLAN CHECKED DRAWING NO A-102 DEVELOPMENT APPLICATION

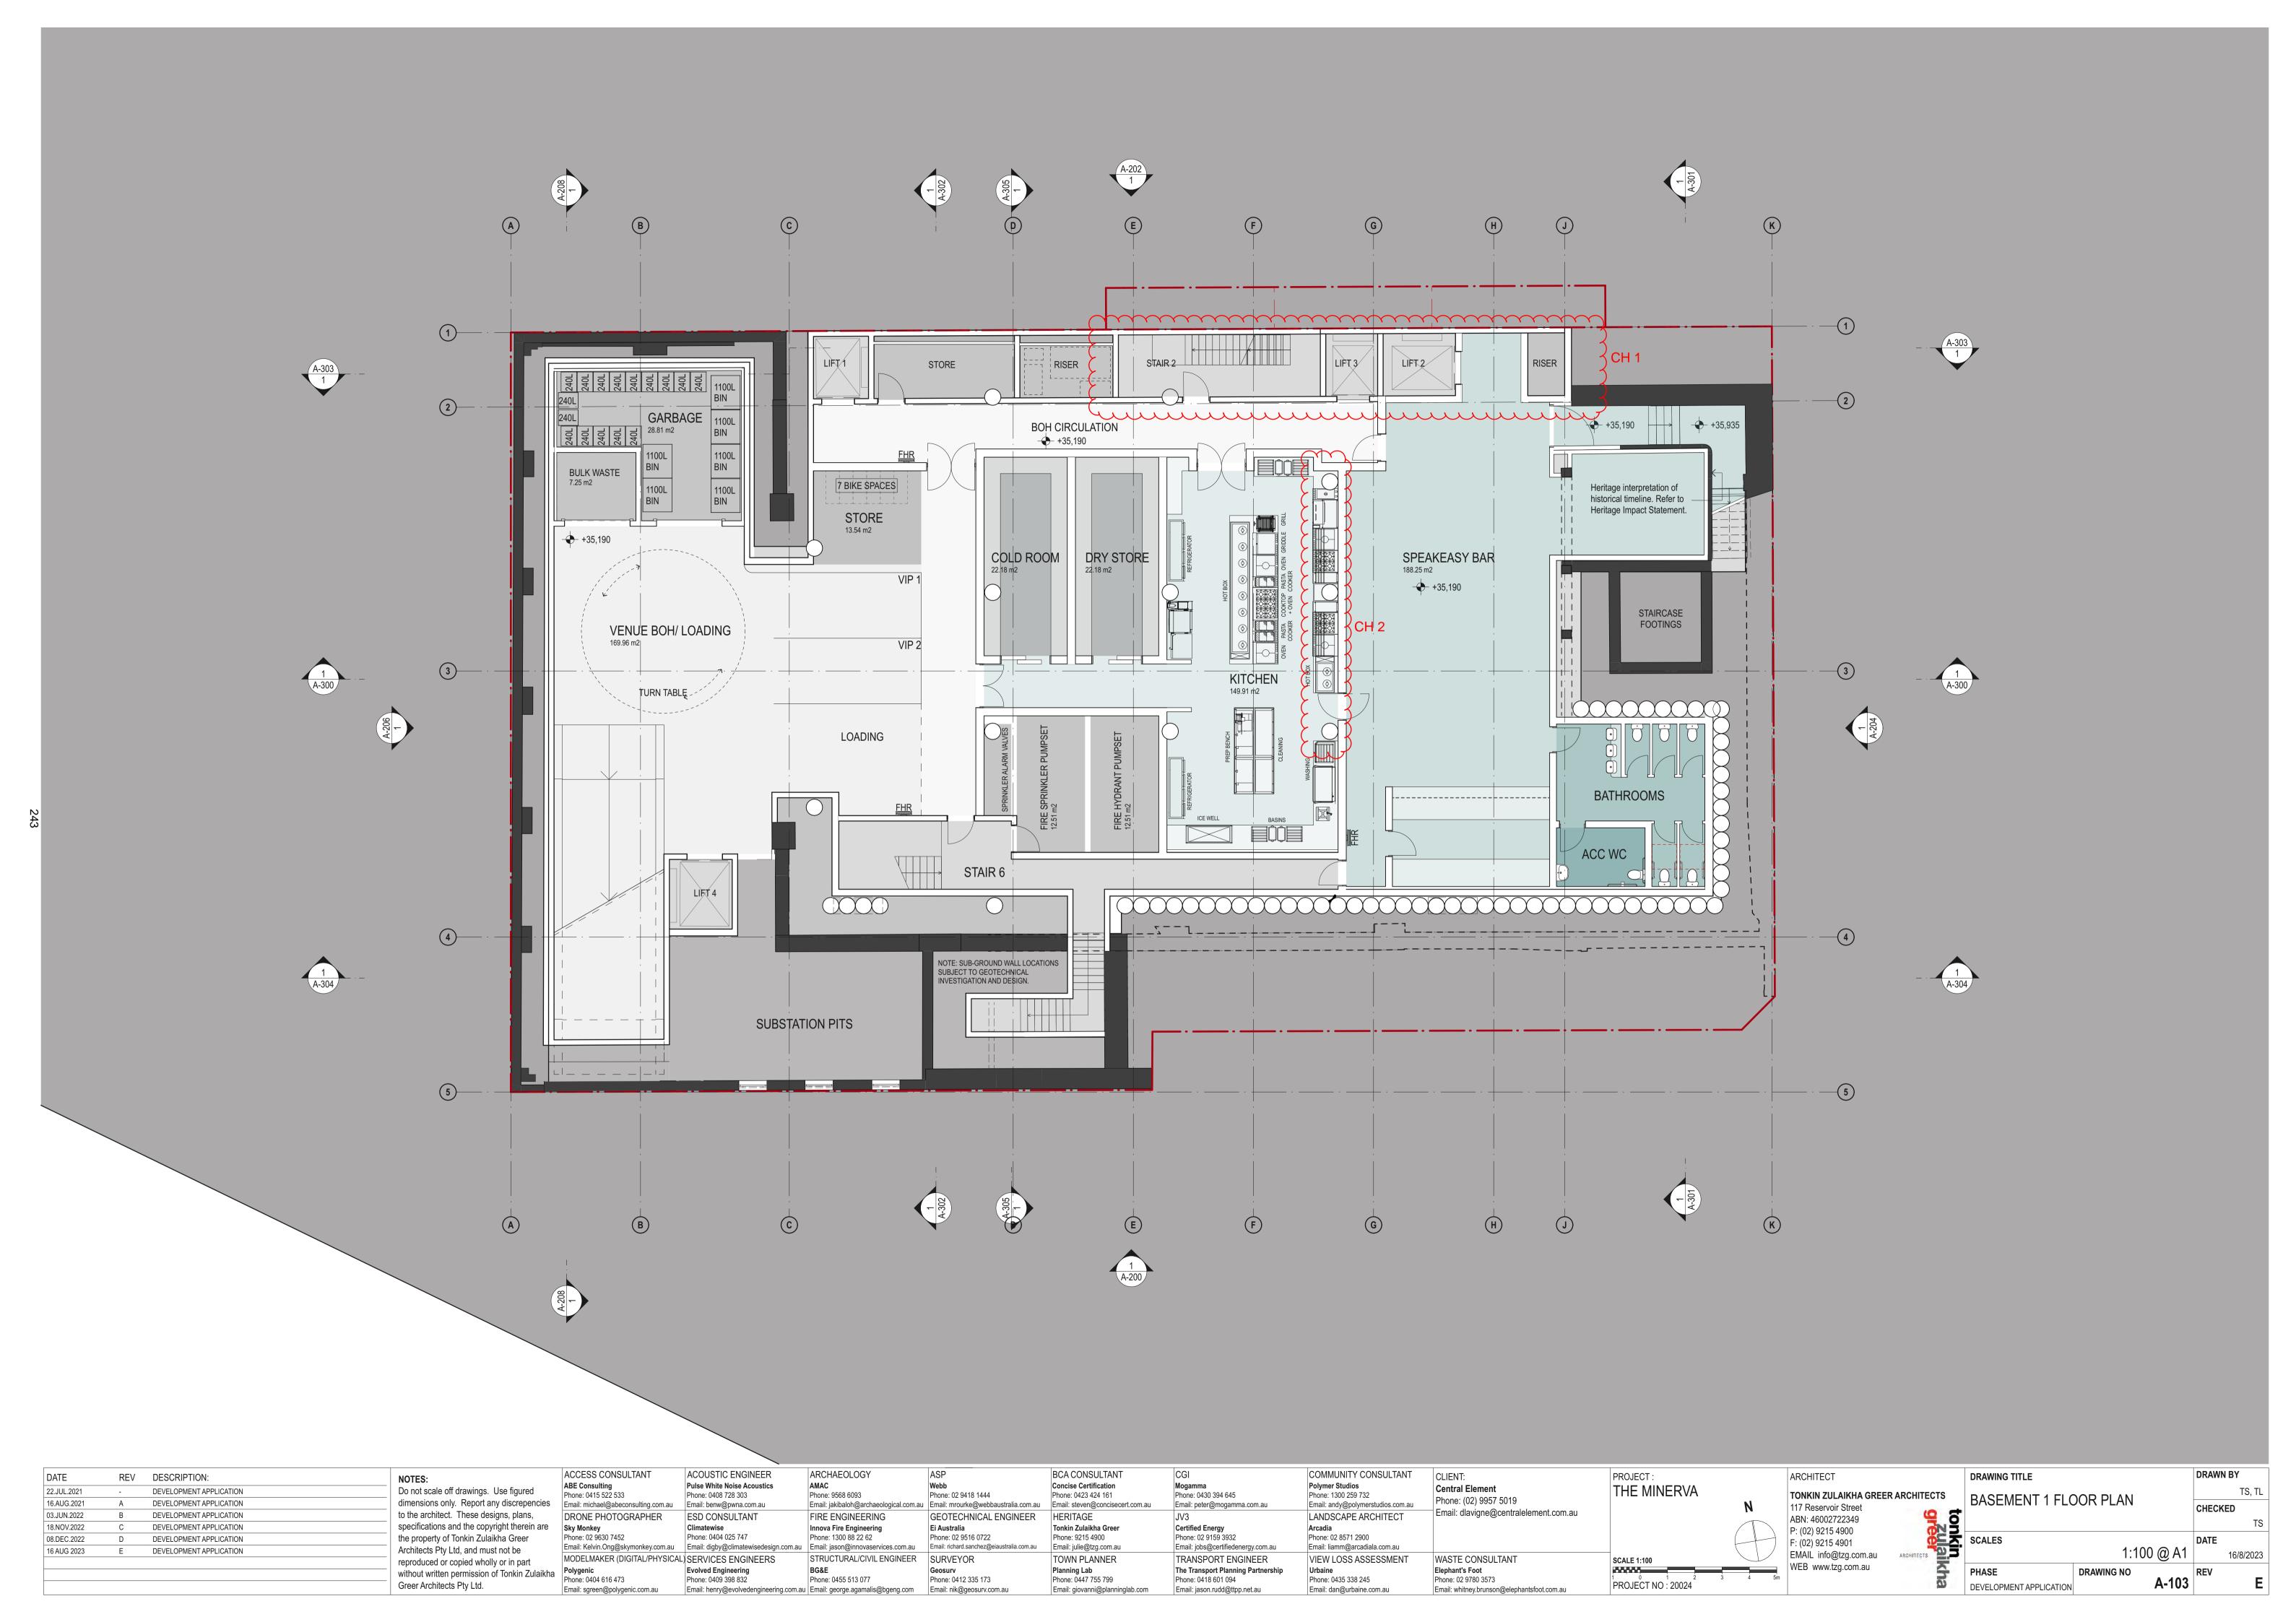


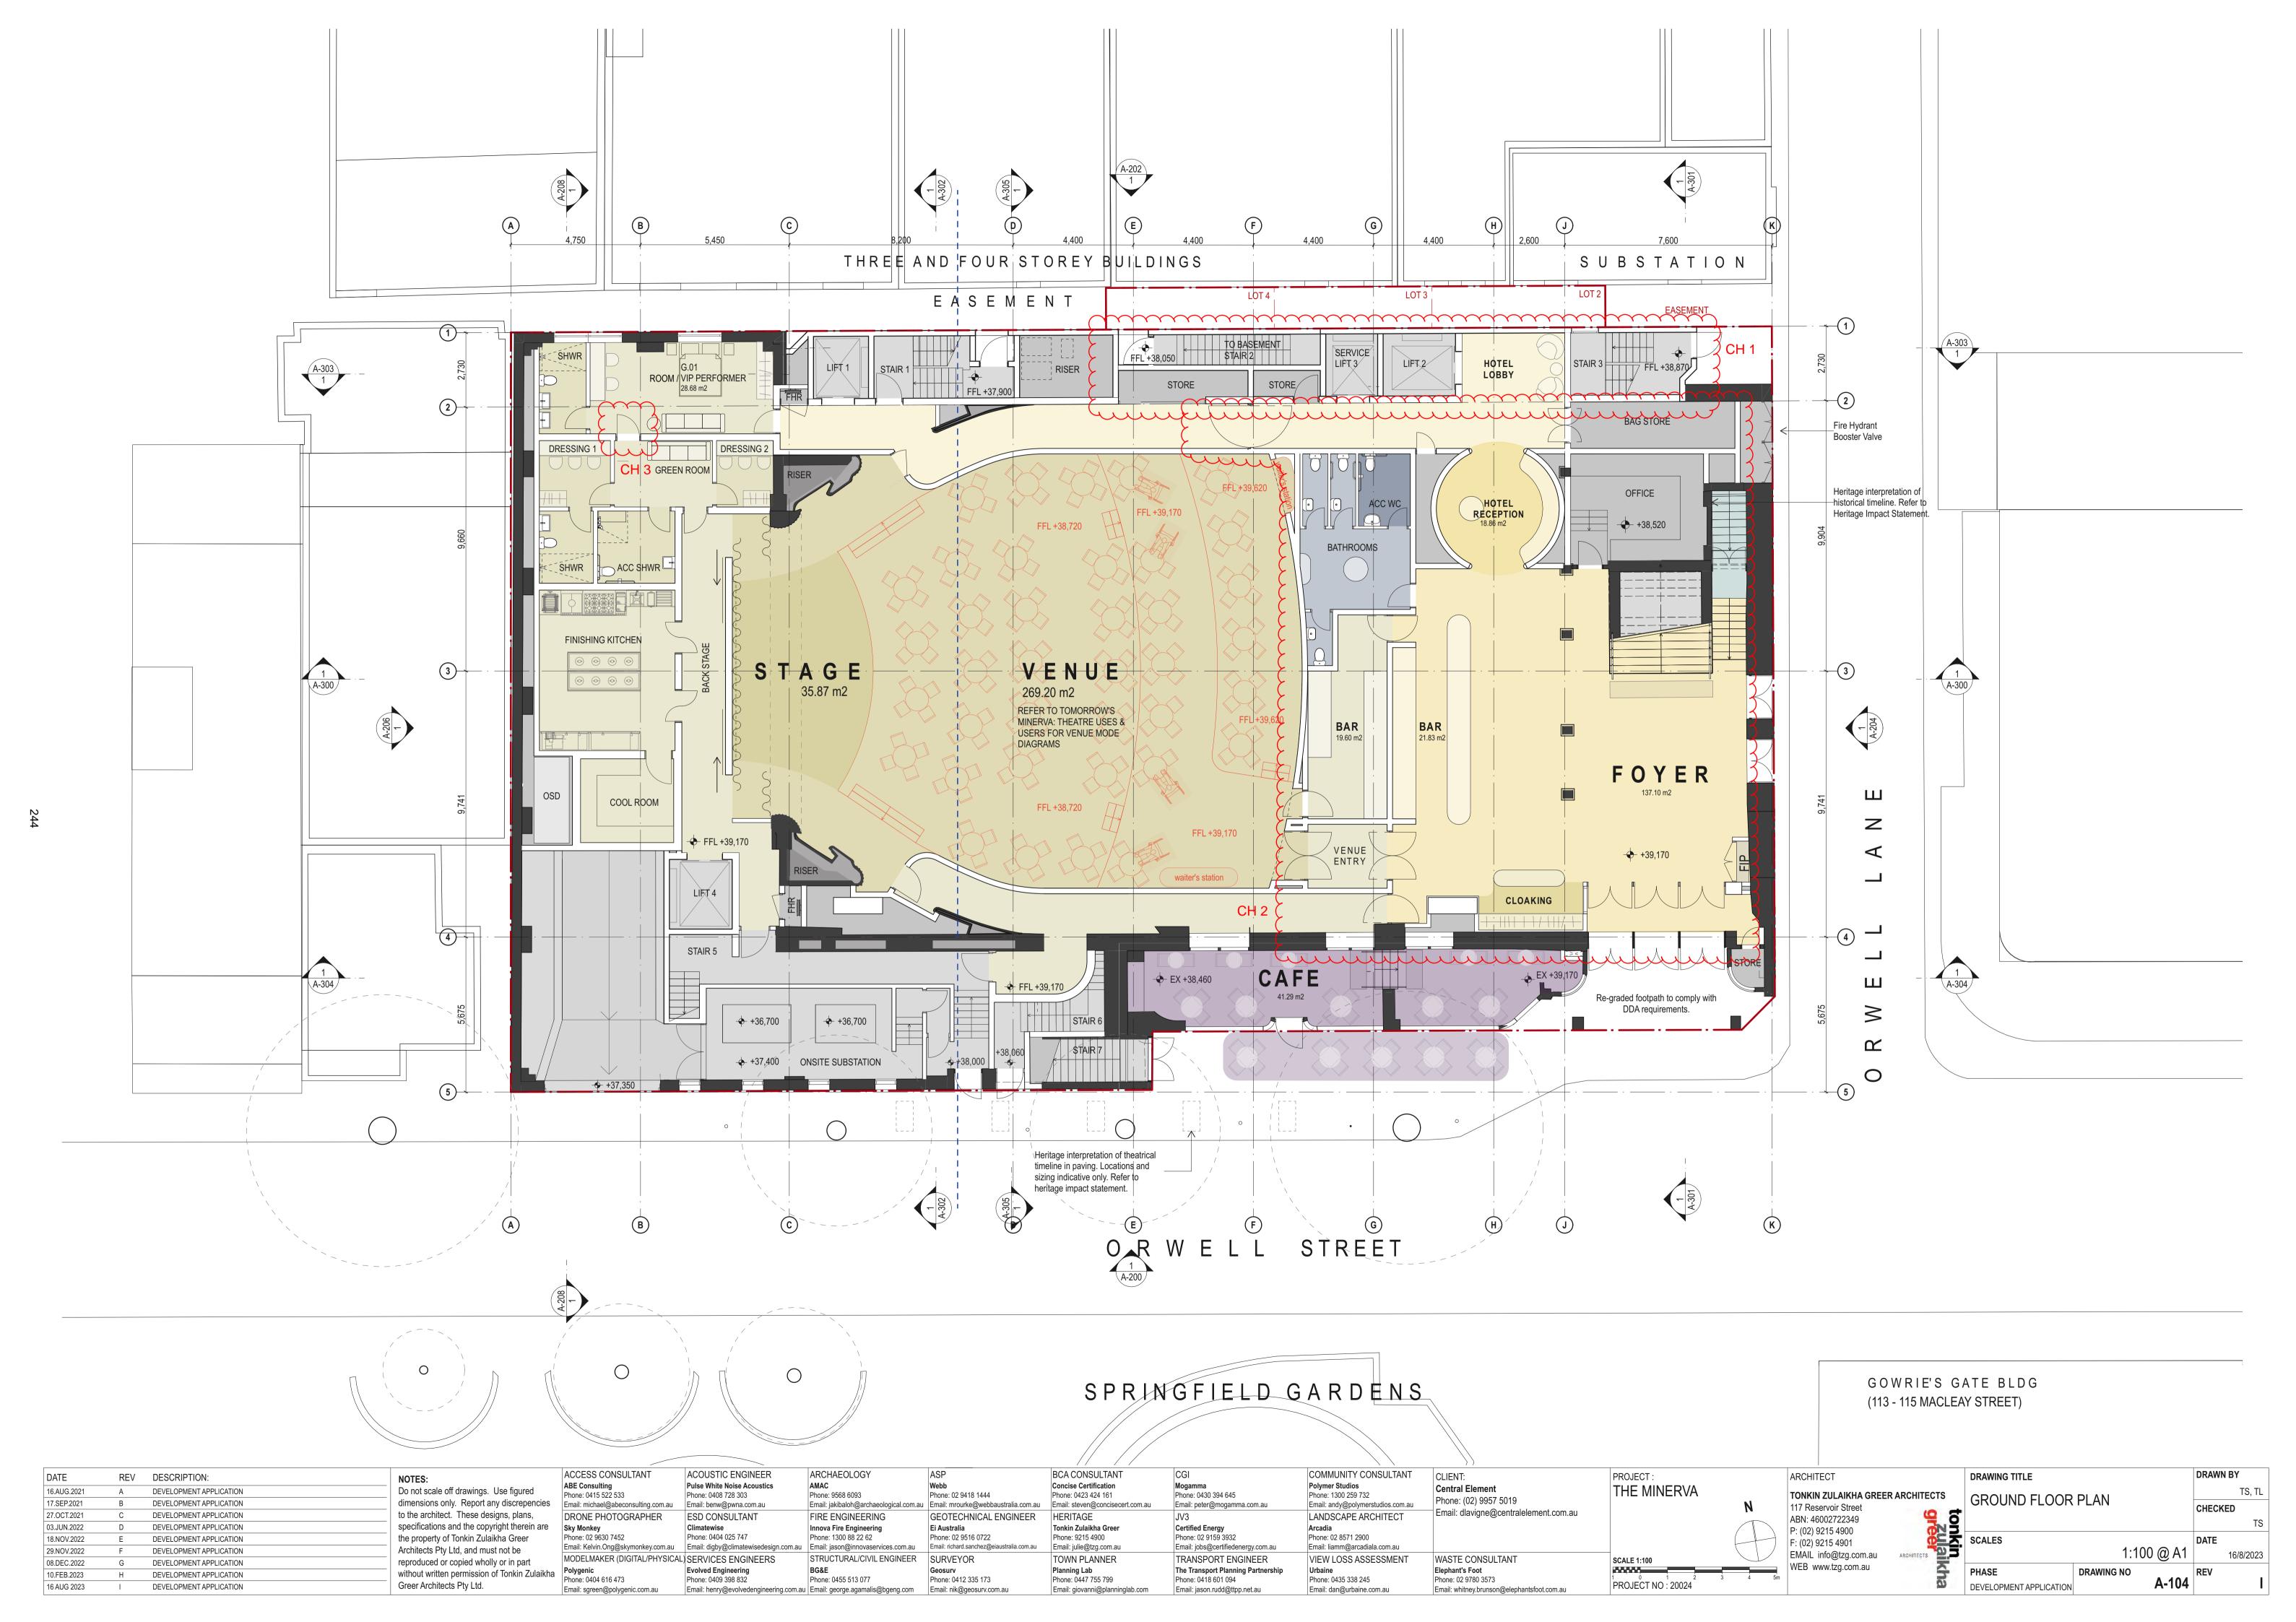

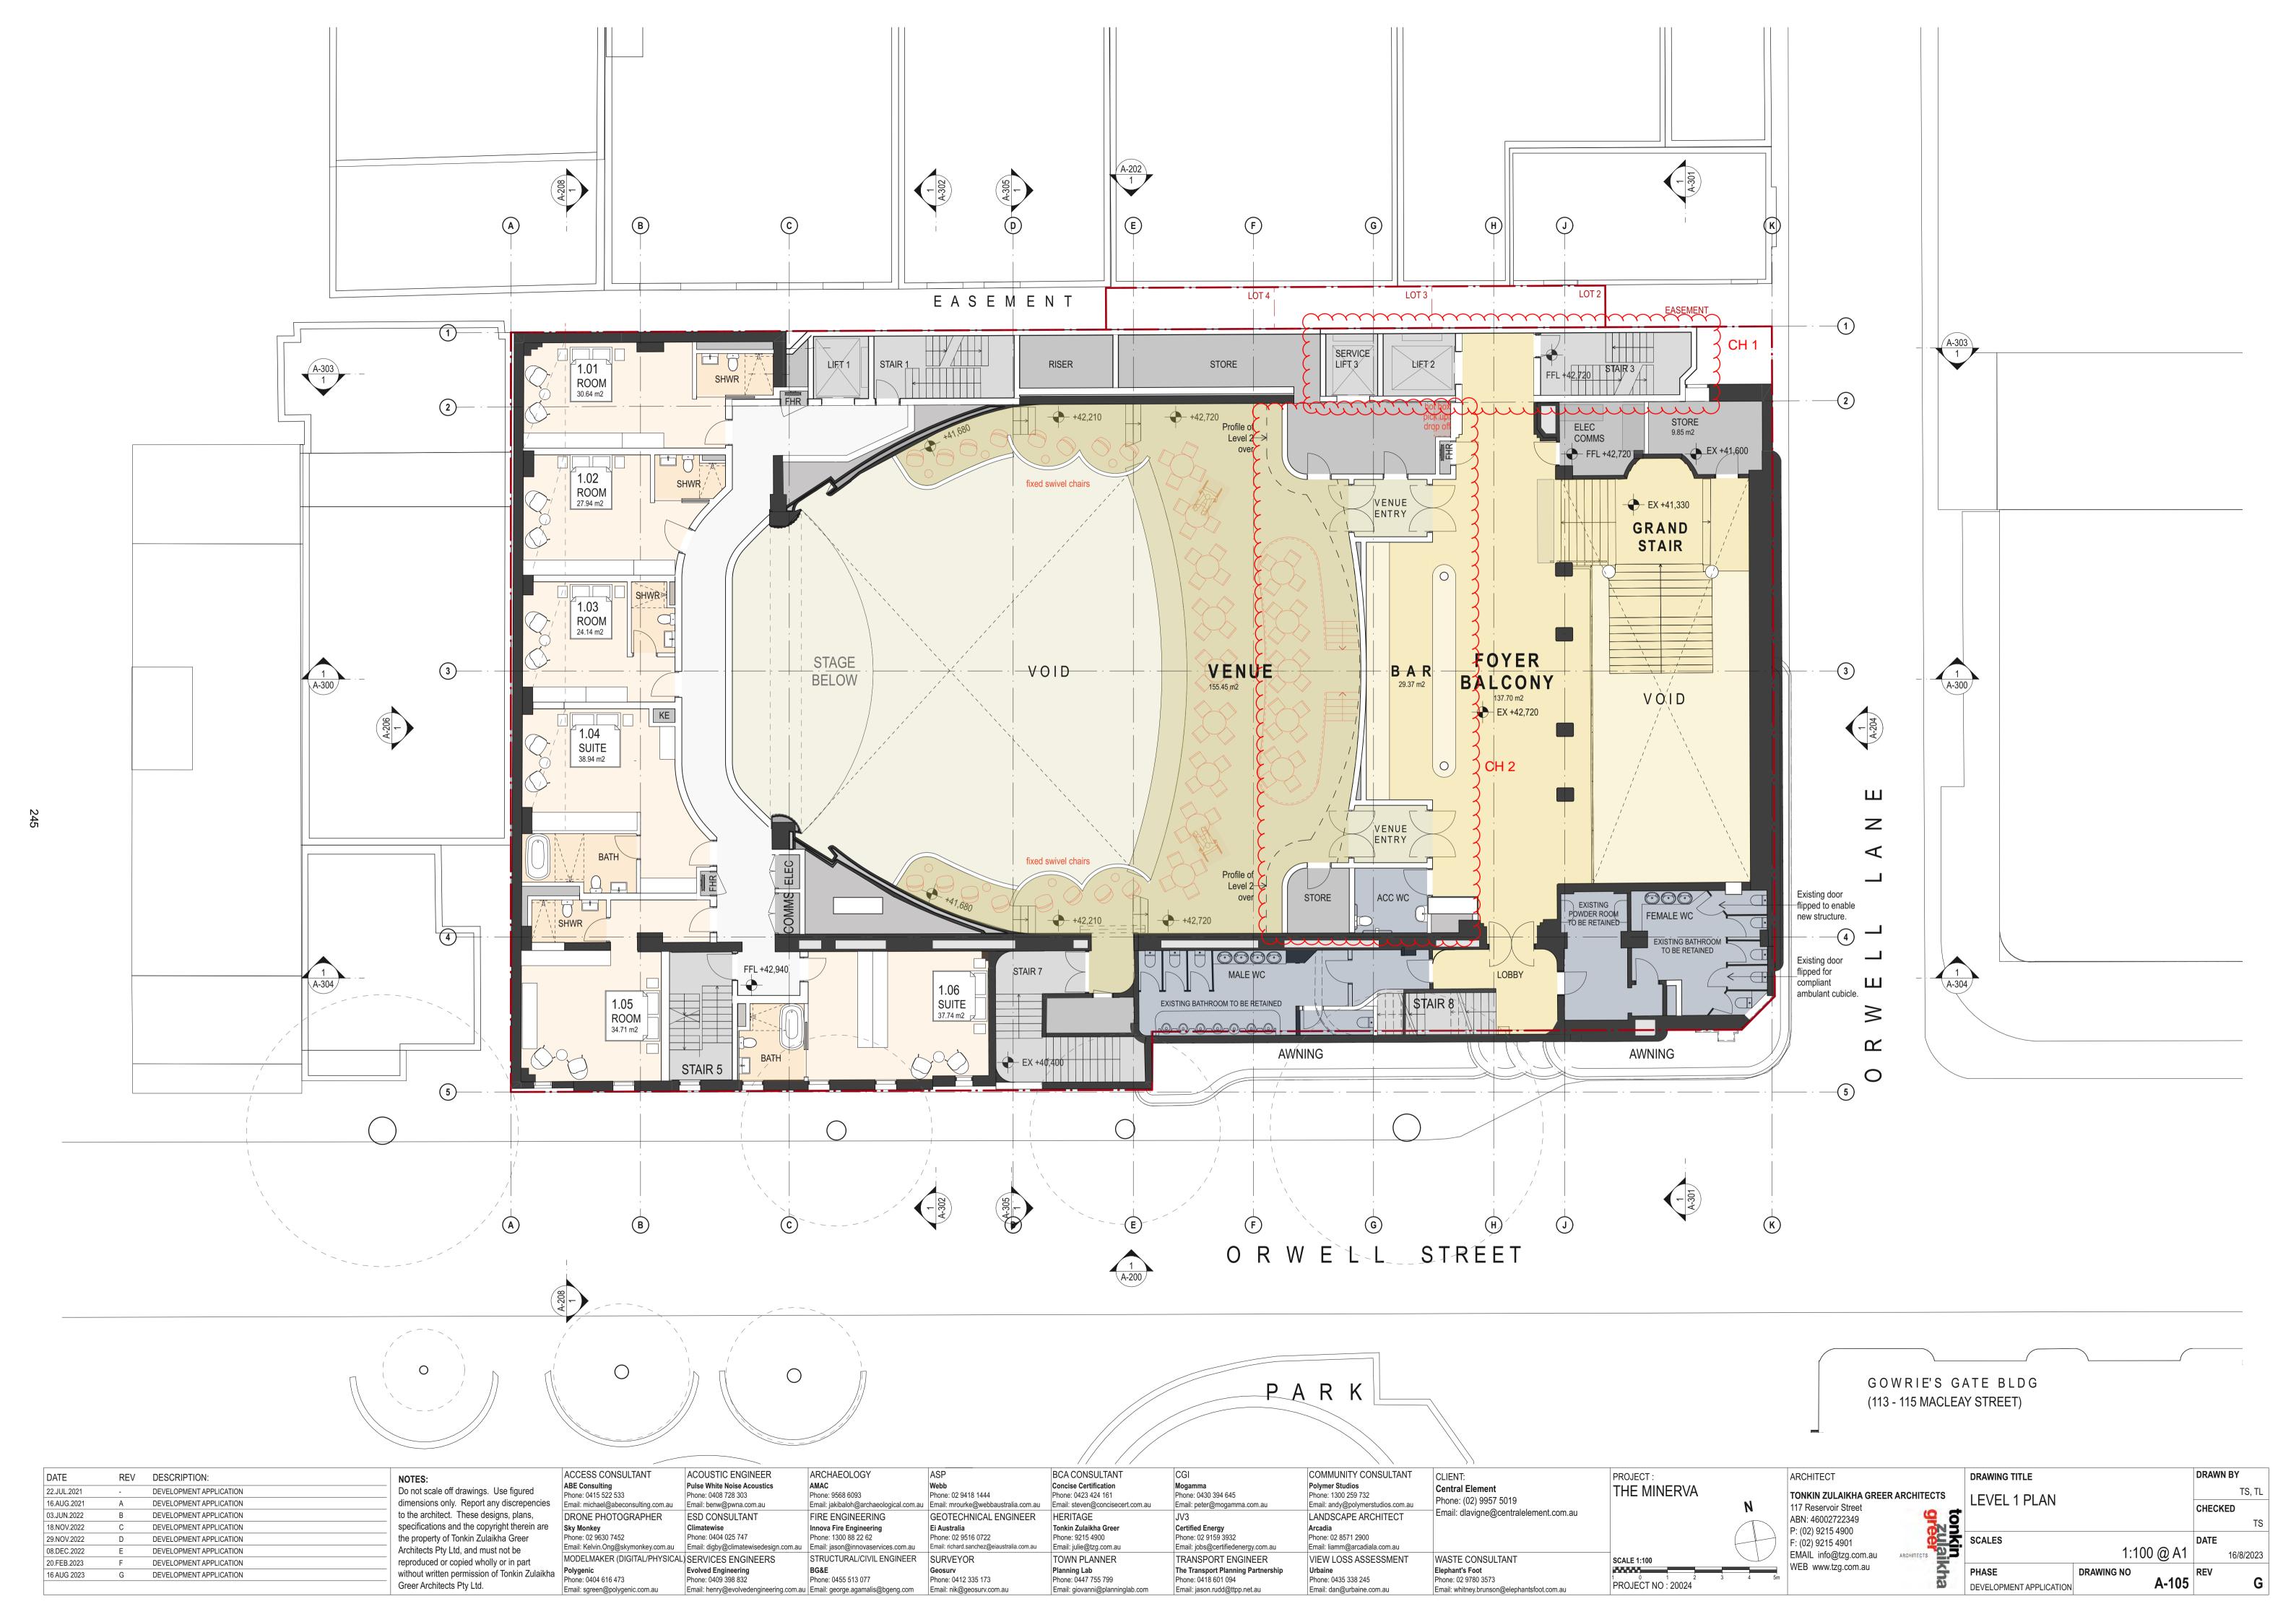

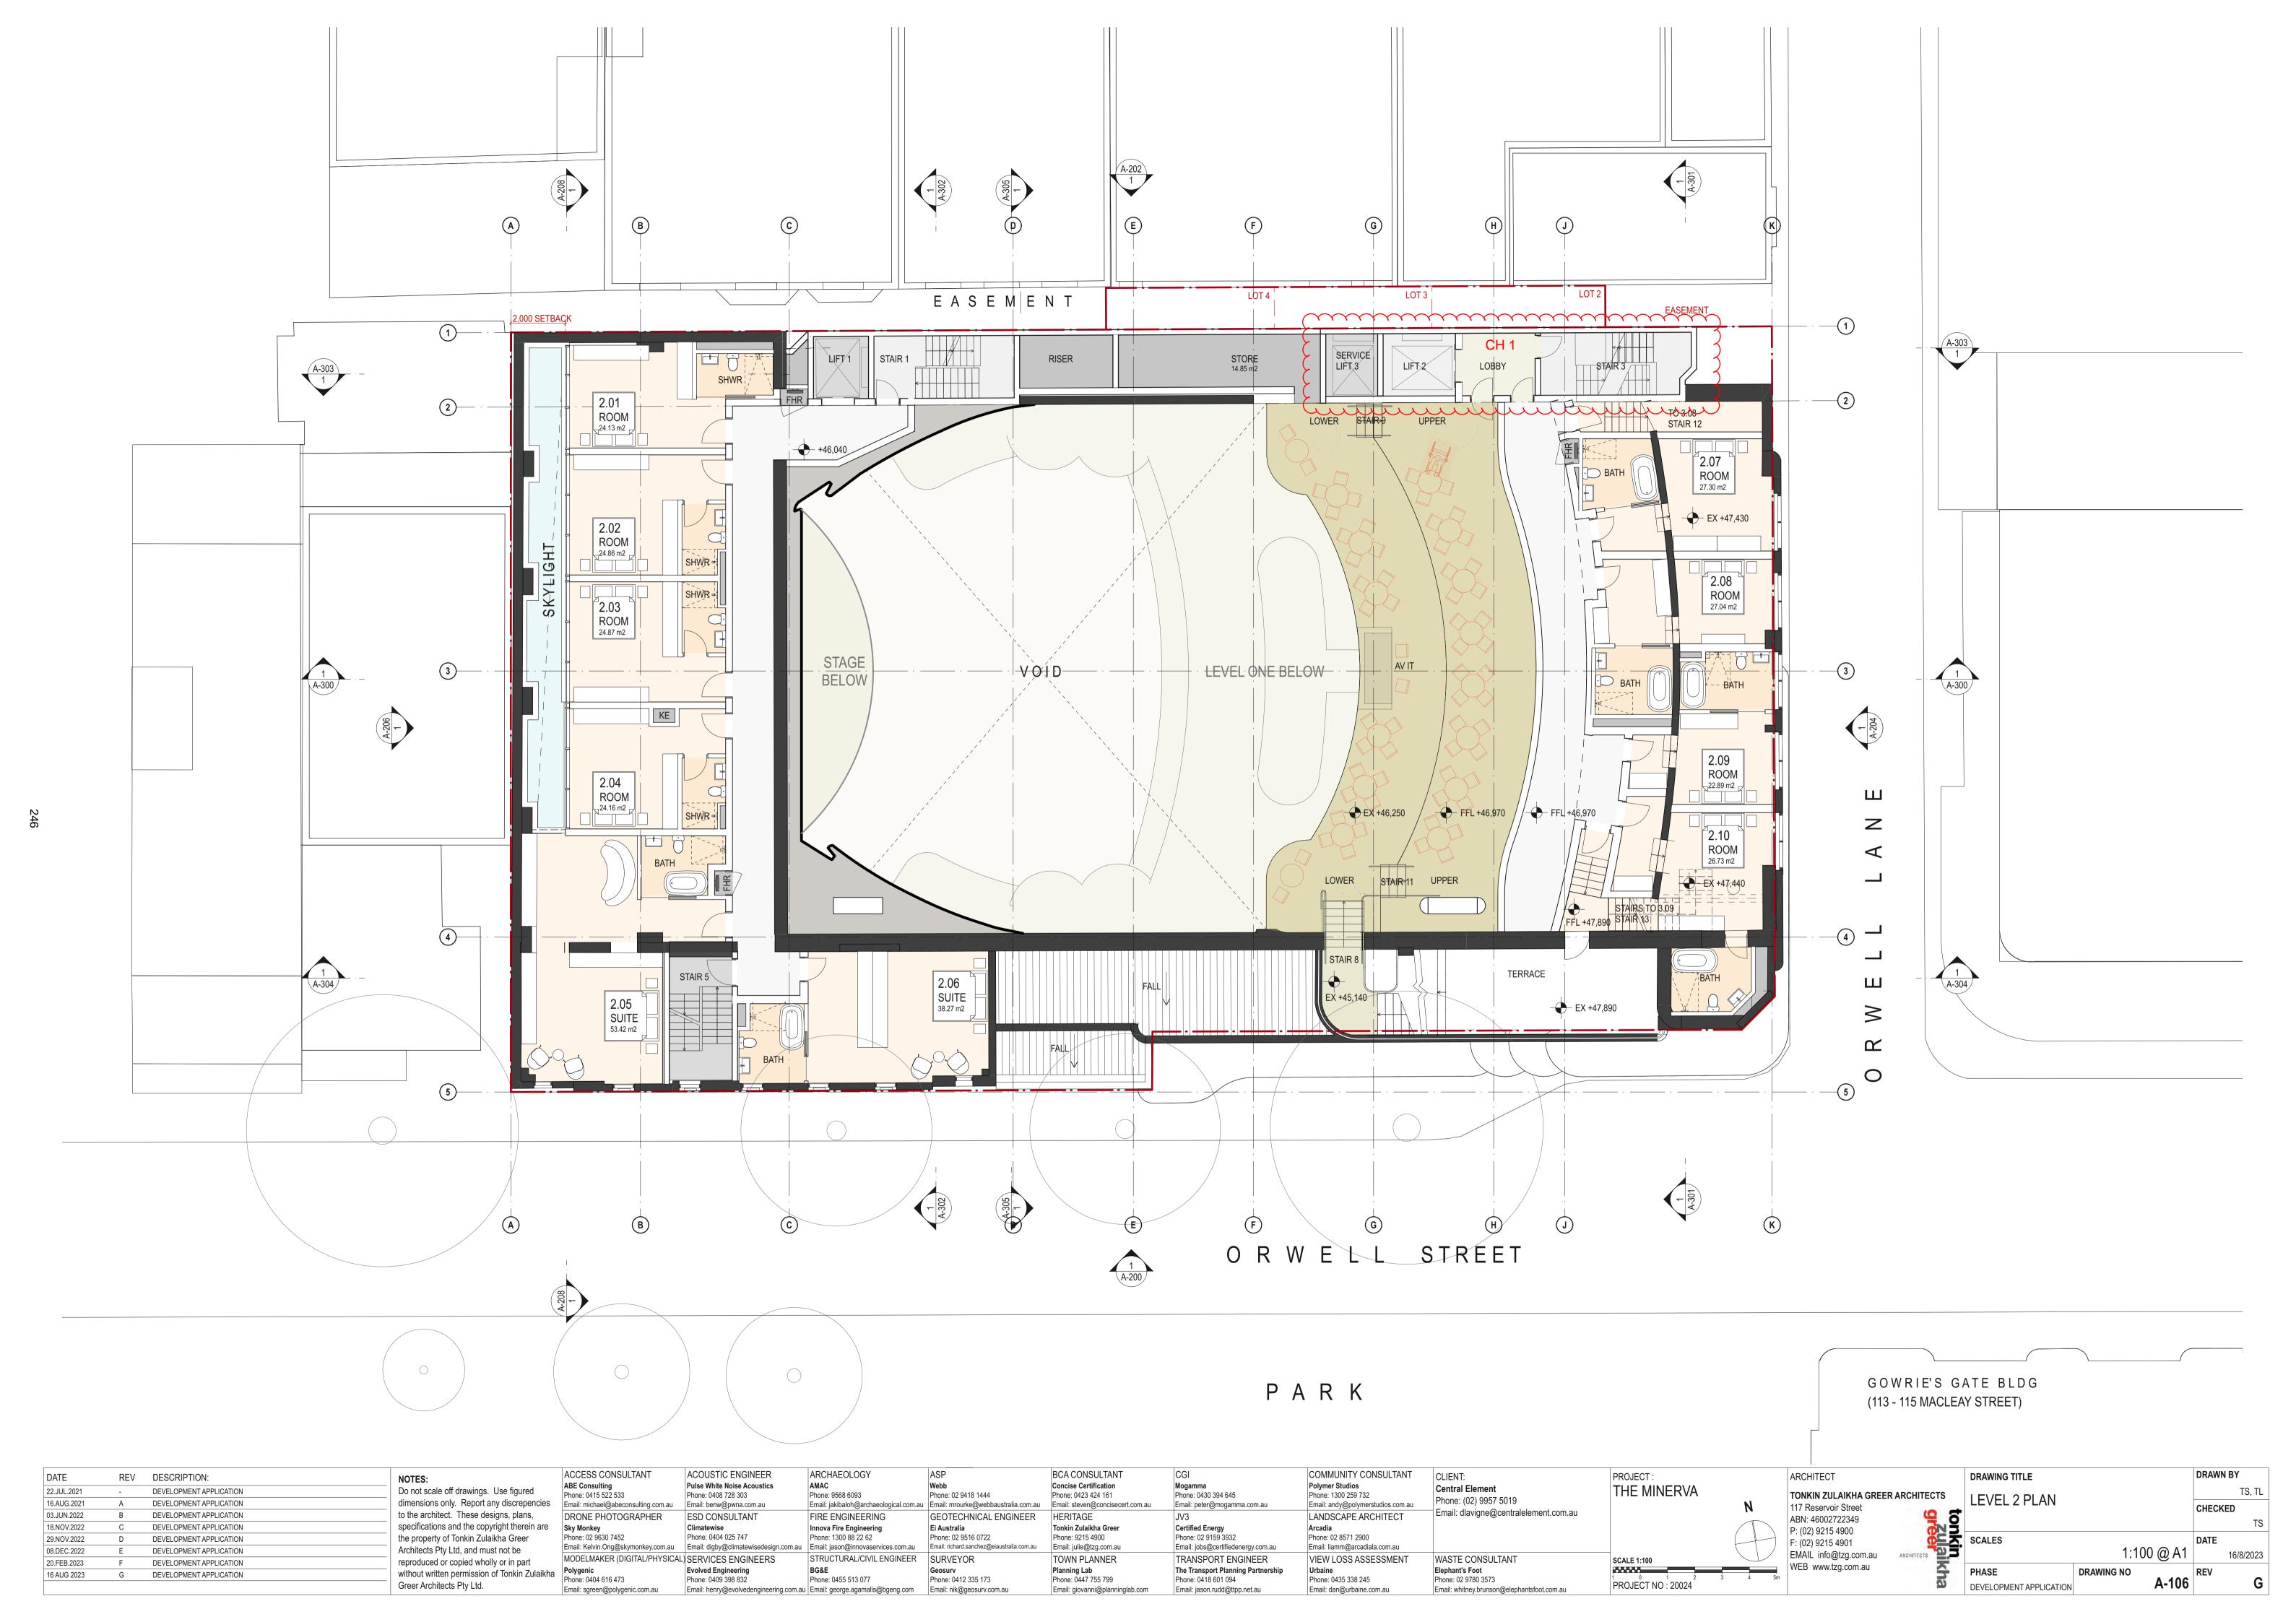

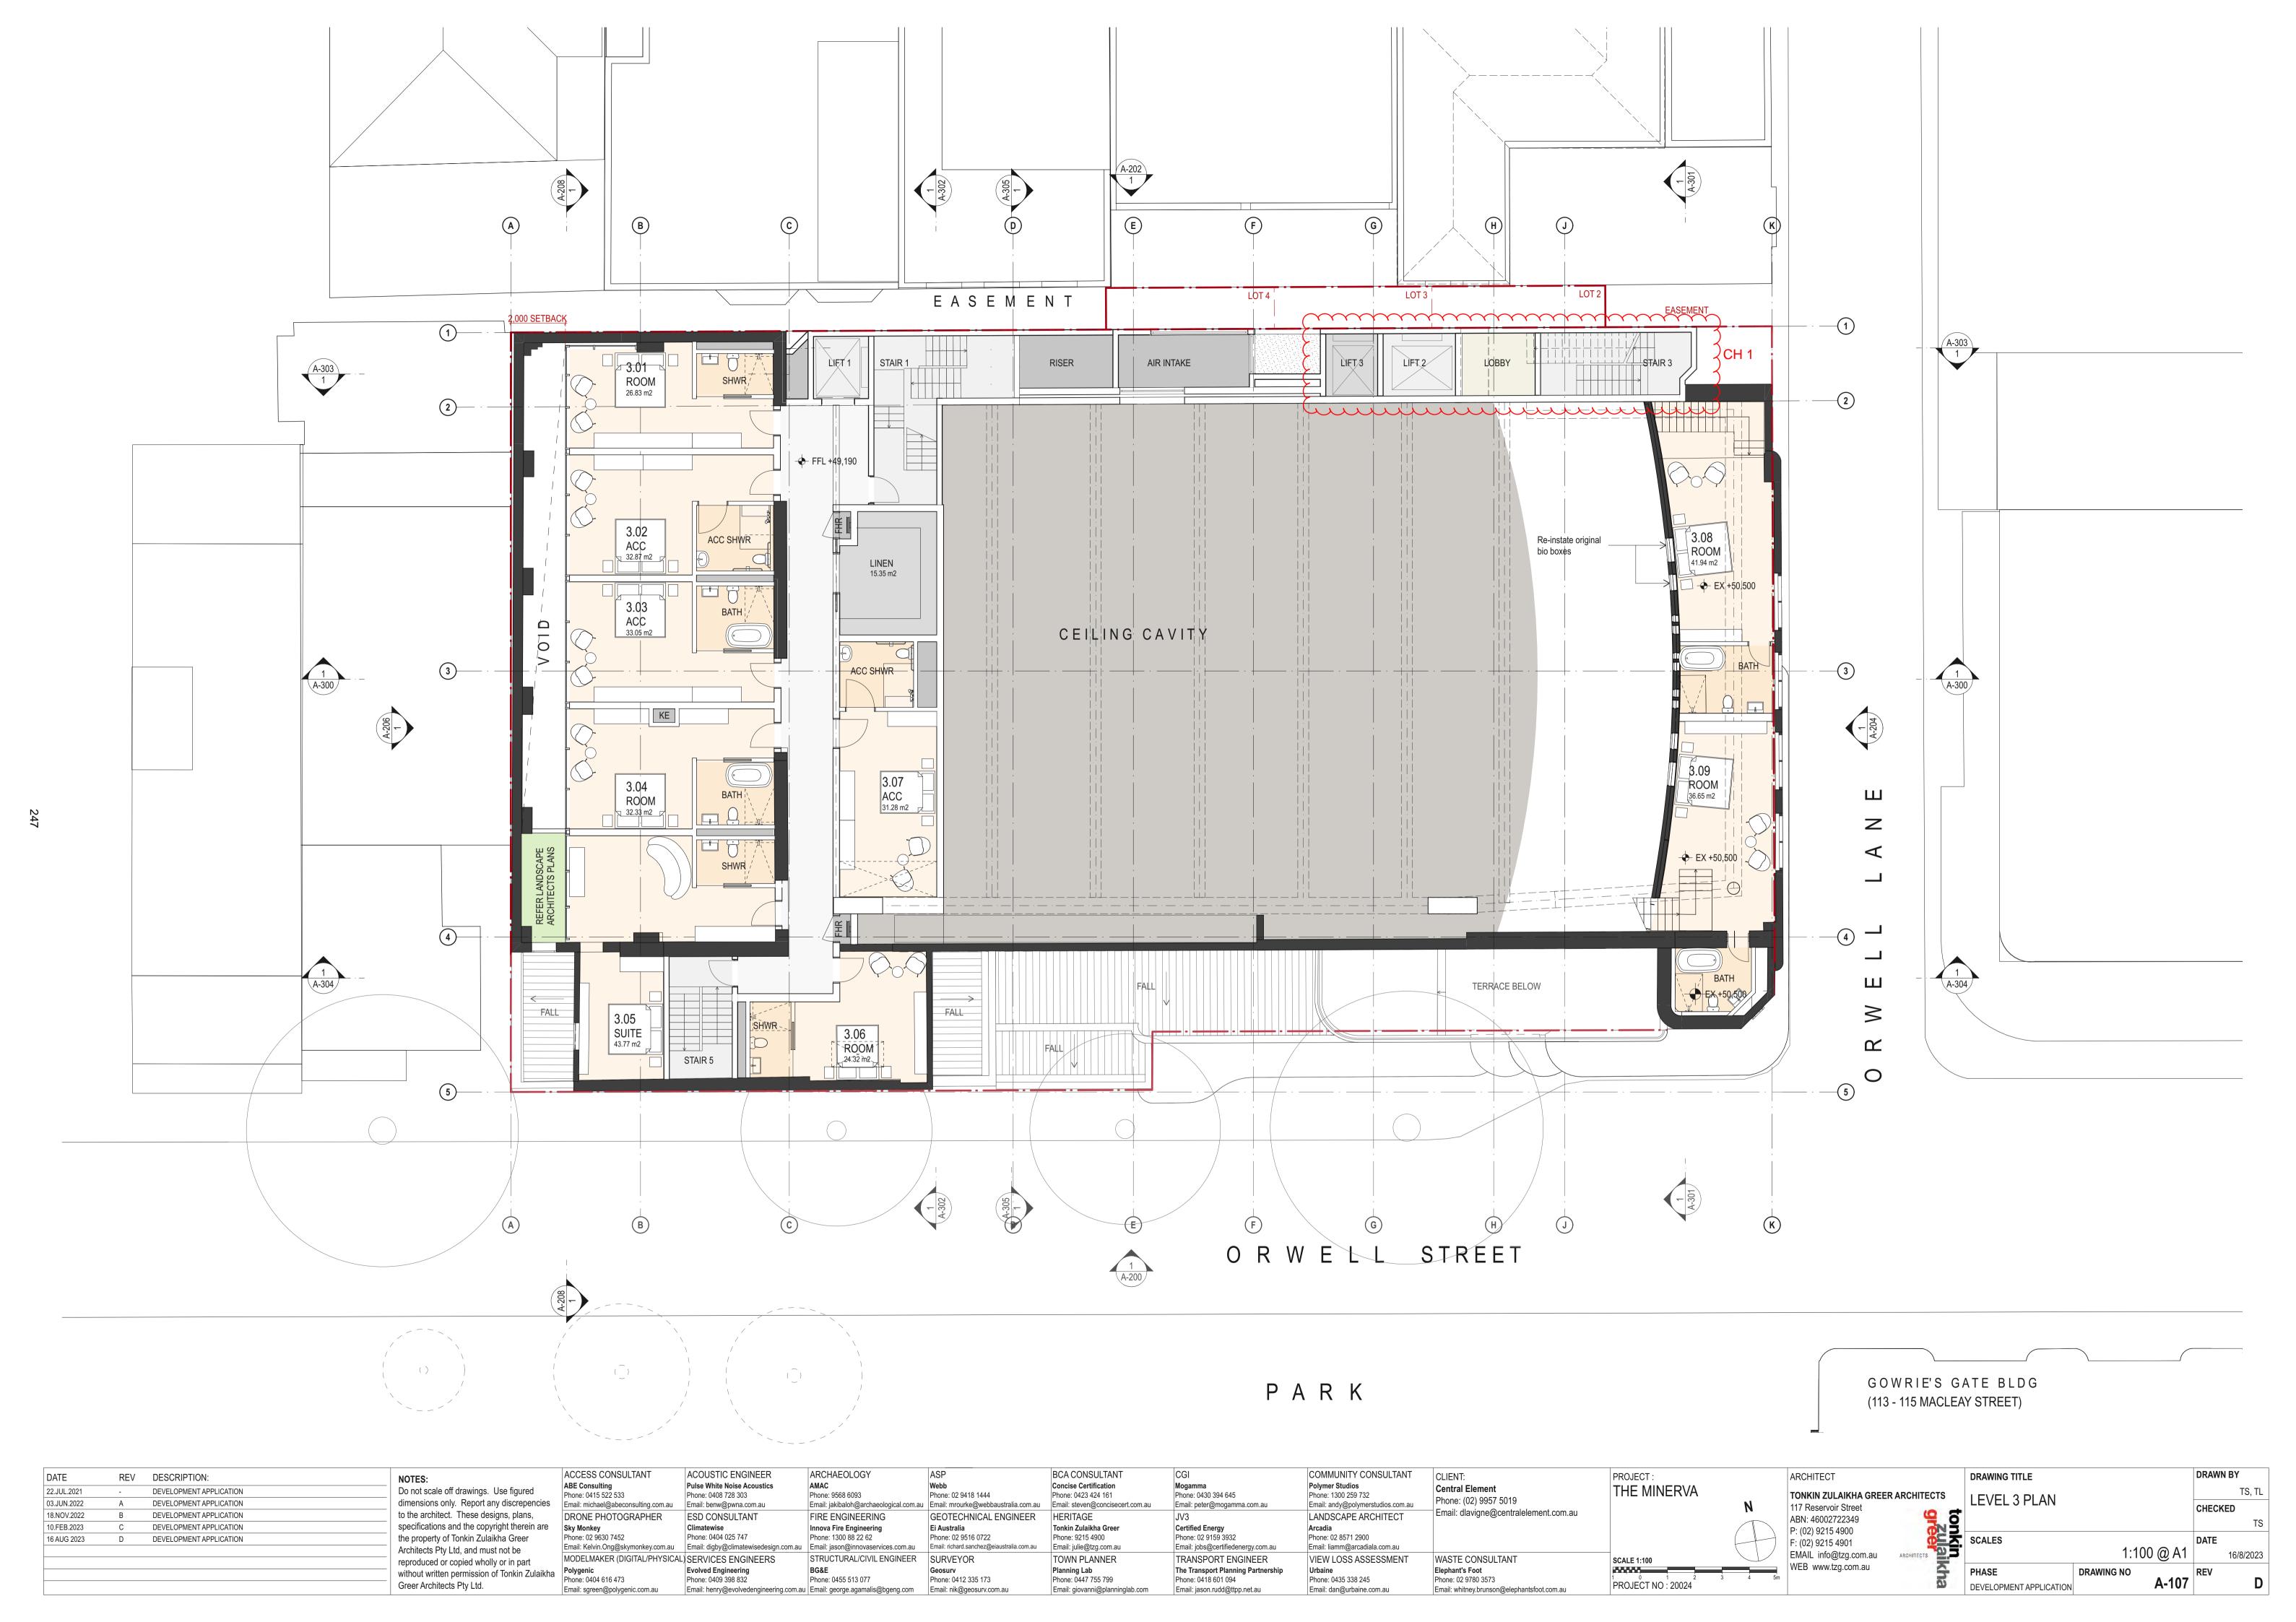

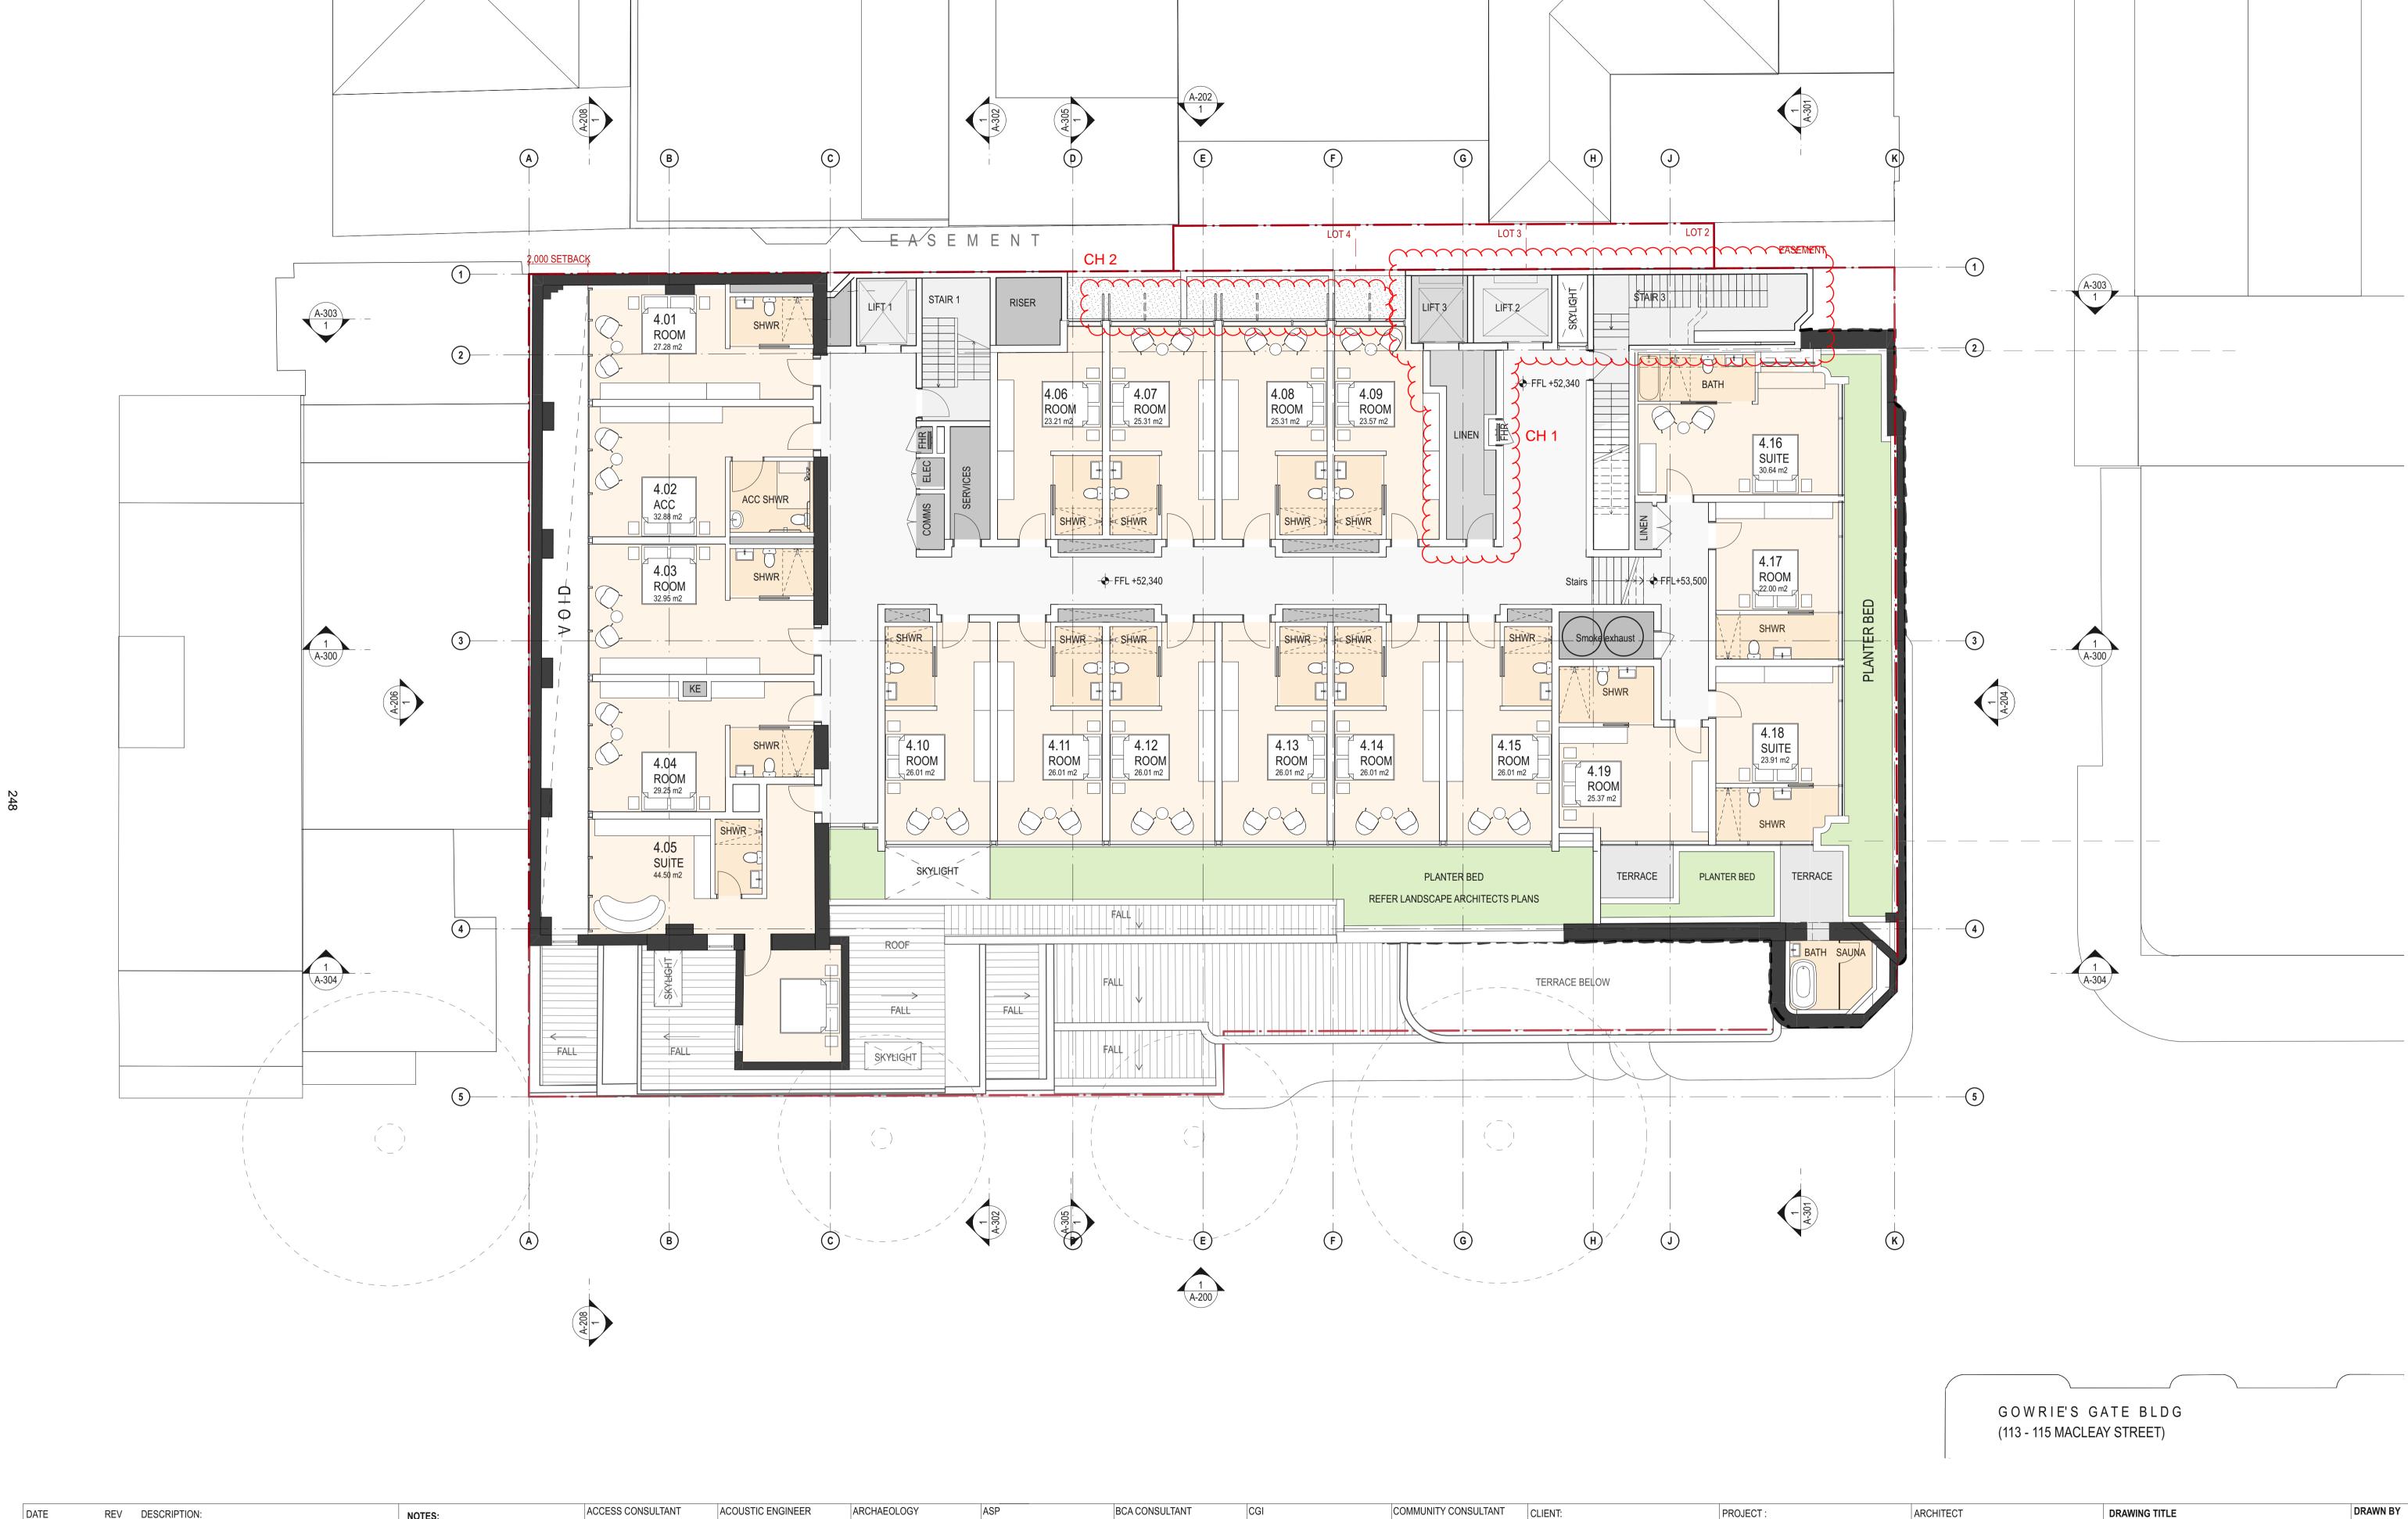

Concise Certification

Phone: 0423 424 161

Tonkin Zulaikha Greer

Phone: 9215 4900

Email: julie@tzg.com.au

TOWN PLANNER

Phone: 0447 755 799

Email: giovanni@planninglab.com

HERITAGE

Planning Lab

Phone: 0430 394 645

Certified Energy

Phone: 02 9159 3932

Phone: 0418 601 094

Email: jason.rudd@ttpp.net.au

Email: peter@mogamma.com.au

Email: jobs@certifiedenergy.com.au

The Transport Planning Partnership

TRANSPORT ENGINEER

Polymer Studios

Phone: 1300 259 732

Phone: 02 8571 2900

Phone: 0435 338 245

Email: dan@urbaine.com.au

Email: andy@polymerstudios.com.au

LANDSCAPE ARCHITECT

Email: liamm@arcadiala.com.au

VIEW LOSS ASSESSMENT

**Central Element** 

Phone: (02) 9957 5019

WASTE CONSULTANT

Elephant's Foot

Phone: 02 9780 3573

Email: dlavigne@centralelement.com.au

Email: whitney.brunson@elephantsfoot.com.au

THE MINERVA

**SCALE 1:100** 

----

PROJECT NO: 20024

**TONKIN ZULAIKHA GREER ARCHITECTS** 

117 Reservoir Street

ABN: 46002722349

EMAIL info@tzg.com.au

WEB www.tzg.com.au

P: (02) 9215 4900

F: (02) 9215 4901

LEVEL 4 PLAN

DEVELOPMENT APPLICATION

DRAWING NO

TS, TL

CHECKED

Pulse White Noise Acoustics

Phone: 0408 728 303

ESD CONSULTANT

Phone: 0404 025 747

**Evolved Engineering** 

Phone: 0409 398 832

MODELMAKER (DIGITAL/PHYSICAL) SERVICES ENGINEERS

Phone: 9568 6093

FIRE ENGINEERING

Innova Fire Engineering

STRUCTURAL/CIVIL ENGINEER SURVEYOR

Phone: 1300 88 22 62

Phone: 0455 513 077

Email: henry@evolvedengineering.com.au | Email: george.agamalis@bgeng.com | Email: nik@geosurv.com.au

Phone: 02 9418 1444

Phone: 02 9516 0722

Phone: 0412 335 173

| Email: jakibaloh@archaeological.com.au | Email: mrourke@webbaustralia.com.au | Email: steven@concisecert.com.au

GEOTECHNICAL ENGINEER

Email: richard.sanchez@eiaustralia.com.au

ABE Consulting

dimensions only. Report any discrepencies Email: michael@abeconsulting.com.au Email: benw@pwna.com.au

Phone: 0415 522 533

Phone: 02 9630 7452

Phone: 0404 616 473

DRONE PHOTOGRAPHER

Email: sgreen@polygenic.com.au

Do not scale off drawings. Use figured

the property of Tonkin Zulaikha Greer

reproduced or copied wholly or in part

Architects Pty Ltd, and must not be

Greer Architects Pty Ltd.

to the architect. These designs, plans,

specifications and the copyright therein are Sky Monkey

without written permission of Tonkin Zulaikha

22.JUL.2021

03.JUN.2022

18.NOV.2022

29.NOV.2022

10.FEB.2023

DEVELOPMENT APPLICATION


DEVELOPMENT APPLICATION

DEVELOPMENT APPLICATION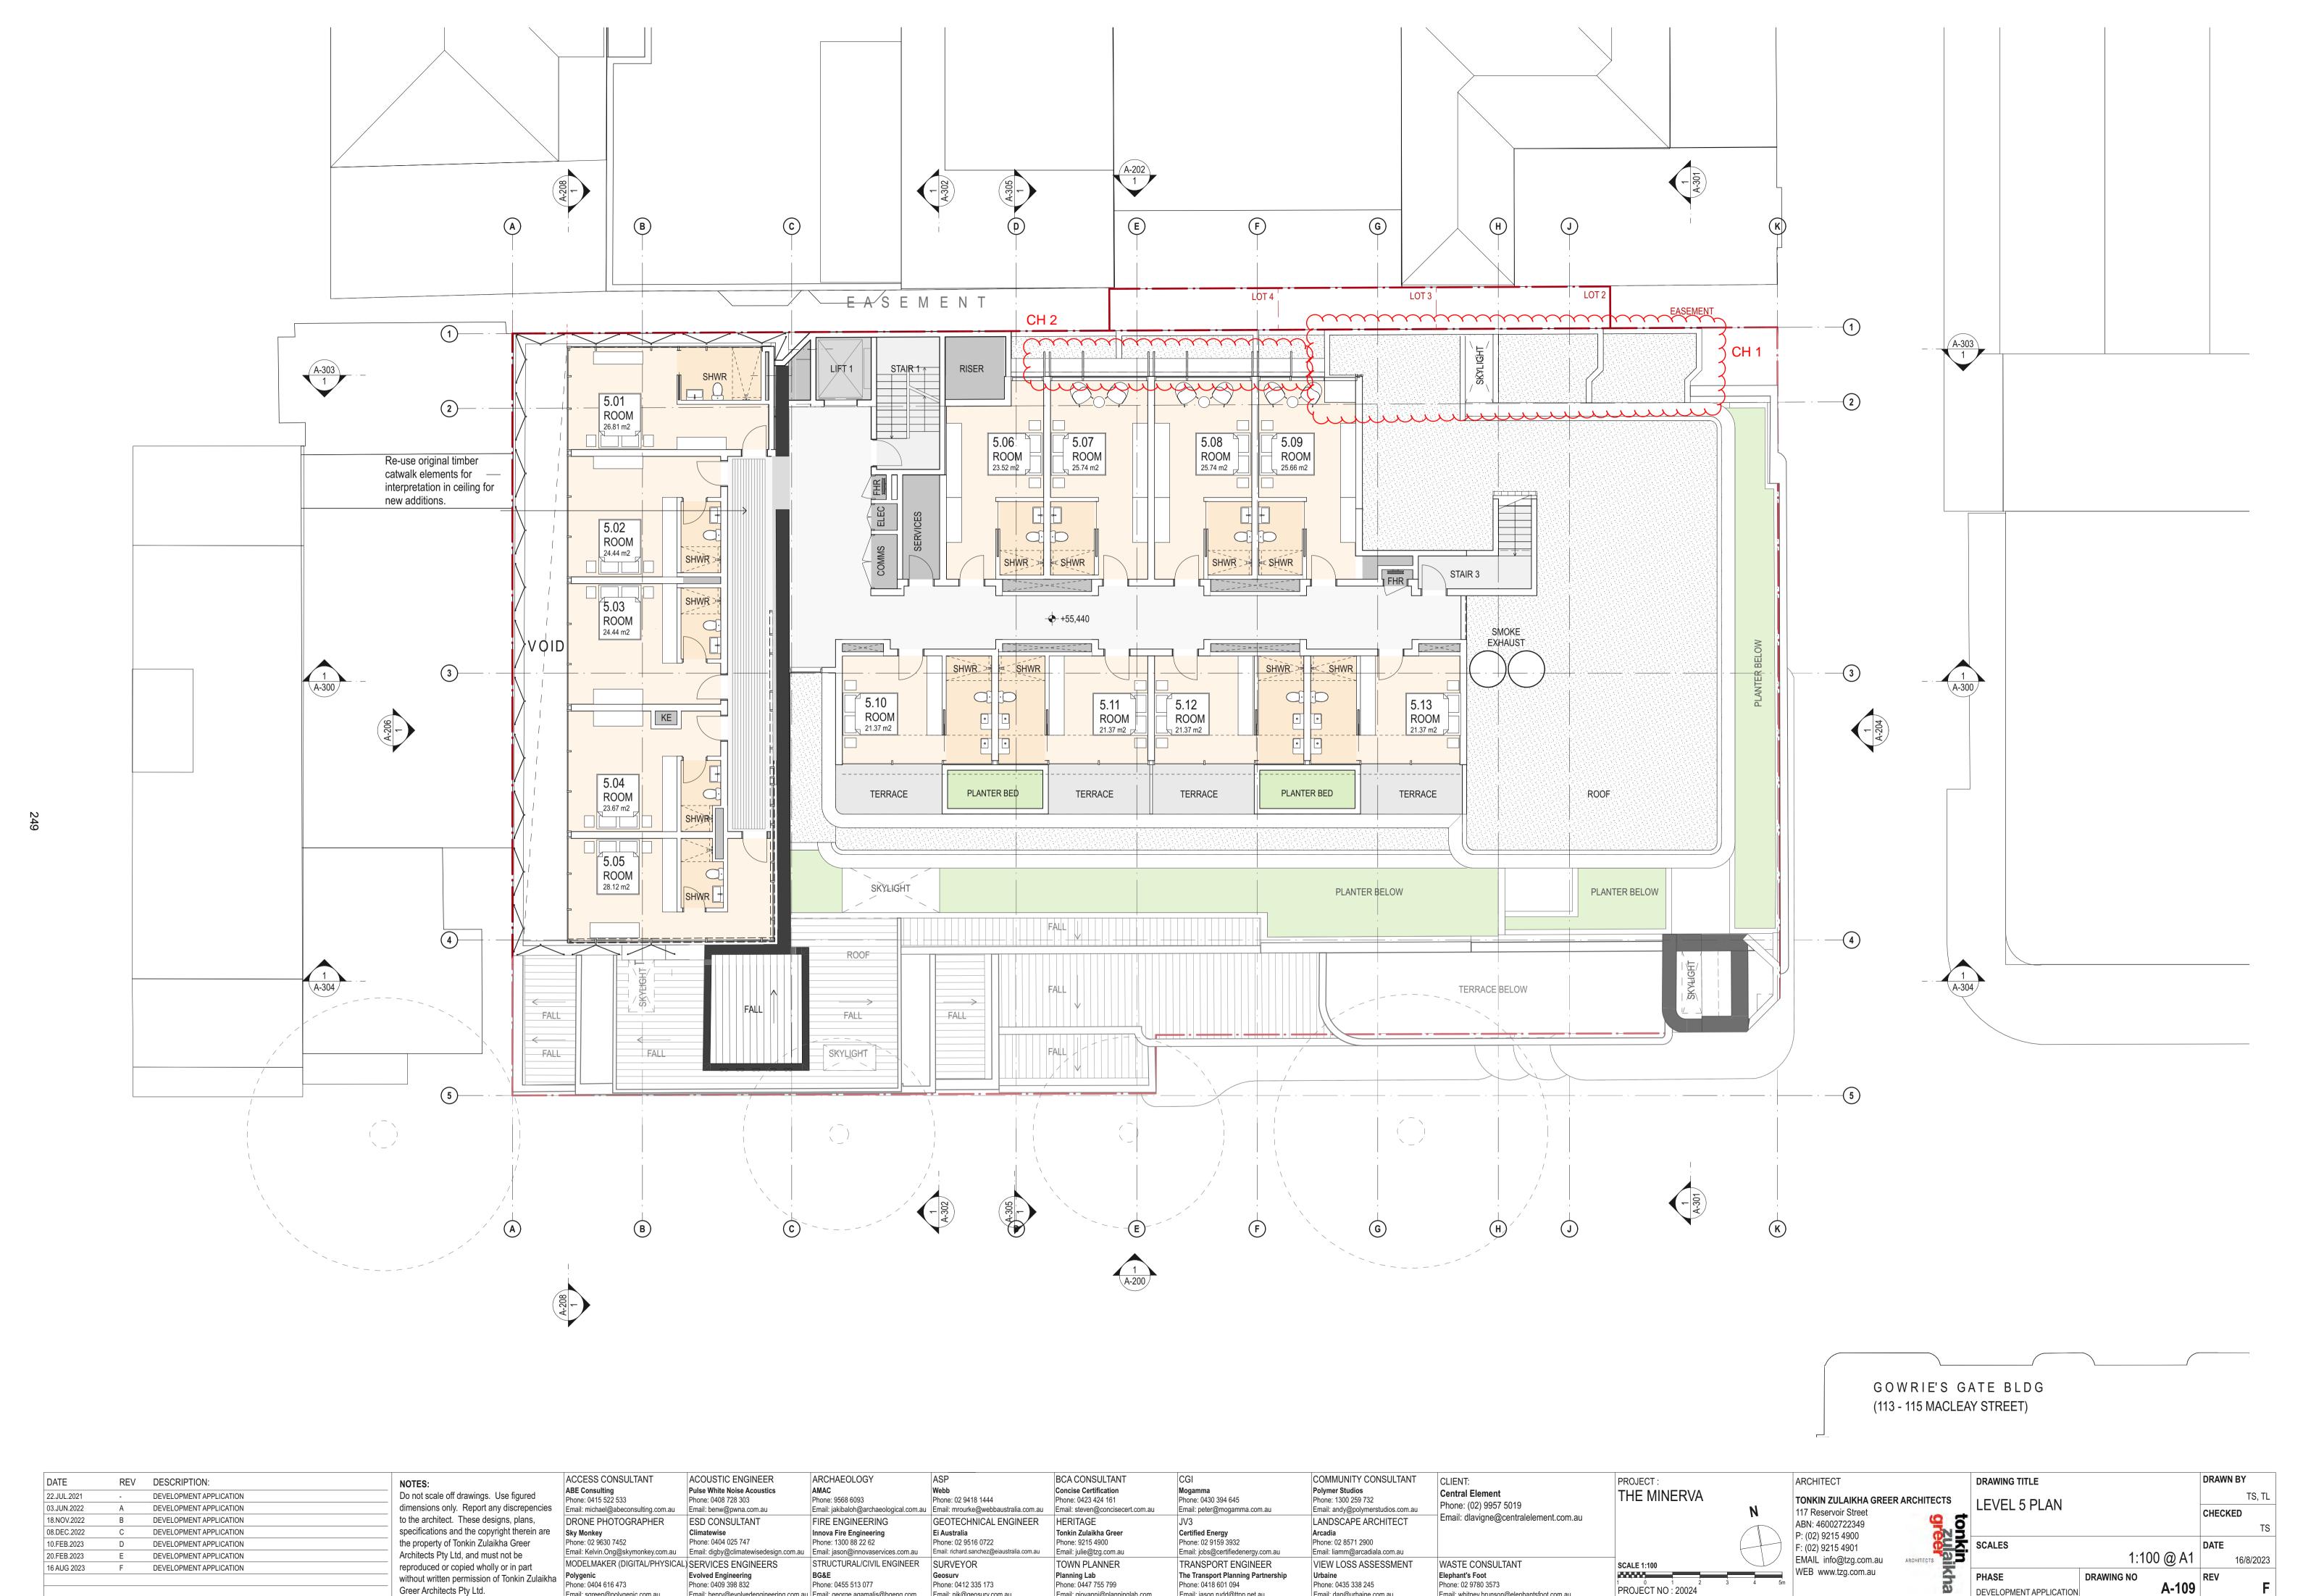

Email: giovanni@planninglab.com

Email: jason.rudd@ttpp.net.au


Email: dan@urbaine.com.au

Email: whitney.brunson@elephantsfoot.com.au

Email: henry@evolvedengineering.com.au | Email: george.agamalis@bgeng.com | Email: nik@geosurv.com.au

Email: sgreen@polygenic.com.au

DEVELOPMENT APPLICATION

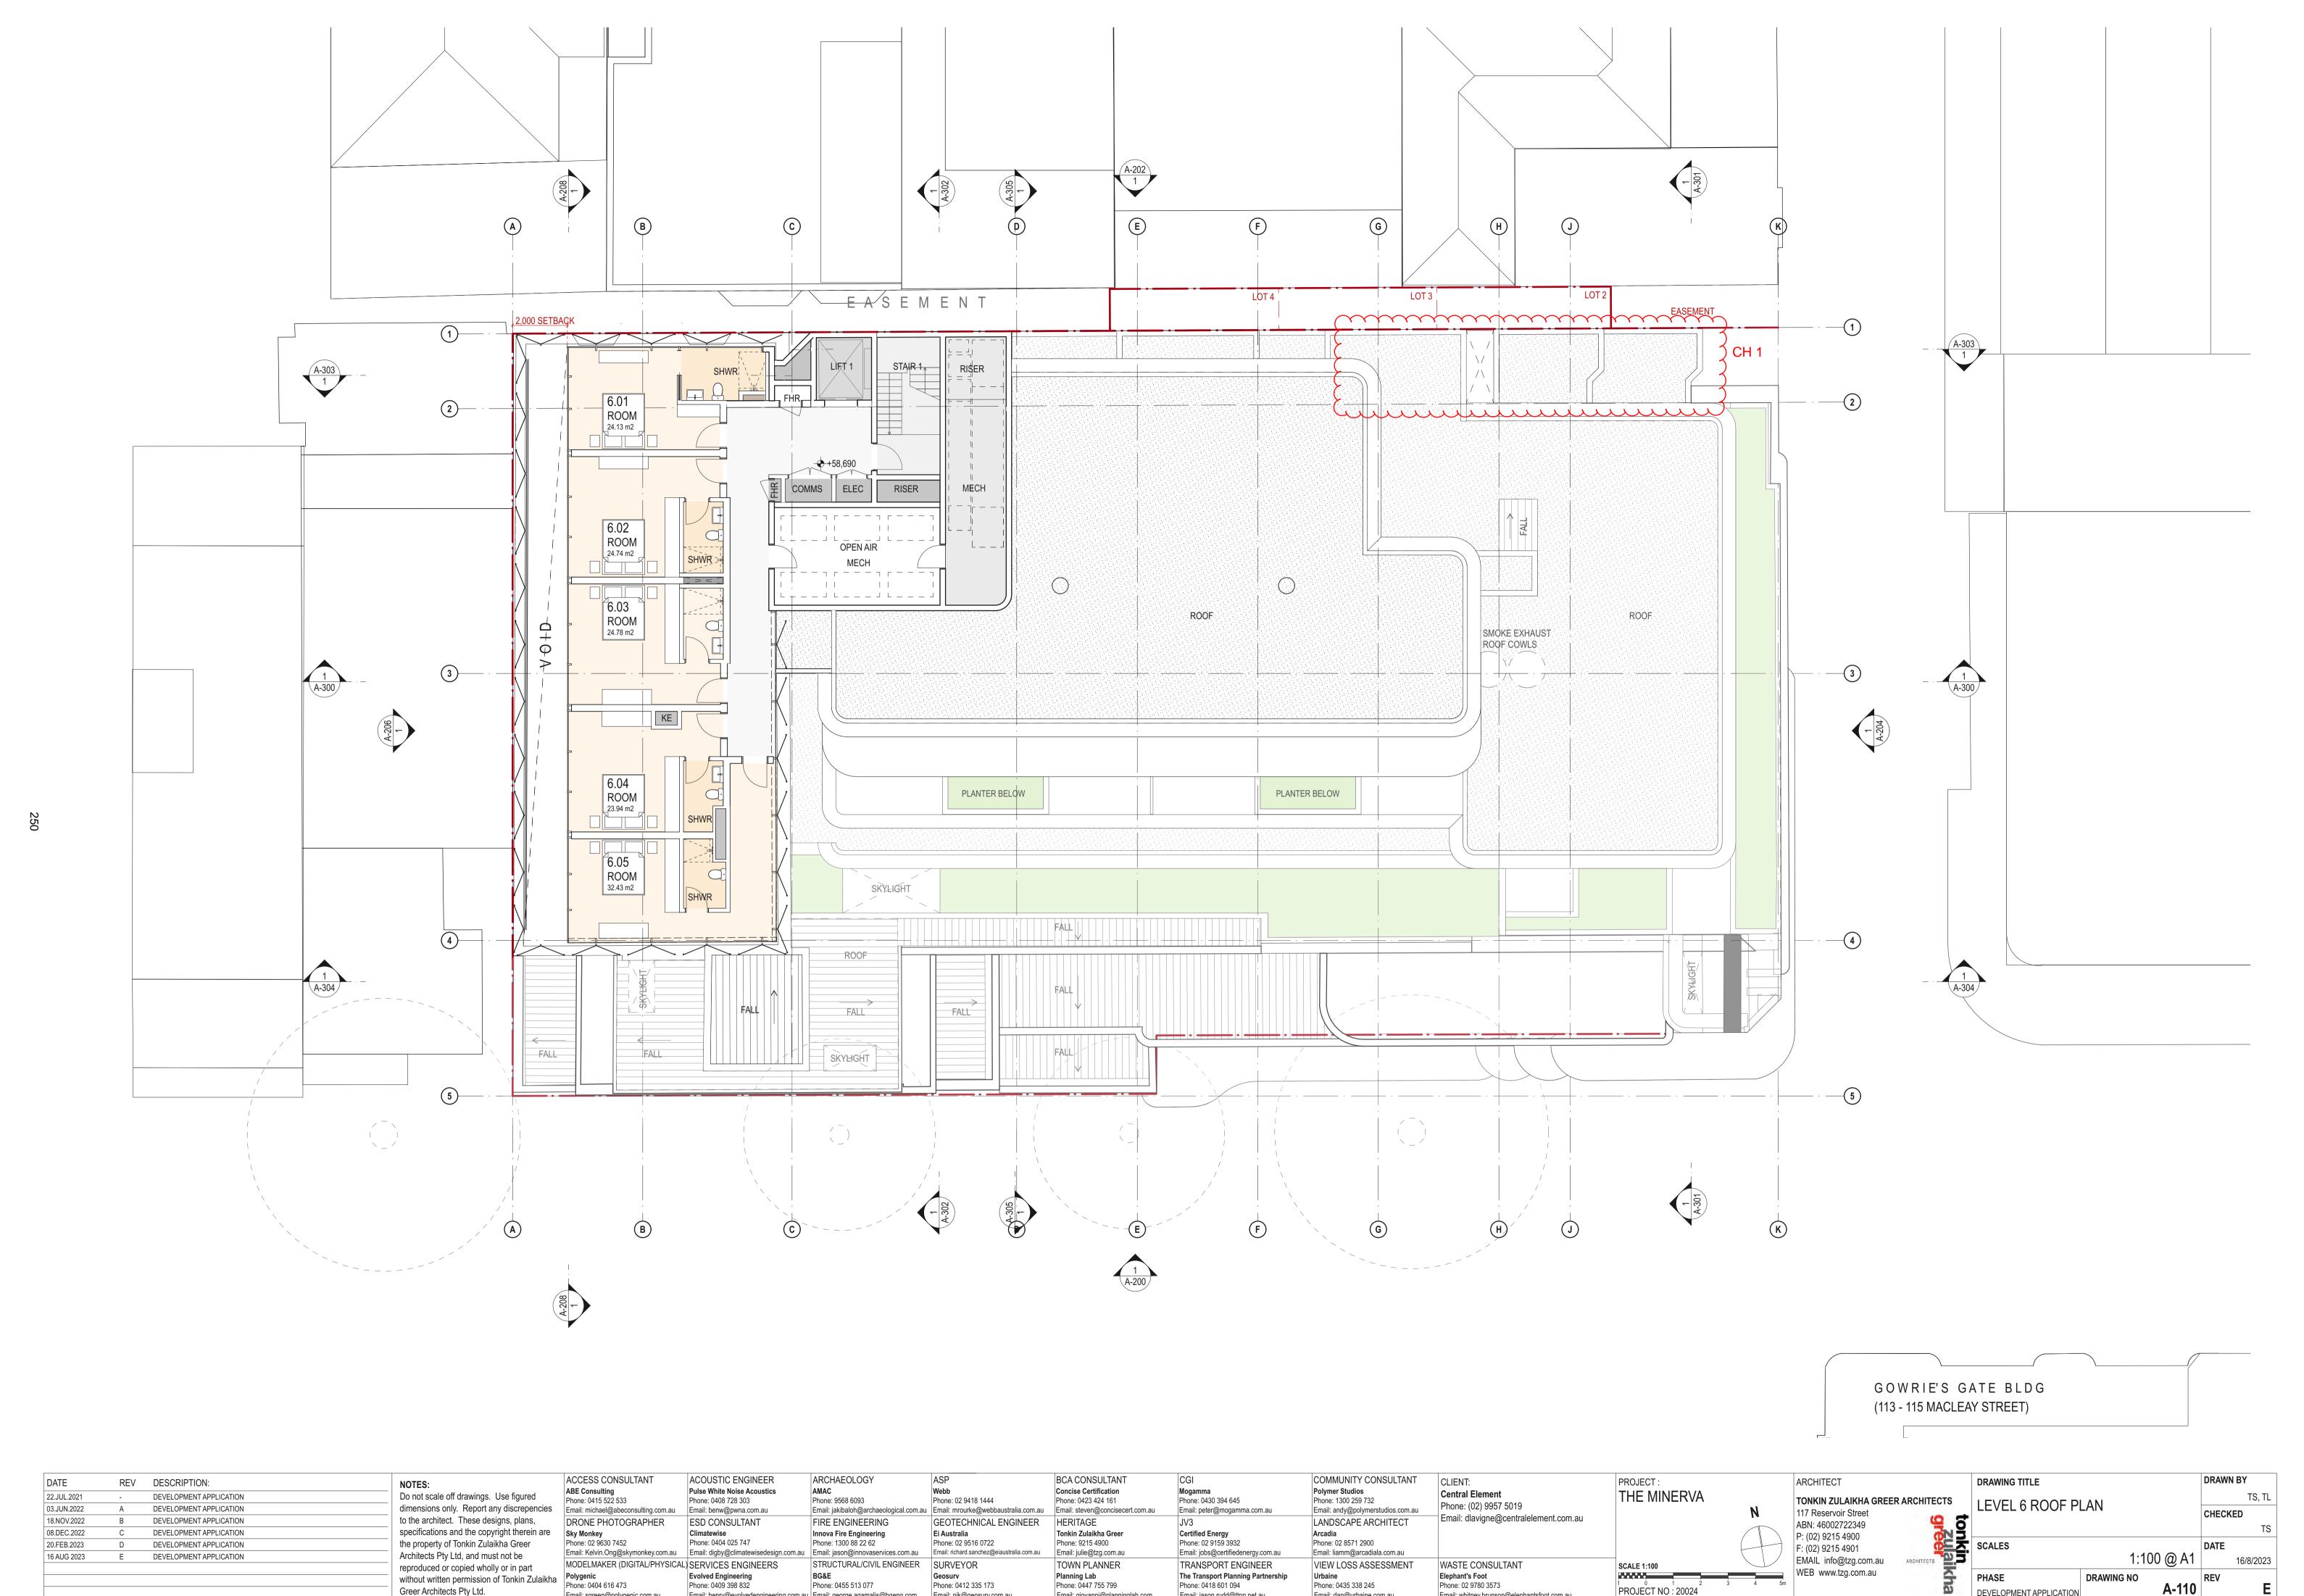

Email: jason.rudd@ttpp.net.au

Email: giovanni@planninglab.com

Email: dan@urbaine.com.au

Email: whitney.brunson@elephantsfoot.com.au


PROJECT NO: 20024

DEVELOPMENT APPLICATION

Greer Architects Pty Ltd.

Email: sgreen@polygenic.com.au

Email: henry@evolvedengineering.com.au | Email: george.agamalis@bgeng.com | Email: nik@geosurv.com.au

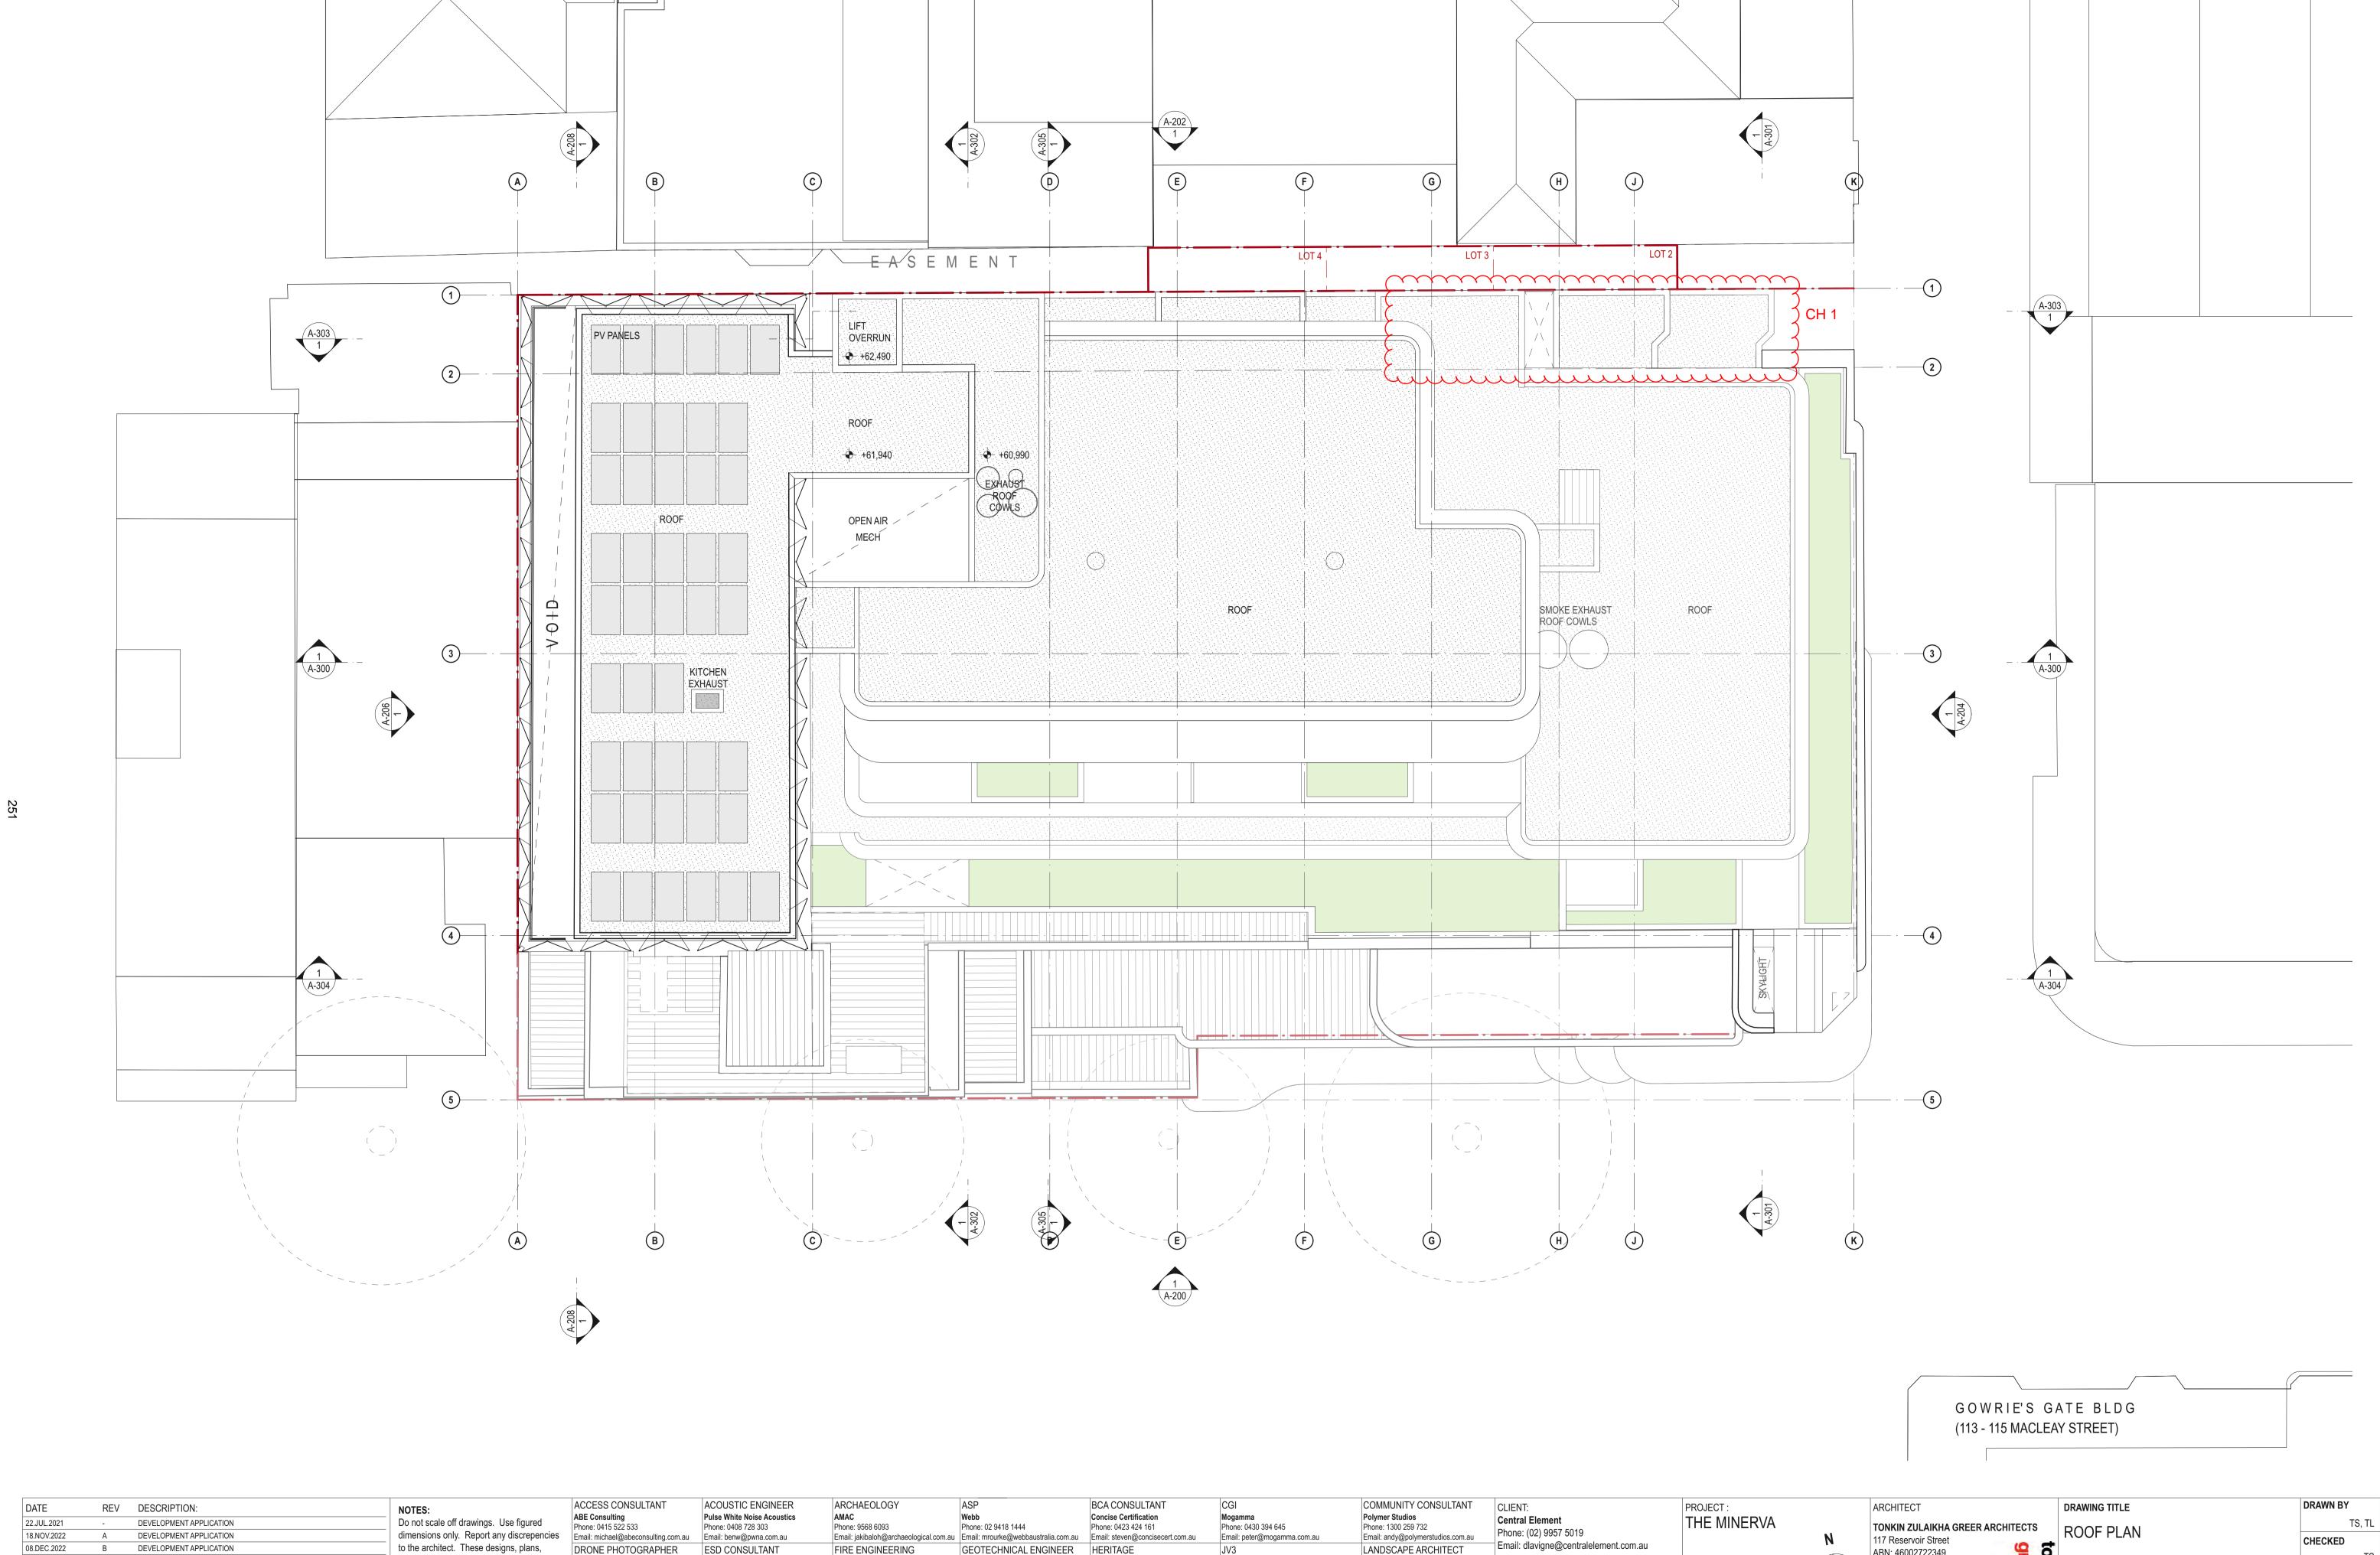

HERITAGE

Planning Lab

Tonkin Zulaikha Greer

Phone: 9215 4900

Email: julie@tzg.com.au

TOWN PLANNER

Phone: 0447 755 799

Email: giovanni@planninglab.com

Certified Energy

Phone: 02 9159 3932

Phone: 0418 601 094

Email: jobs@certifiedenergy.com.au

The Transport Planning Partnership

TRANSPORT ENGINEER

Email: jason.rudd@ttpp.net.au

Phone: 02 8571 2900

Phone: 0435 338 245

Email: dan@urbaine.com.au

Email: liamm@arcadiala.com.au

VIEW LOSS ASSESSMENT

WASTE CONSULTANT

Email: whitney.brunson@elephantsfoot.com.au

Elephant's Foot

Phone: 02 9780 3573

**SCALE 1:100** 

PROJECT NO: 20024

ABN: 46002722349

EMAIL info@tzg.com.au

DRAWING NO

DEVELOPMENT APPLICATION

A-111

WEB www.tzg.com.au

P: (02) 9215 4900

F: (02) 9215 4901

ESD CONSULTANT

Phone: 0404 025 747

**Evolved Engineering** 

Phone: 0409 398 832

MODELMAKER (DIGITAL/PHYSICAL) SERVICES ENGINEERS

specifications and the copyright therein are Sky Monkey

without written permission of Tonkin Zulaikha

Polygenic
Phone: 0404 616 473

Phone: 02 9630 7452

Email: sgreen@polygenic.com.au

the property of Tonkin Zulaikha Greer

reproduced or copied wholly or in part

Architects Pty Ltd, and must not be

Greer Architects Pty Ltd.

DEVELOPMENT APPLICATION

D DEVELOPMENT APPLICATION

20.FEB.2023

FIRE ENGINEERING

Innova Fire Engineering Phone: 1300 88 22 62

Phone: 0455 513 077


Email: henry@evolvedengineering.com.au | Email: george.agamalis@bgeng.com | Email: nik@geosurv.com.au

STRUCTURAL/CIVIL ENGINEER SURVEYOR

Email: Kelvin.Ong@skymonkey.com.au Email: digby@climatewisedesign.com.au Email: jason@innovaservices.com.au Email: richard.sanchez@eiaustralia.com.au

Phone: 02 9516 0722

Phone: 0412 335 173

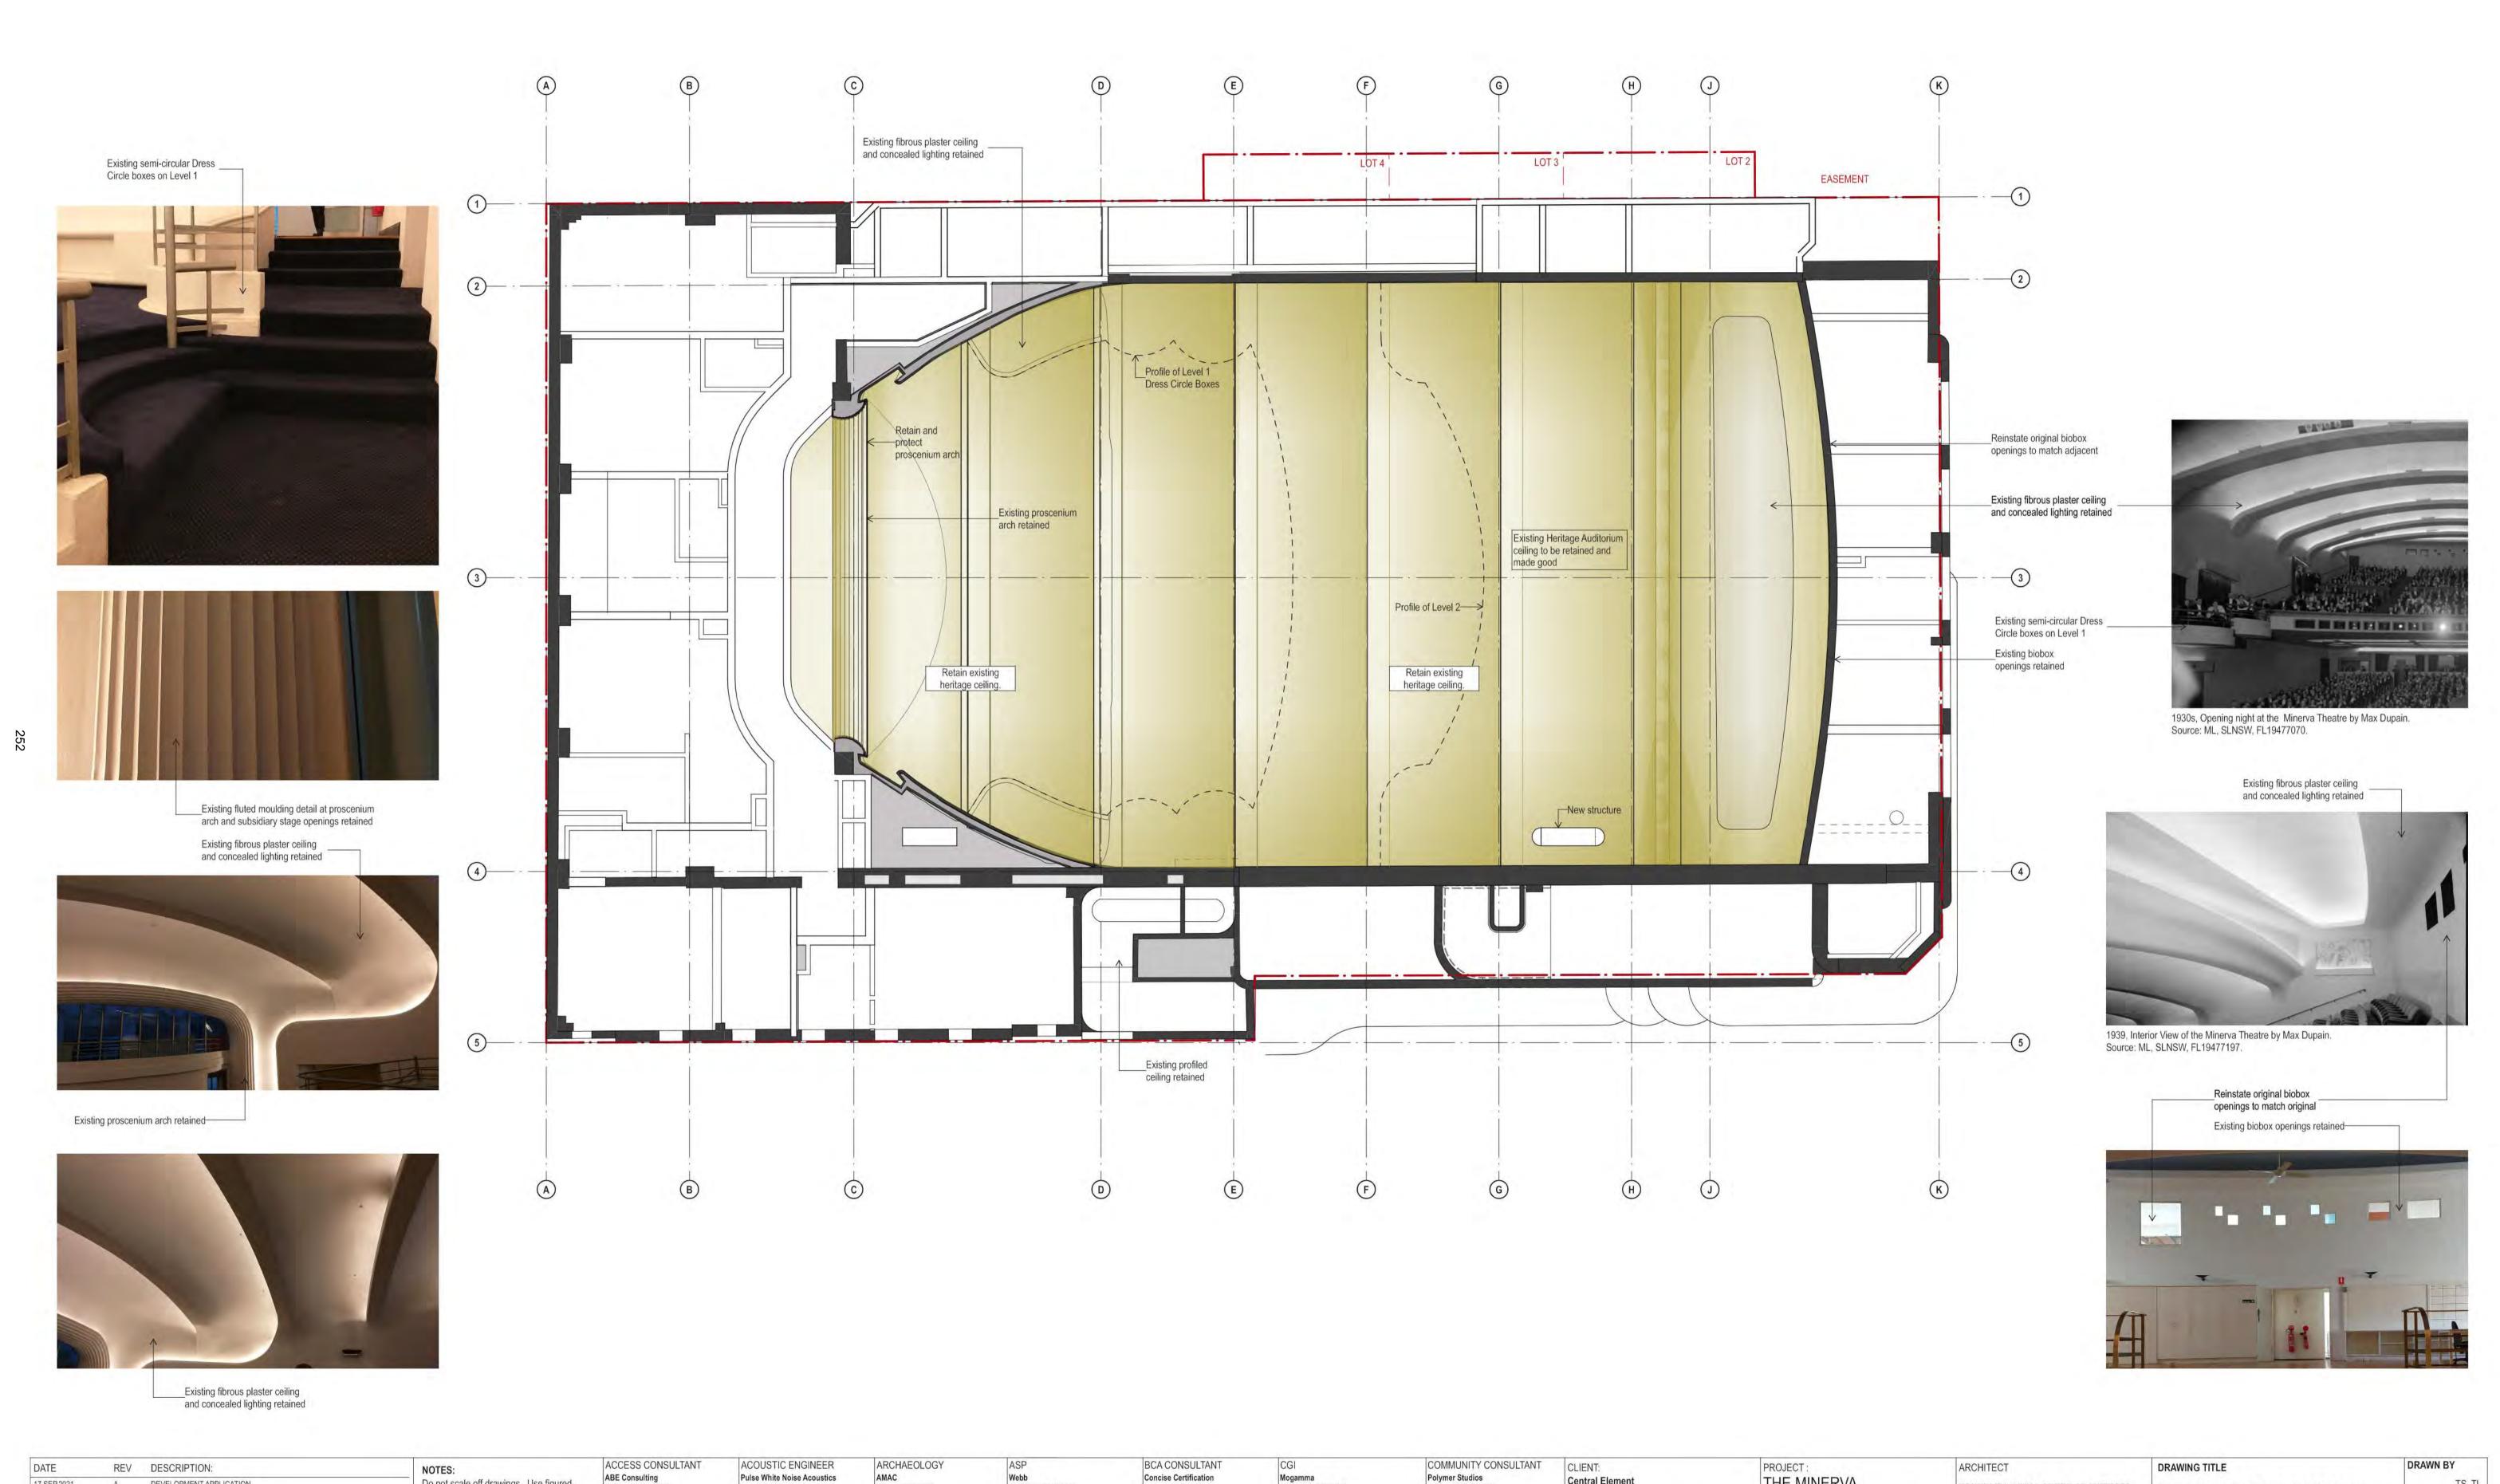

Mogamma Phone: 0430 394 645 THE MINERVA **Central Element** 17.SEP.2021 DEVELOPMENT APPLICATION Do not scale off drawings. Use figured Phone: 9568 6093 Phone: 02 9418 1444 TONKIN ZULAIKHA GREER ARCHITECTS AUDITORIUM RCP PROPOSED Phone: 0415 522 533 Phone: 0408 728 303 Phone: 0423 424 161 Phone: 1300 259 732 dimensions only. Report any discrepencies Email: michael@abeconsulting.com.au Email: benw@pwna.com.au Phone: (02) 9957 5019 DEVELOPMENT APPLICATION 18.NOV.2022 Email: steven@concisecert.com.au Email: peter@mogamma.com.au Email: andy@polymerstudios.com.au 117 Reservoir Street CHECKED Email: dlavigne@centralelement.com.au to the architect. These designs, plans, **GROUND FLOOR - LEVEL 3** DEVELOPMENT APPLICATION LANDSCAPE ARCHITECT 08.DEC.2022 DRONE PHOTOGRAPHER **ESD CONSULTANT** FIRE ENGINEERING GEOTECHNICAL ENGINEER HERITAGE ABN: 46002722349 specifications and the copyright therein are Sky Monkey 01 MAR 2023 D DEVELOPMENT APPLICATION Climatewise Innova Fire Engineering Ei Australia Tonkin Zulaikha Greer Certified Energy P: (02) 9215 4900 Phone: 02 9516 0722 Email: richard.sanchez@eiaustralia.com.au Phone: 02 8571 2900 Email: liamm@arcadiala.com.au Phone: 02 9630 7452 the property of Tonkin Zulaikha Greer Phone: 0404 025 747 Phone: 1300 88 22 62 Phone: 9215 4900 Phone: 02 9159 3932 F: (02) 9215 4901 Email: jason@innovaservices.com.au Email: julie@tzg.com.au Email: jobs@certifiedenergy.com.au Architects Pty Ltd, and must not be 1:100 @ A1 EMAIL info@tzg.com.au 1/3/2023 WASTE CONSULTANT STRUCTURAL/CIVIL ENGINEER VIEW LOSS ASSESSMENT MODELMAKER (DIGITAL/PHYSICAL) SERVICES ENGINEERS TRANSPORT ENGINEER SURVEYOR TOWN PLANNER SCALE 1:100 reproduced or copied wholly or in part WEB www.tzg.com.au without written permission of Tonkin Zulaikha

Polygenic
Phone: 0404 616 473 **Evolved Engineering** The Transport Planning Partnership Elephant's Foot 255557 DRAWING NO Planning Lab Phone: 0409 398 832 Phone: 0455 513 077 Phone: 0412 335 173 Phone: 0447 755 799 Phone: 0418 601 094 Phone: 0435 338 245 Phone: 02 9780 3573 A-121 Greer Architects Pty Ltd. PROJECT NO: 20024 DEVELOPMENT APPLICATION Email: henry@evolvedengineering.com.au Email: george.agamalis@bgeng.com Email: nik@geosurv.com.au Email: whitney.brunson@elephantsfoot.com.au Email: dan@urbaine.com.au Email: sgreen@polygenic.com.au Email: giovanni@planninglab.com Email: jason.rudd@ttpp.net.au