

Attachment B

Selected Drawings

Check all dimensions and site conditions prior to commencement of any work. Any discrepancy between the drawings and the site conditions shall be reported immediately to the architect. The architect shall be responsible for the accuracy of the drawings. Do not scale drawings - refer to listed dimensions only. Any discrepancy shall immediately be referred to the architect for clarification. All drawings may not be reproduced or distributed without prior permission from the architect.

| Rev | Desc | Drawn | Checked | Initial | Date |
|-----|--|-------|---------|---------|------|
| B | 24/01/24: DA Response to Pitt Street Council | | | | |
| | | | | | |

Hunter & Pitt




Site Plan

| | |
|----------------|-------------------------|
| Status | Development Application |
| Scale | 1:500 @ A1 |
| Drawn | AT |
| Checked | DS |
| Project No. | S12333A |
| Plot Date | 2005/03/11 02:25 AM |
| BNV | |
| Drawing No. | Revision |
| A01.000 | B |


Bates Smart Architects Pty Ltd ABN 68 094 740 888
 100 Waterloo Road, Sydney NSW 2010
 Sydney NSW 2010 Australia
 Phone: +61 (0)2 9211 8888
 Email: info@batesmart.com.au
 Website: www.batesmart.com.au

BATESSMART

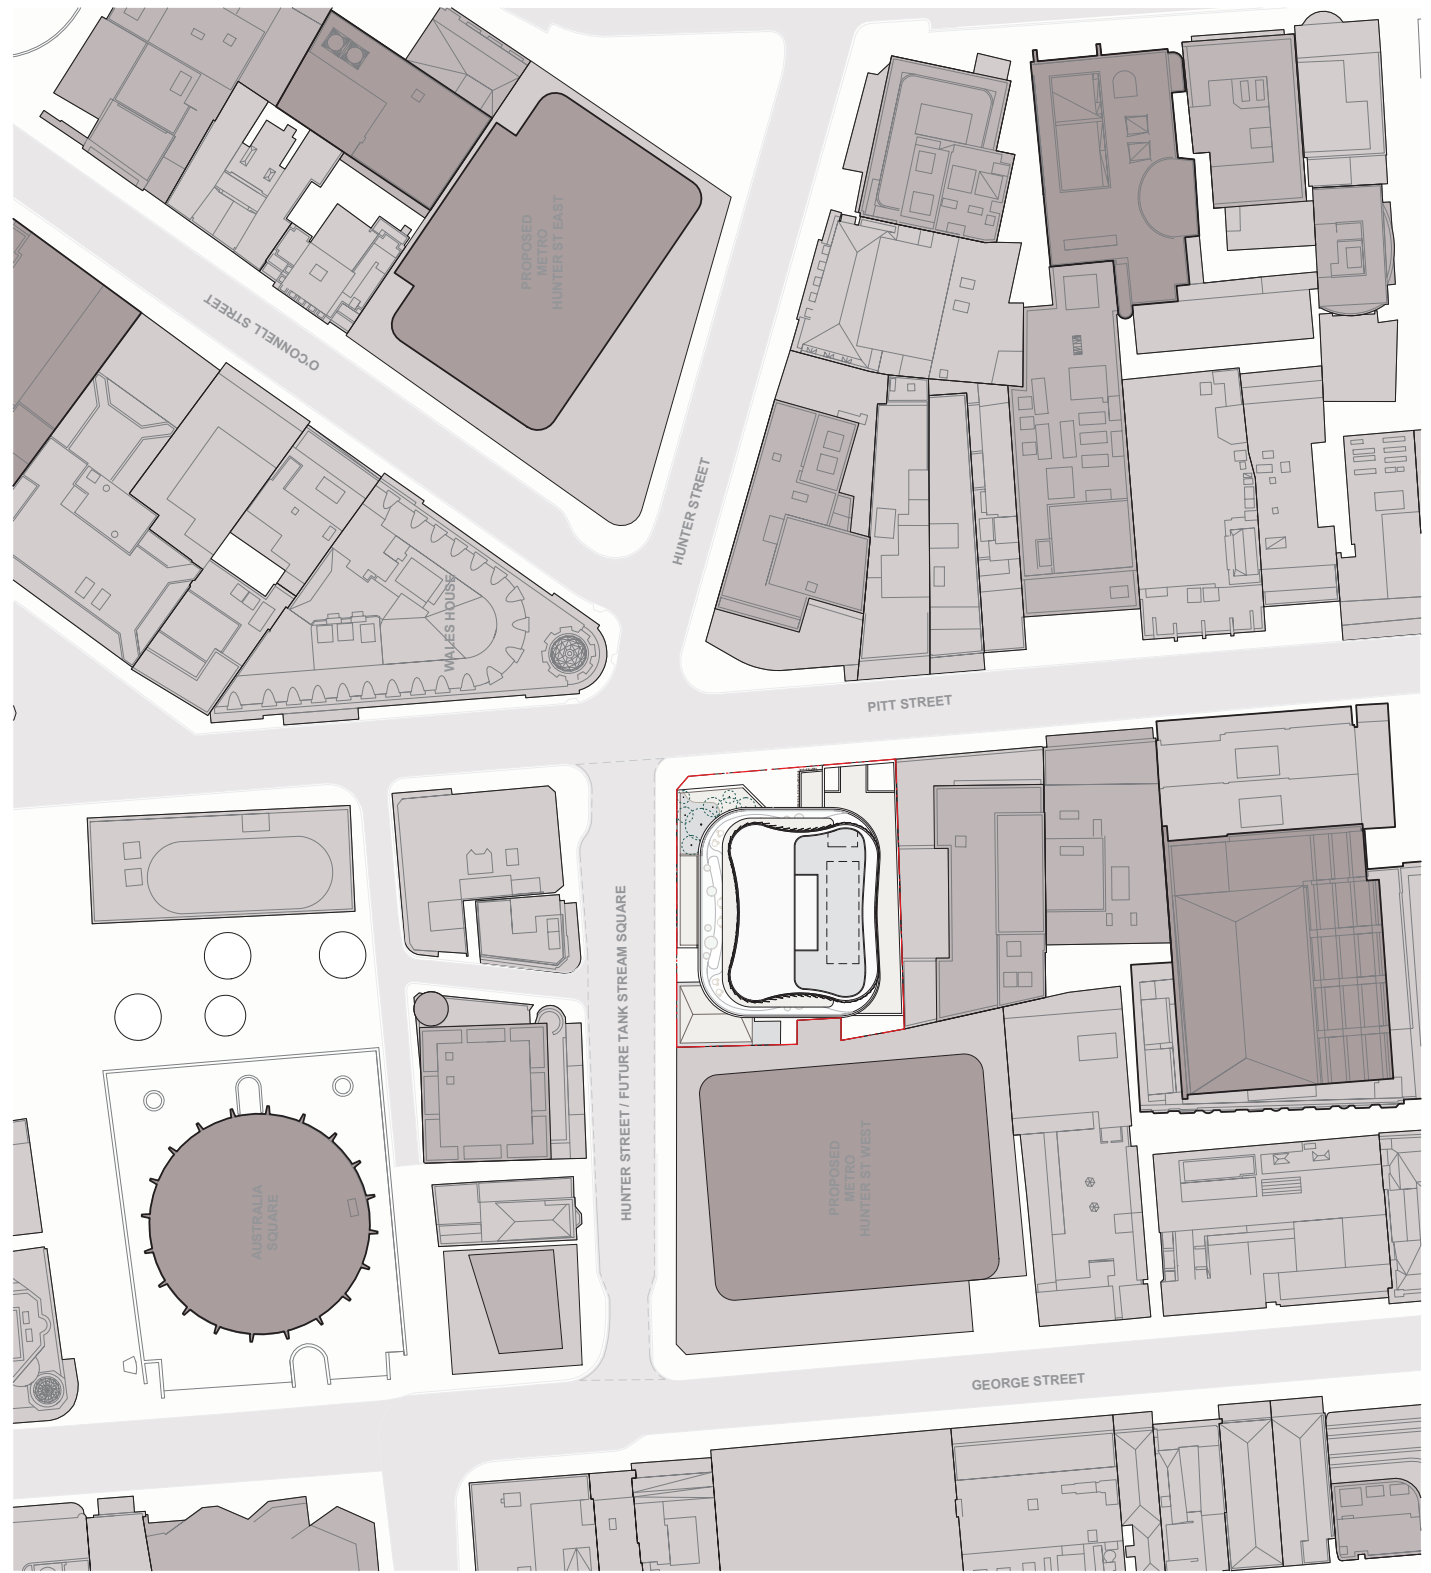

Check all dimensions and site conditions prior to commencement of any work. The contractor shall be responsible for ensuring that the proposed easement is in accordance with the relevant legislation and that the easement is properly registered. Do not scale drawings - refer to listed dimensions only. Any discrepancies shall immediately be referred to the architect for clarification. All drawings may not be reproduced or distributed without prior permission from the architect.

| | |
|-----|--------|
| UG | 10.000 |
| U1 | 10.000 |
| U2 | 10.000 |
| U3 | 10.000 |
| U4 | 10.000 |
| U5 | 10.000 |
| U6 | 10.000 |
| U7 | 10.000 |
| U8 | 10.000 |
| U9 | 10.000 |
| U10 | 10.000 |
| U11 | 10.000 |
| GR | 10.000 |

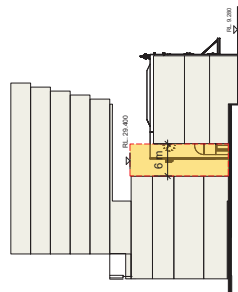

Section AA 1:500



Proposed Easement for Public Access limited in the depth to the upper surface of the finished road material and limited in height to RL 29.4

| | | | | | |
|-----|------|-------------------------------|----|---------|---------|
| A | M&P | Melbourne Retail Inc. Council | JB | DB | Checked |
| Rev | Date | Description | By | Initial | Checked |


Hunter & Pitt



Proposed Easement Plan

| | | | |
|-------------|-------------------------|---------|---------|
| Status | Development Application | | |
| Scale | As indicated @ A1 | | |
| Drawn | Author | Checked | Checker |
| Project No. | S12333A | | |
| Plot Date | 2005/08/11 05:14:44 | | |
| BIT | | | |

| | |
|---|--|
| Drawing No. | Revision |
| A01.002 | A |
| Melbourne 1 Nicholson Street Melbourne VIC 3000 Australia Phone: +61 (0)3 9493 9000 Email: info@batesmart.com.au http://www.batesmart.com.au | Sydney 43 Brisbane Street Sydney NSW 2010 Australia Phone: +61 (0)2 9493 9000 Email: info@batesmart.com.au http://www.batesmart.com.au |
| Bates Smart Architects Pty Ltd ABN 68 094 740 588 100 Waterloo Road, Sydney NSW 2000 Copyright © Bates Smart Architects Pty Ltd 2005. All Rights Reserved. | |

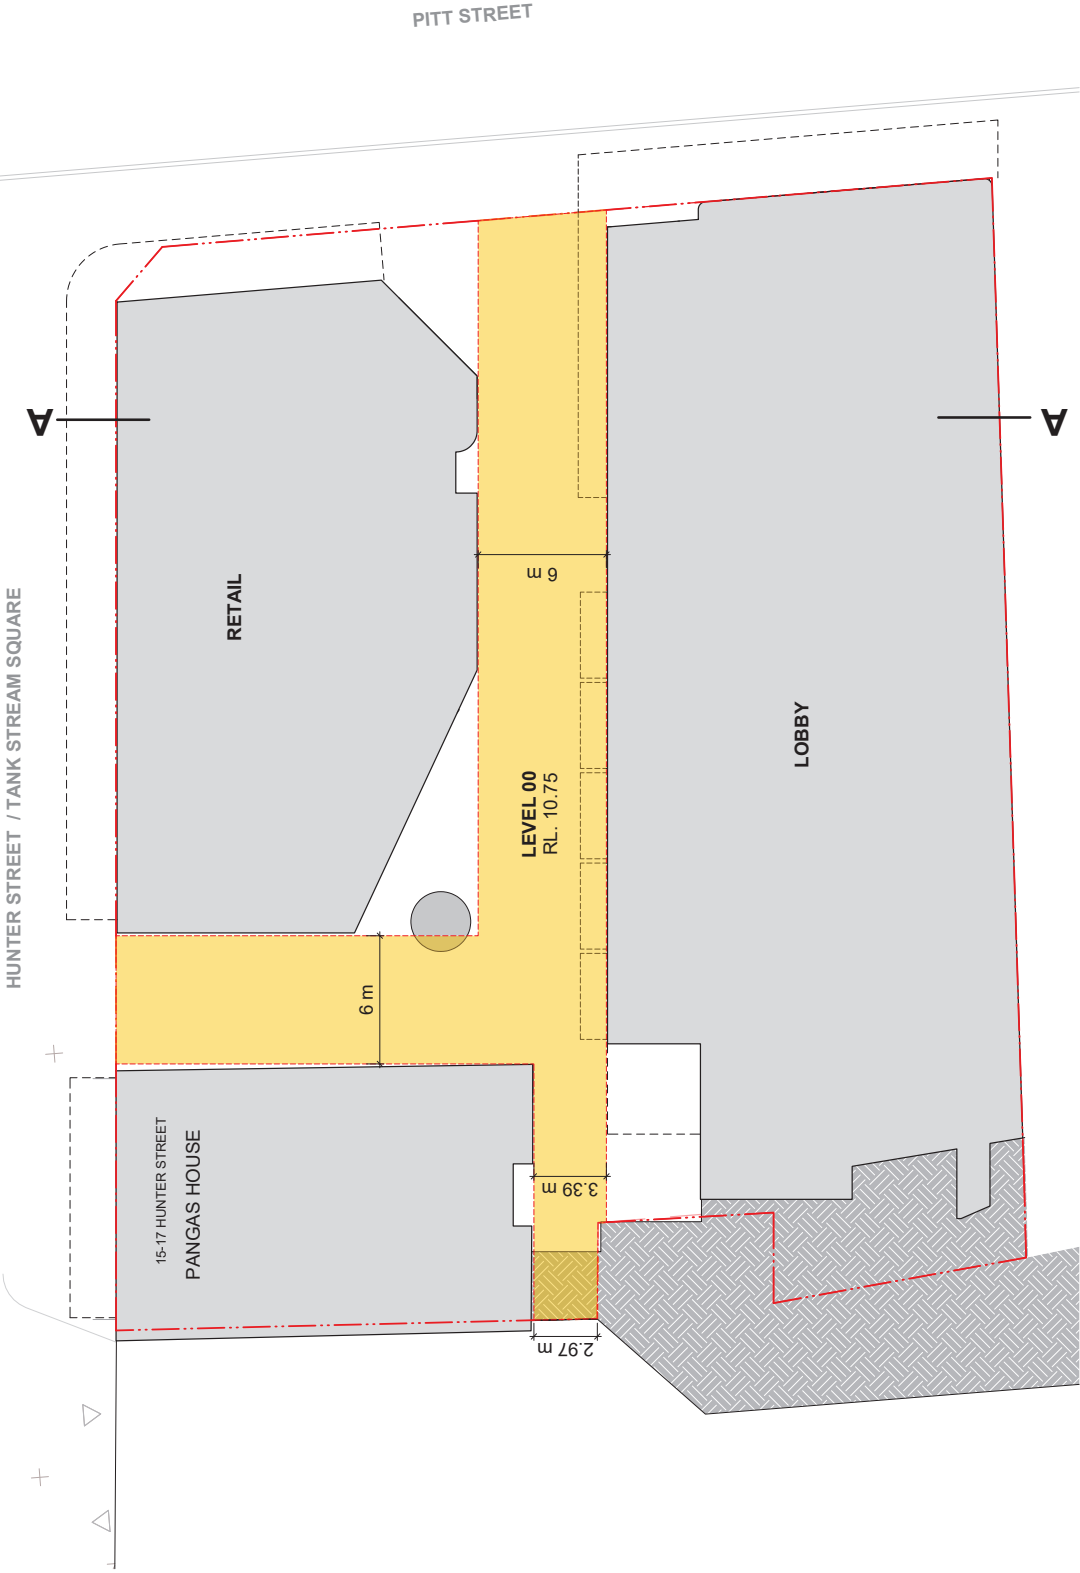

1 LEVEL 00 Easment Plan 1:125

Check all dimensions and site conditions prior to commencement of any work. The contractor shall be responsible for the accuracy of the information provided and the contractor shall be responsible for the accuracy of the information provided. Do not scale drawings - refer to listed dimensions only. Any discrepancies shall immediately be referred to the architect for clarification. All drawings may not be reproduced or distributed without prior permission from the architect.

Legend

-  To be demolished
-  To be demolished and rebuilt
-  To be retained

| Rev | Desc | By | Appr | Date |
|-----|---|----|------|------|
| 1 | 24/01/24: DA Response to RFP from Council | JB | DB | |
| 2 | 04/02/24: Design | JB | DB | |


Hunter & Pitt

Pangas House - Demolition plans

| | |
|-------------|-------------------------|
| Status | Development Application |
| Scale | 1:100 @ A1 |
| Drawn | ET/BCO |
| Checked | DS |
| Project No. | ST2335A |
| Proj. Date | 2002/03/11 02:24:44 |

| | |
|---|----------|
| Drawing No. | Revision |
| A02.100 | B |
| Melbourne 1 Nicholson Street Sydney NSW 2010 Australia Phone: +61 (0)2 9230 3000 Fax: +61 (0)2 9230 3001 Email: info@batesmart.com.au http://www.batesmart.com.au | |
| Bates Smart Architects Pty Ltd ABN: 68 094 740 888 10/11 Market Street, Melbourne VIC 3000 Australia Phone: +61 (0)3 9230 3000 Fax: +61 (0)3 9230 3001 Email: info@batesmart.com.au http://www.batesmart.com.au | |

BATESMART

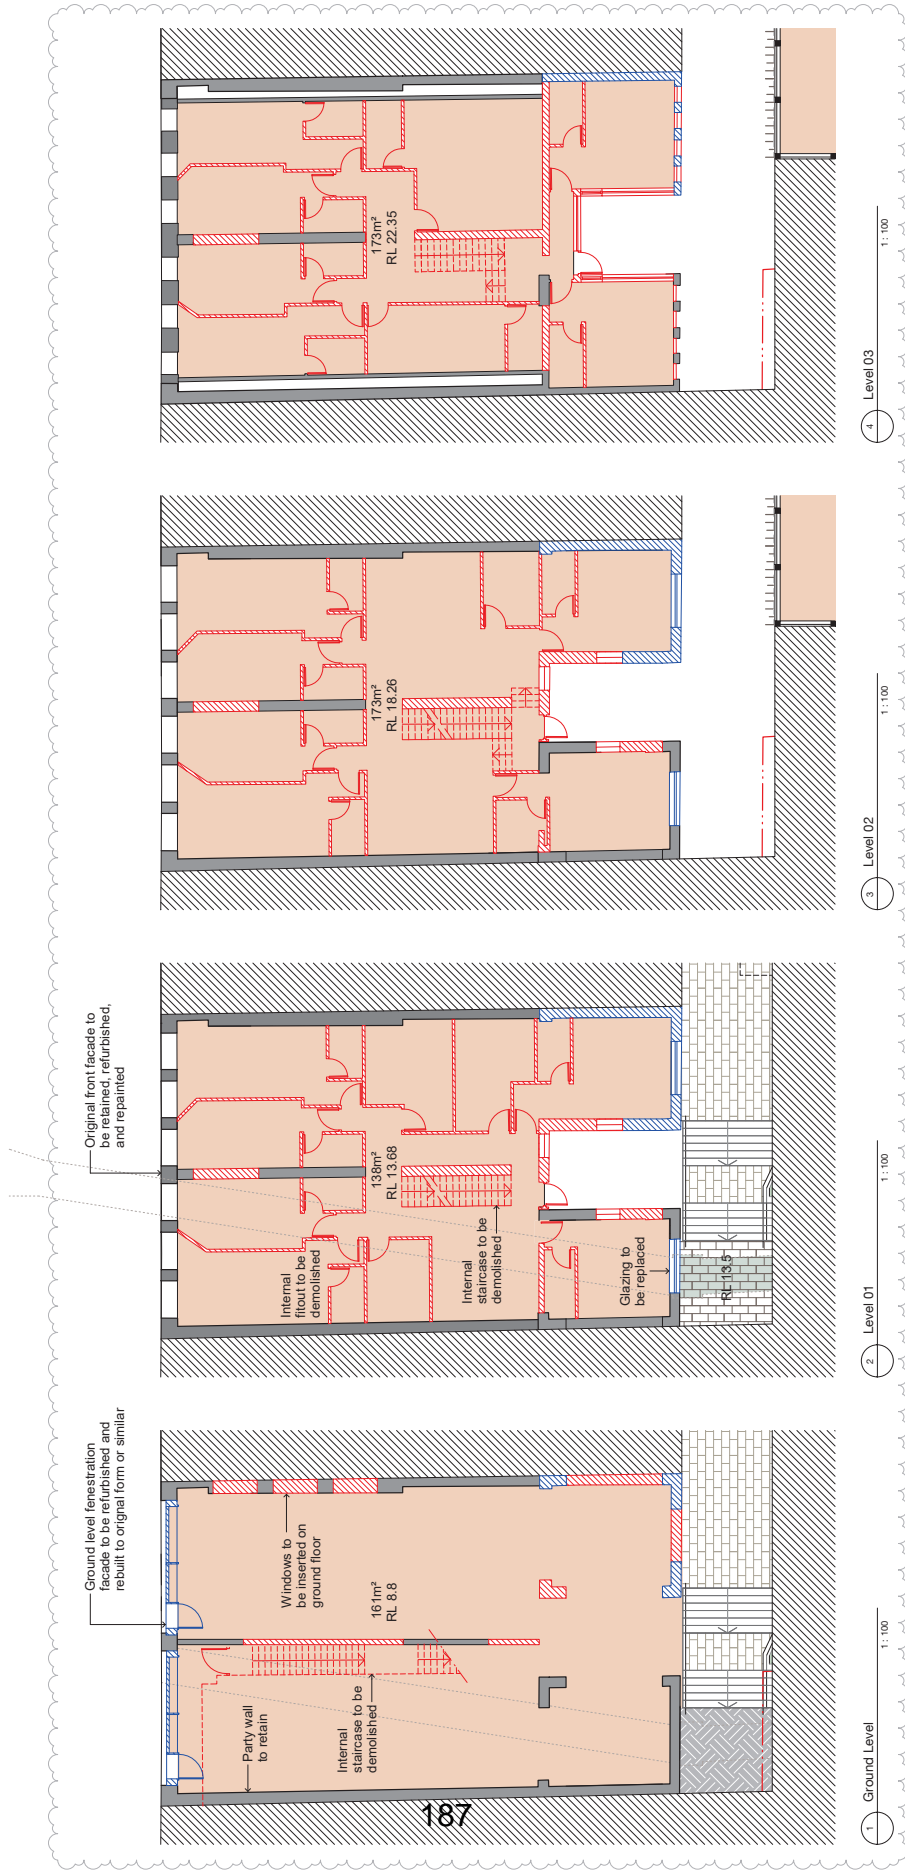

Check all dimensions and site conditions prior to commencement of any work. Any increase or reduction of dimensions or materials, or any change to the design or construction, must be approved in writing by the Council. Do not make changes to the design or construction without the written approval of the Council. All drawings may not be reproduced or distributed without prior permission from the architect.

Legend
 Existing walls
 New walls

| Rev | Date | Description | By | CS | Checked |
|-----|----------|-------------------------------|----|----|---------|
| A | 20/03/22 | DA Response to Refuse Council | | | |

Hunter & Pitt




Pangas House - Plans

| | |
|----------------|-------------------------|
| Status | Development Application |
| Scale | 1:100 @ A1 |
| Drawn | BY/BCO Checked DS |
| Project No. | S172353.A |
| Plot Code | 23022028 @ 1:250 AM |
| BM | |
| Drawing No. | Revision |
| A02.200 | A |


Melbourne 1 Nicholson Street
 Sydney Hills NSW 2016 Australia
 Phone: +61 (0)2 9550 2000
 Email: info@batesmart.com.au
 http://www.batesmart.com.au

Bates Smart Architects Pty Ltd ABN 68 094 740 588
 100 Victoria Road, Sydney Hills NSW 2016 Australia
 Phone: +61 (0)2 9550 2000
 Email: info@batesmart.com.au
 http://www.batesmart.com.au

BATESMART™

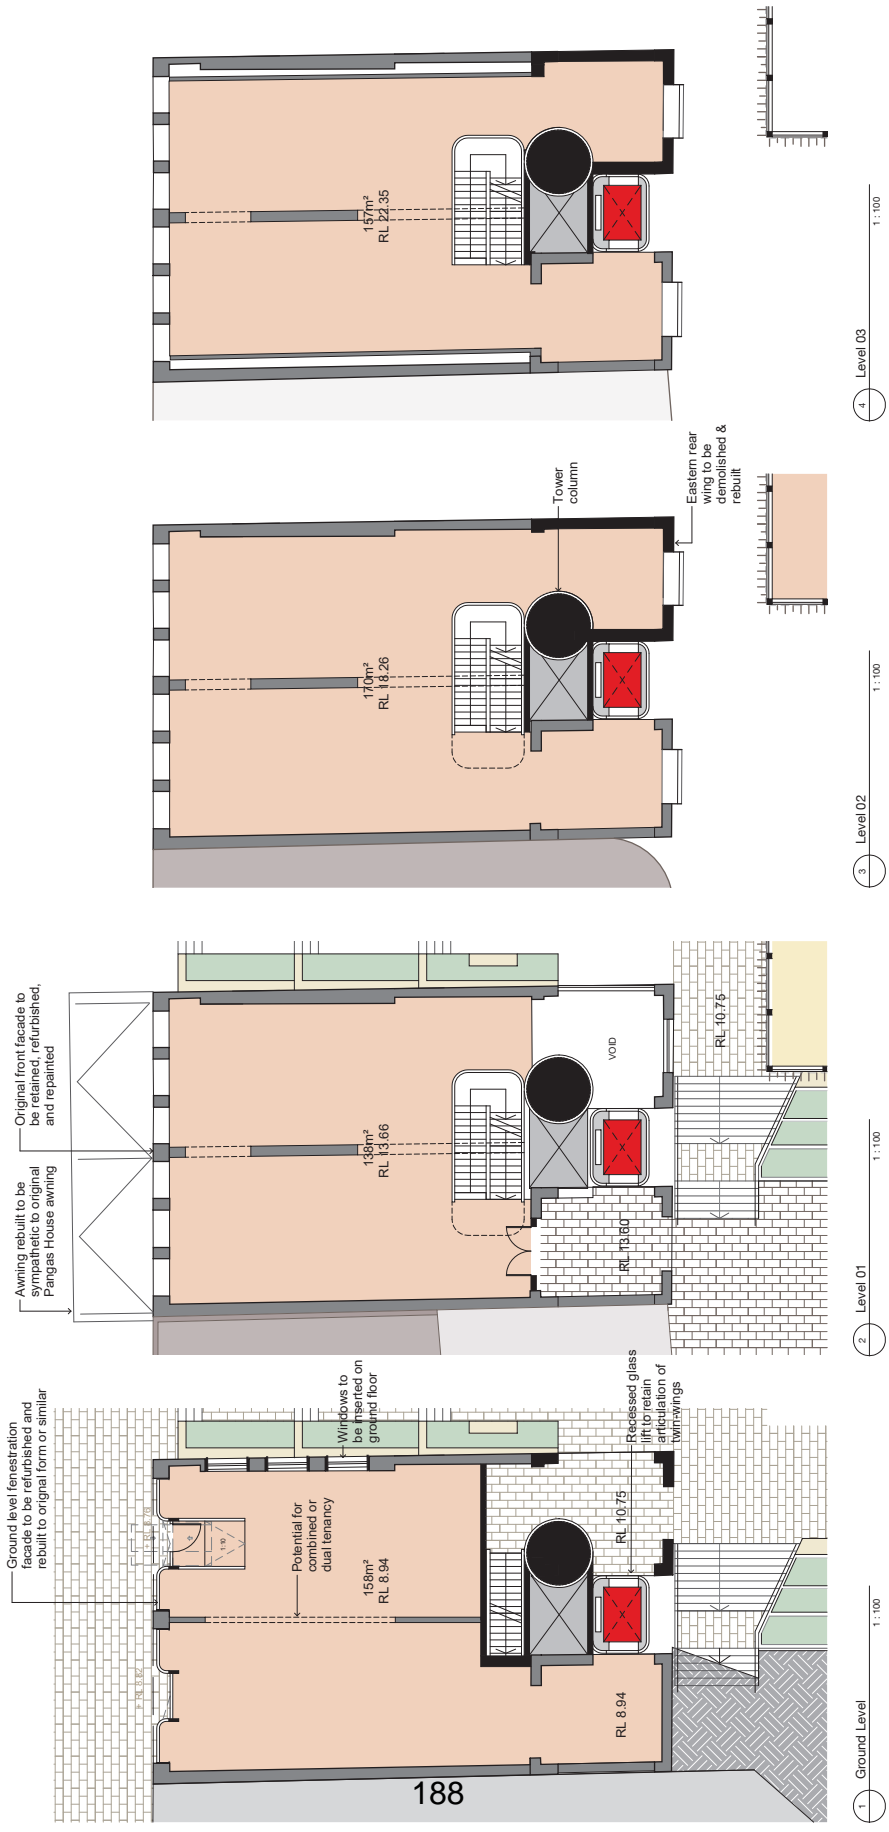

Check all dimensions and site conditions prior to commencement of any work. The contractor shall be responsible for ensuring that the proposed work is in accordance with the relevant codes of practice and standards. The contractor shall be responsible for ensuring that the proposed work is in accordance with the relevant codes of practice and standards. The contractor shall be responsible for ensuring that the proposed work is in accordance with the relevant codes of practice and standards.

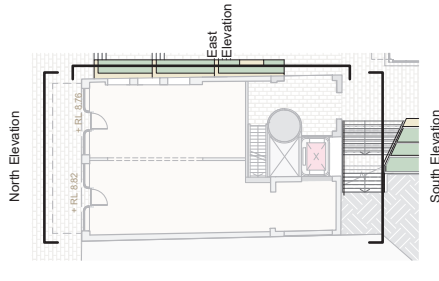

| | | | |
|--------|------------|---------|----------|
| Author | M. Smith | Checked | J. Smith |
| Date | 11/02/2024 | Initial | JS |
| Drawn | M. Smith | Drawn | JS |


Hunter & Pitt

Pangas House - Elevations & Finishes

| | |
|------------------|-------------------------|
| Status | Development Application |
| Scale | As indicated @ A1 |
| Drawn | ET/BCO |
| Project No. | S12333A |
| Rev. Date | 20052024 11:02:24AM |
| Rev. Description | |
| Rev. Initial | |

A02.201 Revision **A**



Bates Smart Architects Pty Ltd ABN 68 094 740 888
 10/101 Market Street, Sydney NSW 2010
 Sydney NSW 2010 Australia
 Phone: +61 (0)2 9231 1111
 Email: info@batesmart.com.au
 Website: http://www.batesmart.com.au

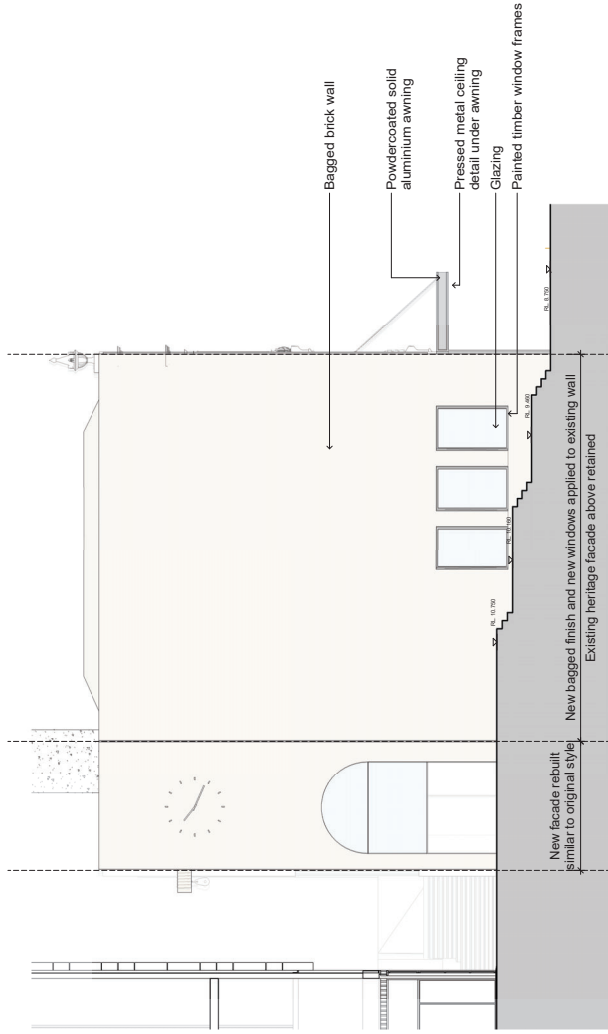


BB East Elevation - Pangas House 1:100

Pangas House Finishes:

1. Painted rendered facade - sandstone colour, with heritage highlights
2. Bagged brick wall - Colour to match front facade
3. Glazing
4. Painted timber doors, ground facade detailing, and window frames
5. Powdercoated solid aluminium metal detailing and awning
6. Pressed metal ceiling detail under awning

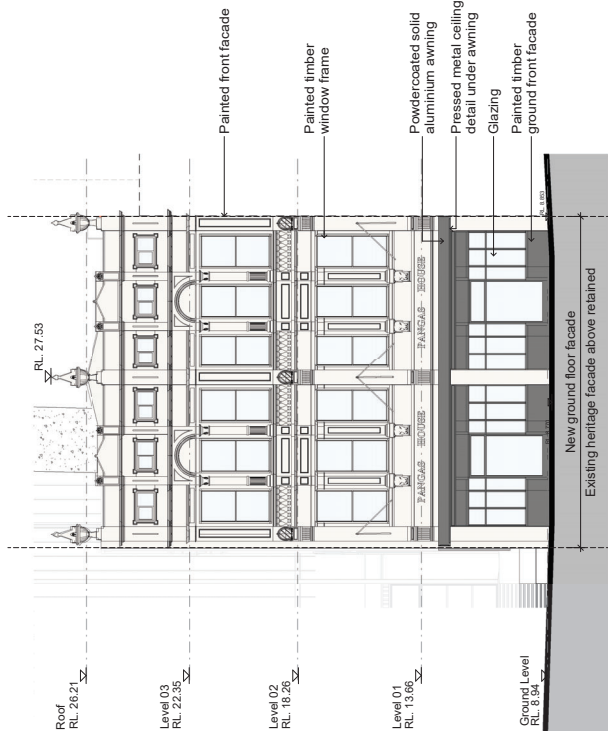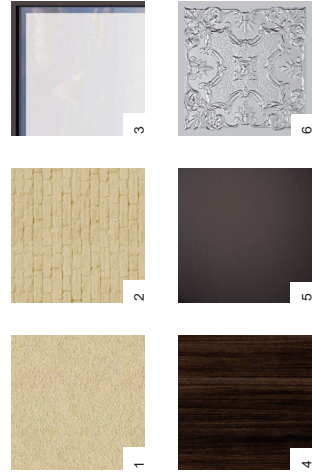


AA North Elevation - Pangas House 1:100

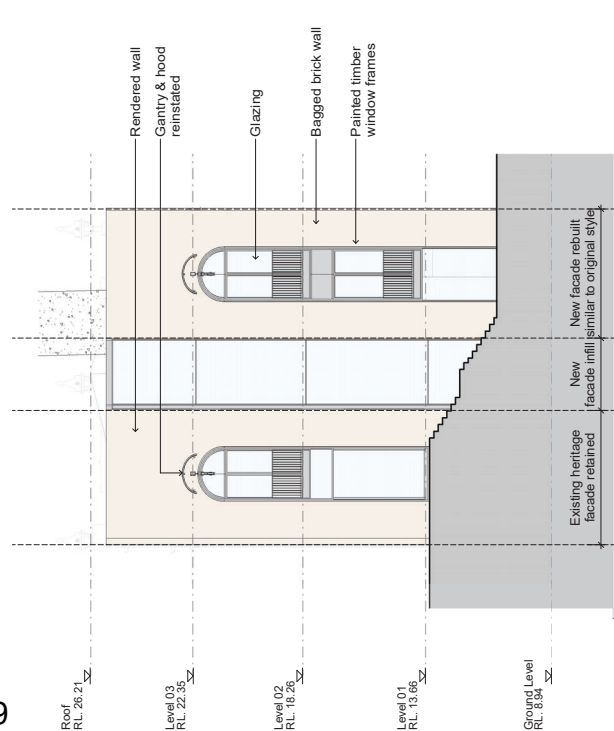


CC South Elevation - Pangas House 1:100

Check all dimensions and site conditions prior to commencement of any work. The contractor shall be responsible for ensuring that the proposed work is in accordance with the relevant codes of practice and standards. The contractor shall be responsible for ensuring that the proposed work is in accordance with the relevant codes of practice and standards. The contractor shall be responsible for ensuring that the proposed work is in accordance with the relevant codes of practice and standards.

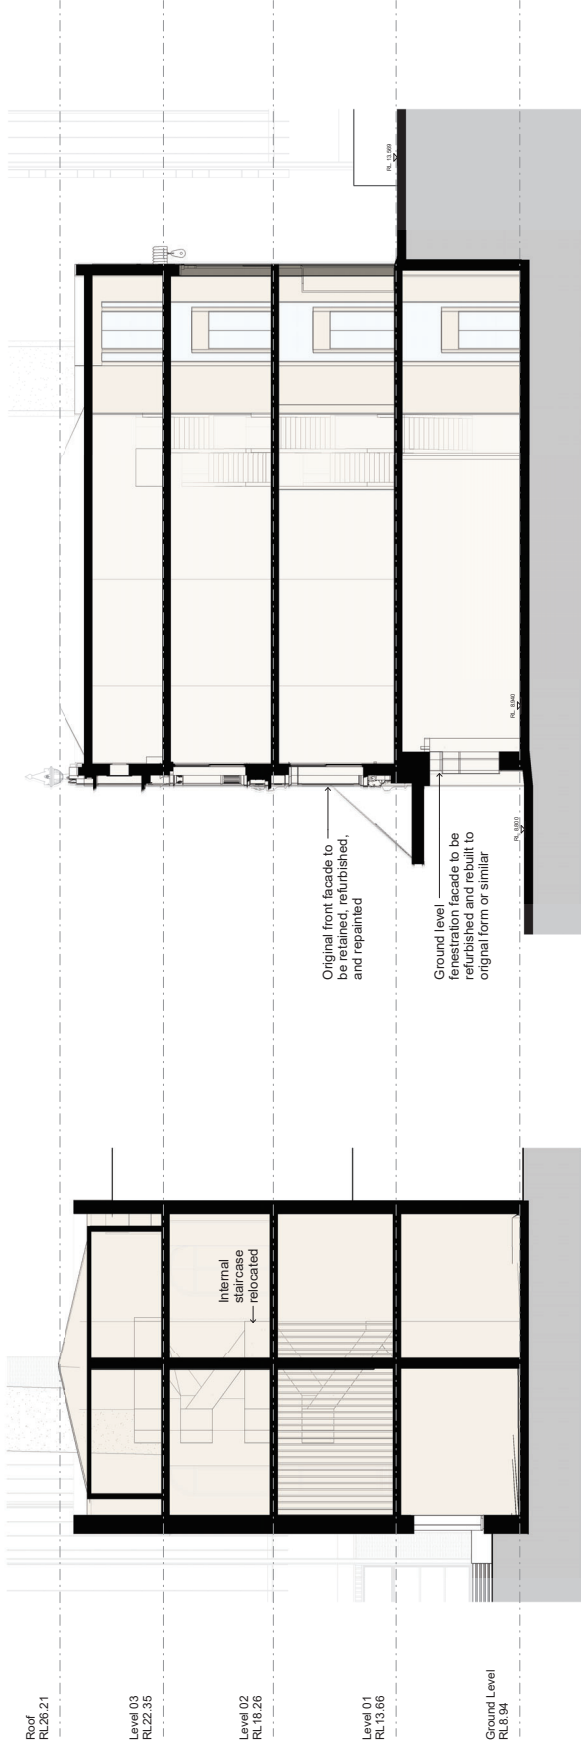


AA Section AA - Pangas House 1:100

CC Section CC - Pangas House 1:100

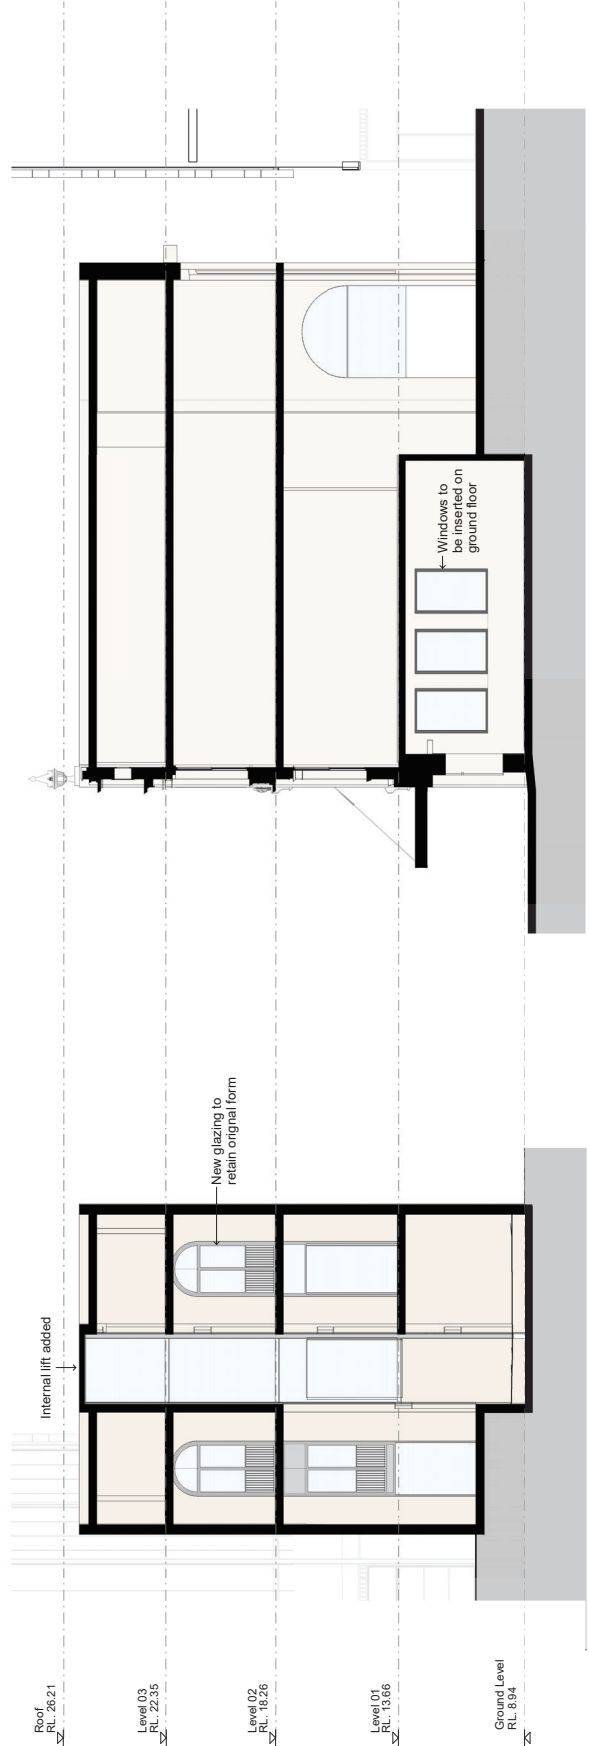

BB Section BB - Pangas House 1:100

DD Section DD - Pangas House 1:100

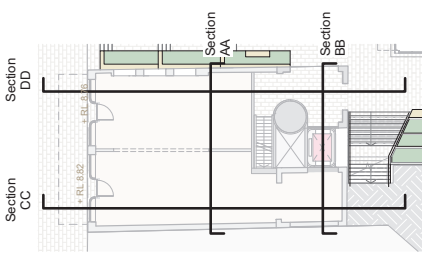

| Rev | Date | Description | By | Chk |
|-----|------------|-------------|----|-----|
| A | 10/01/2023 | Initial | ML | DS |

Hunter & Pitt

Pangas House - Sections

| | |
|-------------|-------------------------|
| Status | Development Application |
| Scale | As indicated @ A1 |
| Drawn | ET/BCO |
| Checked | DS |
| Project No. | S173352A |
| Plot Date | 20022021 11:48:06 AM |
| Rev | |
| Revision | |

A02.202 A

Bates Smart Architects Pty Ltd ABN 68 094 740 888
 10/111 Market Street, Sydney NSW 2011
 Sydney NSW 2011 Australia
 Phone: +61 (0)2 9231 1111
 Email: info@batesmart.com.au
 http://www.batesmart.com.au

Check all dimensions and site conditions prior to commencement of any work. Any provision or omission of any item shall be the responsibility of the client. Do not scale drawings. Refer to final dimensions only. Any discrepancies shall immediately be referred to the architect for clarification. All drawings may not be reproduced or distributed without prior permission from the architect.

CAR SPACES

CAR STACKER (7 levels) 41


MOTORCYCLE SPACES

(B01) 3

SERVICE VEHICLES

COURIER SPACES (B01) 3

SRV (B01) 3

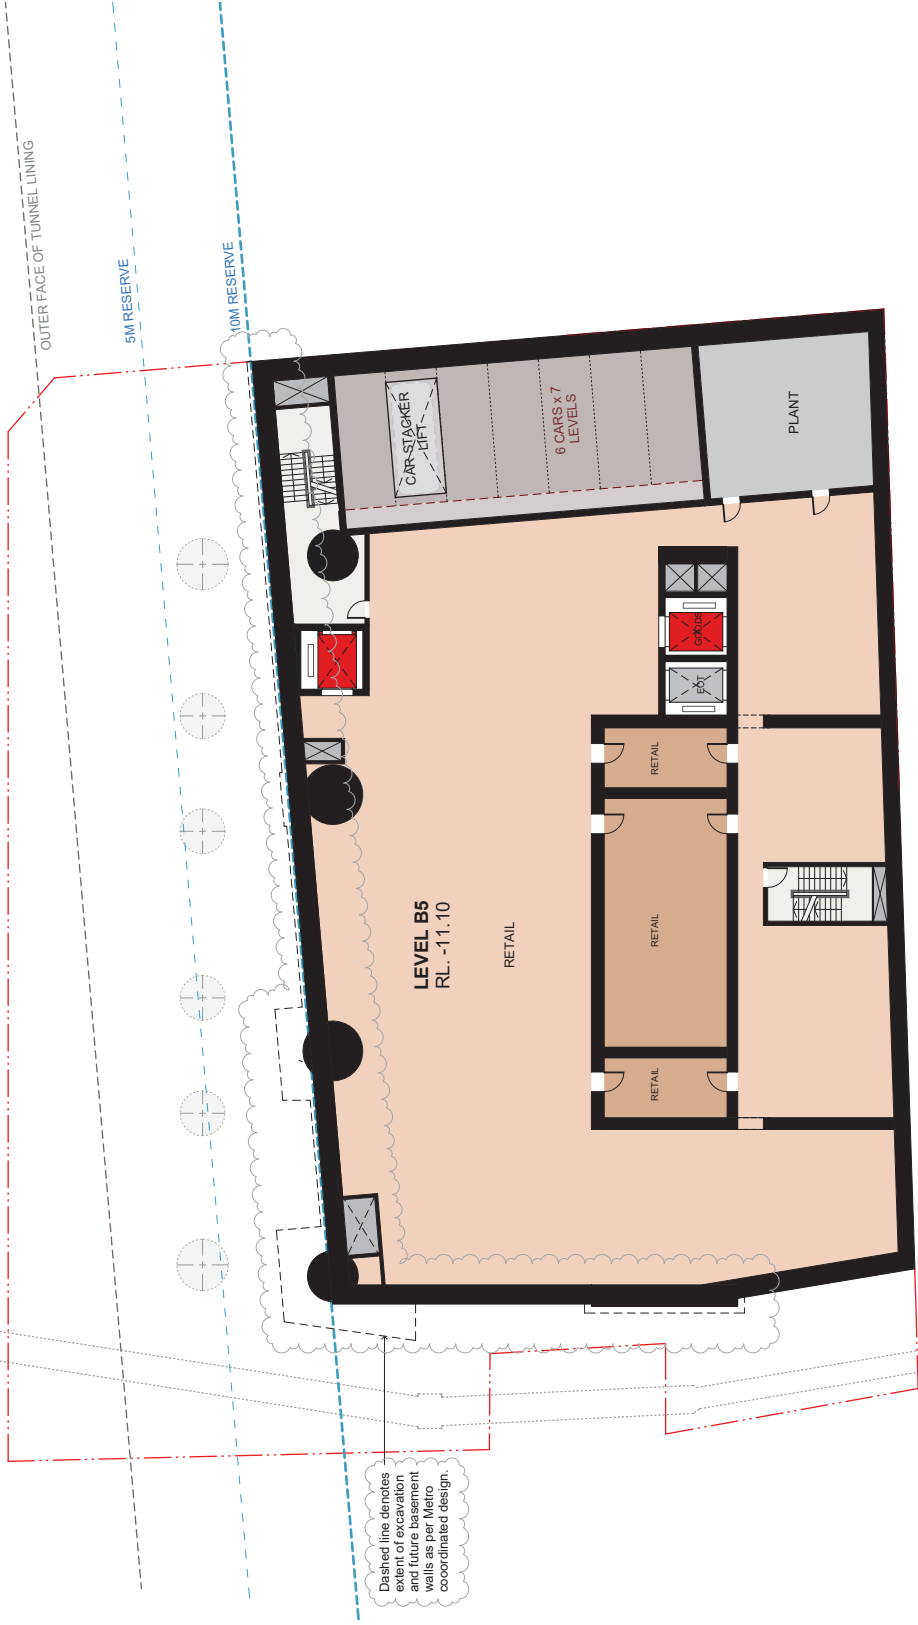

Dashed line denotes extent of excavation and future basement walls as per Metro coordinated design.

General note: Internal basement extent subject to design development of structural walls and selection of waterproofing system.

| Rev | Date | Description | By | DR | Check |
|-----|----------|-----------------------------------|----|----|-------|
| 1 | 24/05/24 | GA Response to RPI Review Comment | JB | DR | |
| | | | JB | DR | |
| | | | JB | DR | |

Hunter & Pitt

GA Plan
Basement 05



| | |
|---------------|-------------------------|
| Status | Development Application |
| Scale | 1:125 @ A1 |
| Drawn | AT |
| Checked | DS |
| Project No. | S12353.A |
| Rev. Ed. Date | 23/05/2024 11:01:00 AM |
| BM | |

A03.0B5

B

Melbourne 1 Nicholson Street
Sydney NSW 2010, Australia
Phone: +61 (0)2 9230 9000
Email: info@batesmart.com.au
http://www.batesmart.com.au

Bates Smart Architects Pty Ltd ABN: 68 094 740 586
100 Victoria Road, St Albans, Victoria 3023, Australia
VVIC Reg: 6098 / 1

Check all dimensions and site conditions prior to commencement of any work. Any provision or condition of any instrument, code, plan, specification or approval, or any other authority, shall be observed and complied with. Do not scale drawings. Refer to final dimensions only. Any discrepancies shall immediately be referred to the architect for clarification. All drawings may not be reproduced or distributed without prior permission from the architect.

CAR SPACES

CAR STACKER (7 levels) 41


MOTORCYCLE SPACES

(B01) 3

SERVICE VEHICLES

COURIER SPACES (B01) 3

SRV (B01) 3

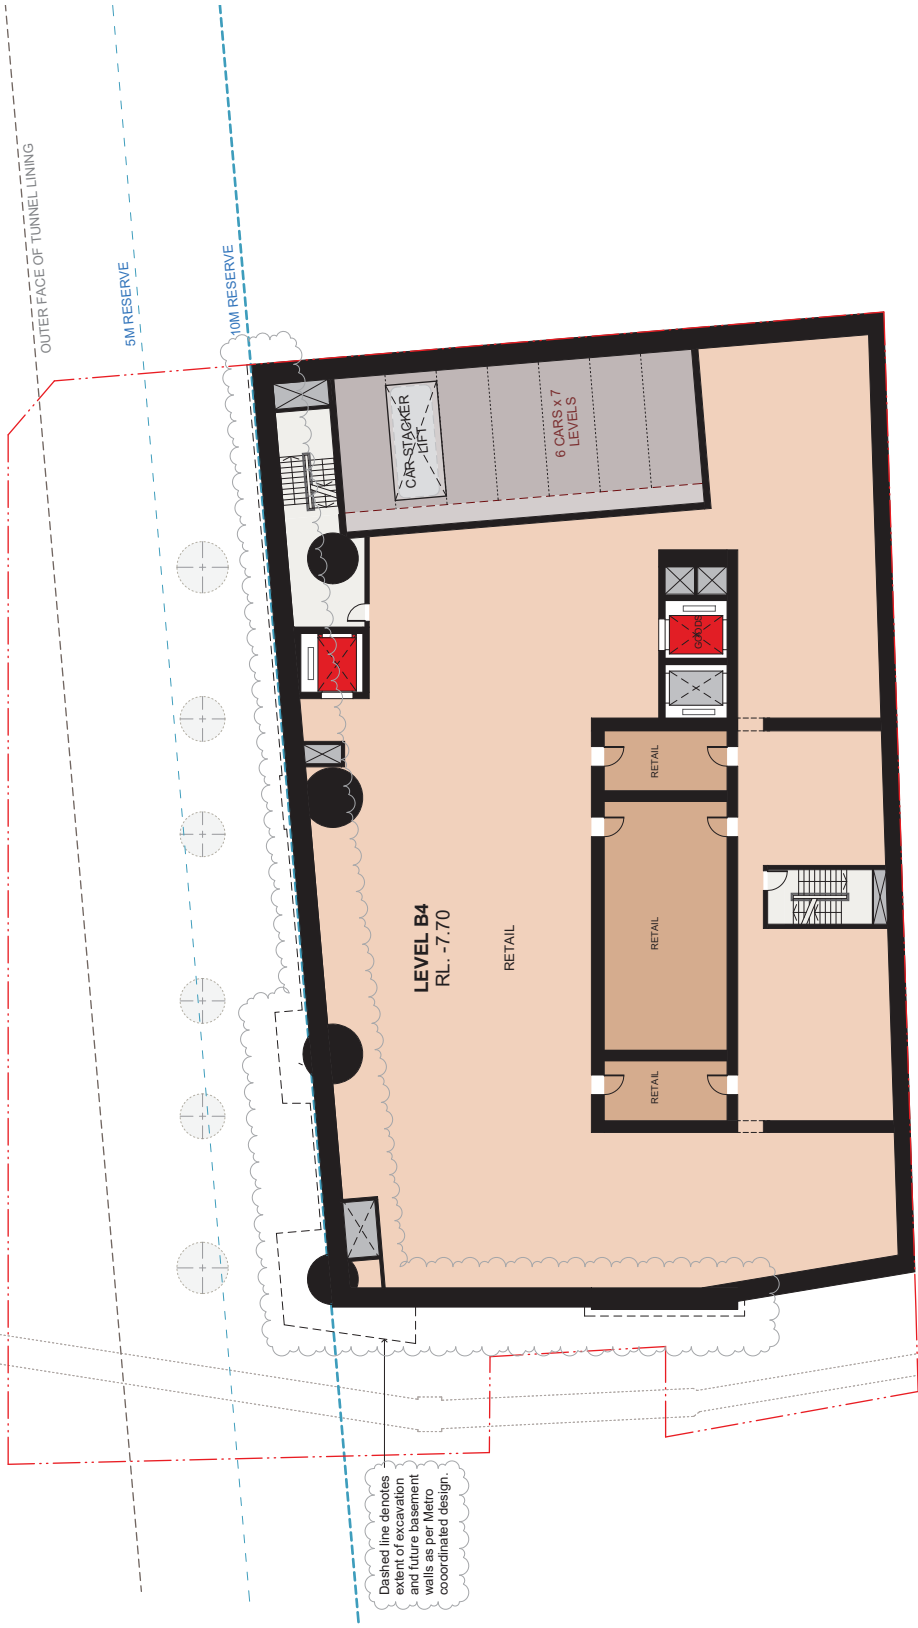

Dashed line denotes extent of excavation and future basement walls as per Metro coordinated design.

General note: Internal basement extent subject to design development of structural walls and selection of waterproofing system.

| Rev | Date | Description | By | DR | Check |
|-----|----------|-----------------------------------|----|----|-------|
| B | 24/05/18 | GA Response to RPI Review Comment | | | |
| | | | | | |
| | | | | | |
| | | | | | |

Hunter & Pitt

GA Plan
Basement 04



| | |
|---------------|-------------------------|
| Status | Development Application |
| Scale | 1:125 @ A1 |
| Drawn | AT |
| Checked | DS |
| Project No. | S12353.A |
| Rev. Ed. Date | 23/05/2018 11:01:59 AM |
| BM | |

A03.0B4 B

Melbourne 1 Nicholson Street
Sydney NSW 2010, Australia
Phone: +61 (0)2 9230 9000
Fax: +61 (0)2 9230 9001
email: info@batesmart.com.au
http://www.batesmart.com.au

Bates Smart Architects Pty Ltd ABN 68 094 740 686
100 Victoria Road, North Sydney NSW 1585, Australia
Voting Reg 6098 / 100 Victoria Road, North Sydney NSW 1585, Australia

Check all dimensions and site conditions prior to commencement of any work. Any provision or omission of any item shall be the responsibility of the client. Do not scale drawings. Refer to final dimensions only. Any discrepancies shall immediately be referred to the architect for clarification. All drawings may not be reproduced or distributed without prior permission from the architect.

CAR SPACES

CAR STACKER (7 levels) 41


MOTORCYCLE SPACES

(B01) 3

SERVICE VEHICLES

COURIER SPACES (B01) 3

SRV (B01) 3

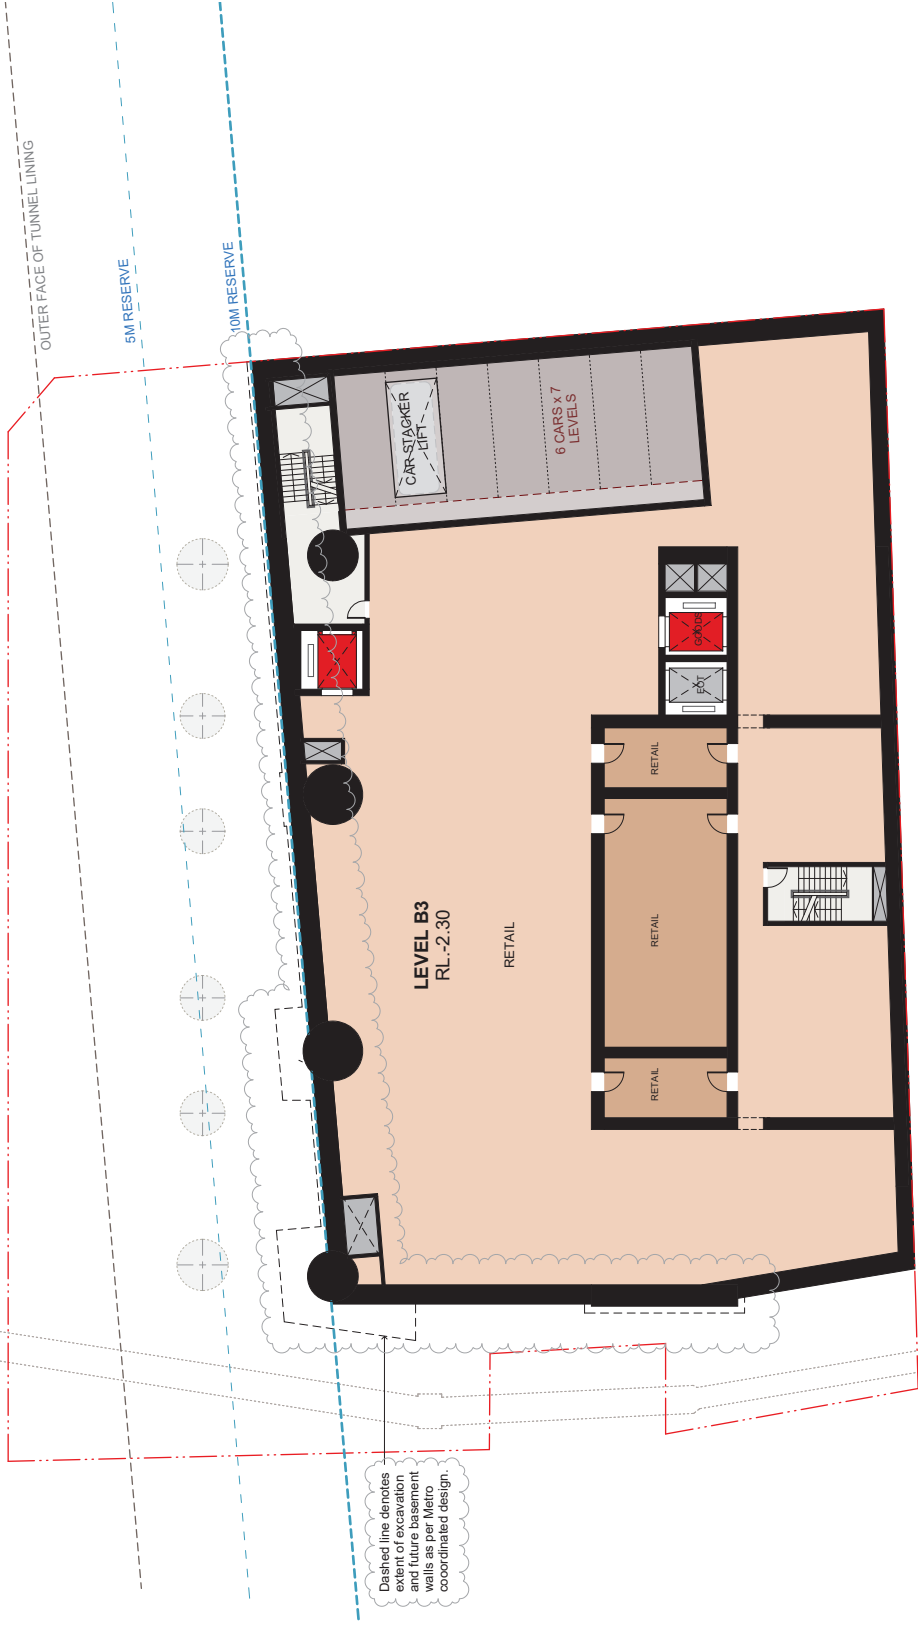

Dashed line denotes extent of excavation and future basement walls as per Metro coordinated design.

General note: Internal basement extent subject to design development of structural walls and selection of waterproofing system.

| Rev | Date | Description | By | Check |
|-----|----------|-----------------------------------|-------|---------|
| B | 24/05/18 | GA Response to RPI Review Comment | JB | DB |
| | | | Total | Checked |

Hunter & Pitt

GA Plan
Basement 03



| | |
|---------------|-------------------------|
| Status | Development Application |
| Scale | 1:125 @ A1 |
| Drawn | AT |
| Checked | DS |
| Project No. | S12353.A |
| Rev. Ed. Date | 23/05/2018 11:01:59 AM |
| BM | |

Drawing No. **A03.0B3** Revision **B**

Melbourne 1 Nicholson Street
Sydney NSW 2010, Australia
Phone: +61 (0)2 9230 9000
Fax: +61 (0)2 9230 9001
email: info@batesmart.com.au
http://www.batesmart.com.au

Bates Smart Architects Pty Ltd ABN: 68 094 740 588
100 Victoria Road, St Albans, Victoria 3021, Australia
VVIC Reg 6098 /

BATESMART

Check all dimensions and site conditions prior to commencement of any work. Any provision or condition of any instrument, code, plan, specification or approval, or any other authority, shall apply to the design and construction of the project. Do not make changes, refer to the drawings for dimensions only. Any discrepancies shall immediately be referred to the architect for clarification. All drawings may not be reproduced or distributed without prior permission from the architect.

- CAR SPACES**
- CAR STACKER (7 levels) 41
- MOTORCYCLE SPACES (B01) 3
- SERVICE VEHICLES**
- COURIER SPACES (B01) 3
- SRV (B01) 3

| Rev | Date | Description | By | DR | Check |
|-----|----------|-------------------------------|-------|---------|-------|
| B | 24/05/24 | GA Response to RPI Flow Cover | JB | DR | |
| | | | Total | Checked | |

Hunter & Pitt


GA Plan
Basement 02



| | |
|----------------|-------------------------|
| Status | Development Application |
| Scale | 1:125 @ A1 |
| Drawn | AT |
| Checked | DS |
| Project No. | S12353.A |
| RPI ID No. | 23022048 1 1014 RM |
| BM | |
| Drawing No. | Revision |
| A03.0B2 | B |

Melbourne 1 Nicholson Street
Sydney NSW 2010, Australia
Phone: +61 (0)2 9230 9200
Email: info@batesmart.com.au
http://www.batesmart.com.au

Bates Smart Architects Pty Ltd ABN 68 094 740 586
100 Victoria Street, Suite 1000, Sydney NSW 2010, Australia
Voting Reg 6098 / 1

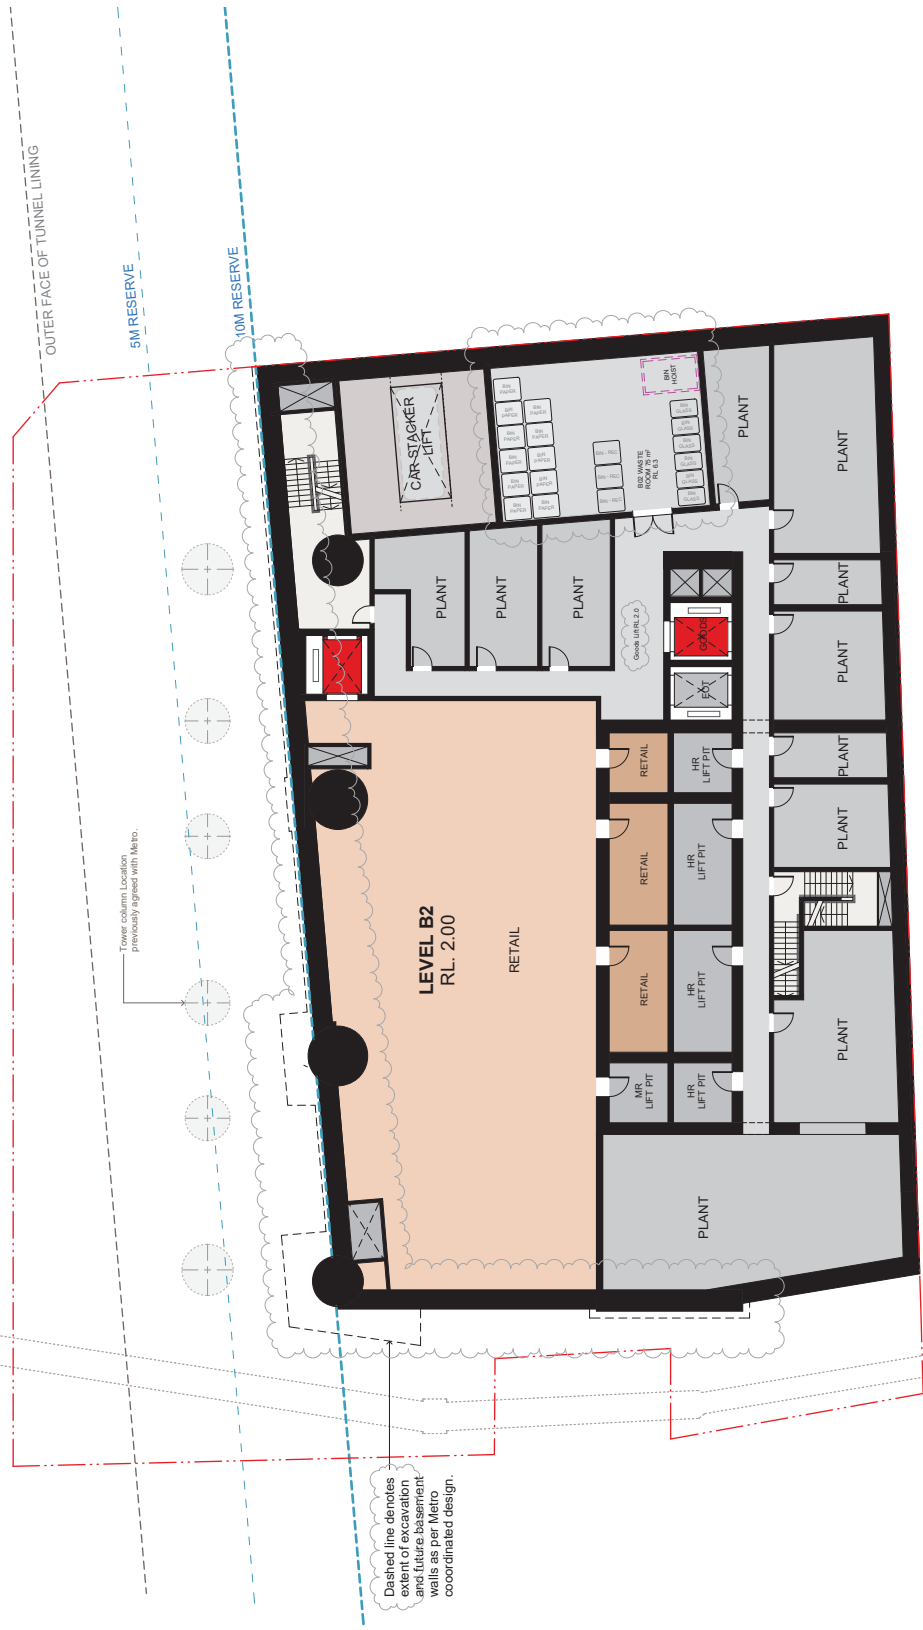

Dashed line denotes extent of excavation and future basement walls as per Metro coordinated design.

General note: Internal basement extent subject to design development of structural walls and selection of waterproofing system.

Check all dimensions and site conditions prior to commencement of any work. Any provision or omission of any item or detail is the responsibility of the client. Do not scale drawings - refer to stated dimensions only. Any discrepancies that immediately be referred to the architect. All drawings may not be reproduced or distributed without prior permission from the architect.

- CAR SPACES
- CAR STACKER (7 levels) 41
- MOTORCYCLE SPACES (B01) 3
- SERVICE VEHICLES
- COURIER SPACES (B01) 11
- SRV (B01) 3



General note: Internal basement extent subject to design development of structural walls and selection of waterproofing system.

| Rev | Desc | Author | Check | Date |
|-----|------------------------|--------|-------|----------|
| 1 | Issue for Tender | GA | GA | 08/08/20 |
| 2 | Issue for Construction | GA | GA | 08/08/20 |

Hunter & Pitt
 GA Plan
 Basement 01



| | |
|-------------|-------------------|
| Scale | 1:125 @ A1 |
| Drawn | AT |
| Checked | DS |
| Project No. | S12353.A |
| Rev. Date | 30/08/20 10:20 AM |
| Rev. No. | 01 |

A03.0B1 C

Bates Smart Architects Pty Ltd
 1 Nicholson Street
 Melbourne VIC 3000 Australia
 Tel: +61 (0)3 9493 1000
 Email: info@batesmart.com.au
 http://www.batesmart.com.au

Check all dimensions and site conditions prior to commencement of any work. The contractor shall be responsible for the accuracy of the information provided and the contractor shall be responsible for the accuracy of the information provided. Do not scale drawings - refer to listed dimensions only. Any discrepancies shall immediately be referred to the architect for clarification. All drawings may not be reproduced or distributed without prior permission from the architect.

| Rev | Desc | Drawn | Checked | Initial | Date |
|-----|---|-------|---------|---------|------|
| 1 | 24/01/24: GA Response to RFP from Council | | | | |
| | | | | | |

Hunter & Pitt


GA Plan
Level Lobby
Preferred Lobby Interface to Metro

| | |
|-------------|-------------------------|
| Status | Development Application |
| Scale | 1:125 @ A1 |
| Drawn | AT |
| Checked | DS |
| Project No. | S12333A |
| Proj. Date | 2002/04/12 12:03PM |
| Rev | |
| Revision | |


A03.001 B

Melbourne 1 Nicholson Street
Sydney Hills NSW 2010 Australia
Phone: +61 (0)2 9550 1234
email: info@batesmart.com.au
http://www.batesmart.com.au

Bates Smart Architects Pty Ltd ABN 68 094 740 888
100 Waterloo Road, Sydney NSW 2000
Copyright © 2023 Bates Smart Architects Pty Ltd

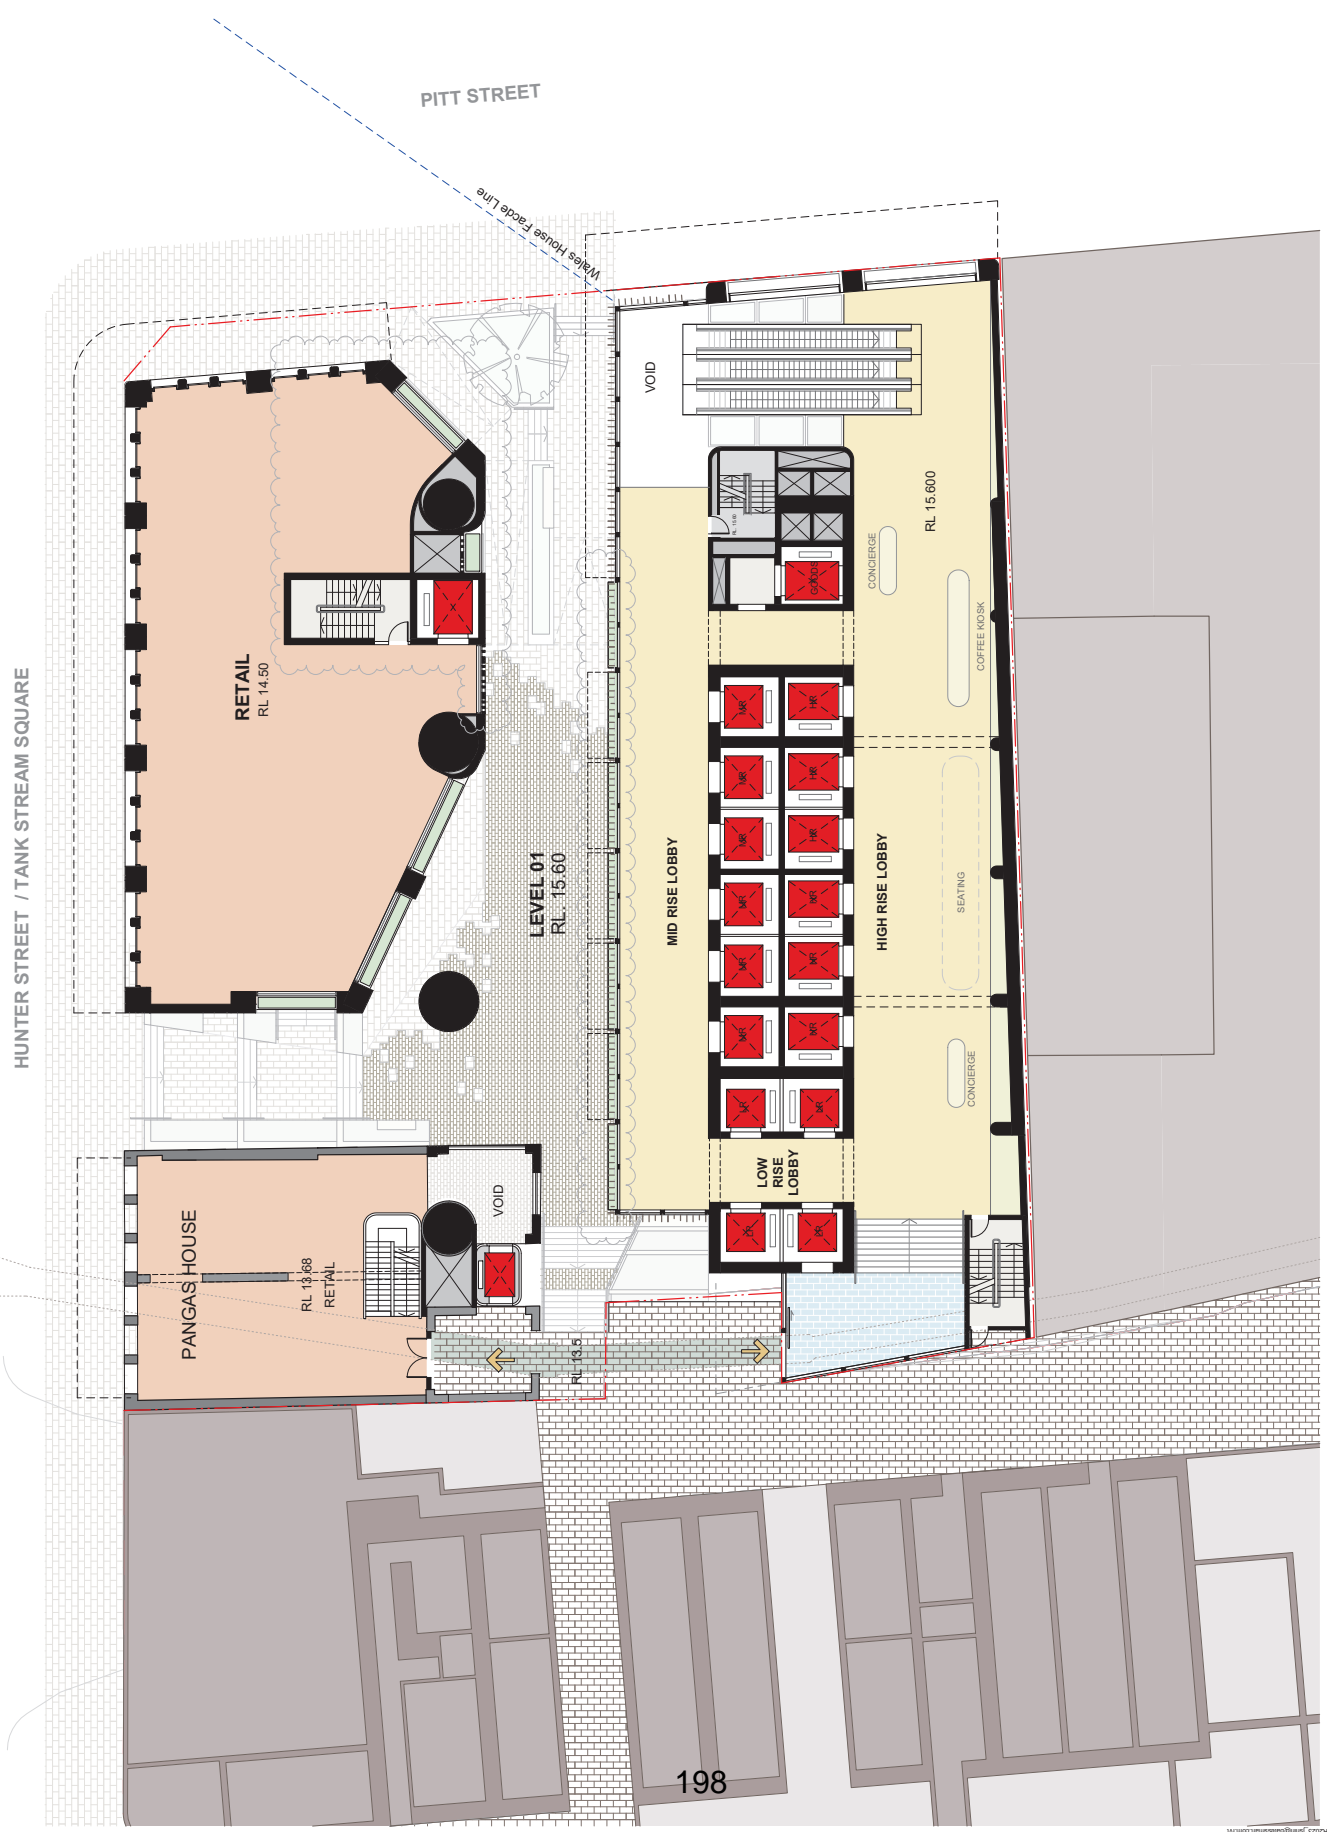

Check all dimensions and site conditions prior to commencement of any work.
 Any provision or omission of any material, work, plant, equipment or equipment
 shall be the responsibility of the contractor. The contractor shall be responsible for
 any and all costs of any nature whatsoever. Do not scale drawings. Refer to listed dimensions only. Any discrepancies shall
 immediately be referred to the architect for clarification.
 All drawings may not be reproduced or distributed without prior permission from
 the architect.

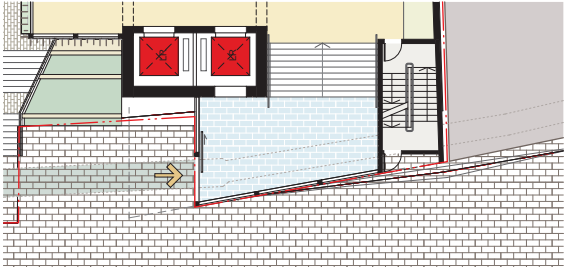

PREFERRED LOBBY TO METRO INTERFACE
 TO BE RESOLVED IN FUTURE


| Rev | Date | Description | Initial | Checked |
|-----|----------|-------------------|---------|---------|
| 0 | 24/01/21 | GA Plan - Lobby | J.S. | DS |
| 1 | 23/01/21 | REVISIONS | J.S. | DS |
| A | 23/01/21 | REQUIRED BY METRO | A.T. | DS |
| | | | | |
| | | | | |
| | | | | |

Hunter & Pitt
 GA Plan
 Level 01 Lobby
 Alternative Lobby Interface to Metro

| | | | |
|---------------|-------------------------|---------|----|
| Status | Development Application | | |
| Scale | 1:125 | @ | A1 |
| Drawn | AT | Checked | DS |
| Project No. | S12/353.A | | |
| Rev. Ed. Date | 23/01/21 10:54 AM | | |
| BIM | | | |

Drawing No. **A03.001.1** Revision
B
 Bates Smart Architects Pty Ltd
 1 Nicholson Street
 Melbourne VIC 3000 Australia
 Tel: +61 (0)3 9493 8800
 Email: info@batesmart.com.au
 http://www.batesmart.com.au
 Bates Smart Architects Pty Ltd ABN 68 094 740 988
 (Vic Planning Reg. No. 25277, Qld Planning Reg. No. 25277, Warr Reg. 698)

BATESMART


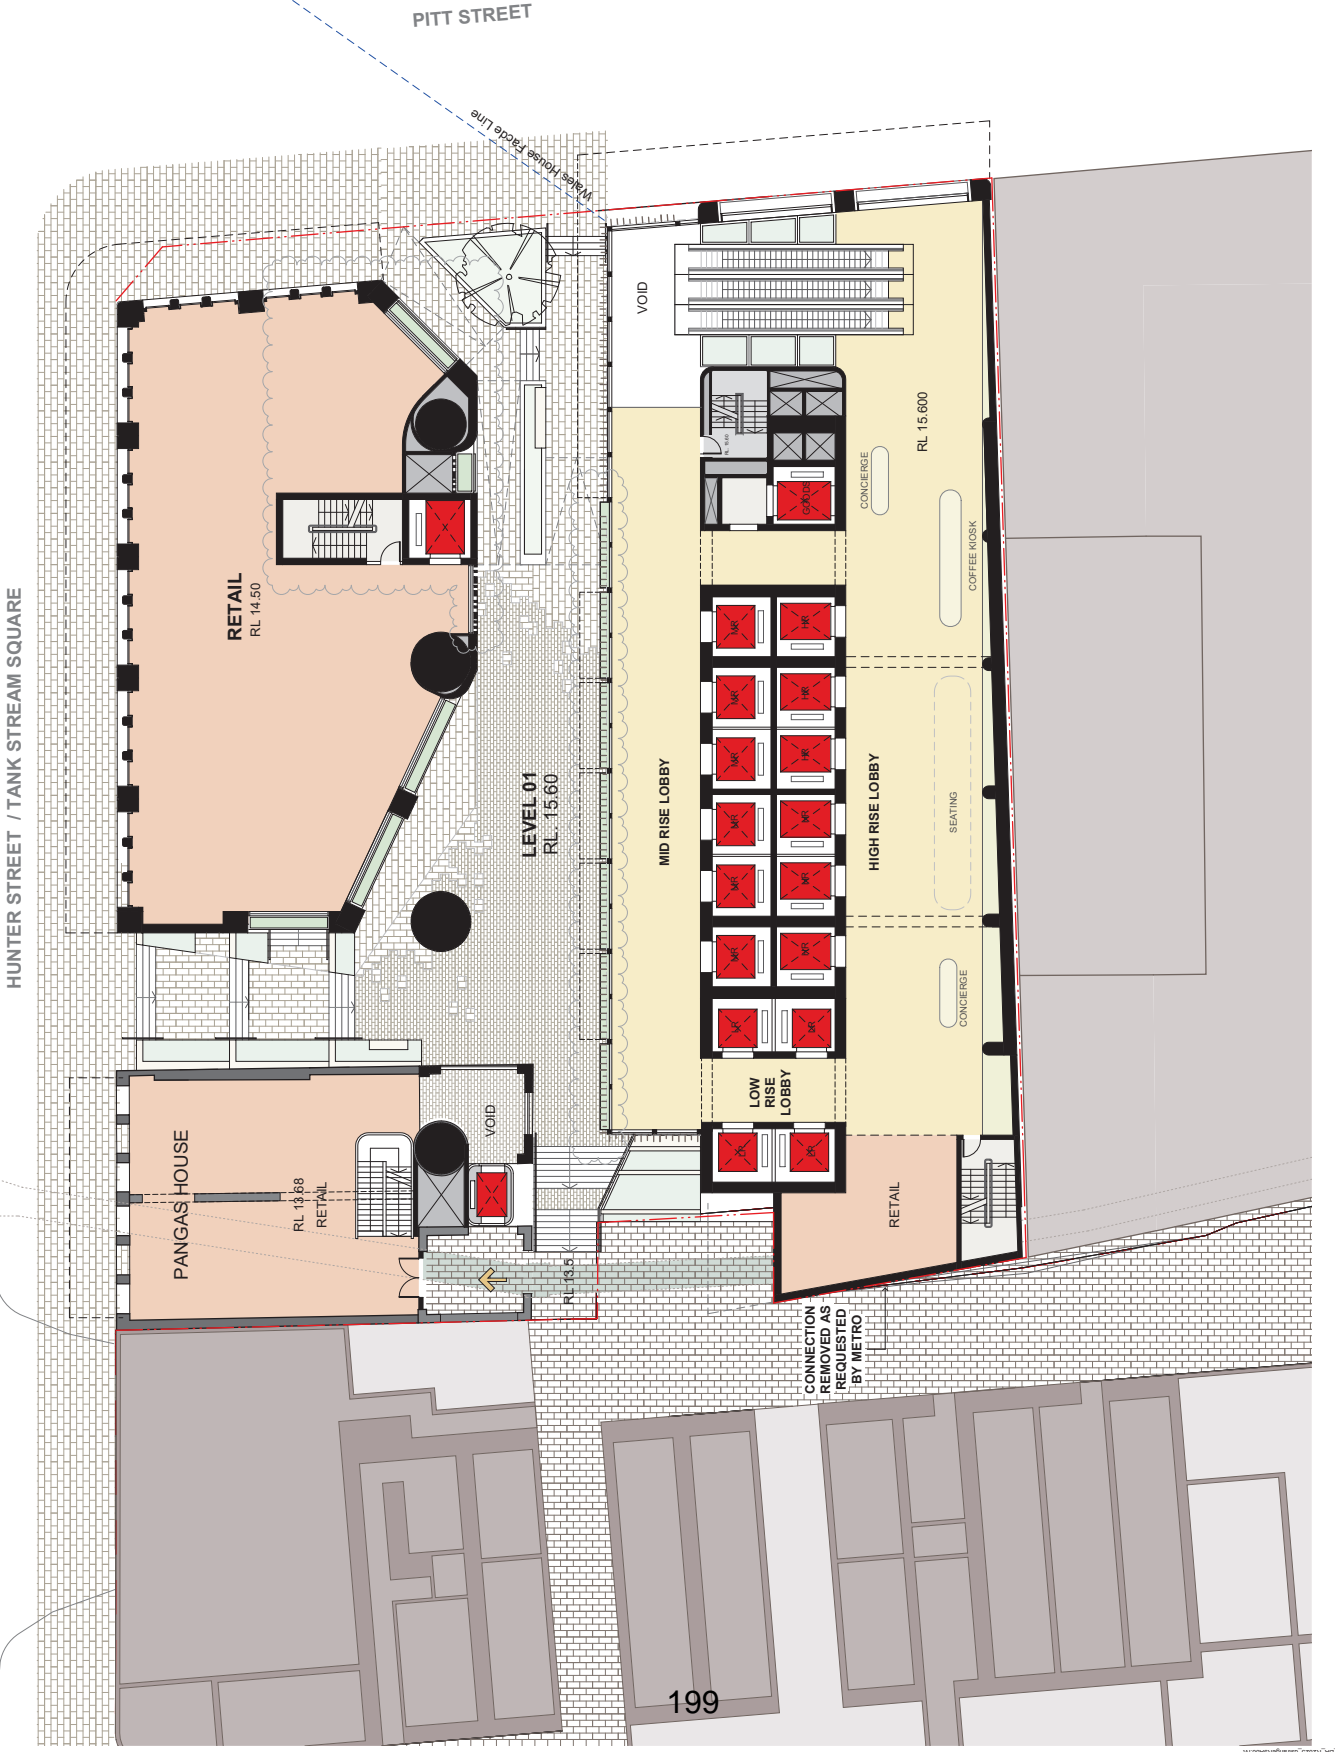


CONNECTION
 REMOVED AS
 REQUESTED
 BY METRO


199

Check all dimensions and site conditions prior to commencement of any work. The contractor shall be responsible for ensuring that all dimensions are correct and that all site conditions are as shown on the drawings. Any discrepancies shall immediately be referred to the architect for clarification. All drawings may not be reproduced or distributed without prior permission from the architect.

HUNTER STREET / TANK STREAM SQUARE

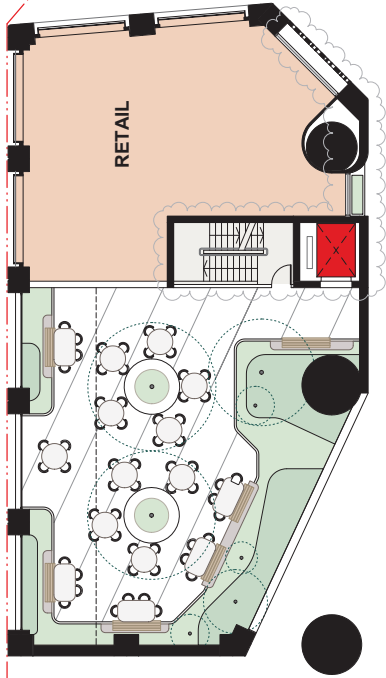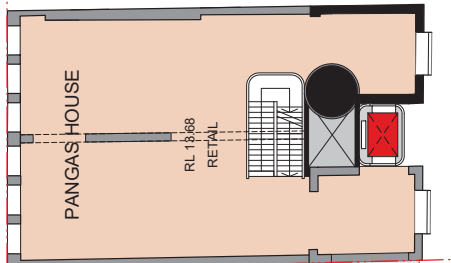

PITT STREET

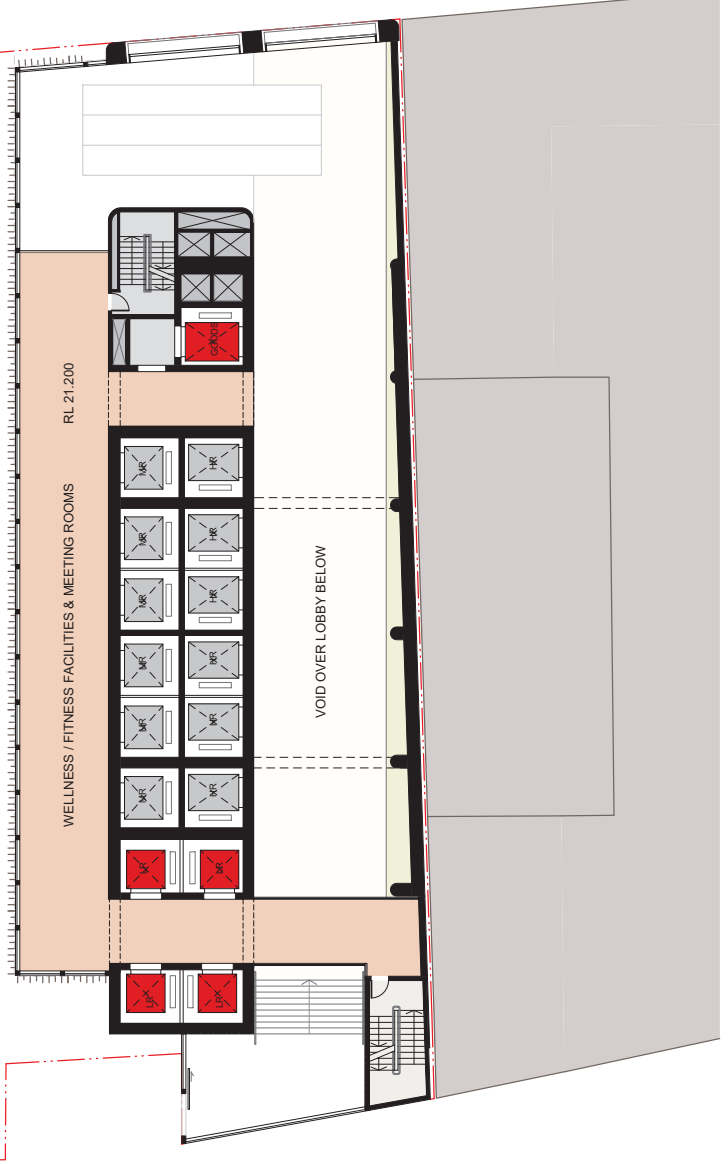

200

| Rev | Desc/Revision | By | Check | Date |
|-----|--|---------|---------|------|
| B | 24/01/18 - GA Response to RFI from Council | JB | DB | |
| | | Drawn | Checked | |
| | | Initial | Checked | |

Hunter & Pitt

GA Plan
Level 2



| | |
|-------------|-------------------------|
| Status | Development Application |
| Scale | 1:125 @ A1 |
| Drawn | AT |
| Checked | DS |
| Project No. | S12333A |
| Proj. Date | 2006/08/13 22:28 PM |
| Rev | |

| Drawing No. | Revision |
|-------------|----------|
| A03.002 | B |


Melbourne 1 Nicholson Street
Sydney NSW 2010 Australia
Melbourne VIC 3000 Australia
Sydney NSW 2010 Australia
email mel@batesmart.com.au
email syd@batesmart.com.au
http://www.batesmart.com.au

Bates Smart Architects Pty Ltd ABN 68 094 740 888
100 Waterloo Rd, Sydney NSW 2010 Australia
100 Waterloo Rd, Sydney NSW 2010 Australia
100 Waterloo Rd, Sydney NSW 2010 Australia

BATESSMART

Check all dimensions and site conditions prior to commencement of any work. The contractor shall be responsible for the accuracy of the information contained in this drawing. The contractor shall be responsible for the accuracy of the information contained in this drawing. Do not scale drawings - refer to listed dimensions only. Any discrepancies shall immediately be referred to the architect for clarification. All drawings may not be reproduced or distributed without prior permission from the architect.

HUNTER STREET / TANK STREAM SQUARE

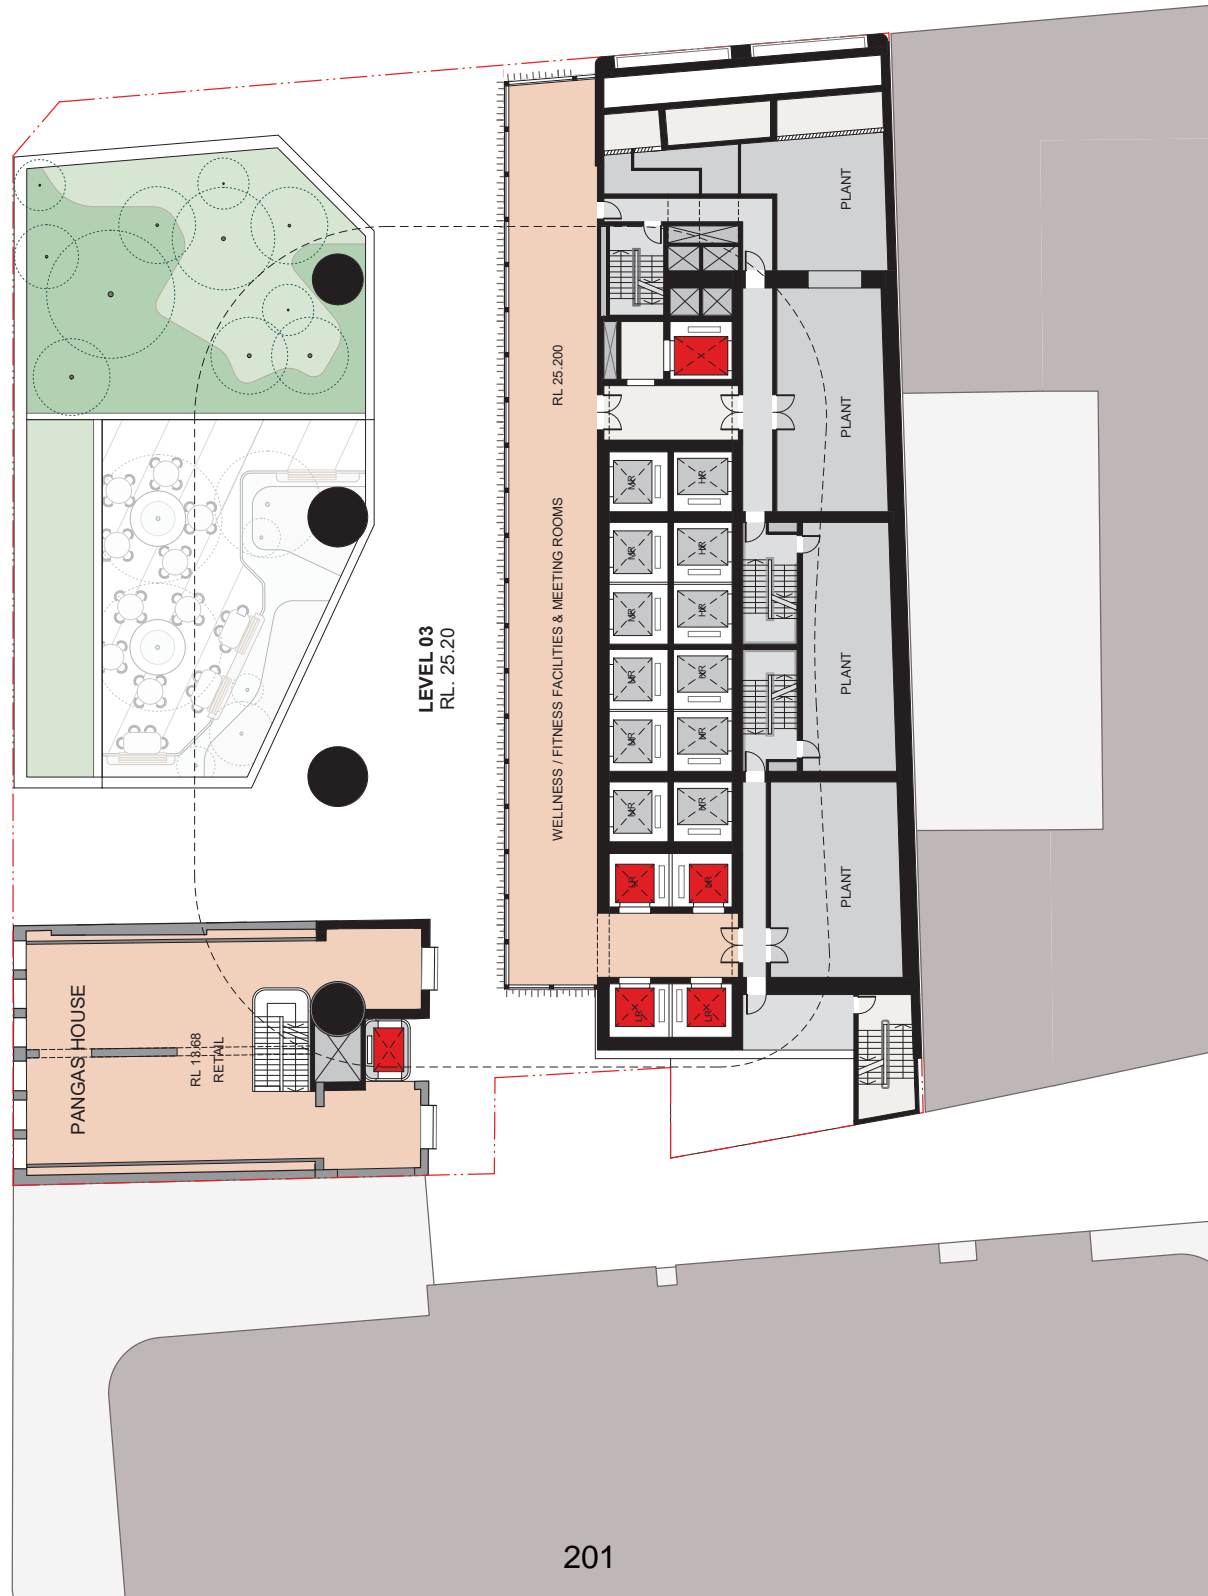

PITT STREET

LEVEL 03
RL. 25.20

WELLNESS / FITNESS FACILITIES & MEETING ROOMS

RL 25.200

PANGAS HOUSE

RL 18.688
RETAIL

Hunter & Pitt

GA Plan
Level 3 - Plant & Substation



| | |
|-------------|-------------------------|
| Status | Development Application |
| Scale | 1:125 @ A1 |
| Drawn | AT |
| Checked | DS |
| Project No. | S12333A |
| Proj. Date | 2005/08/12 2:30 PM |
| Rev. | |

| | |
|--|----------|
| Drawing No. | Revision |
| A03.003 | B |
| <p>Melbourne 1 Nicholson Street Sydney NSW 2010 Australia Sydney 43 Brisbane Street Sydney NSW 2010 Australia Melbourne VIC 3000 Australia Sydney NSW 2010 Australia email mel@batesmart.com.au email syd@batesmart.com.au http://www.batesmart.com.au</p> <p>Bates Smart Architects Pty Ltd ABN 68 094 740 888 100 Waterloo Rd, Sydney NSW 2000 Australia Contact: Sydney 02 9550 9999, Melbourne 03 9550 9999, Perth 08 9550 9999</p> | |

| | | | | |
|-----|----------|---------------------------------|---------|---------|
| B | 24/05/18 | GA Response to RFI from Council | JD | DB |
| Rev | Drawn | Checked | Initial | Checked |

Check all dimensions and site conditions prior to commencement of any work. The contractor shall be responsible for the accuracy of the information provided in this drawing. The contractor shall be responsible for the accuracy of the information provided in this drawing. Do not scale drawings - refer to listed dimensions only. Any discrepancies shall immediately be referred to the architect for clarification. All drawings may not be reproduced or distributed without prior permission from the architect.

| Rev | Desc | Drawn | Checked | Initial | Date |
|-----|---|-------|---------|---------|------|
| B | 2400 H. GA Response to RFI from Council | | | | |

Hunter & Pitt
 GA Plan
 Level 4 - Plant


| | |
|-------------|-------------------------|
| Status | Development Application |
| Scale | 1:125 @ A1 |
| Drawn | AT |
| Checked | DS |
| Project No. | S12333A |
| File Date | 2005204 12:21:44PM |
| BNF | |

A03.004 Revision
B
 Melbourne 1 Nicholson Street
 Sydney Q3 Brisbane Street
 Melbourne VIC 3000 Australia
 Sydney NSW 2010 Australia
 email mel@batesmart.com.au
 email syd@batesmart.com.au
 http://www.batesmart.com.au
 http://www.batesmart.com.au
 Bates Smart Architects Pty Ltd ABN 68 094 740 888
 200 Waverley Rd, Waverley VIC 3155 Australia
 03 9594 1111
 www.batesmart.com.au


BATESMART

HUNTER STREET / TANK STREAM SQUARE

PITT STREET

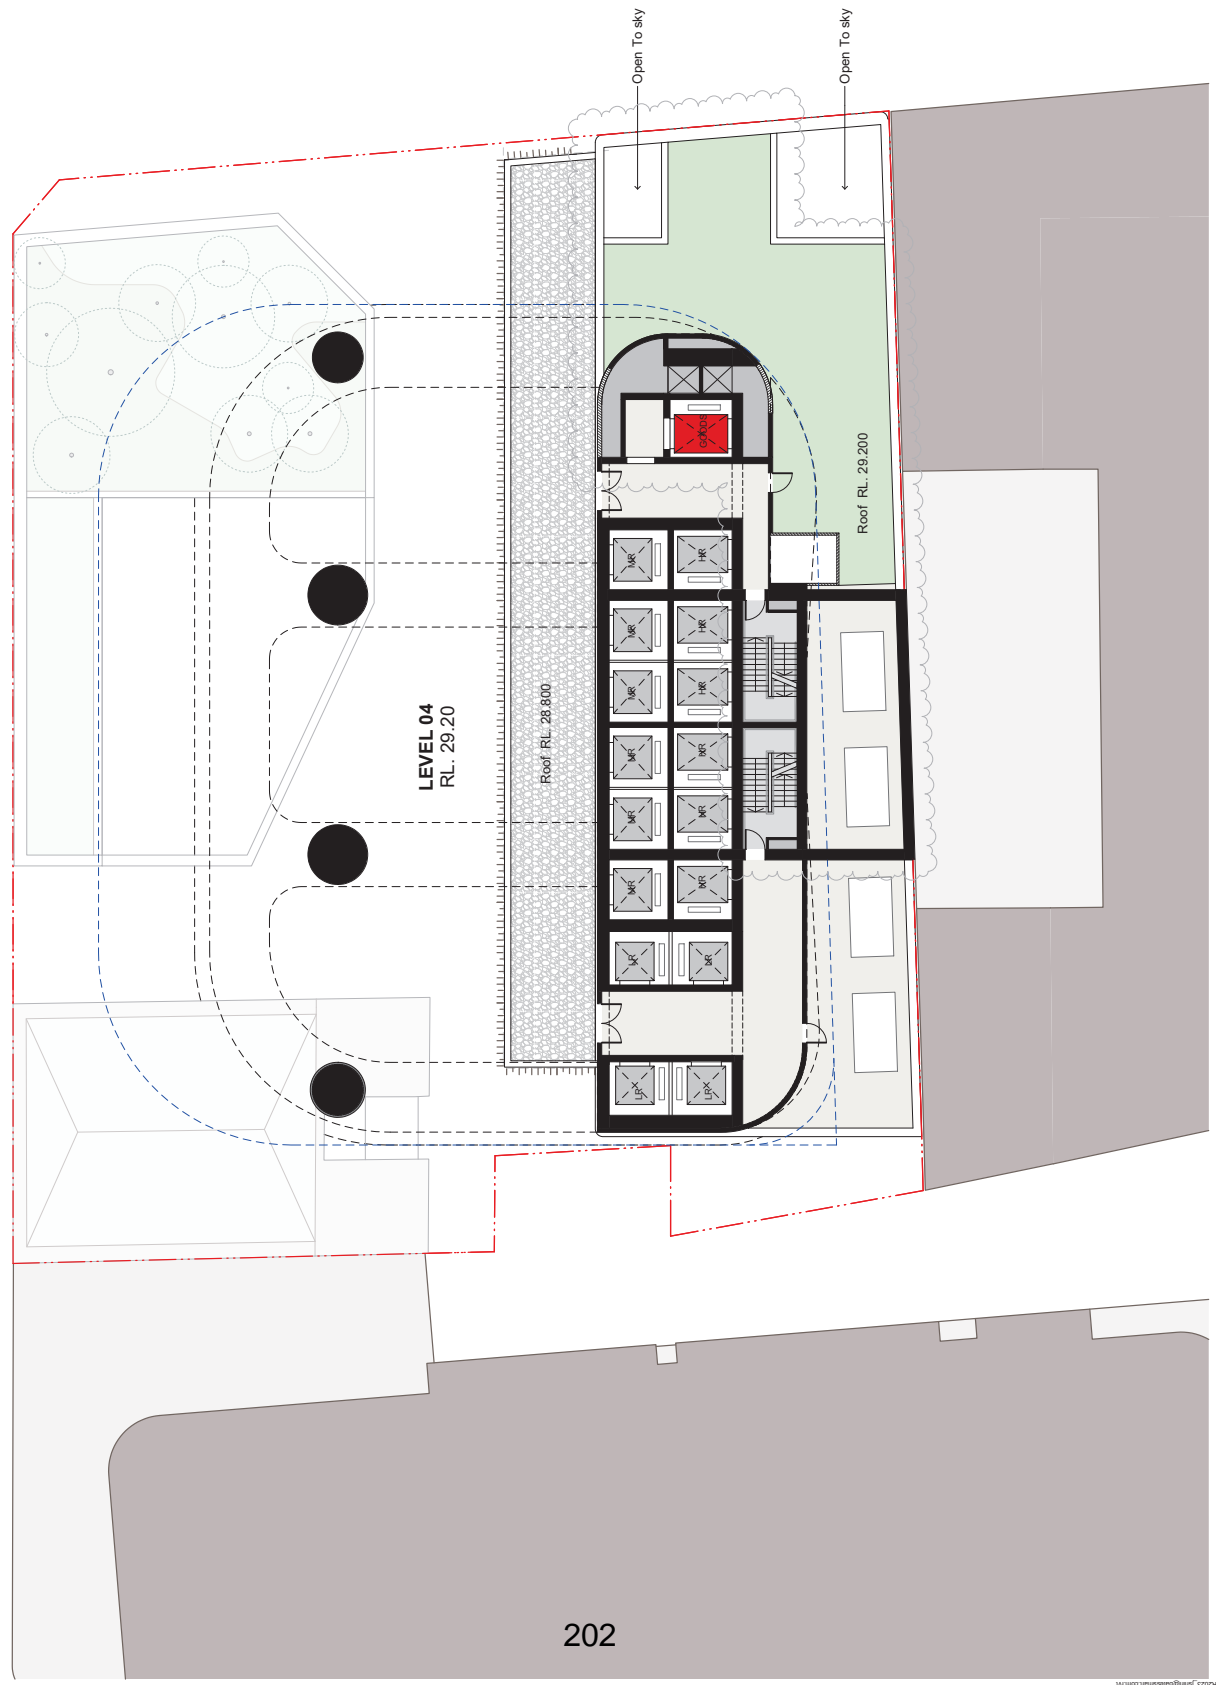

Check all dimensions and site conditions prior to commencement of any work. The contractor shall be responsible for ensuring that the site is suitable for construction and that all necessary permits and approvals are obtained prior to commencement of any work. Do not scale drawings - refer to listed dimensions only. Any discrepancies shall immediately be referred to the architect for clarification. All drawings may not be reproduced or distributed without prior permission from the architect.

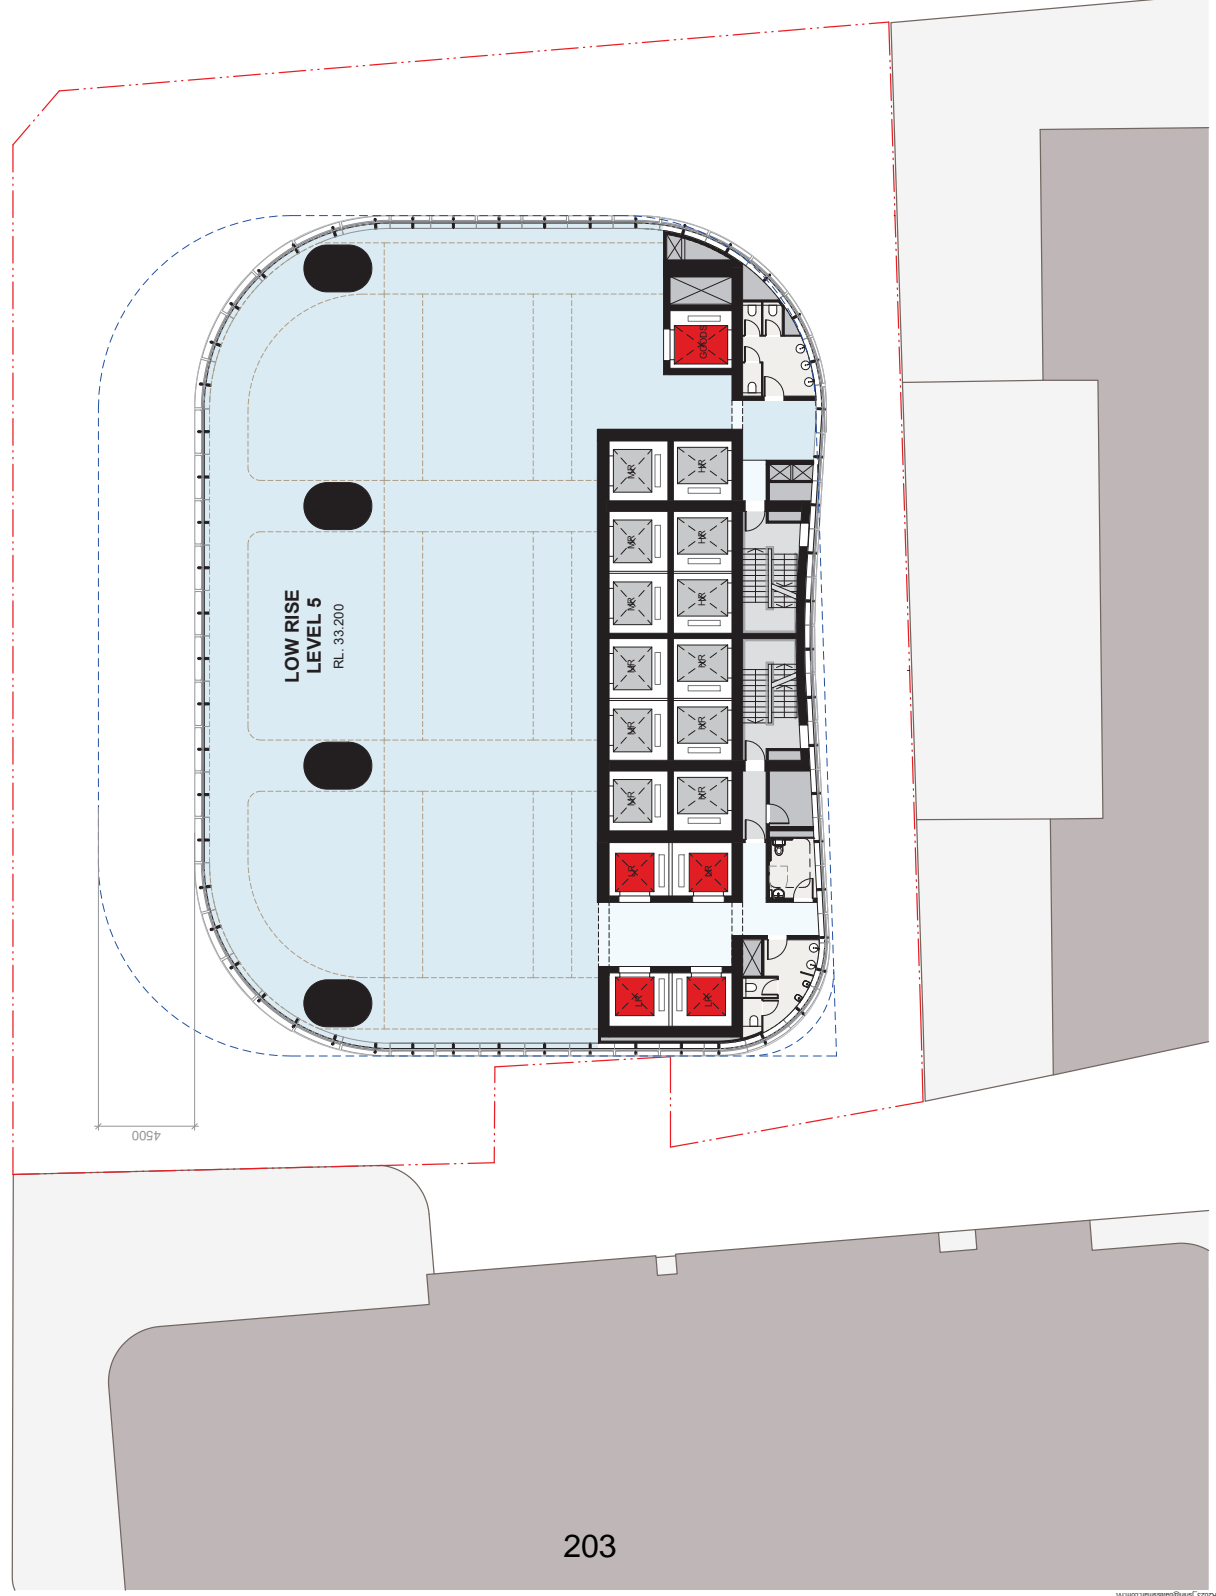

| Rev | Desc | Drawn | Checked | Initial | Checked |
|-----|--|-------|---------|---------|---------|
| B | 2400 RL. GA Response to RFI from Council | JB | DS | | |
| | | DSB | DSB | | |

Hunter & Pitt

GA Plan
Level 5




| | |
|-------------|-------------------------|
| Status | Development Application |
| Scale | 1:125 @ A1 |
| Drawn | AT |
| Checked | DS |
| Project No. | S12333A |
| Proj. Date | 2002/04/12 12:58 PM |
| BNV | |

| Drawing No. | Revision |
|----------------|----------|
| A03.005 | B |

Melbourne 1 Nicholson Street
 Sydney NSW 2010 Australia
 Melbourne VIC 3000 Australia
 email: info@batesmart.com.au
 email: syd@batesmart.com.au
 http://www.batesmart.com.au

Bates Smart Architects Pty Ltd ABN 68 094 740 588
 20/100 Victoria Road, North Melbourne, VIC 3048
 Copyright © 2012 Bates Smart Architects Pty Ltd. All Rights Reserved.

Check all dimensions and site conditions prior to commencement of any work. The contractor shall be responsible for ensuring that the site conditions are suitable for the proposed development. The contractor shall be responsible for ensuring that the site conditions are suitable for the proposed development. The contractor shall be responsible for ensuring that the site conditions are suitable for the proposed development.

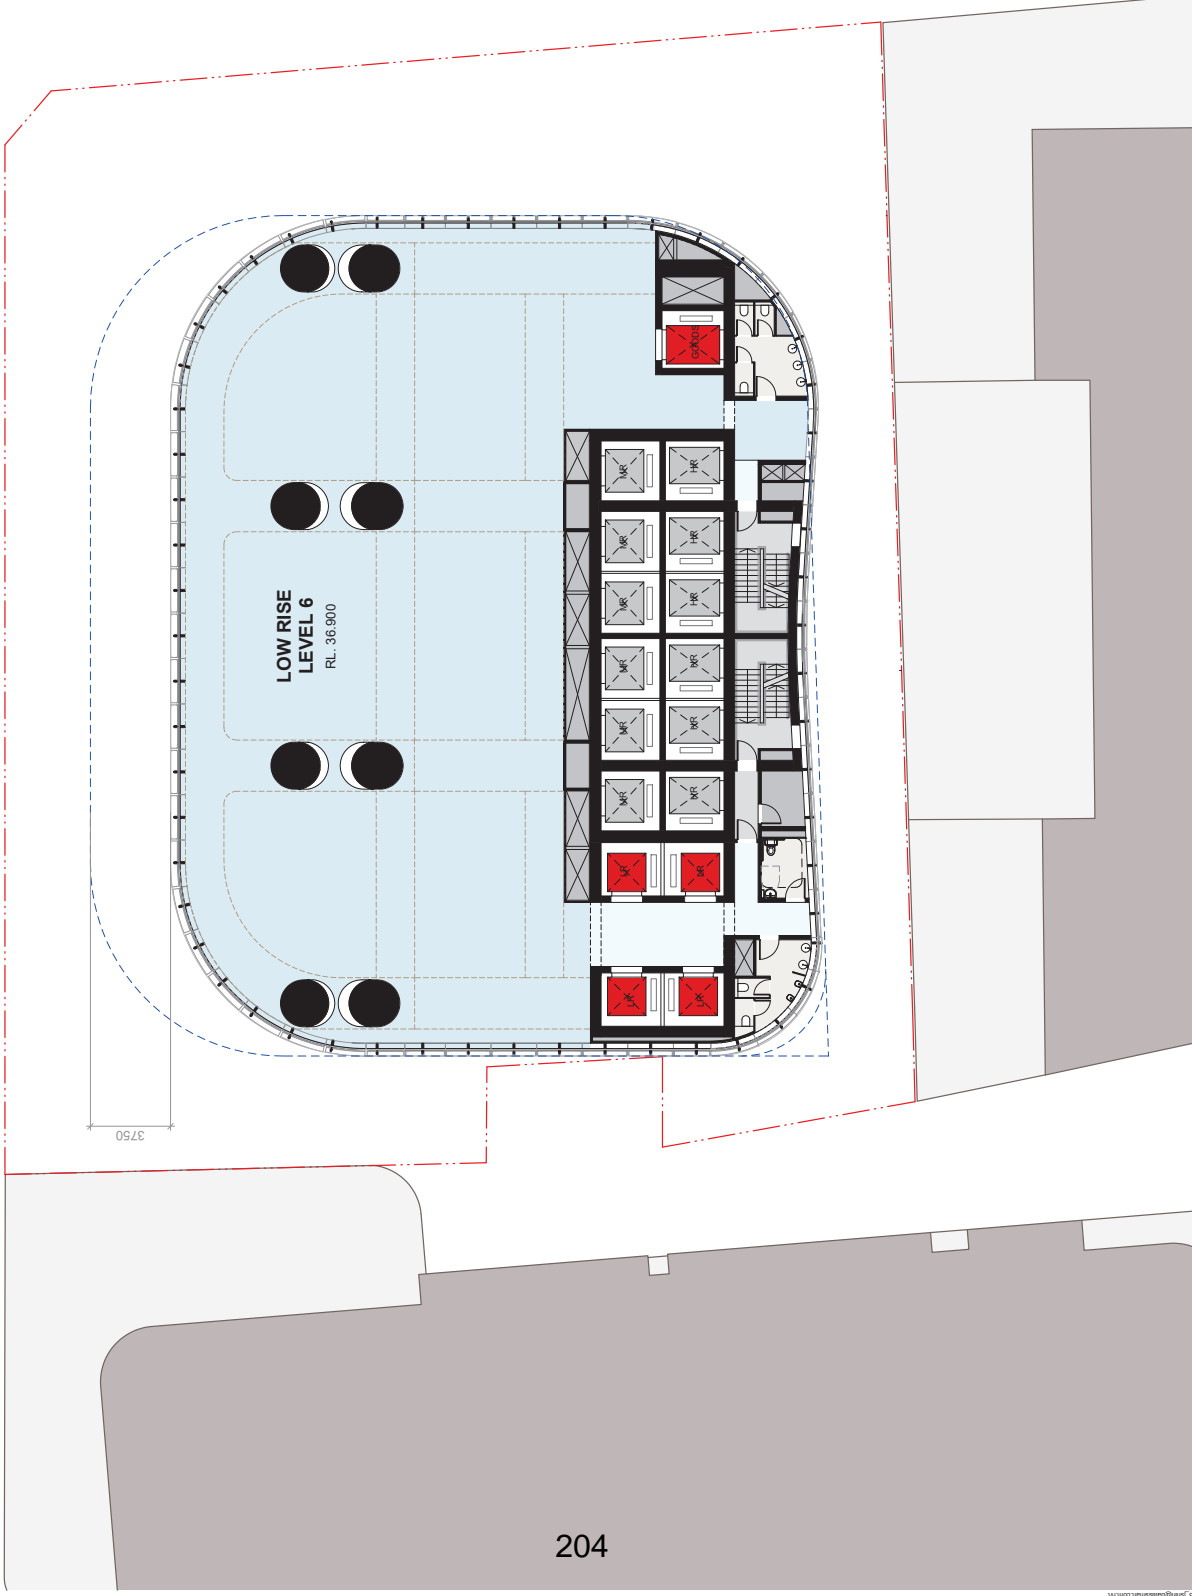

| Rev | Desc | Drawn | Checked | Initial | Checked |
|-----|---|-------|---------|---------|---------|
| B | 24/01/18. GA Response to RFI from Council | JB | DS | | |
| | | DSB | | | |

Hunter & Pitt

GA Plan
Level 6




| | |
|-------------|-------------------------|
| Status | Development Application |
| Scale | 1:125 @ A1 |
| Drawn | AT |
| Checked | DS |
| Project No. | S12333A |
| Proj. Date | 29/02/2011 12:22:07PM |
| BM | |

Drawing No. Revision
A03.006 B

Melbourne 1 Nicholson Street
Sydney NSW 2010 Australia
Phone: +61 (0)2 9211 8888
email: info@batesmart.com.au
http://www.batesmart.com.au

Bates Smart Architects Pty Ltd ABN 68 094 740 588
100 Waterloo Road, Sydney NSW 2010 Australia
Phone: +61 (0)2 9211 8888
Fax: +61 (0)2 9211 8889
www.batesmart.com.au

Check all dimensions and site conditions prior to commencement of any work. The contractor shall be responsible for ensuring that the drawings are in accordance with the site conditions. The contractor shall be responsible for ensuring that the drawings are in accordance with the site conditions. Do not scale drawings - refer to listed dimensions only. Any discrepancies shall immediately be referred to the architect for clarification. All drawings may not be reproduced or distributed without prior permission from the architect.

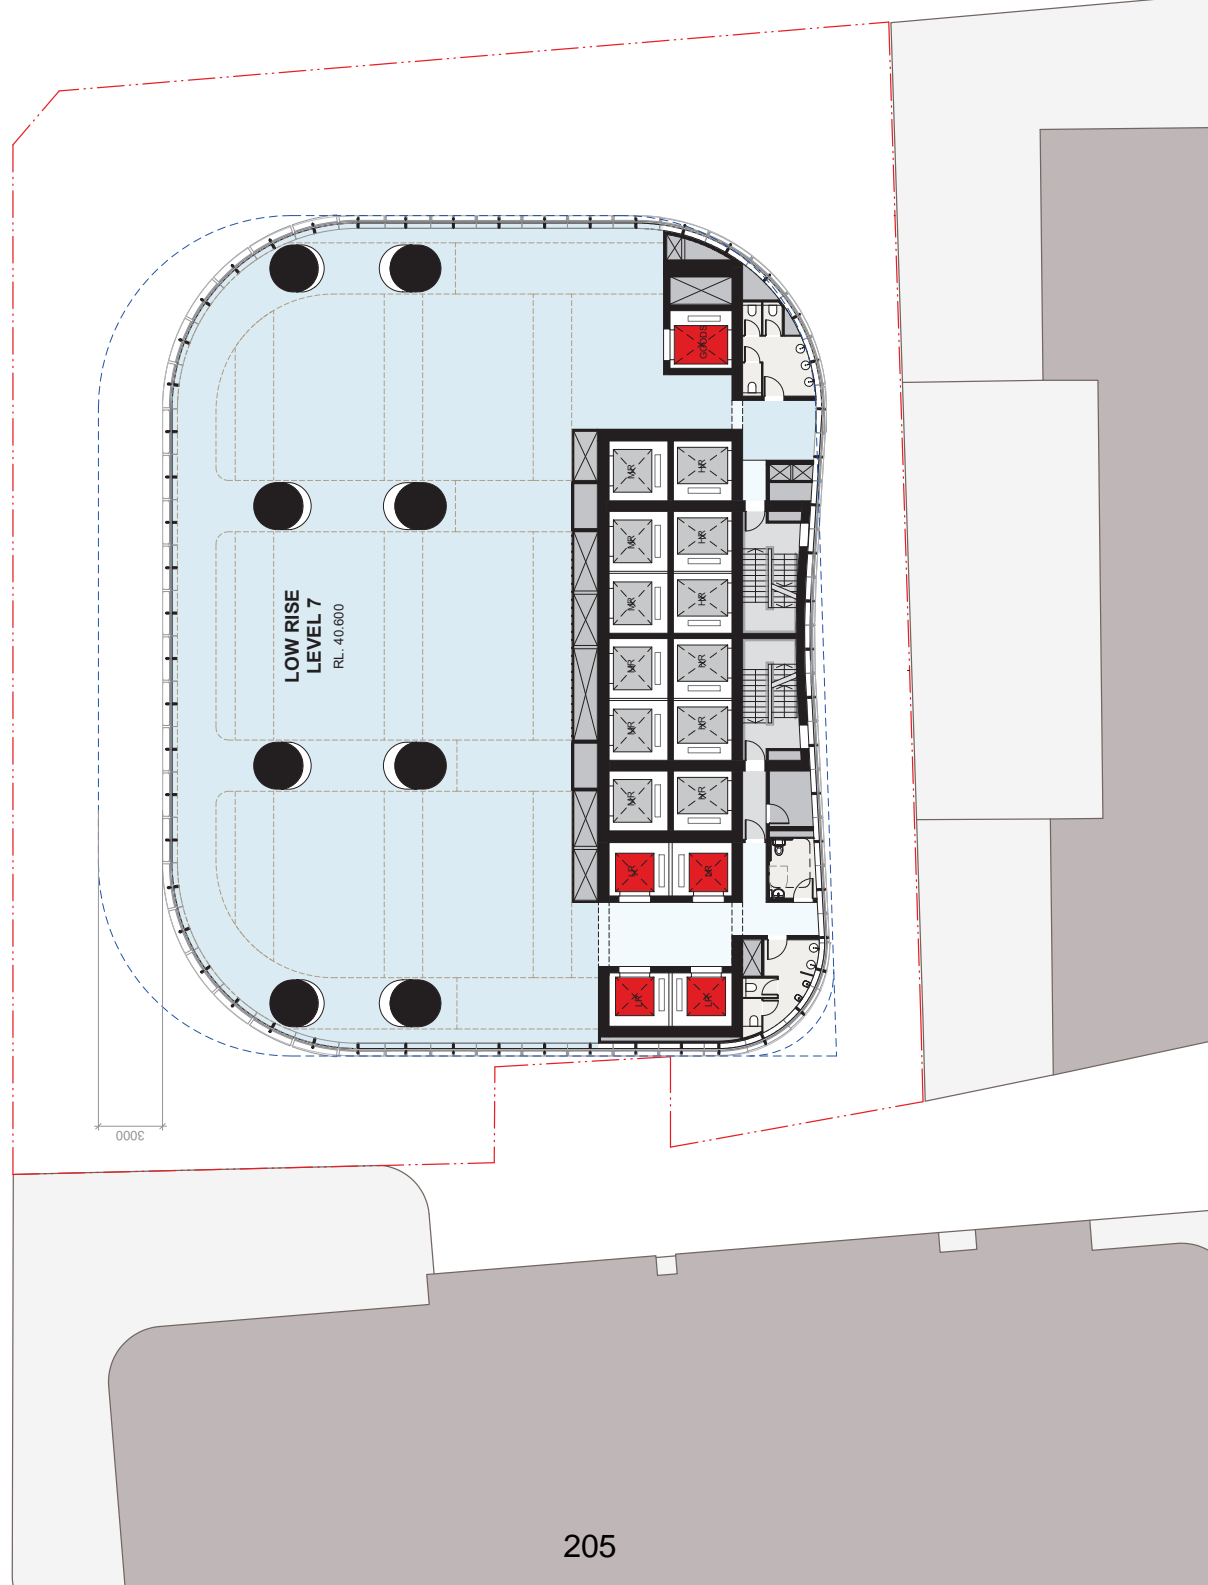

| Rev | Desc | Drawn | Checked | Initial | Checked |
|-----|---|-------|---------|---------|---------|
| B | 24/01/18, GA Response to RFI from Council | JB | DB | | |
| | | DB | JB | | |
| | | DB | JB | | |

Hunter & Pitt

GA Plan
Level 7




| | |
|-------------|-------------------------|
| Status | Development Application |
| Scale | 1:125 @ A1 |
| Drawn | AT |
| Checked | DS |
| Project No. | S12333A |
| Proj Date | 2002/04/12 2:18 PM |
| BN | |

| Drawing No. | Revision |
|----------------|----------|
| A03.007 | B |

Melbourne 1 Nicholson Street
 Sydney NSW 2010 Australia
 Melbourne VIC 3000 Australia
 email: info@batesmart.com.au
 http://www.batesmart.com.au

Bates Smart Architects Pty Ltd ABN 68 094 740 588
 10/11 Market Street, Melbourne VIC 3000 Australia
 10/11 Market Street, Sydney NSW 2010 Australia

Check all dimensions and site conditions prior to commencement of any work.
 The contractor shall be responsible for obtaining all necessary permits and approvals.
 Do not scale drawings - refer to listed dimensions only. Any discrepancies shall
 immediately be referred to the architect for clarification.
 All drawings may not be reproduced or distributed without prior permission from
 the architect.

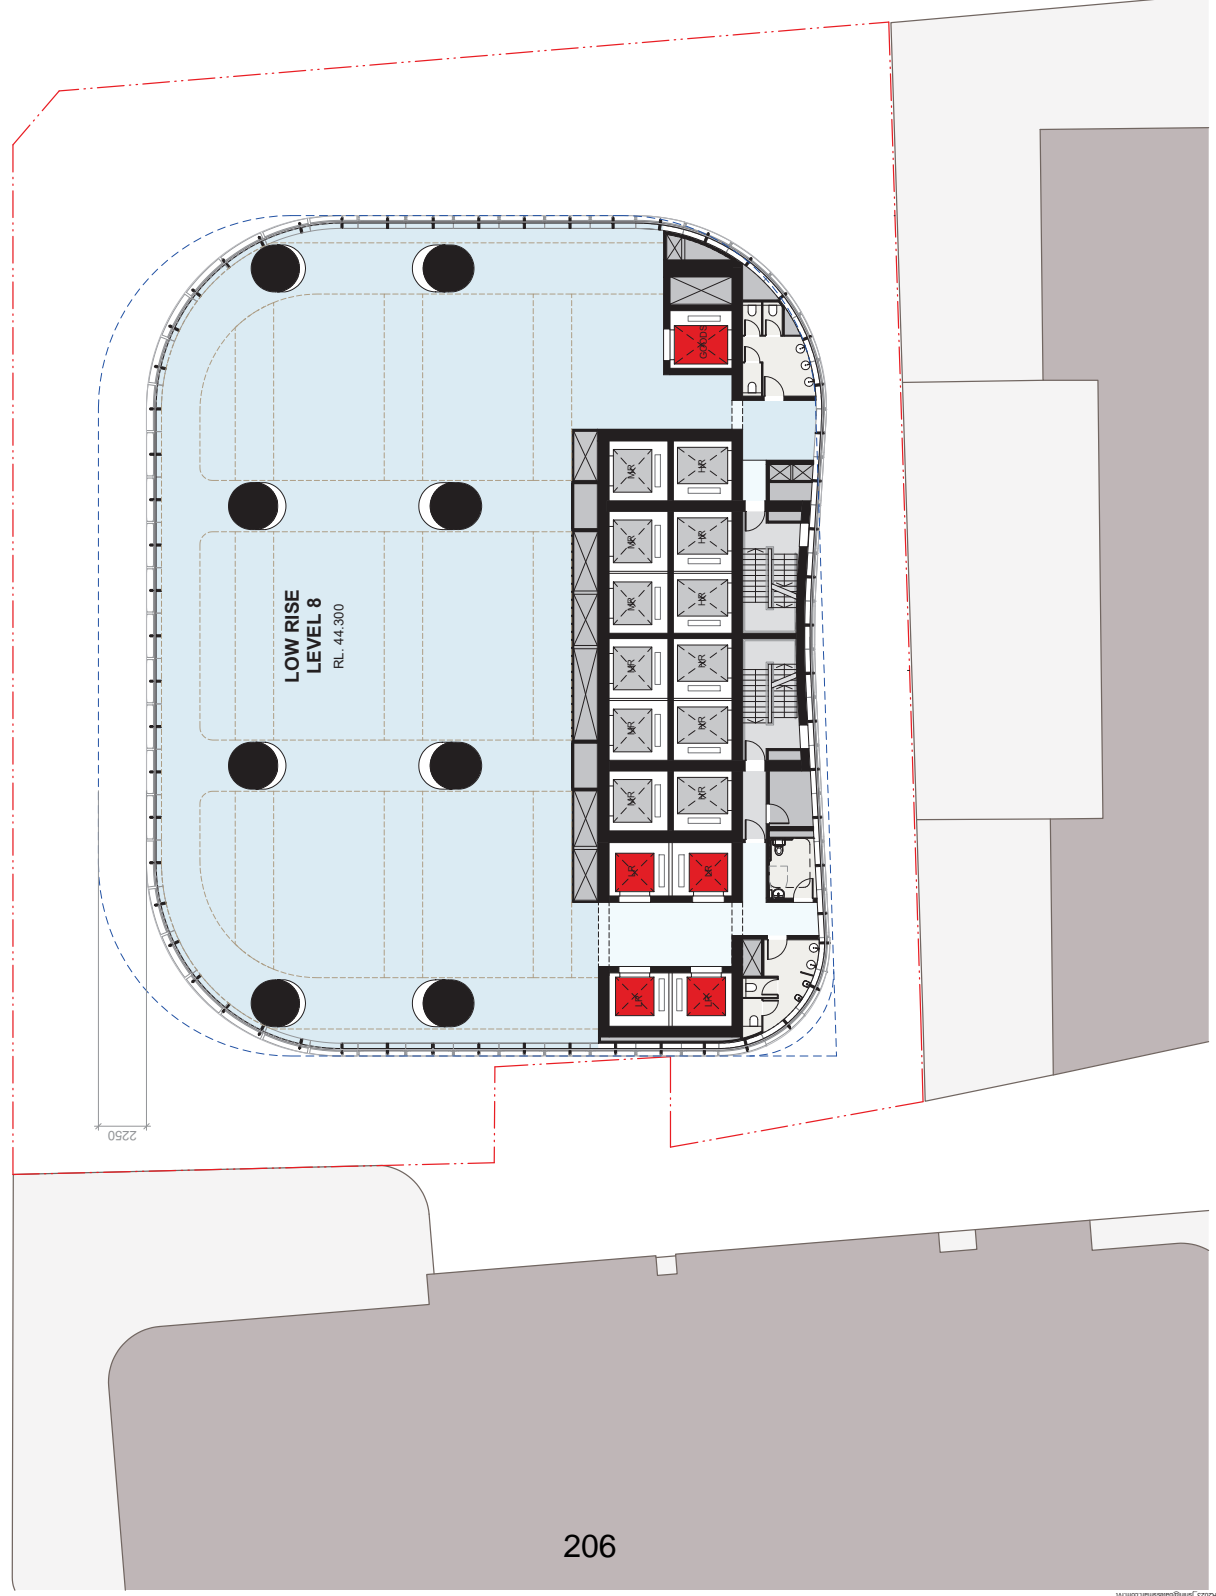

| Rev | Description | DB | Checked |
|-----|---|---------|---------|
| B | 24/01/18: GA Response to RFI from Council | JB | |
| | | Initial | Checked |

Hunter & Pitt

GA Plan
Level 8




| | |
|-------------|-------------------------|
| Status | Development Application |
| Scale | 1:125 @ A1 |
| Drawn | AT |
| Checked | DS |
| Project No. | S12333A |
| Proj. Date | 29/05/2014 12:22:30PM |
| BM | |

Drawing No. Revision
A03.008 B

Melbourne 1 Nicholson Street
 Melbourne VIC 3000 Australia
 Phone: +61 (0)3 9493 9300
 Fax: +61 (0)3 9493 9301
 email: info@batesmart.com.au
 http://www.batesmart.com.au

Bates Smart Architects Pty Ltd ABN 68 094 740 888
 10/11 Wattle Street, Wattle Park, VIC 3086
 Phone: +61 (0)3 9493 9300 Fax: +61 (0)3 9493 9301
 www.batesmart.com.au

Check all dimensions and site conditions prior to commencement of any work. The contractor shall be responsible for ensuring that the drawings are in accordance with the latest version of the relevant codes of practice and standards. Do not scale drawings - refer to listed dimensions only. Any discrepancies shall immediately be referred to the architect for clarification. All drawings may not be reproduced or distributed without prior permission from the architect.

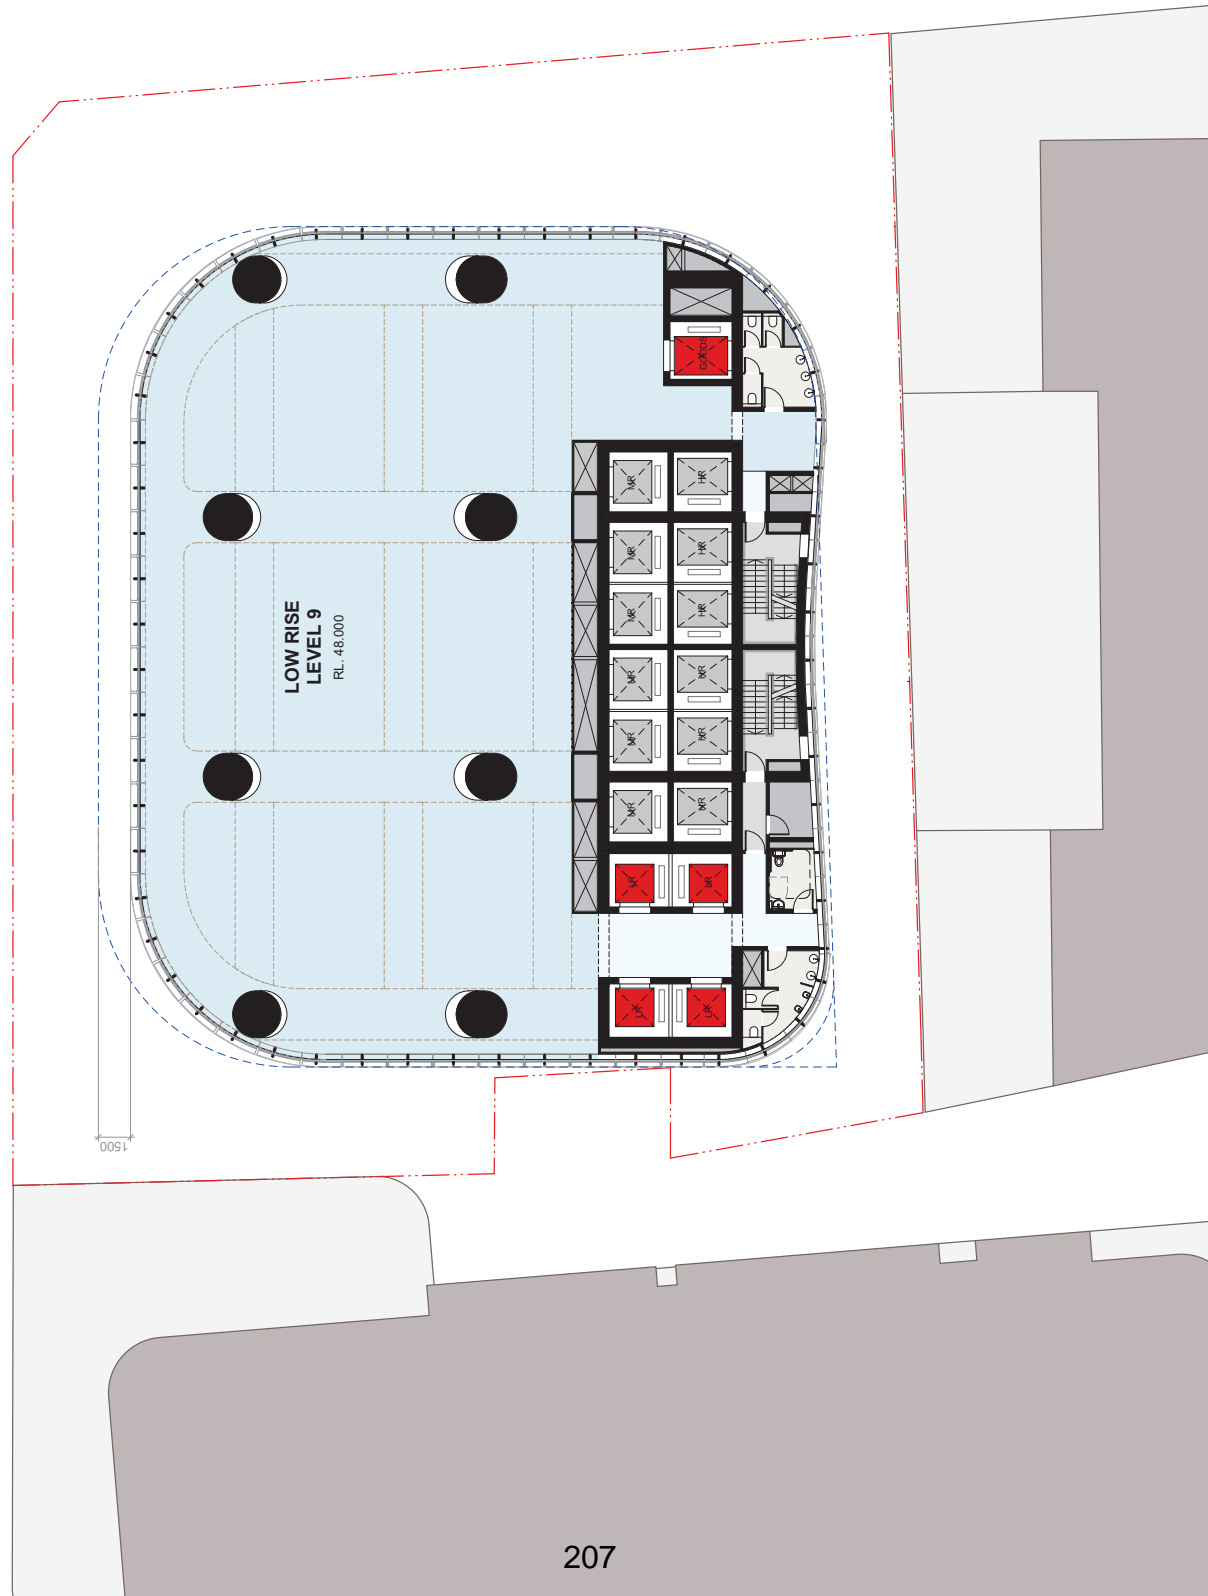

LOW RISE
LEVEL 9
RL: 48.000

1500

| Rev | Description | Drawn | Checked | Initial | Checked |
|-----|---|-------|---------|---------|---------|
| B | 2400 RL DA Response to RFI from Council | JB | DB | | |
| | | DB | | | |

Hunter & Pitt

GA Plan
Level 9




| | |
|-------------|-------------------------|
| Status | Development Application |
| Scale | 1:125 @ A1 |
| Drawn | AT |
| Checked | DS |
| Project No. | S12333A |
| Proj. Date | 2002/04/12 2:42 PM |
| BM | |

| Drawing No. | Revision |
|-------------|----------|
| A03.009 | B |

Melbourne 1 Nicholson Street
Sydney NSW 2010 Australia
Phone: +61 (0)2 9230 4000
email: info@batesmart.com.au
http://www.batesmart.com.au

Bates Smart Architects Pty Ltd ABN 68 094 740 988
100 Waterloo Road, Sydney NSW 2000
Company No. 121 224 274

Check all dimensions and site conditions prior to commencement of any work. The contractor is responsible for ensuring that the design is in accordance with the relevant codes of practice and standards. The contractor shall be responsible for obtaining all necessary permits and approvals. Do not scale drawings - refer to listed dimensions only. Any discrepancies shall immediately be referred to the architect for clarification. All drawings may not be reproduced or distributed without prior permission from the architect.

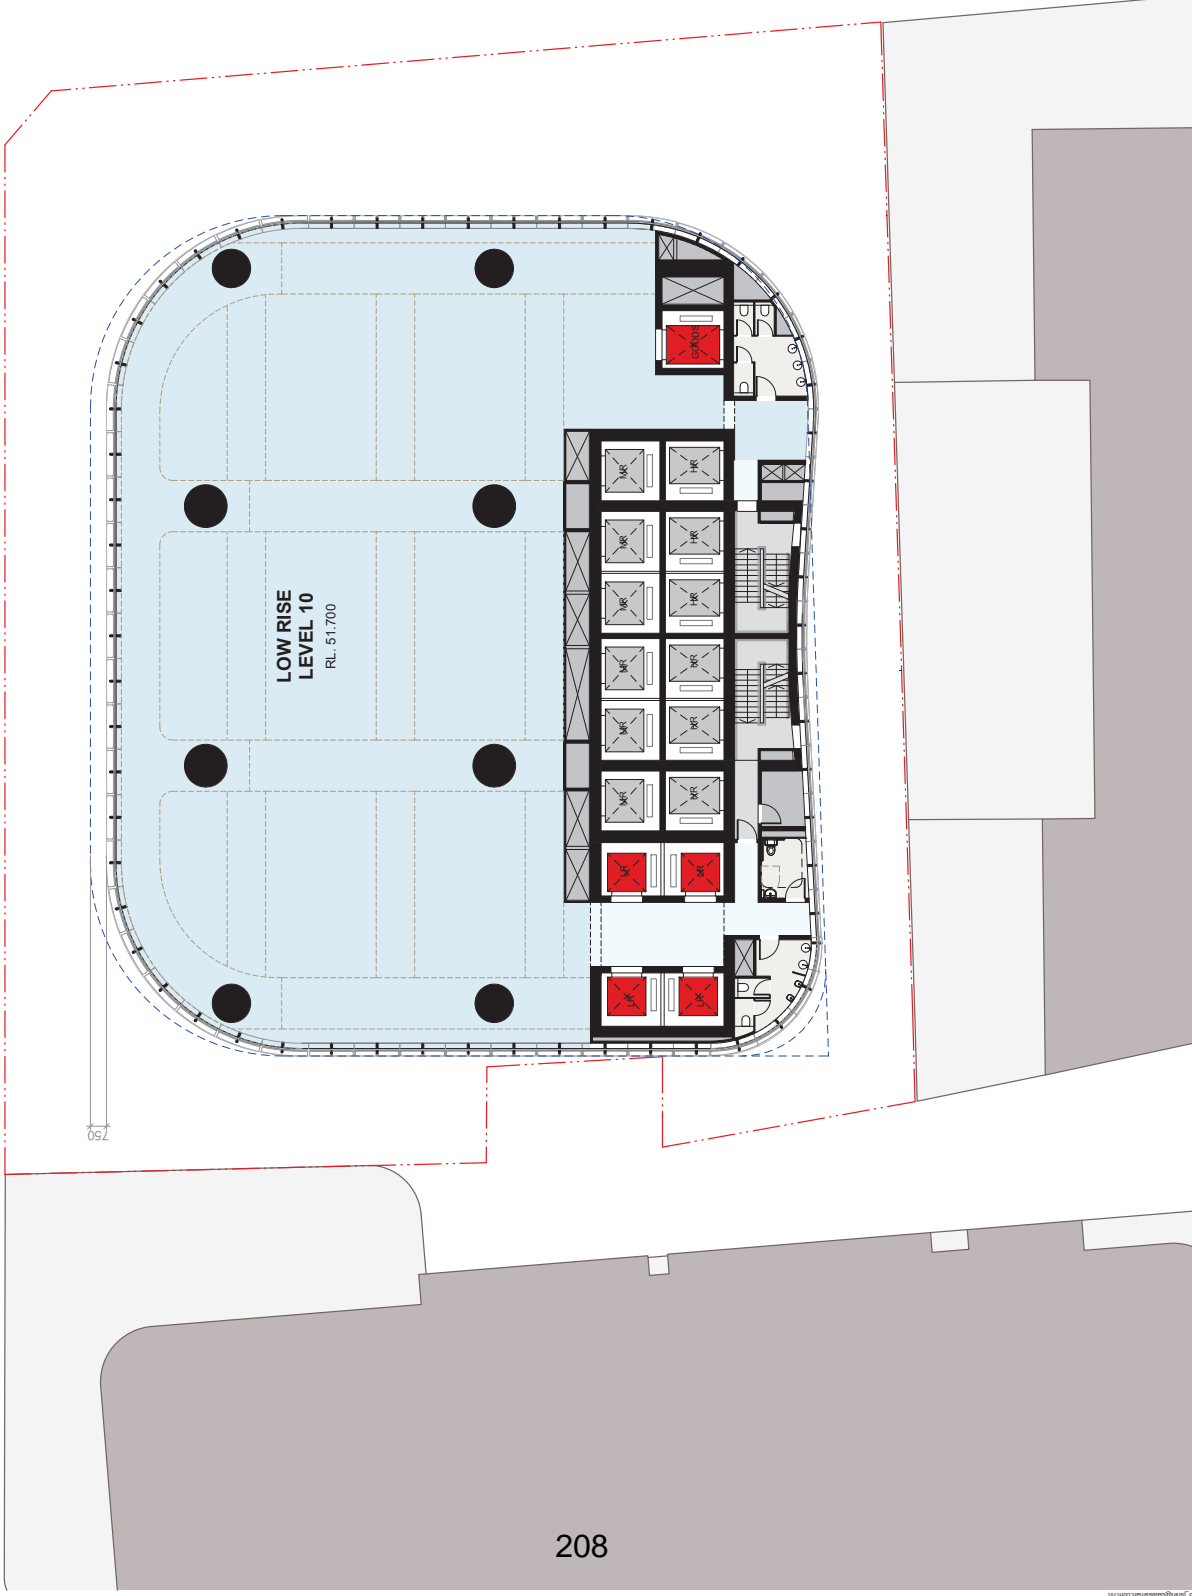

| Rev | Desc | Checked | Initial | Date |
|-----|---|---------|---------|------|
| B | 2400 RL DA Response to RFI from Council | | | |
| | | | | |
| | | | | |

Hunter & Pitt

GA Plan
Level 10




| | |
|-------------|-------------------------|
| Status | Development Application |
| Scale | 1:125 @ A1 |
| Drawn | AT |
| Checked | DS |
| Project No. | S12333A |
| Proj Date | 20020811 12:23:08 PM |
| BN1 | |

| Drawing No. | Revision |
|----------------|----------|
| A03.010 | B |

Melbourne 1 Nicholson Street
 Sydney NSW 2010 Australia
 Phone: +61 (0)2 9230 9000
 Email: info@batesmart.com.au
 http://www.batesmart.com.au

Bates Smart Architects Pty Ltd ABN 68 094 740 988
 100 Waterloo Rd, Sydney NSW 2010 Australia
 Phone: +61 (0)2 9230 9000
 Fax: +61 (0)2 9230 9001
 Email: info@batesmart.com.au
 Website: www.batesmart.com.au

Check all dimensions and site conditions prior to commencement of any work. The contractor shall be responsible for ensuring that the drawings are in accordance with the latest version of the relevant codes of practice and standards. Do not scale drawings - refer to listed dimensions only. Any discrepancies shall immediately be referred to the architect for clarification. All drawings may not be reproduced or distributed without prior permission from the architect.

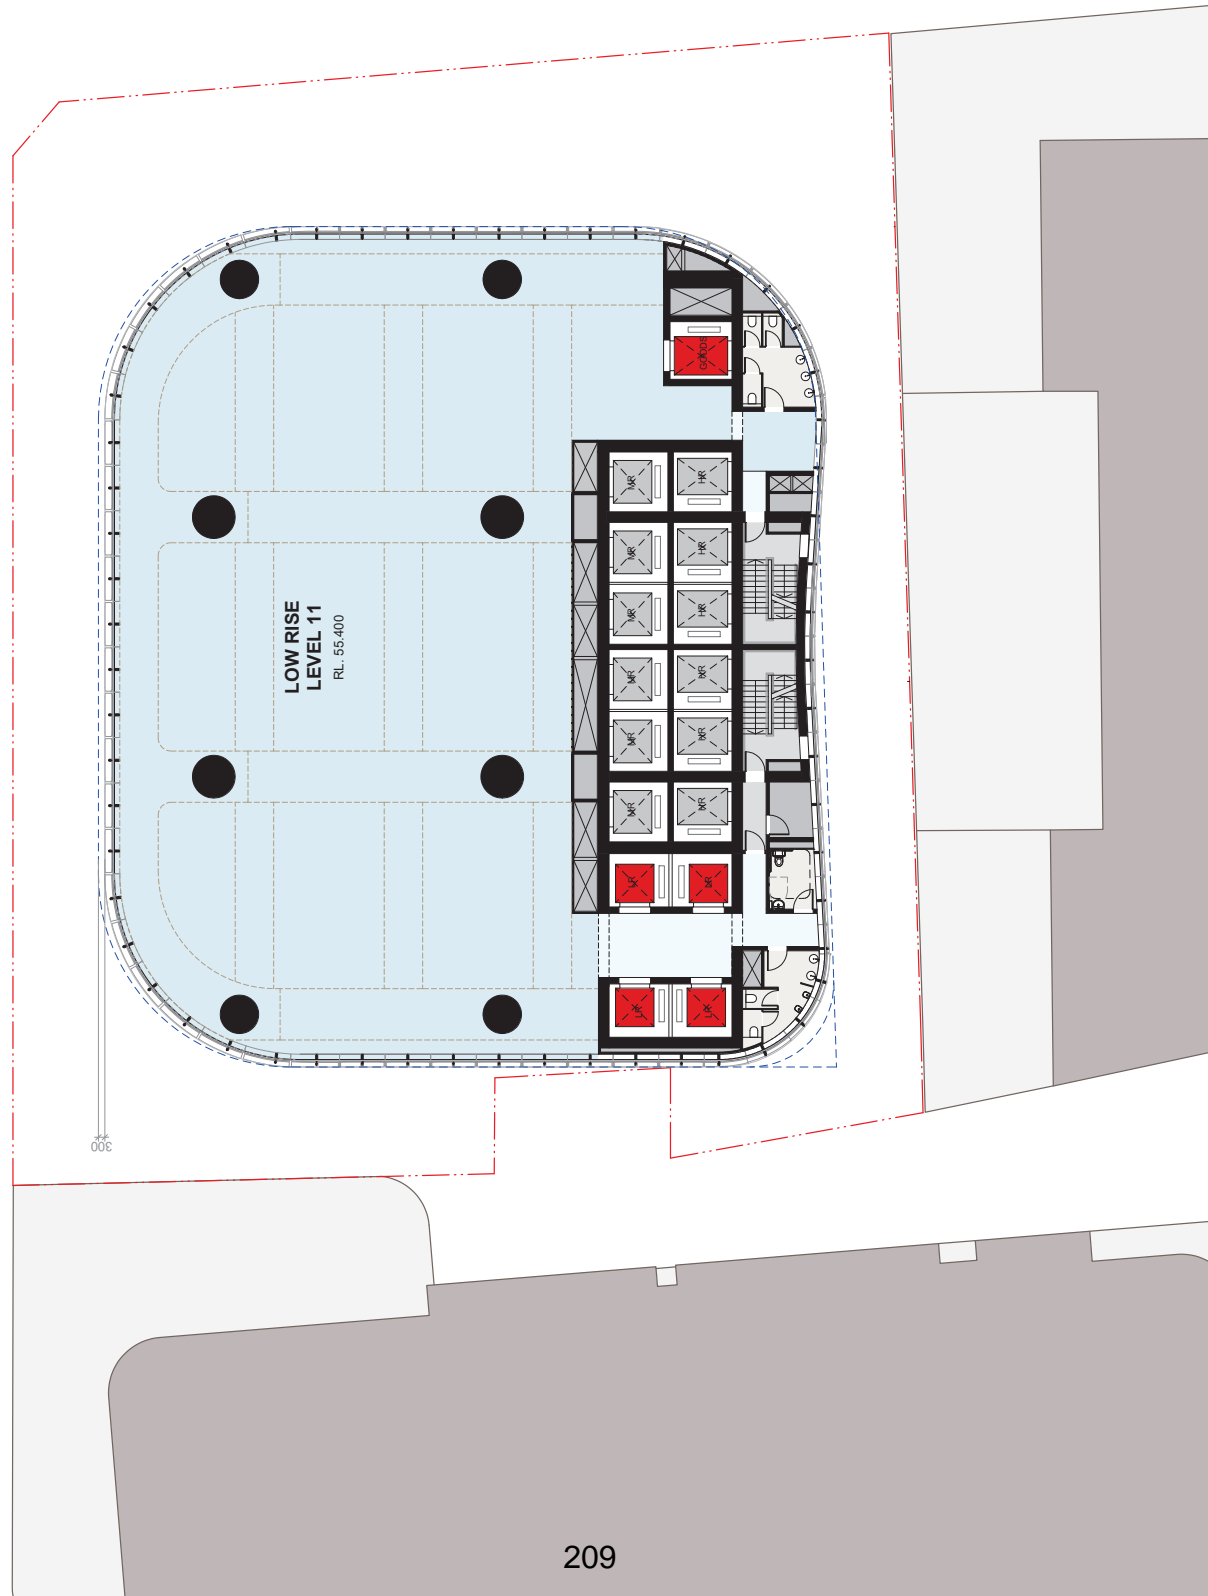

| Rev | Desc | Drawn | Checked | Initial | Checked |
|-----|---|-------|---------|---------|---------|
| B | 24/01/18, GA Response to RFI from Council | JB | DB | | |
| | | DB | | | |

Hunter & Pitt

GA Plan
Level 11




| | |
|-------------|-------------------------|
| Status | Development Application |
| Scale | 1:125 @ A1 |
| Drawn | AT |
| Checked | DS |
| Project No. | S12333A |
| Proj. Date | 29/02/2018 12:25:17 PM |
| BNF | |

| Drawing No. | Revision |
|----------------|----------|
| A03.011 | B |

Melbourne 1 Nicholson Street
 Sydney NSW 2010 Australia
 Phone: +61 (0)2 9230 4000
 Email: info@batesmart.com.au
 http://www.batesmart.com.au

Bates Smart Architects Pty Ltd ABN 68 094 740 588
 10/11 Market Street, Sydney NSW 2000
 Phone: +61 (0)2 9230 4000
 Fax: +61 (0)2 9230 4001
 Email: info@batesmart.com.au

Check all dimensions and site conditions prior to commencement of any work. The contractor is to ensure that all dimensions are correct and to collaborate with the architect to ensure that all dimensions are correct. The contractor is to ensure that all dimensions are correct and to collaborate with the architect to ensure that all dimensions are correct. Do not scale drawings - refer to listed dimensions only. Any discrepancies shall immediately be referred to the architect for clarification. All drawings may not be reproduced or distributed without prior permission from the architect.

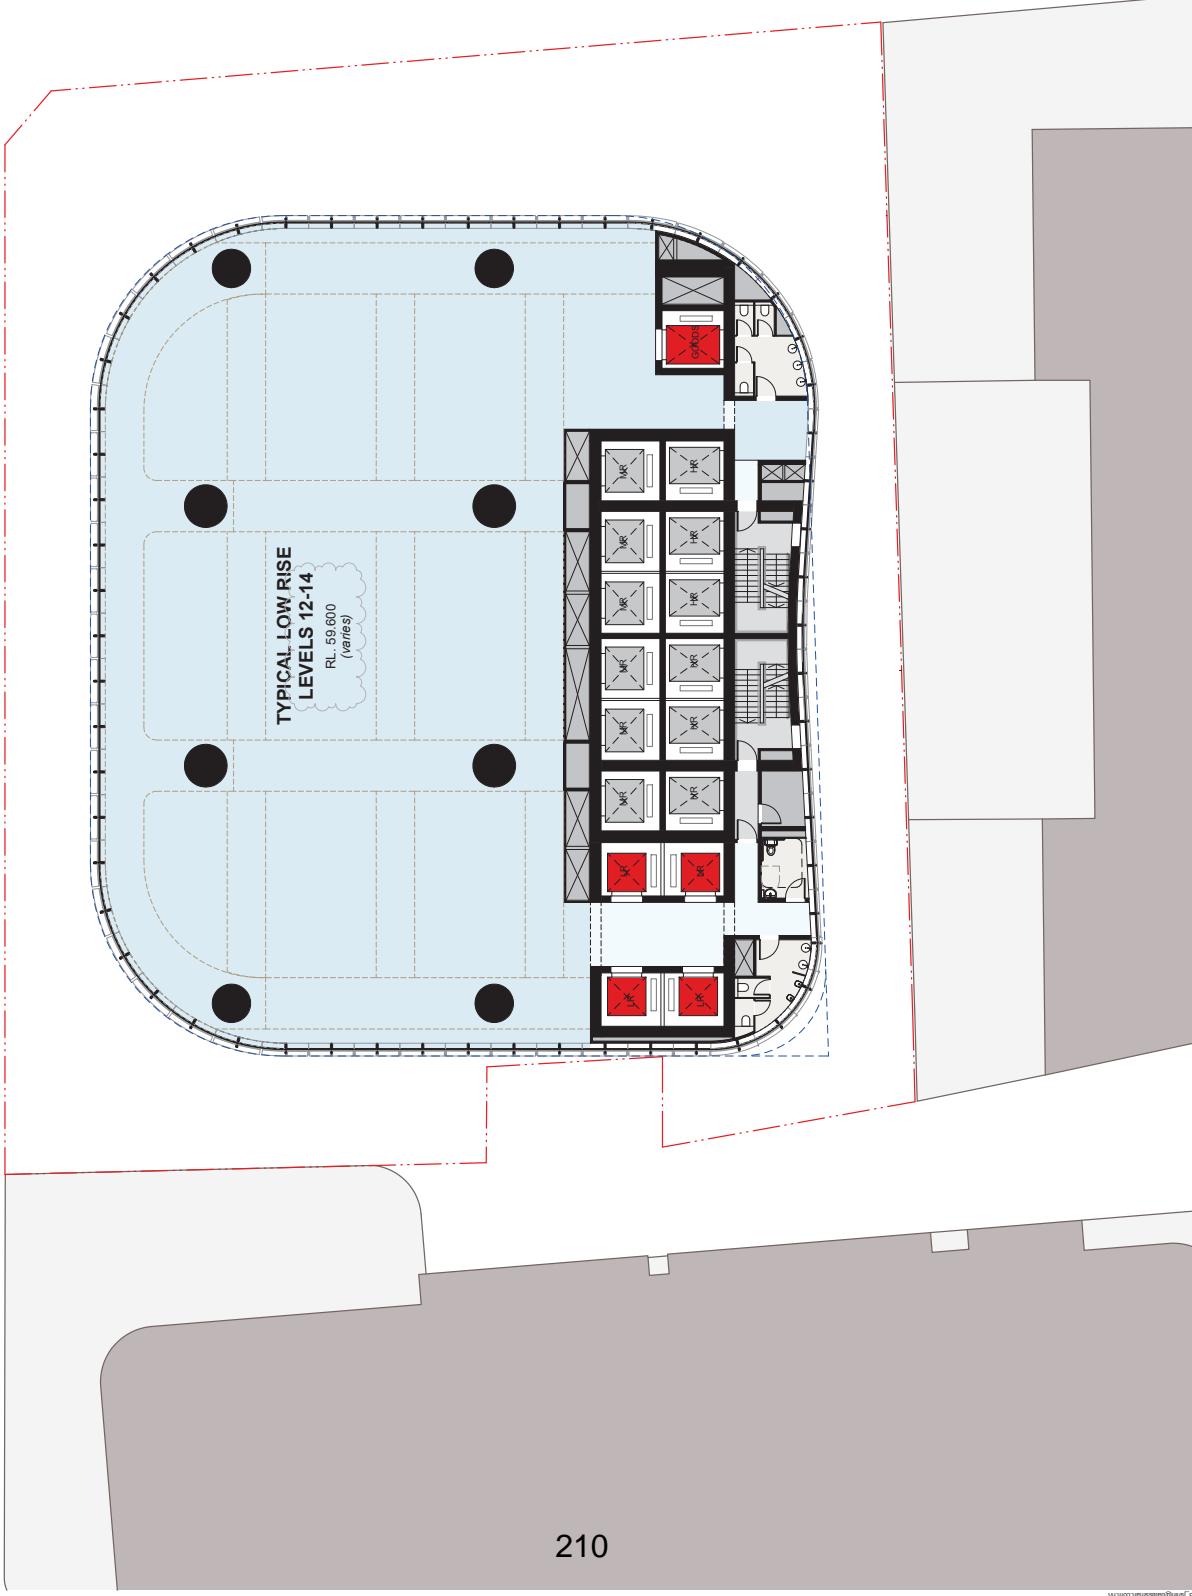

| Rev | Desc | Drawn | Checked | Initial | Checked |
|-----|--|-------|---------|---------|---------|
| B | 24/10/24 - GA Response to RFI from Council | JB | DB | | |
| | | DB | | | |
| | | DB | | | |

Hunter & Pitt



GA Plan Level 12-14 - Low Rise Typical

| | |
|-------------|-------------------------|
| Status | Development Application |
| Scale | 1:125 @ A1 |
| Drawn | AT |
| Checked | DS |
| Project No. | S12333A |
| Proj. Date | 2002/04/12 2:28:24M |
| BN | |

| | |
|---|----------|
| Drawing No. | Revision |
| A03.012 | B |
| Melbourne 1 Nicholson Street Sydney NSW 2010 Australia Melbourne VIC 3000 Australia Brisbane QLD 4000 Australia email: info@batesmart.com.au http://www.batesmart.com.au | |
| Bates Smart Architects Pty Ltd ABN 68 094 740 988 10/11 Market Street, Melbourne VIC 3000 10/11 Market Street, Brisbane QLD 4000 10/11 Market Street, Sydney NSW 2010 | |

Check all dimensions and site conditions prior to commencement of any work. The contractor is responsible for ensuring that the proposed construction complies with all applicable laws, regulations, codes of practice, and standards. Do not scale drawings - refer to listed dimensions only. Any dimensions shall immediately be referred to the architect for clarification. All drawings may not be reproduced or distributed without prior permission from the architect.

| Rev | Desc | Drawn | Checked | Initial | Date |
|-----|------------------------|-------|---------|---------|------|
| B | 2400 Hx 2400 Wx 2400 D | DR | DR | | |
| | | DR | DR | | |
| | | DR | DR | | |

Hunter & Pitt




| | |
|-------------|-------------------------|
| Status | Development Application |
| Scale | 1:125 @ A1 |
| Drawn | AT |
| Checked | DS |
| Project No. | S12333A |
| Plot Date | 20020413 12:25:37PM |
| BM | |


A03.016 Revision **B**

Bates Smart Architects Pty Ltd
 1 Nicholson Street
 Sydney NSW 2010 Australia
 Phone: +61 (0)2 9251 1234
 Email: info@batesmart.com.au
 http://www.batesmart.com.au

Bates Smart Architects Pty Ltd ABN 68 094 740 588
 123 Street, Sydney NSW 2010 Australia
 Phone: +61 (0)2 9251 1234
 Email: info@batesmart.com.au
 http://www.batesmart.com.au

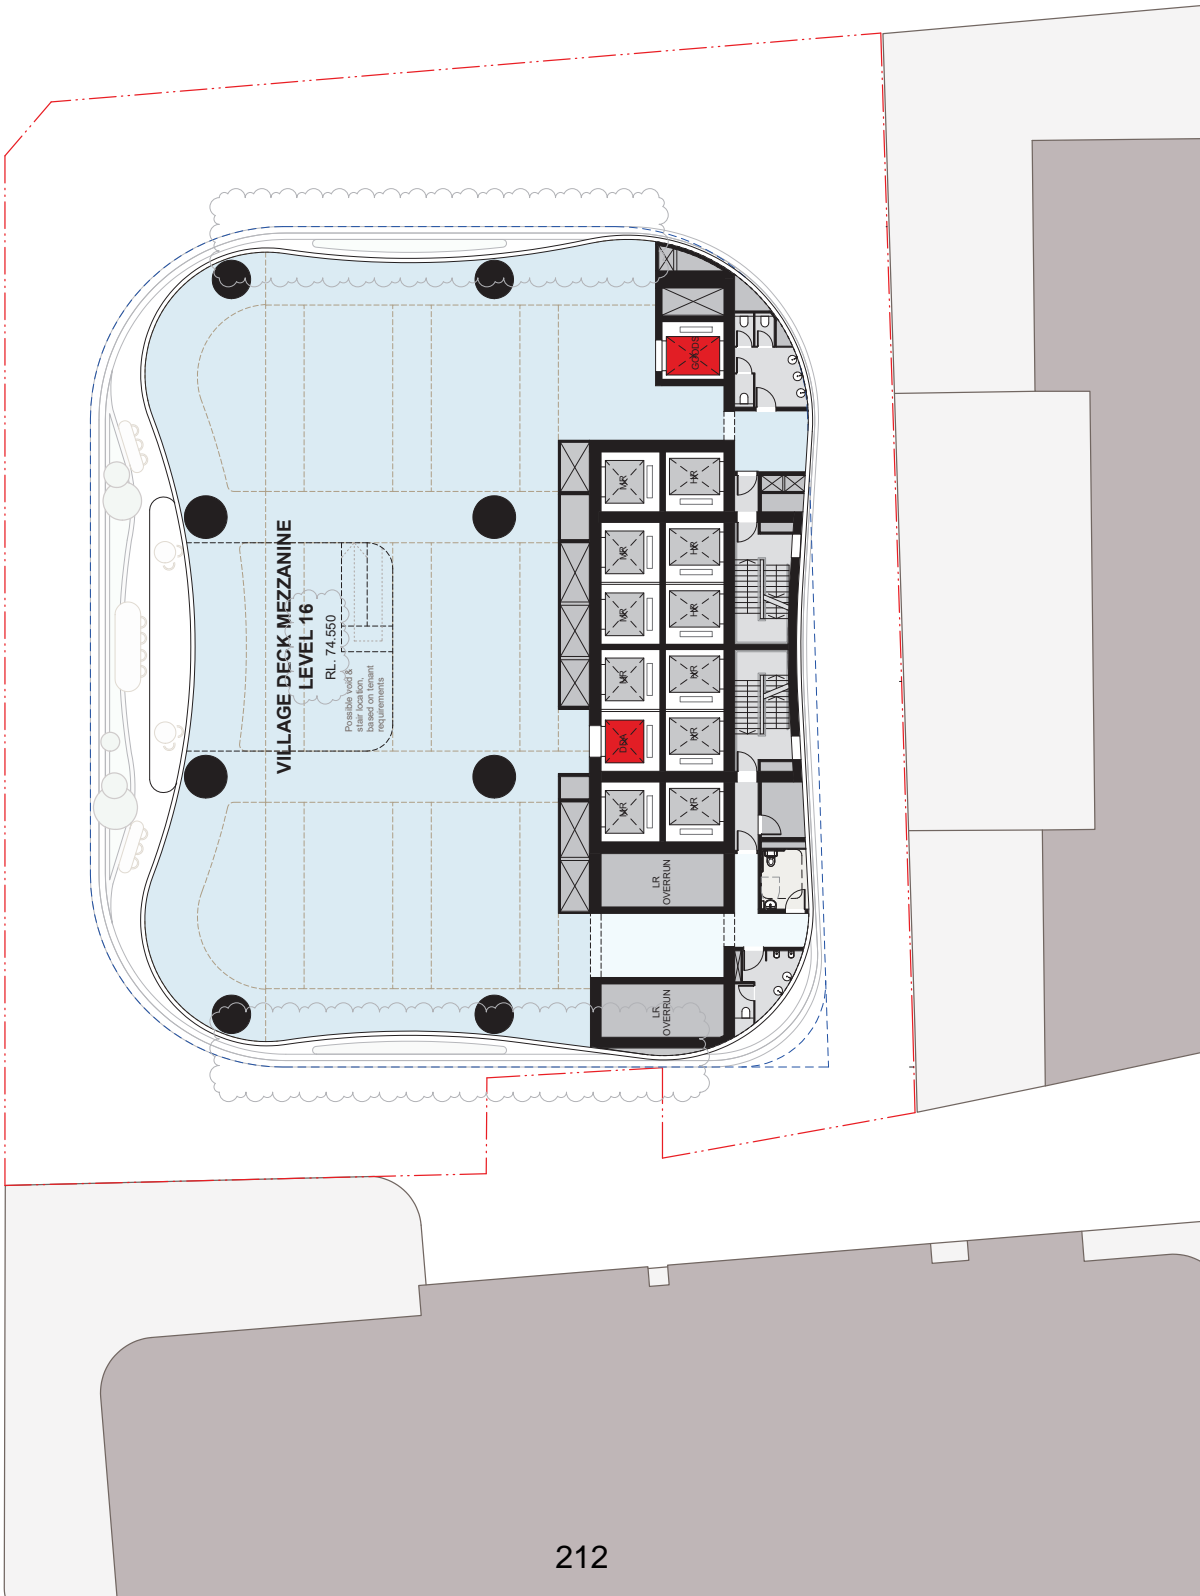

Check all dimensions and site conditions prior to commencement of any work. The contractor is responsible for ensuring that the site is suitable for the proposed development and that all necessary approvals and permits are obtained. Do not scale drawings - refer to listed dimensions only. Any discrepancies shall immediately be referred to the architect for clarification. All drawings may not be reproduced or distributed without prior permission from the architect.

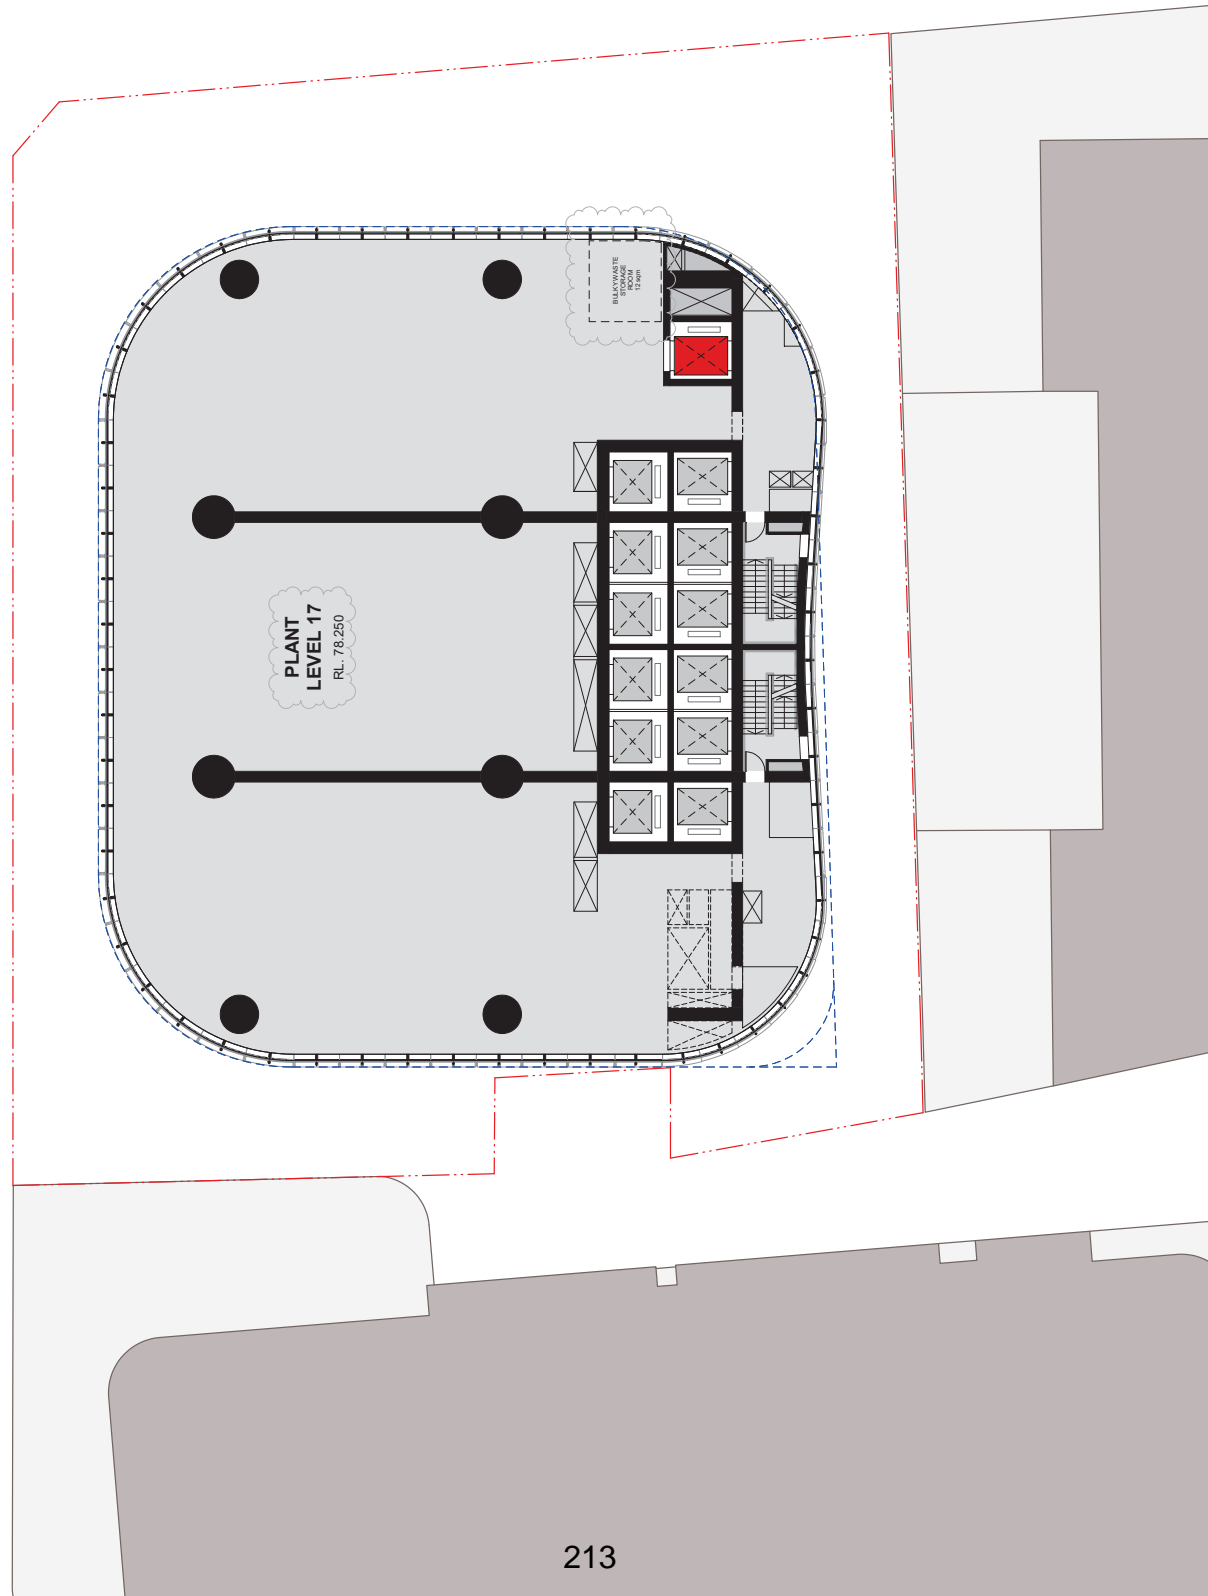

| Rev | Desc | Drawn | Checked | Initial | Checked |
|-----|---|-------|---------|---------|---------|
| B | 24/01/24: GA Response to RFI from Council | | | | |


Hunter & Pitt



| | |
|-------------|-------------------------|
| Status | Development Application |
| Scale | 1:125 @ A1 |
| Drawn | AT |
| Checked | DS |
| Project No. | S12333A |
| Proj. Date | 2002/04/12 03:37PM |
| BNV | |

A03.017 Revision
B
 Melbourne 1 Nicholson Street
 Sydney NSW 2010 Australia
 Melbourne VIC 3000 Australia
 email: info@batesmart.com.au
 email: mel@batesmart.com.au
 http://www.batesmart.com.au
Bates Smart Architects Pty Ltd ABN 68 094 740 888
 20/11/2019 11:30:00 AM
 20/11/2019 11:30:00 AM
 20/11/2019 11:30:00 AM

Check all dimensions and site conditions prior to commencement of any work. The contractor is responsible for ensuring that the design is suitable for the site and that all necessary permits and approvals are obtained. Do not scale drawings - refer to listed dimensions only. Any discrepancies shall immediately be referred to the architect for clarification. All drawings may not be reproduced or distributed without prior permission from the architect.

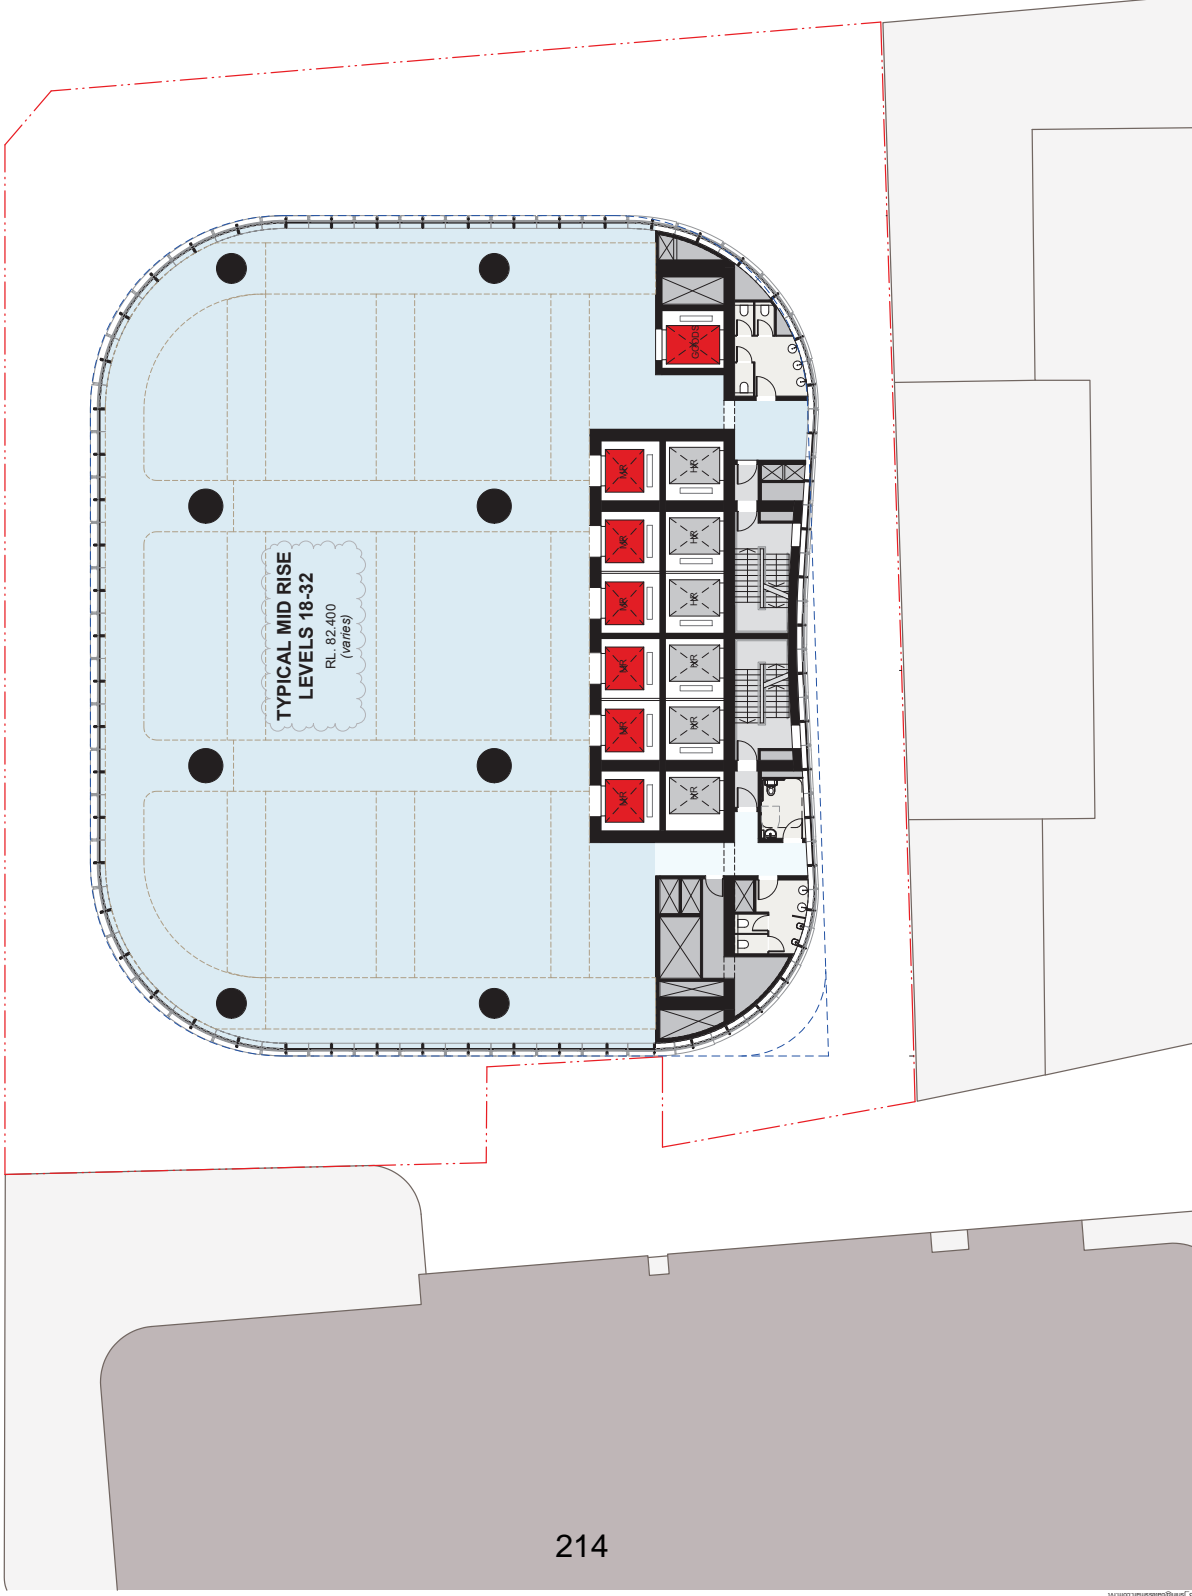

| Rev | Desc | Drawn | Checked | Initial | Checked |
|-----|---|-------|---------|---------|---------|
| B | 24/01/18, GA Response to RFI from Council | | | | |
| | | | | | |

Hunter & Pitt


GA Plan
Level 18-32 - Mid Rise Typical

| | |
|-------------|-------------------------|
| Status | Development Application |
| Scale | 1:125 @ A1 |
| Drawn | AT |
| Checked | DS |
| Project No. | S12333A |
| Proj. Date | 2002/04/13 to 18/14 |
| BM | |

Drawing No. **A03.018** Revision **B**
 Melbourne 1 Nicholson Street
 Sydney NSW 2010 Australia
 Melbourne VIC 3000 Australia
 email info@batesmart.com.au
<http://www.batesmart.com.au>
 Bates Smart Architects Pty Ltd ABN 68 094 740 888
 10/11 Market Street, Melbourne VIC 3000
 10/11 Market Street, Sydney NSW 2010

Check all dimensions and site conditions prior to commencement of any work. The contractor is responsible for ensuring that the design is in accordance with the relevant codes of practice and standards. The contractor is responsible for ensuring that the design is in accordance with the relevant codes of practice and standards. The contractor is responsible for ensuring that the design is in accordance with the relevant codes of practice and standards.

Do not scale drawings - refer to listed dimensions only. Any dimensions shall immediately be referred to the architect for clarification. All drawings may not be reproduced or distributed without prior permission from the architect.

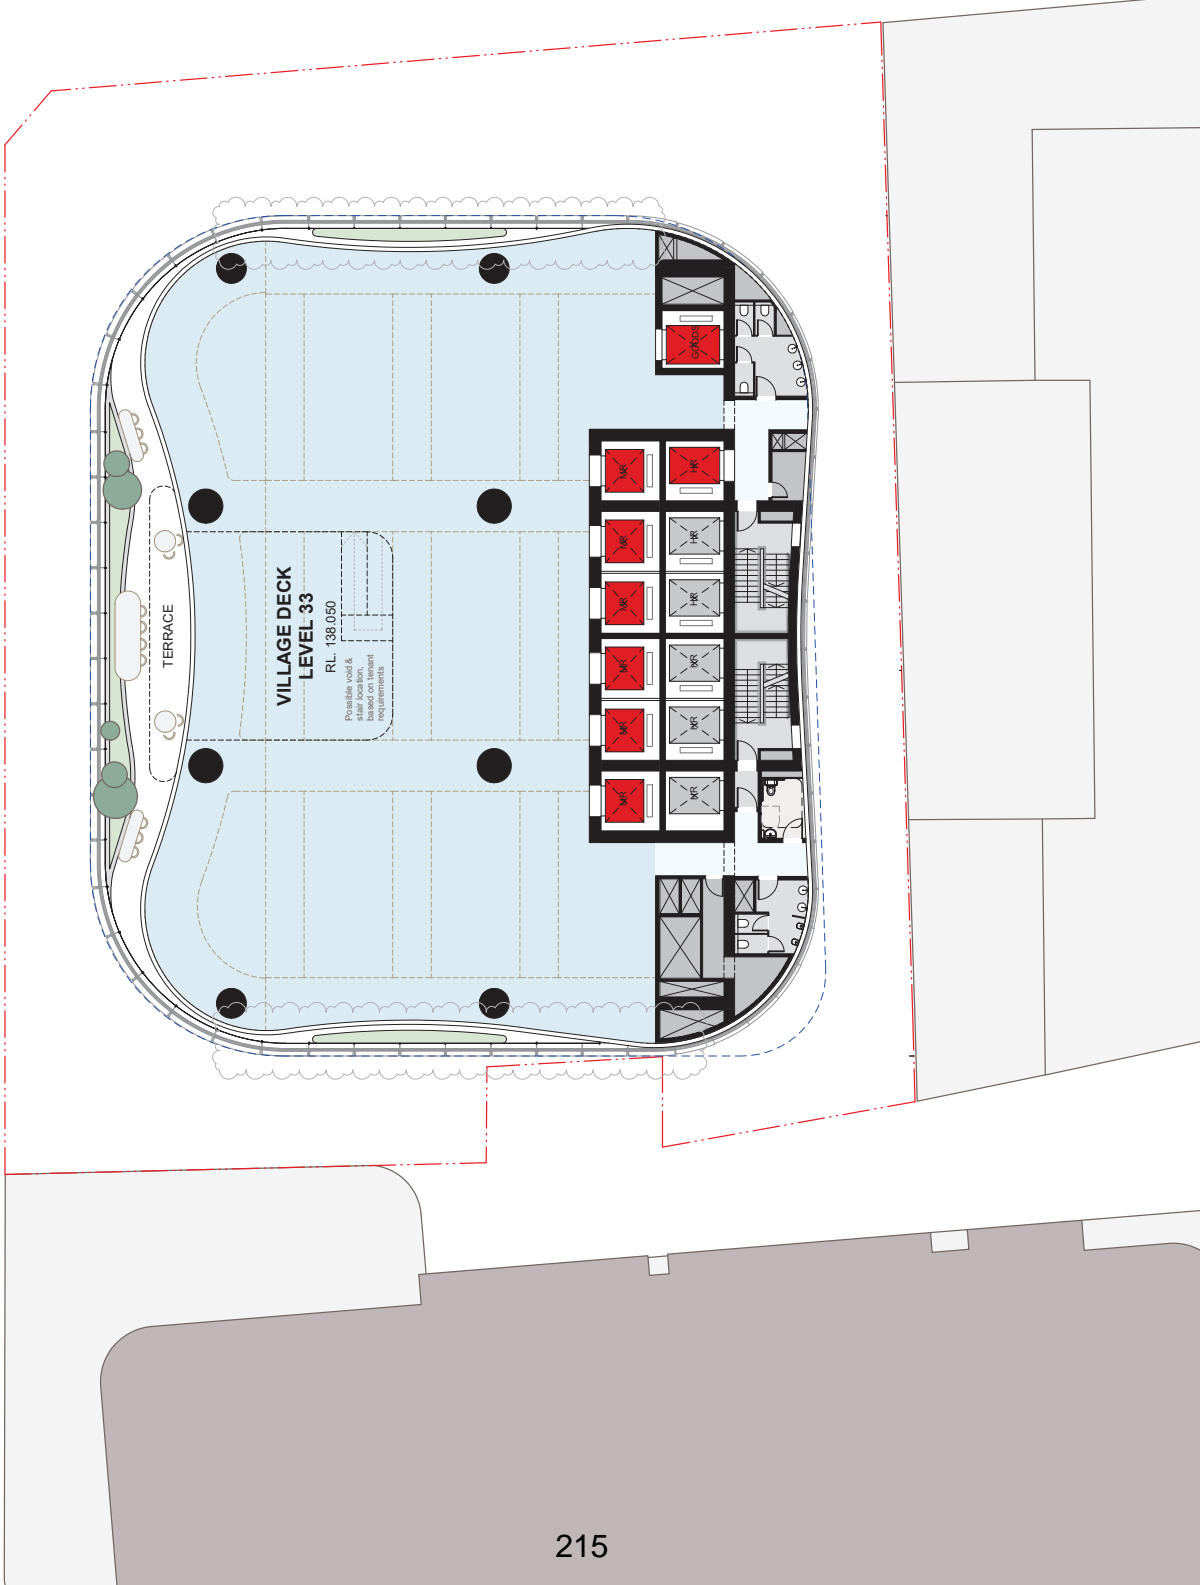

| Rev | Desc | Drawn | Checked | Initial | Checked |
|-----|--|-------|---------|---------|---------|
| B | 24/01/24: GA Requests RFI from Council | | | | |
| | | | | | |
| | | | | | |

Hunter & Pitt


GA Plan
Level 33 - Village Deck



| | |
|-------------|-------------------------|
| Status | Development Application |
| Scale | 1:125 @ A1 |
| Drawn | AT |
| Checked | DS |
| Project No. | S12333A |
| Proj. Date | 2002/04/13 2:27PM |
| BNF | |

| Drawing No. | Revision |
|---|----------|
| A03.033 | B |
| Melbourne 1 Nicholson Street Sydney NSW 2010 Australia Melbourne VIC 3000 Australia email: info@batesmart.com.au email: sydney@batesmart.com.au http://www.batesmart.com.au | |
| Bates Smart Architects Pty Ltd ABN 68 094 740 588 10/110 Wattle Street, Wattle Park, VIC 3168 10/110 Wattle Street, Wattle Park, VIC 3168 | |

Check all dimensions and site conditions prior to commencement of any work. The contractor shall be responsible for ensuring that the drawings are in accordance with the latest specifications and standards. Do not scale drawings - refer to listed dimensions only. Any discrepancies shall immediately be referred to the architect for clarification. All drawings may not be reproduced or distributed without prior permission from the architect.

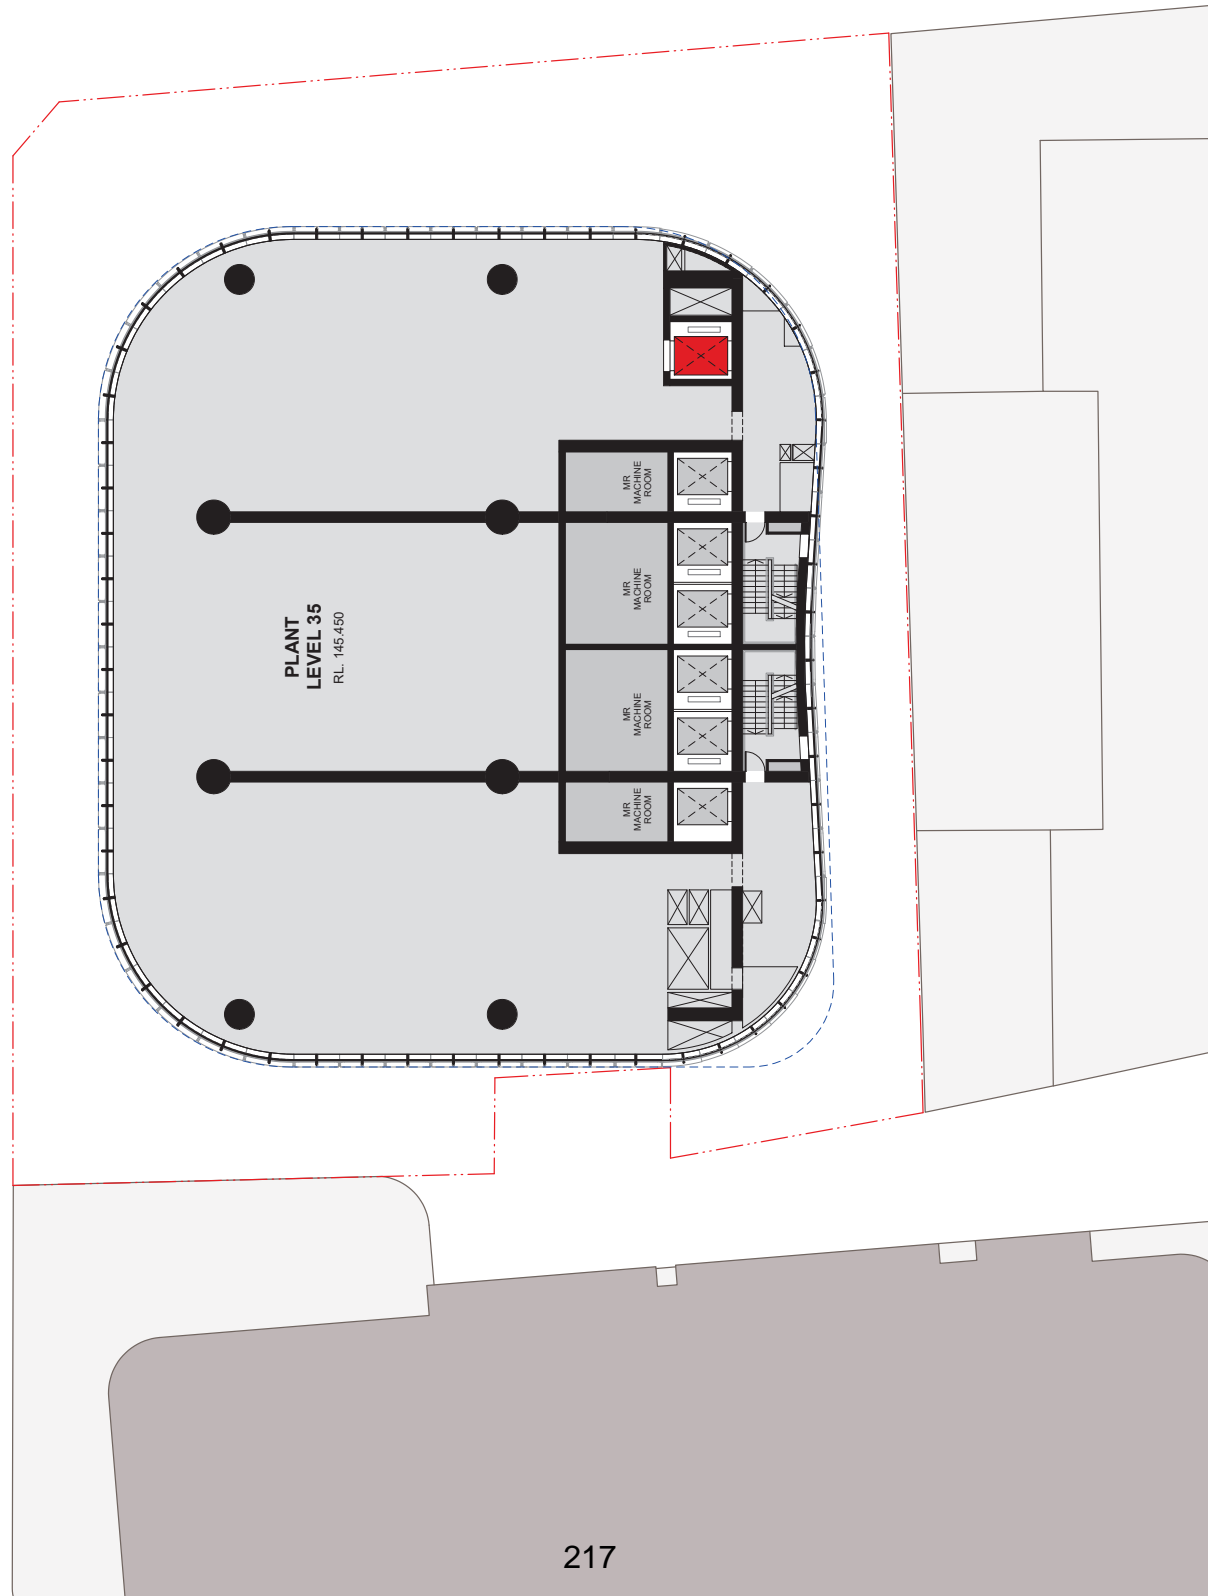

| Rev | Desc | Drawn | Checked | Initial | Checked |
|-----|---|-------|---------|---------|---------|
| B | 24/01/24: GA Response to RFI from Council | | | | |

Hunter & Pitt

GA Plant Level 35 - Plant




| | |
|-------------|-------------------------|
| Status | Development Application |
| Scale | 1:125 @ A1 |
| Drawn | AT |
| Checked | DS |
| Project No. | S12333A |
| Proj. Date | 2002/04/12 12:48:34 PM |
| Rev | |

| Drawing No. | Revision |
|----------------|----------|
| A03.035 | B |

Melbourne 1 Nicholson Street
 Melbourne VIC 3000 Australia
 Phone: +61 (0)3 9412 3600
 Email: info@batesmart.com.au
 http://www.batesmart.com.au

Bates Smart Architects Pty Ltd ABN 68 094 740 588
 10/110 Spring Street, Melbourne VIC 3000
 Phone: +61 (0)3 9412 3600

Check all dimensions and site conditions prior to commencement of any work. The contractor is responsible for ensuring that the dimensions and site conditions are as shown on the drawings. The contractor is responsible for ensuring that the dimensions and site conditions are as shown on the drawings. The contractor is responsible for ensuring that the dimensions and site conditions are as shown on the drawings.

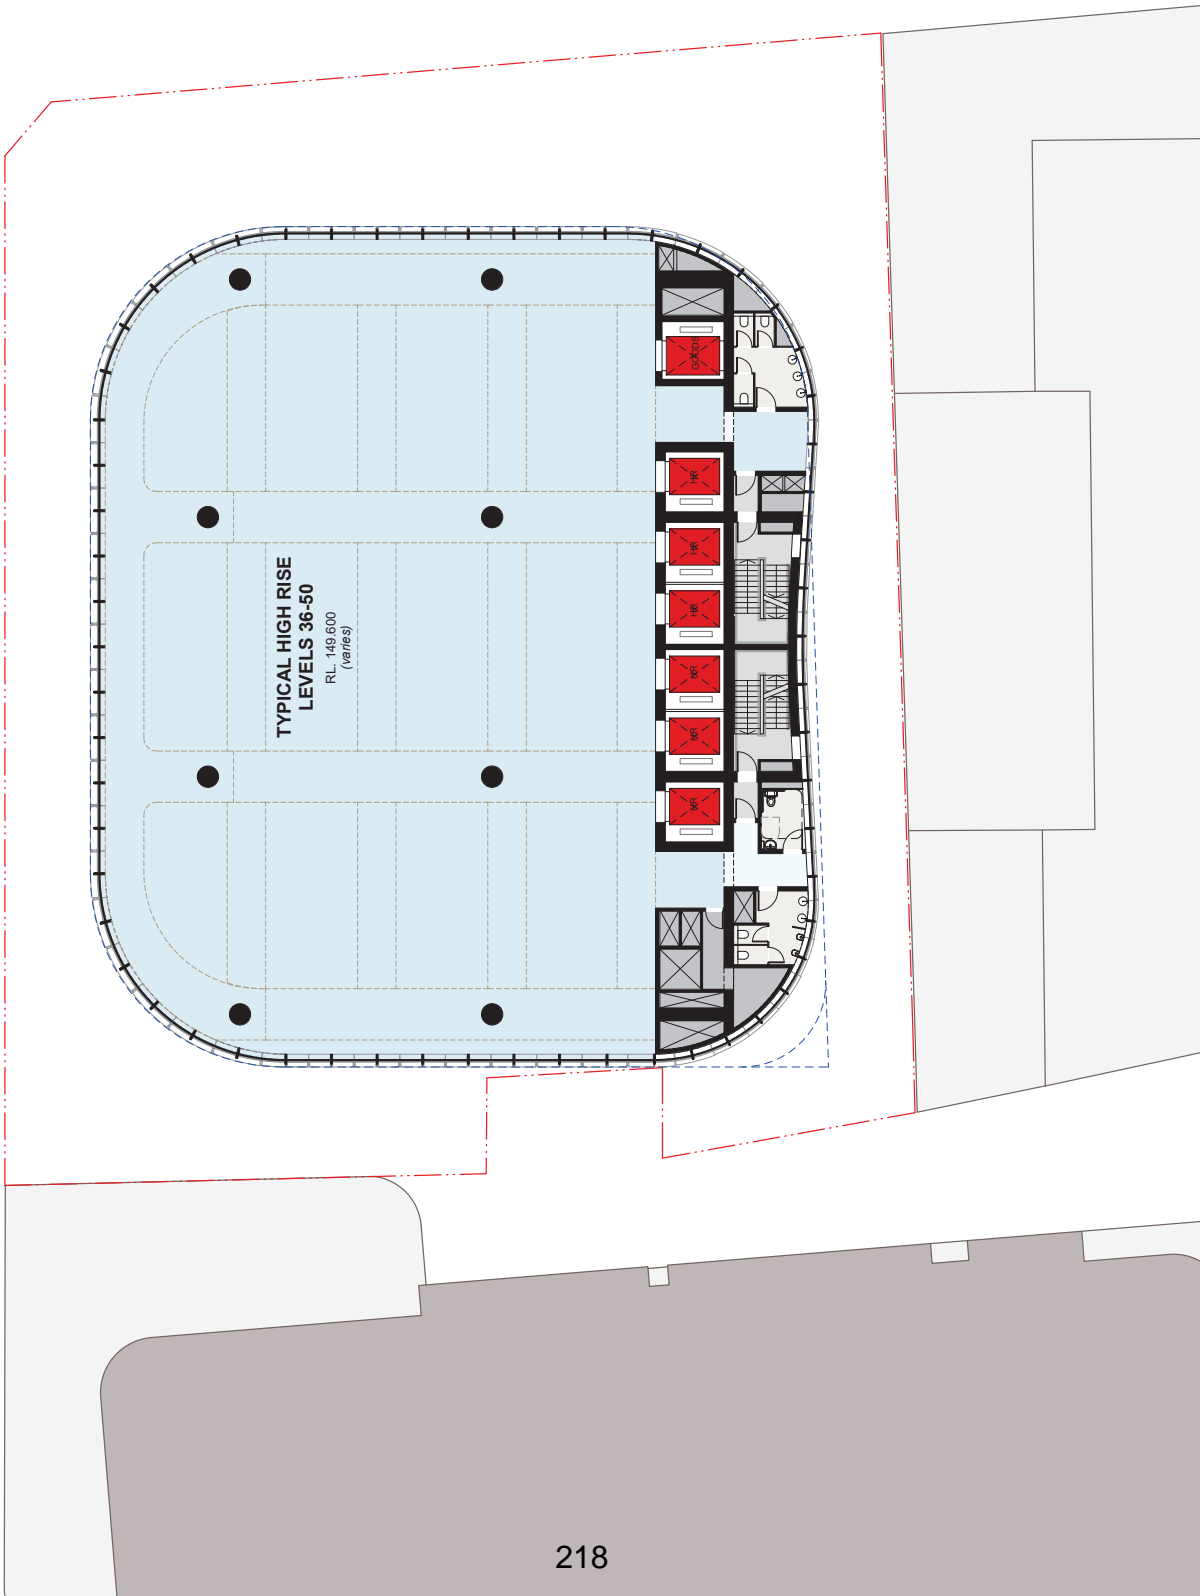

TYPICAL HIGH RISE
LEVELS 36-50
RL: 145.6100
(varies)

| Rev | Desc | Drawn | Checked | Initial | Checked |
|-----|---|-------|---------|---------|---------|
| B | 24/01/18, GA Response to RFI from Council | JB | DB | | |
| | | DB | | | |

Hunter & Pitt

GA Plan
Level 36-50 - Typical High Rise




| | |
|-------------|-------------------------|
| Status | Development Application |
| Scale | 1:125 @ A1 |
| Drawn | AT |
| Checked | DS |
| Project No. | S12333A |
| Plot Date | 2002/04/12 12:58:59PM |
| BNF | |

| Drawing No. | Revision |
|----------------|----------|
| A03.036 | B |

Melbourne 1 Nicholson Street
 Sydney NSW 2010 Australia
 Melbourne VIC 3000 Australia
 email: info@batesmart.com.au
 email: syd@batesmart.com.au
 http://www.batesmart.com.au

Bates Smart Architects Pty Ltd ABN 68 094 740 588
 10/110 Collins Street, Melbourne VIC 3000 Australia
 10/110 Collins Street, Melbourne VIC 3000 Australia

Check all dimensions and site conditions prior to commencement of any work. The contractor shall be responsible for ensuring that all dimensions and site conditions are as shown on this drawing. Any discrepancies shall be immediately referred to the architect. All drawings may not be reproduced or distributed without prior permission from the architect.

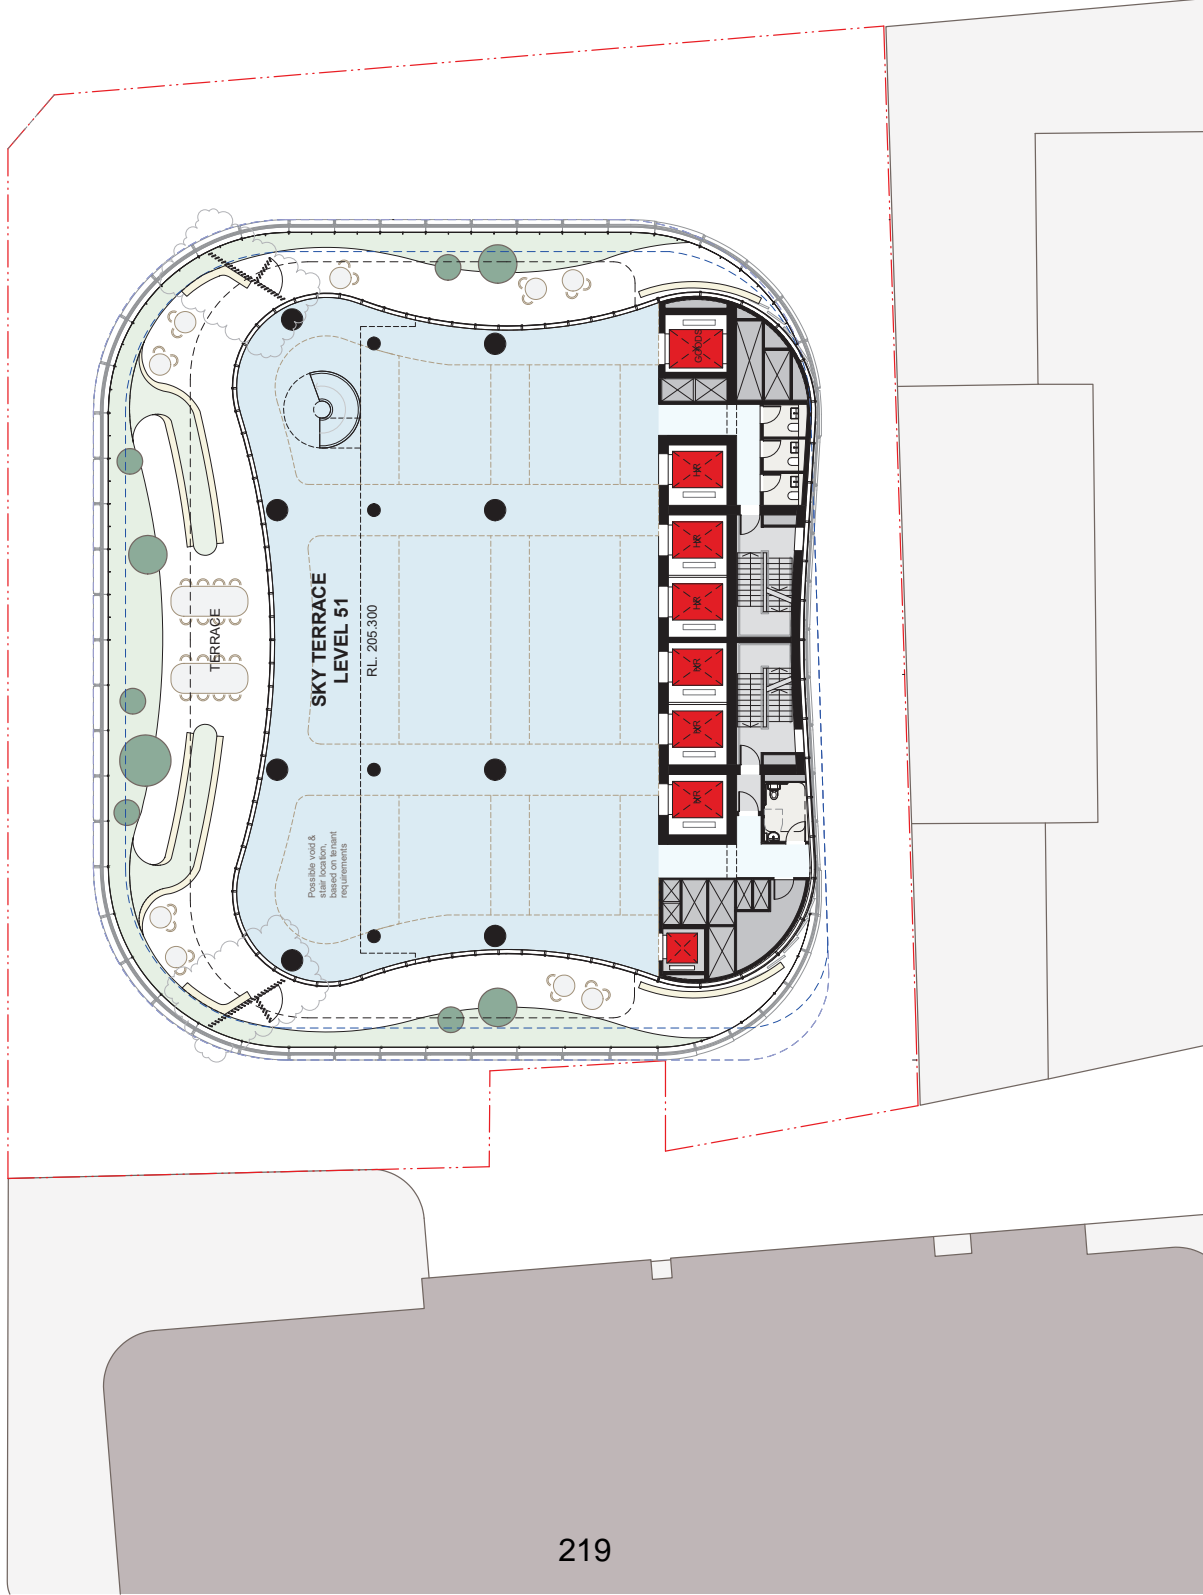


Check all dimensions and site conditions prior to commencement of any work. The contractor shall be responsible for ensuring that all dimensions and site conditions are as shown on this drawing. Any discrepancies shall be immediately referred to the architect. All drawings may not be reproduced or distributed without prior permission from the architect.

24/01/24 GA Response to RFI from Council
 Row Draw Description Initial Checked

GA Plan
 Level 51 - Sky Terrace

 Hunter & Pitt



| | |
|----------------|-------------------------|
| Status | Development Application |
| Scale | 1:125 @ A1 |
| Drawn | AT |
| Checked | DS |
| Project No. | S12333A |
| Plot Date | 2002/04/12 08:04PM |
| BNV | |
| Drawing No. | Revision |
| A03.051 | B |

Melbourne 1 Nicholson Street
 Melbourne VIC 3000 Australia
 Sydney 43 Brisbane Street
 Sydney NSW 2010 Australia
 email mel@batesmart.com.au
<http://www.batesmart.com.au>

Bates Smart Architects Pty Ltd ABN 68 094 740 888
 20/100 Victoria Road, North Sydney NSW 1585
 20/100 Victoria Road, North Sydney NSW 1585

Check all dimensions and site conditions prior to commencement of any work. The contractor is responsible for ensuring that all dimensions are correct and that all site conditions are suitable for the proposed development. All dimensions shall be based on the latest approved plans and specifications. Do not scale drawings - refer to listed dimensions only. Any discrepancies shall immediately be referred to the architect for clarification. All drawings may not be reproduced or distributed without prior permission from the architect.

| Rev | Description | Drawn | Checked | Date |
|-----|--|-------|---------|------|
| B | 2400 Hx GA Revisions to RFL from Council | | | |
| | | | | |
| | | | | |
| | | | | |
| | | | | |

Hunter & Pitt

GA Plan
Level 52 - Sky Terrace Mezzanine




| | |
|-------------|-------------------------|
| Status | Development Application |
| Scale | 1:125 @ A1 |
| Drawn | AT |
| Checked | DS |
| Project No. | S123353A |
| Plot Date | 2005204 13:28:00PM |
| BNR | |

| Drawing No. | Revision |
|----------------|----------|
| A03.052 | B |

Melbourne 1 Nicholson Street
 Melbourne VIC 3000 Australia
 Sydney 43 Brisbane Street
 Sydney NSW 2010 Australia
 email: info@batesmart.com.au
 http://www.batesmart.com.au

Bates Smart Architects Pty Ltd ABN 68 094 740 588
 20/100 Wattle Street, Wattle Park VIC 3086
 20/100 Wattle Street, Wattle Park VIC 3086

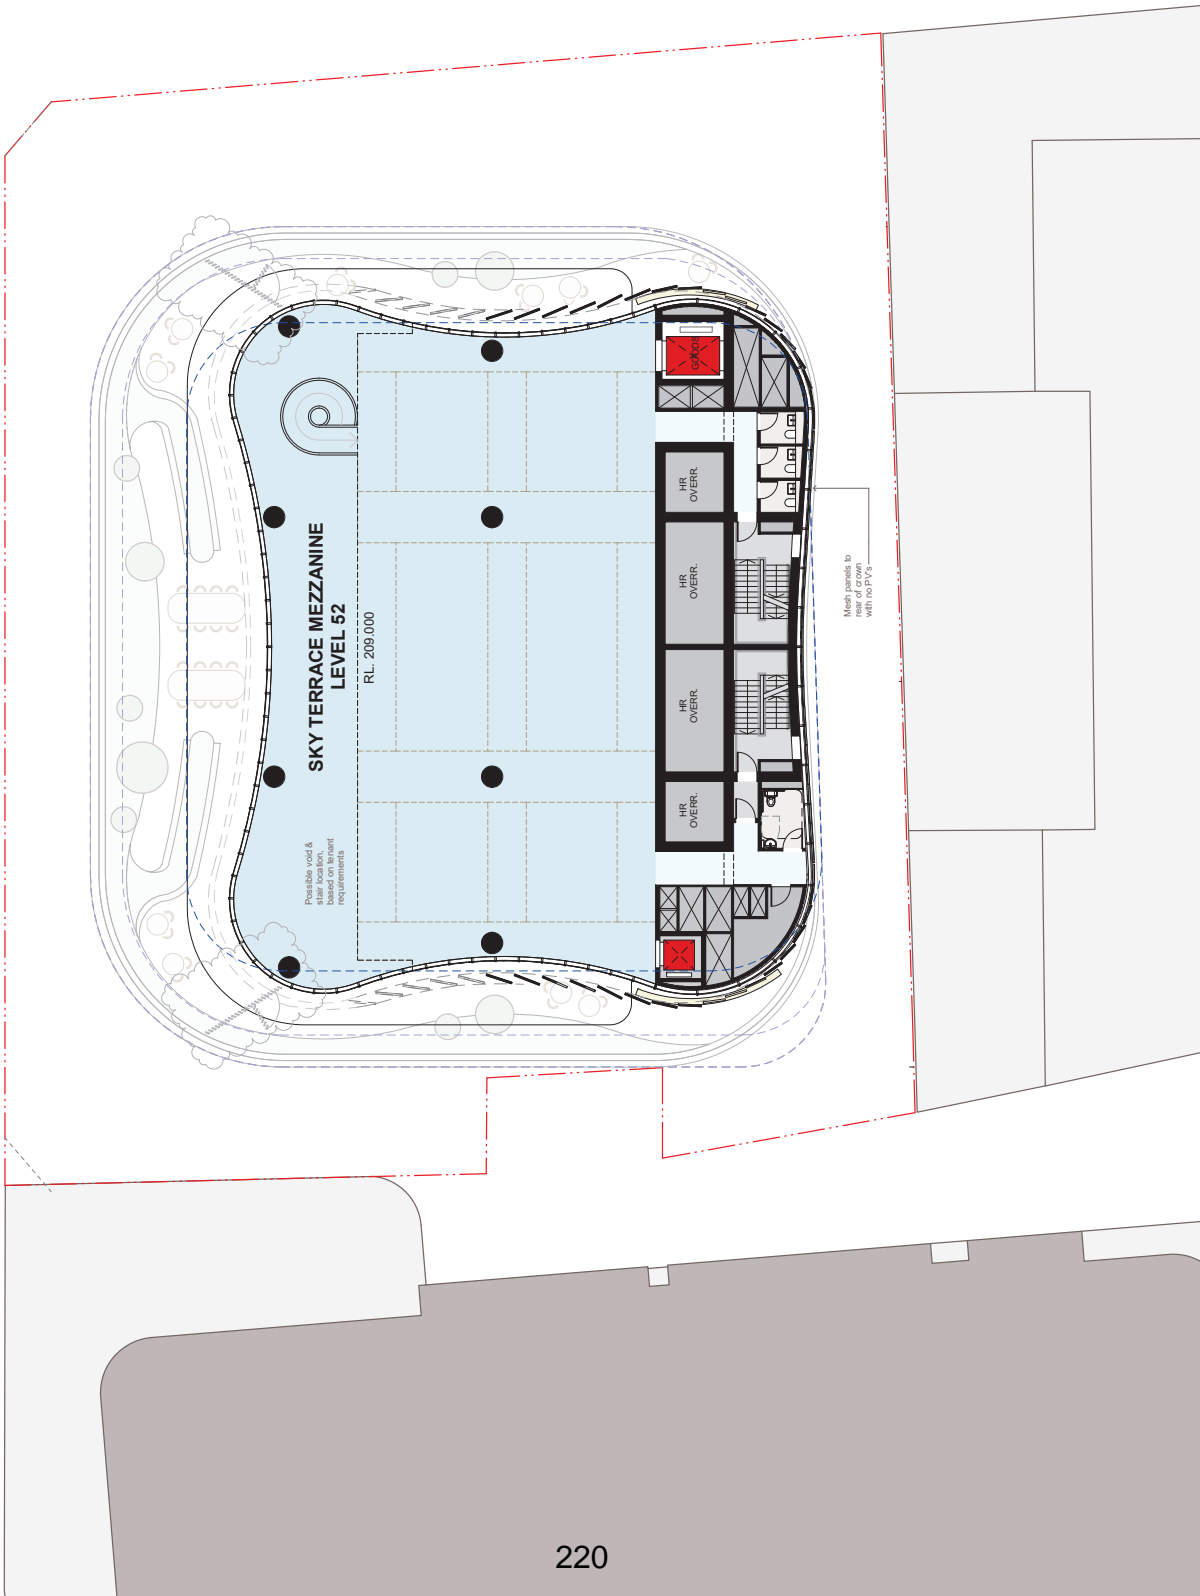

Check all dimensions and site conditions prior to commencement of any work.
 The contractor is responsible for ensuring that all dimensions and site conditions are correct.
 Do not scale drawings - refer to listed dimensions only. Any discrepancies shall immediately be referred to the architect for clarification.
 All drawings may not be reproduced or distributed without prior permission from the architect.

| Rev | Desc | Drawn | Checked | Initial | Checked |
|-----|---|-------|---------|---------|---------|
| B | 2400 Hrs. DA Response to RFI from Council | | | | |

Hunter & Pitt

GA Plan
 Level 53 - Plant




| | |
|-------------|-------------------------|
| Status | Development Application |
| Scale | 1:125 @ A1 |
| Drawn | AT |
| Checked | DS |
| Project No. | S12333A |
| Proj. Date | 2002/04/12 2:24 PM |
| BNF | |

| Drawing No. | Revision |
|----------------|----------|
| A03.053 | B |

Melbourne 1 Nicholson Street
 Melbourne VIC 3000 Australia
 Phone: +61 (0)3 9412 3600
 Email: info@batesmart.com.au
 http://www.batesmart.com.au

Bates Smart Architects Pty Ltd ABN 68 094 740 888
 20/199 Sturt Street, Melbourne VIC 3000
 Phone: +61 (0)3 9412 3600
 Fax: +61 (0)3 9412 3601
 Email: info@batesmart.com.au
 http://www.batesmart.com.au

BATESMART

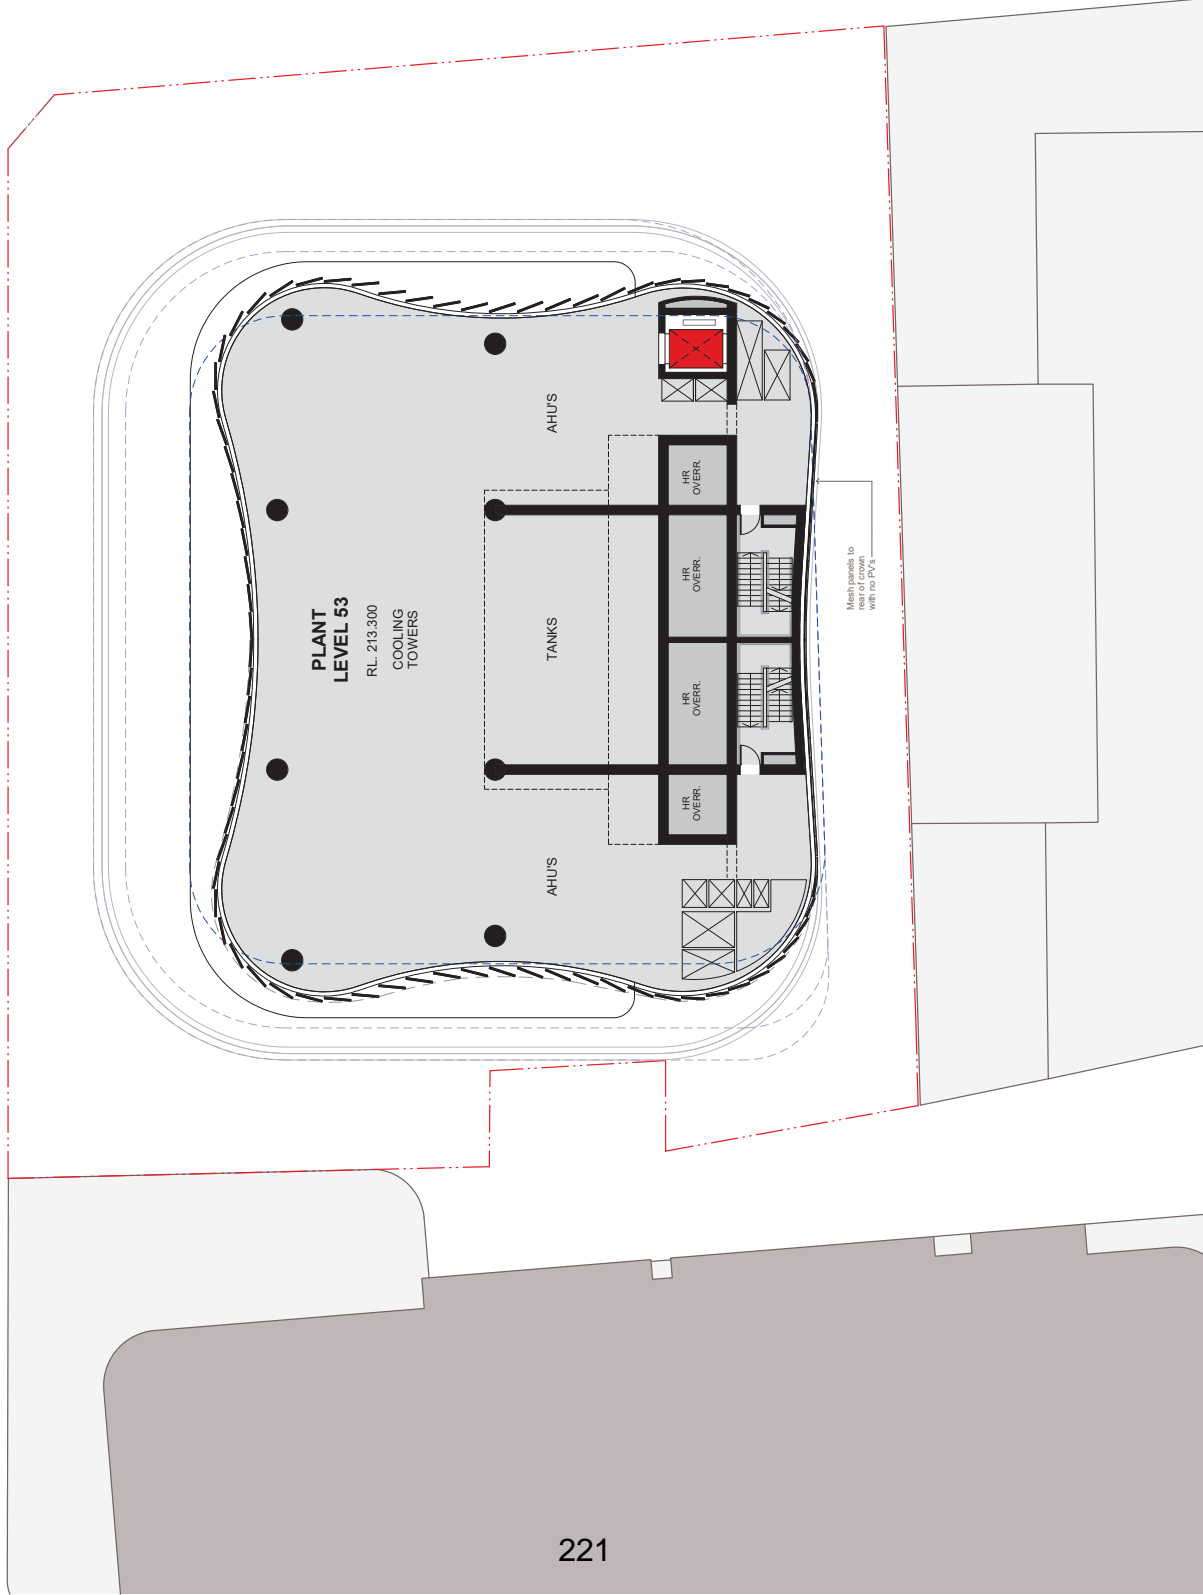

Check all dimensions and site conditions prior to commencement of any work. The contractor is responsible for ensuring that the drawings are in accordance with the current codes of practice and standards. The contractor shall be responsible for obtaining all necessary permits and approvals. Do not scale drawings - refer to listed dimensions only. Any discrepancies shall immediately be referred to the architect for clarification. All drawings may not be reproduced or distributed without prior permission from the architect.

| Rev | Desc | Drawn | Checked | Initial | Date |
|-----|---|-------|---------|---------|------|
| B | 24/01/24: GA Response to RFI from Council | | | | |

Hunter & Pitt

GA Plan
Level 54 - Plant




| | |
|-------------|-------------------------|
| Status | Development Application |
| Scale | 1:125 @ A1 |
| Drawn | AT |
| Checked | DS |
| Project No. | S12333A |
| Proj. Date | 2002/04/12 09:34PM |
| BM | |

| Drawing No. | Revision |
|-------------|----------|
| A03.054 | B |


Melbourne 1 Nicholson Street
 Sydney Hills NSW 2010 Australia
 Phone: +61 (0)2 9550 2000
 Email: info@batesmart.com.au
 http://www.batesmart.com.au

Bates Smart Architects Pty Ltd ABN 68 094 740 588
 20/11 Sturt Street, Sydney NSW 1510
 Phone: +61 (0)2 9550 2000
 Fax: +61 (0)2 9550 2001
 Email: info@batesmart.com.au
 Website: www.batesmart.com.au

BATESMART

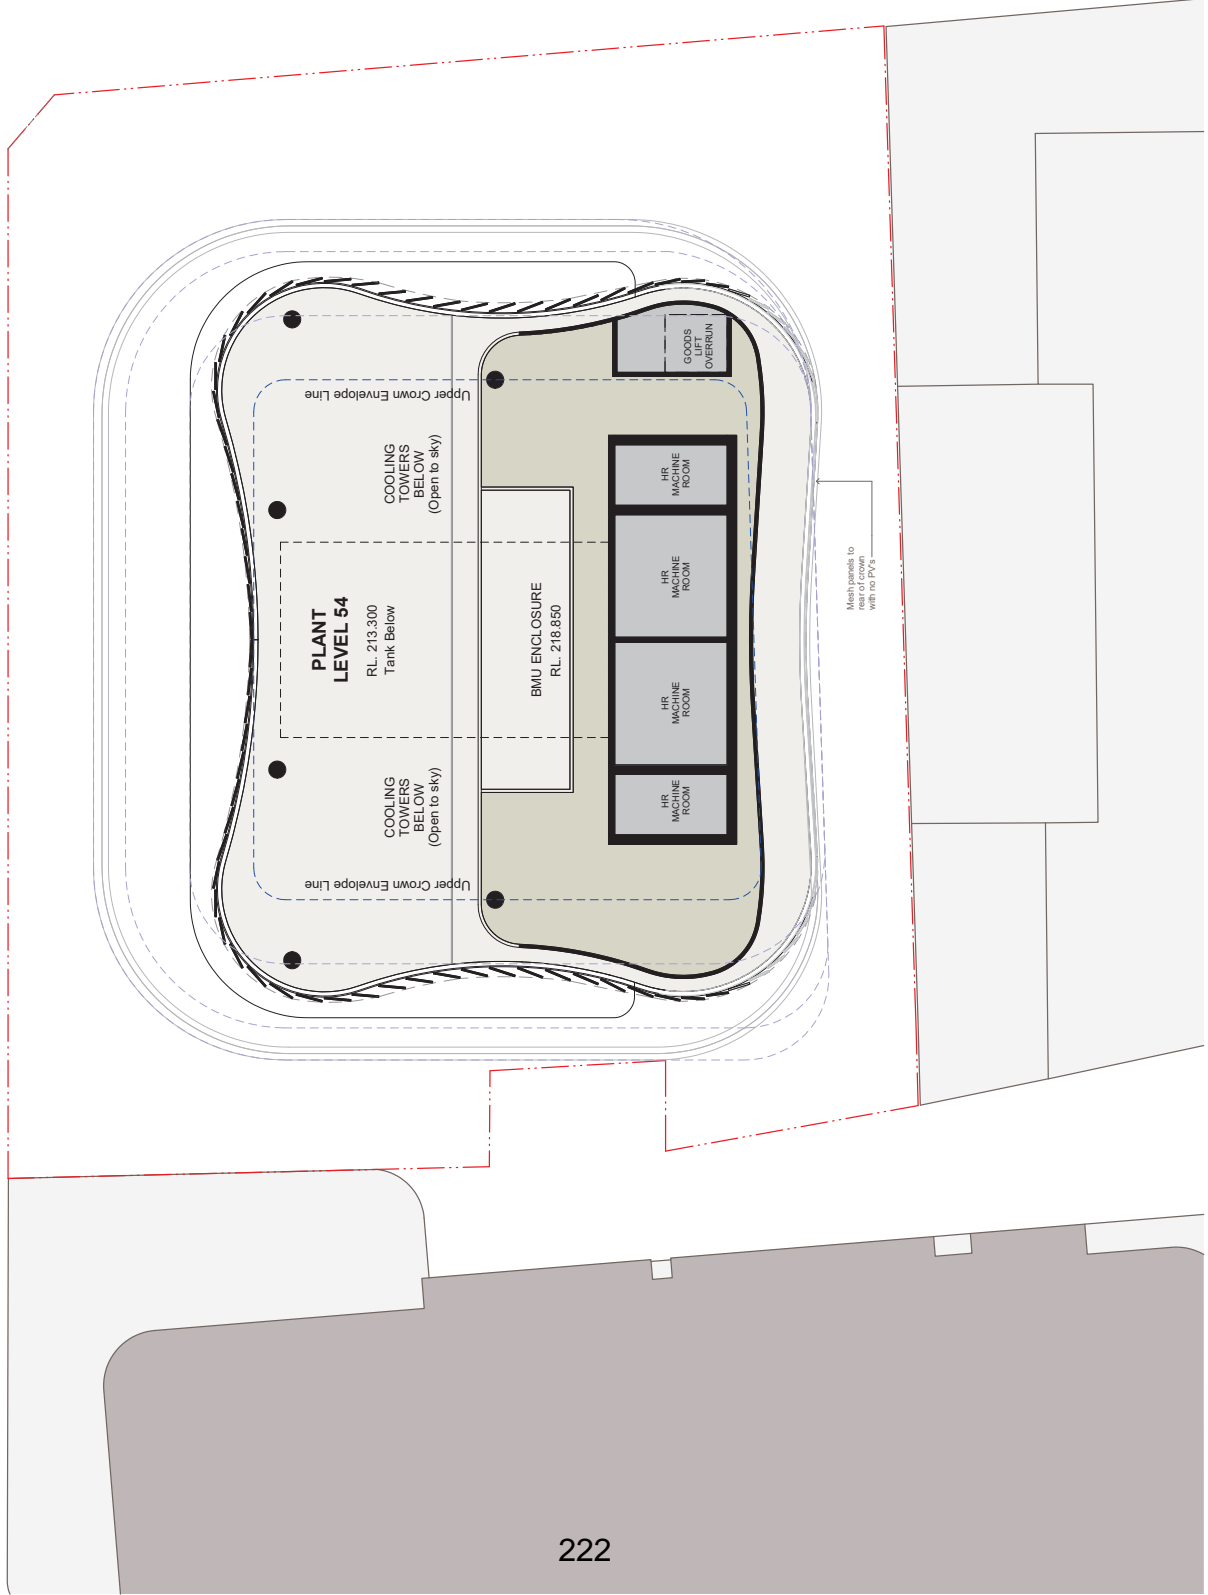

Check all dimensions and site conditions prior to commencement of any work. The contractor shall be responsible for ensuring that all dimensions and site conditions are correct. Do not scale drawings - refer to listed dimensions only. Any discrepancies shall immediately be referred to the architect for clarification. All drawings may not be reproduced or distributed without prior permission from the architect.

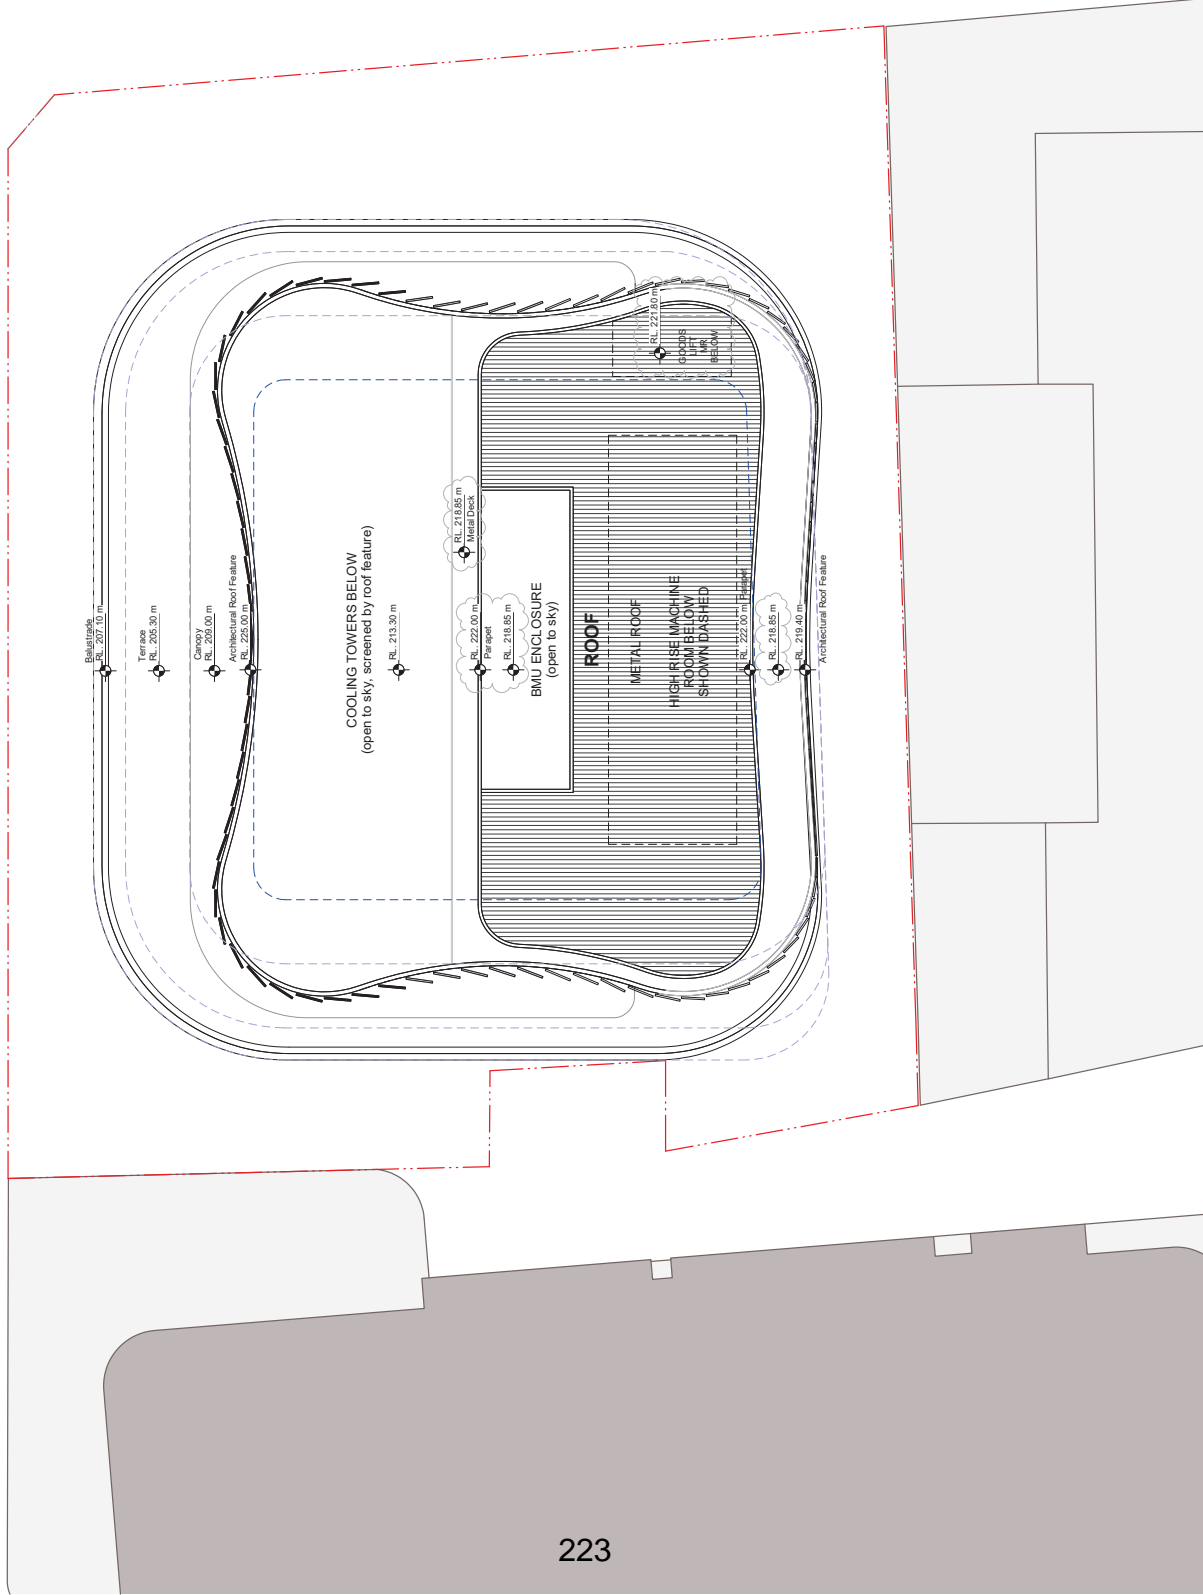

| Rev | Desc | Drawn | Checked | Initial | Checked |
|-----|--|-------|---------|---------|---------|
| B | 24/01/24 - GA Response to RFI from Council | JB | DB | | |

Hunter & Pitt

GA Plan
Roof




| | |
|-------------|-------------------------|
| Status | Development Application |
| Scale | 1:125 @ A1 |
| Drawn | AT |
| Checked | DS |
| Project No. | S12333A |
| Proj. Date | 2002/04/12 2:43PM |
| BM | |

| Drawing No. | Revision |
|-------------|----------|
| A03.055 | B |

Bates Smart Architects Pty Ltd ABN 68 094 740 988
 20/100 Pitt Street Sydney NSW 2000
 Sydney NSW 2000 Australia
 Tel: +61 (0)2 9250 9000
 Fax: +61 (0)2 9250 9001
 email: info@batesmart.com.au
 http://www.batesmart.com.au

Check all dimensions and site conditions prior to commencement of any work. Any variations or omissions to the drawings shall be the responsibility of the client. Do not scale drawings - refer to figured dimensions only. Any discrepancies shall immediately be referred to the architect for clarification. All drawings may not be reproduced or distributed without prior permission from the architect.

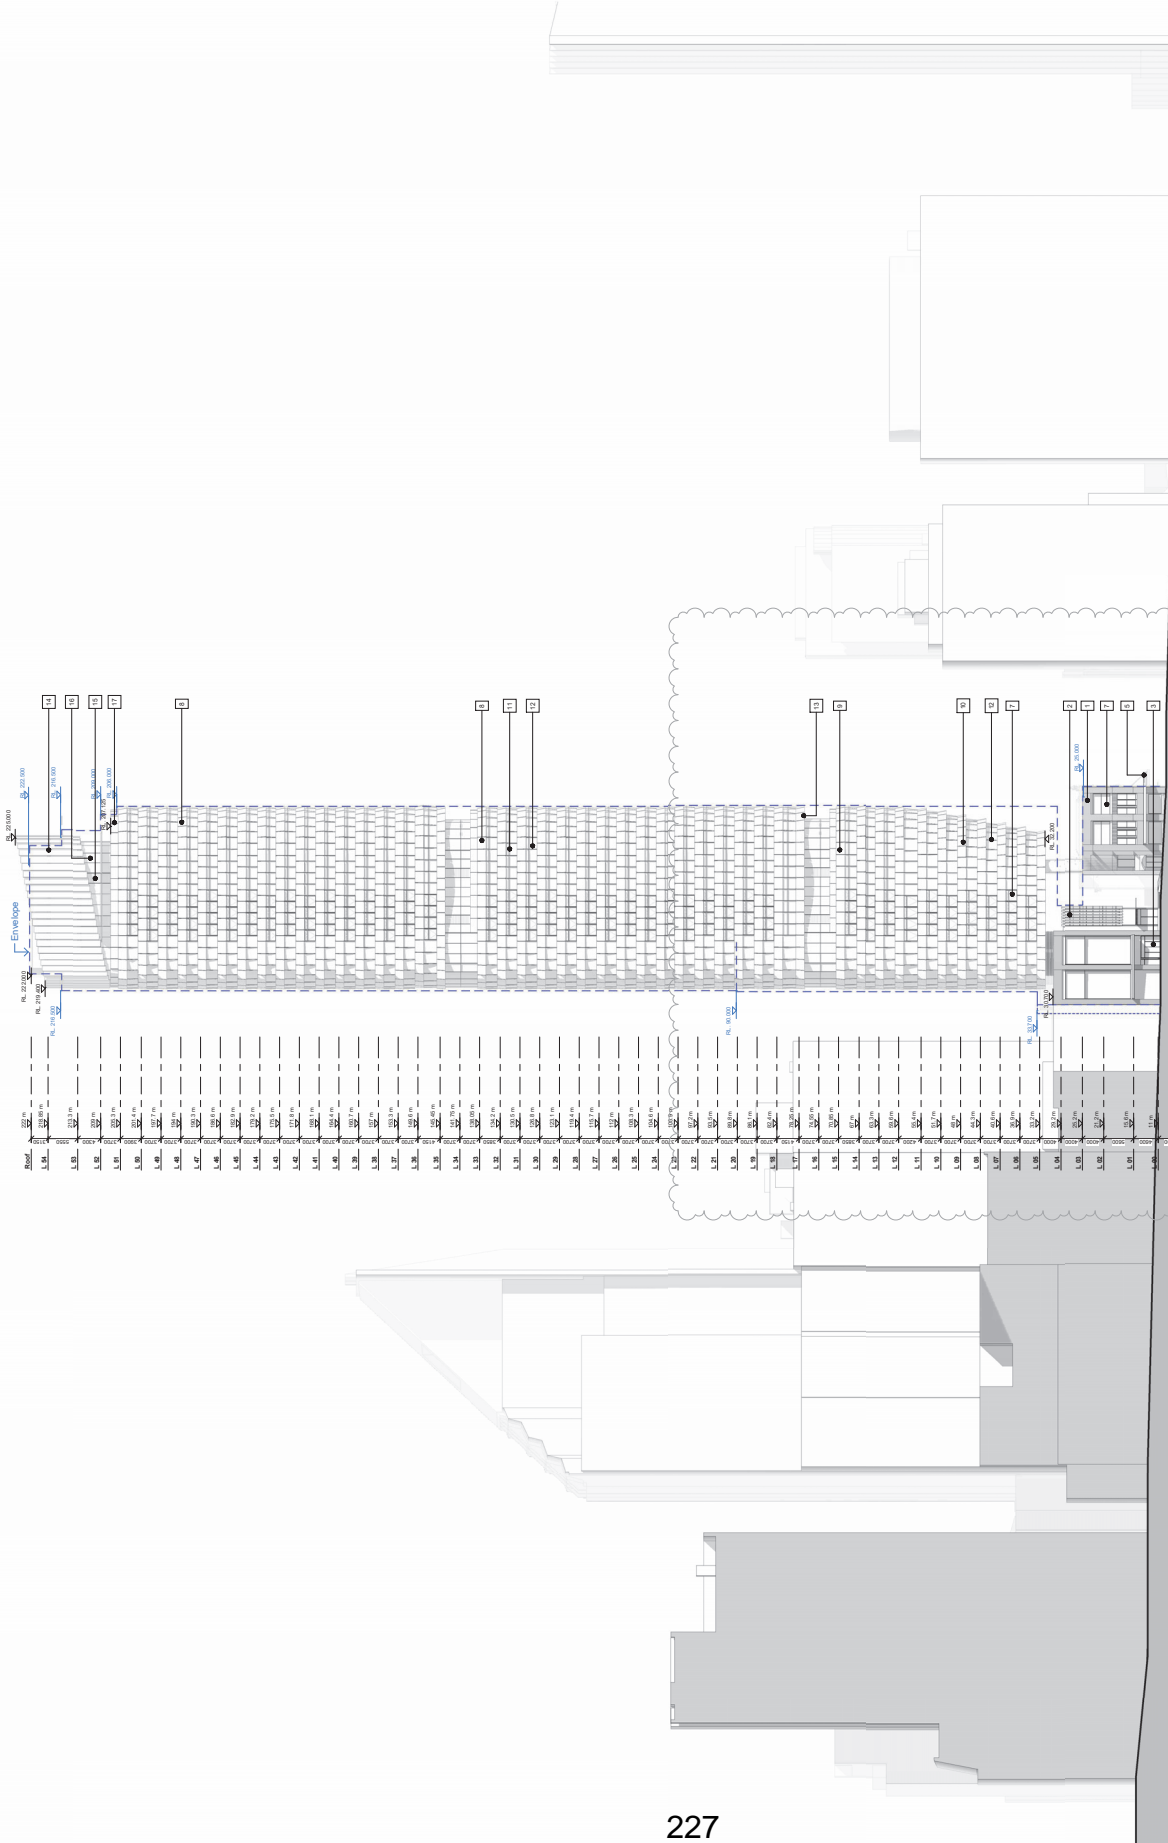

- 1. Low profile sandstone doors - Pine Creek Surree Cold
- 2. Facade screen of aluminium doors, windows frames - Charcoal
- 3. Powdercoated acid anodized aluminium doors, windows frames - Charcoal
- 4. Charcoal-coloured planter boxes
- 5. Fixed wiring with bespoke soffit profile
- 6. Vertical - Top-Old steel frame doors - charcoal
- 7. Powdercoated aluminium with grey colour cast with height of 10.2m from to the wall 10.2m
- 8. TBC - indicative and subject to design development
- 9. Material F8 plus integrated PV cells
- 10. Perforated bronze aluminium panel
- 11. Horizontal extruded anodized aluminium extrusions - Bronze
- 12. Vertical aluminium fins - Bronze
- 13. Timber battened system to internal & external walls
- 14. TBC - indicative and subject to design development
- 15. Operable glass doors and sky lanterns
- 16. TBC - indicative and subject to design development. Claim or imber-coated double height glazing of wall panel & sky lanterns to design development
- 17. 1600mmH glass balustrade
- 18. Bagged brick with mineral paint finish to rendered front facade

A09.003 Revision **B**

Bates Smart Architects Pty Ltd 48/68 740 988
 230/238 44/239 AM
 11/11/2022

Melbourne 1 Nicholson Street
 Sydney 43 Elizabeth Street
 Brisbane 100 Queen Street
 Perth 100 St Georges Terrace
 Melbourne VIC 3000 Australia
 email mel@batesmart.com.au
 http://www.batesmart.com.au

Hunter & Pitt

East Elevation - Pitt Street

Status: Development Application
 Scale: As indicated @ A1
 Drawn: AT Checked: DS
 Project No: S12353.A
 Rev: 01 Date: 23/02/2022 4:42:29 AM

| Rev | Date | Description | By | Check |
|-----|----------|------------------------------|----|-------|
| B | 24/02/22 | DA Response to RP/Item Court | JB | DS |
| A | 15/02/22 | Development | JB | DS |

BATESSMART

Check all dimensions and site conditions prior to commencement of any work. The contractor shall be responsible for ensuring that the building is constructed in accordance with the approved plans and specifications. Any discrepancies shall be immediately referred to the architect for clarification. All drawings may not be reproduced or distributed without prior permission from the architect.



| Rev | Date | Description | By | DS |
|-----|------------|--------------------------------|----|---------|
| A | 10/01/2023 | Update to include RIBA and BSA | JS | Checked |

Hunter & Pitt

The Little Building - Elevation


| | |
|-------------|-------------------------|
| Status | Development Application |
| Scale | 1:100 @ A1 |
| Drawn | JS |
| Checked | DS |
| Project No. | S12333A |
| Plot Date | 20022021 11:28 AM |
| Sheet | |
| Revision | |

A09.101

Bates Smart Architects Pty Ltd
 Melbourne 1 Nicholson Street
 Sydney 43 Brisbane Street
 Melbourne VIC 3000 Australia
 Sydney NSW 2010 Australia
 email mel@batesmart.com.au
 email syd@batesmart.com.au
 http://www.batesmart.com.au

Bates Smart Architects Pty Ltd ABN 68 094 740 888
 100 Waverley Rd, Waverley VIC 3169
 100 Waverley Rd, Waverley VIC 3169

Check all dimensions and site conditions prior to commencement of any work. The contractor is responsible for ensuring that the drawings are in accordance with the current Australian Standards and any applicable local council requirements. Do not scale drawings - refer to listed dimensions only. Any discrepancies shall immediately be referred to the architect for clarification. All drawings may not be reproduced or distributed without prior permission from the architect.

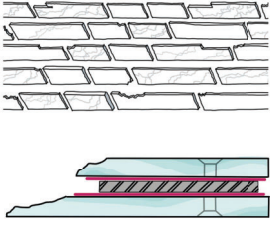

Detail of facade screen from salvaged stone off-cuts. Conceal fixed to each side of a steel plate framing support.

| Rev | Date | Description | By | CS | Checked |
|-----|------------|---------------|----|----|---------|
| A | 10/01/2023 | Initial Issue | JS | DS | |


Hunter & Pitt

Laneway - North Elevation

| | |
|-------------|-------------------------|
| Status | Development Application |
| Scale | 1:100 @ A1 |
| Drawn | JS |
| Project No. | S173352A |
| Rev. Date | 20022021 16:29 PM |
| DS | |
| Revision | A |

A09.103

Bates Smart Architects Pty Ltd ABN 68 094 740 888
 10/101 Market Street, Melbourne VIC 3000
 10/101 Market Street, Sydney NSW 2010
 email: info@bates-smart.com.au
 http://www.bates-smart.com.au

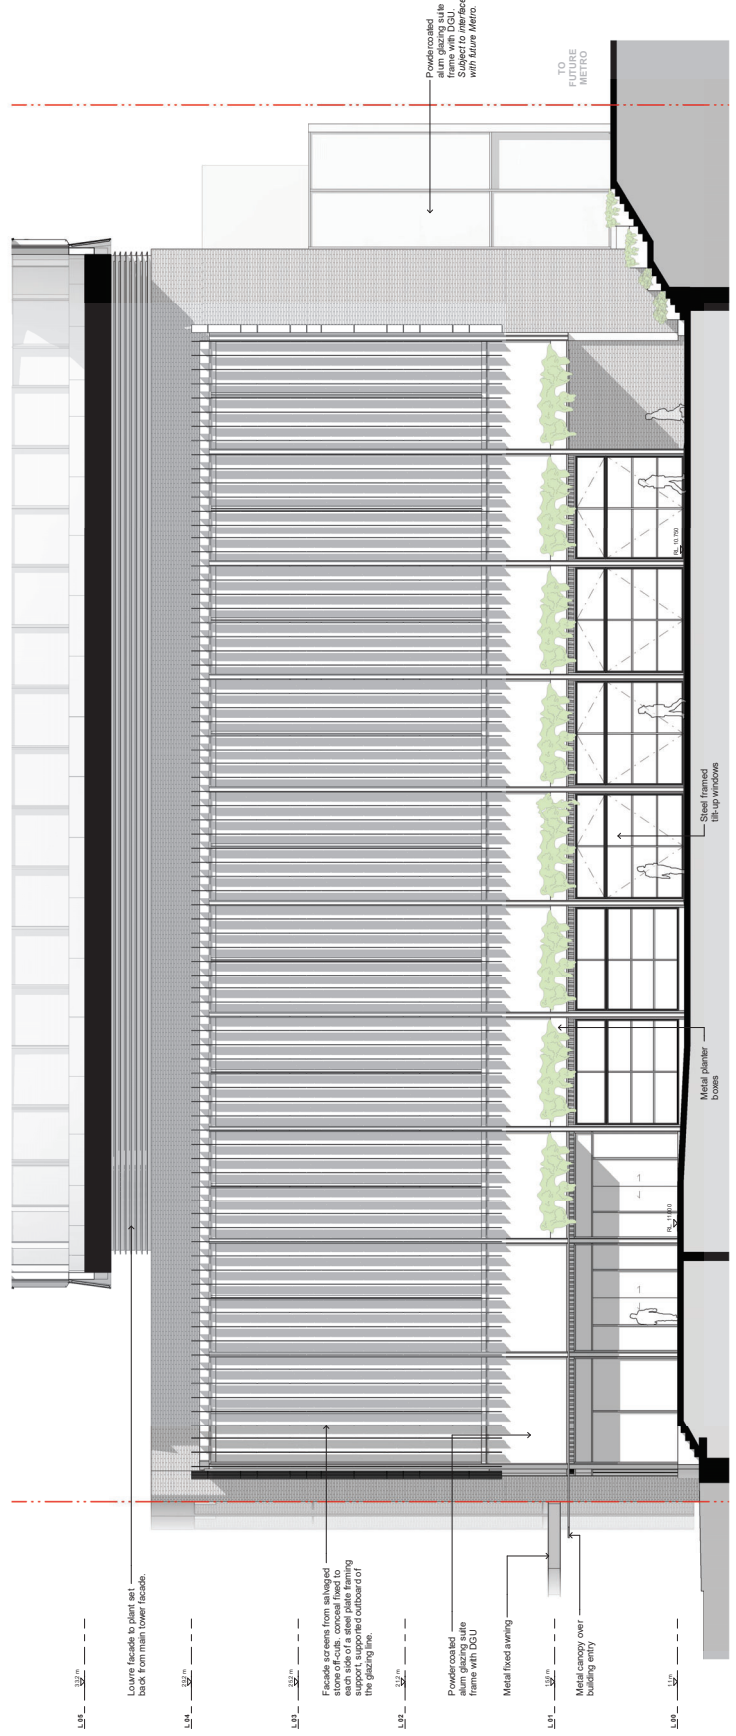

1. Podium North Elevation, 1:100

Check all dimensions and site conditions prior to commencement of any work. Any discrepancy or error may be the result of a clerical error or a misinterpretation of the drawings. The architect shall be responsible for the accuracy of the drawings. Do not scale drawings - refer to listed dimensions only. Any discrepancy shall immediately be referred to the architect for clarification. All drawings may not be reproduced or distributed without prior permission from the architect.

| | | | | |
|-----|----------|---------------------------------|---------|---------|
| B | 24/05/18 | DA Response to Ref from Council | JD | DB |
| Rev | Drawn | Checked | Initial | Checked |


Hunter & Pitt

Section AA_North-South Section


| | |
|-------------|-------------------------|
| Status | Development Application |
| Scale | 1:500 @ A1 |
| Drawn | AT |
| Checked | DS |
| Project No. | S12333A |
| Proj. Date | 20052011 14:16 PM |
| Rev | |

| | |
|--|----------|
| Drawing No. | Revision |
| A10.001 | B |
| Melbourne 1 Nicholson Street Sydney NSW 2010 Australia Sydney NSW 2010 Australia email: info@batesmart.com.au http://www.batesmart.com.au | |
| Bates Smart Architects Pty Ltd ABN 68 094 740 888 10/11 Market Street, Sydney NSW 2010 Australia Contact: 02 9232 2222 Fax: 02 9232 2223 | |


BATESMART

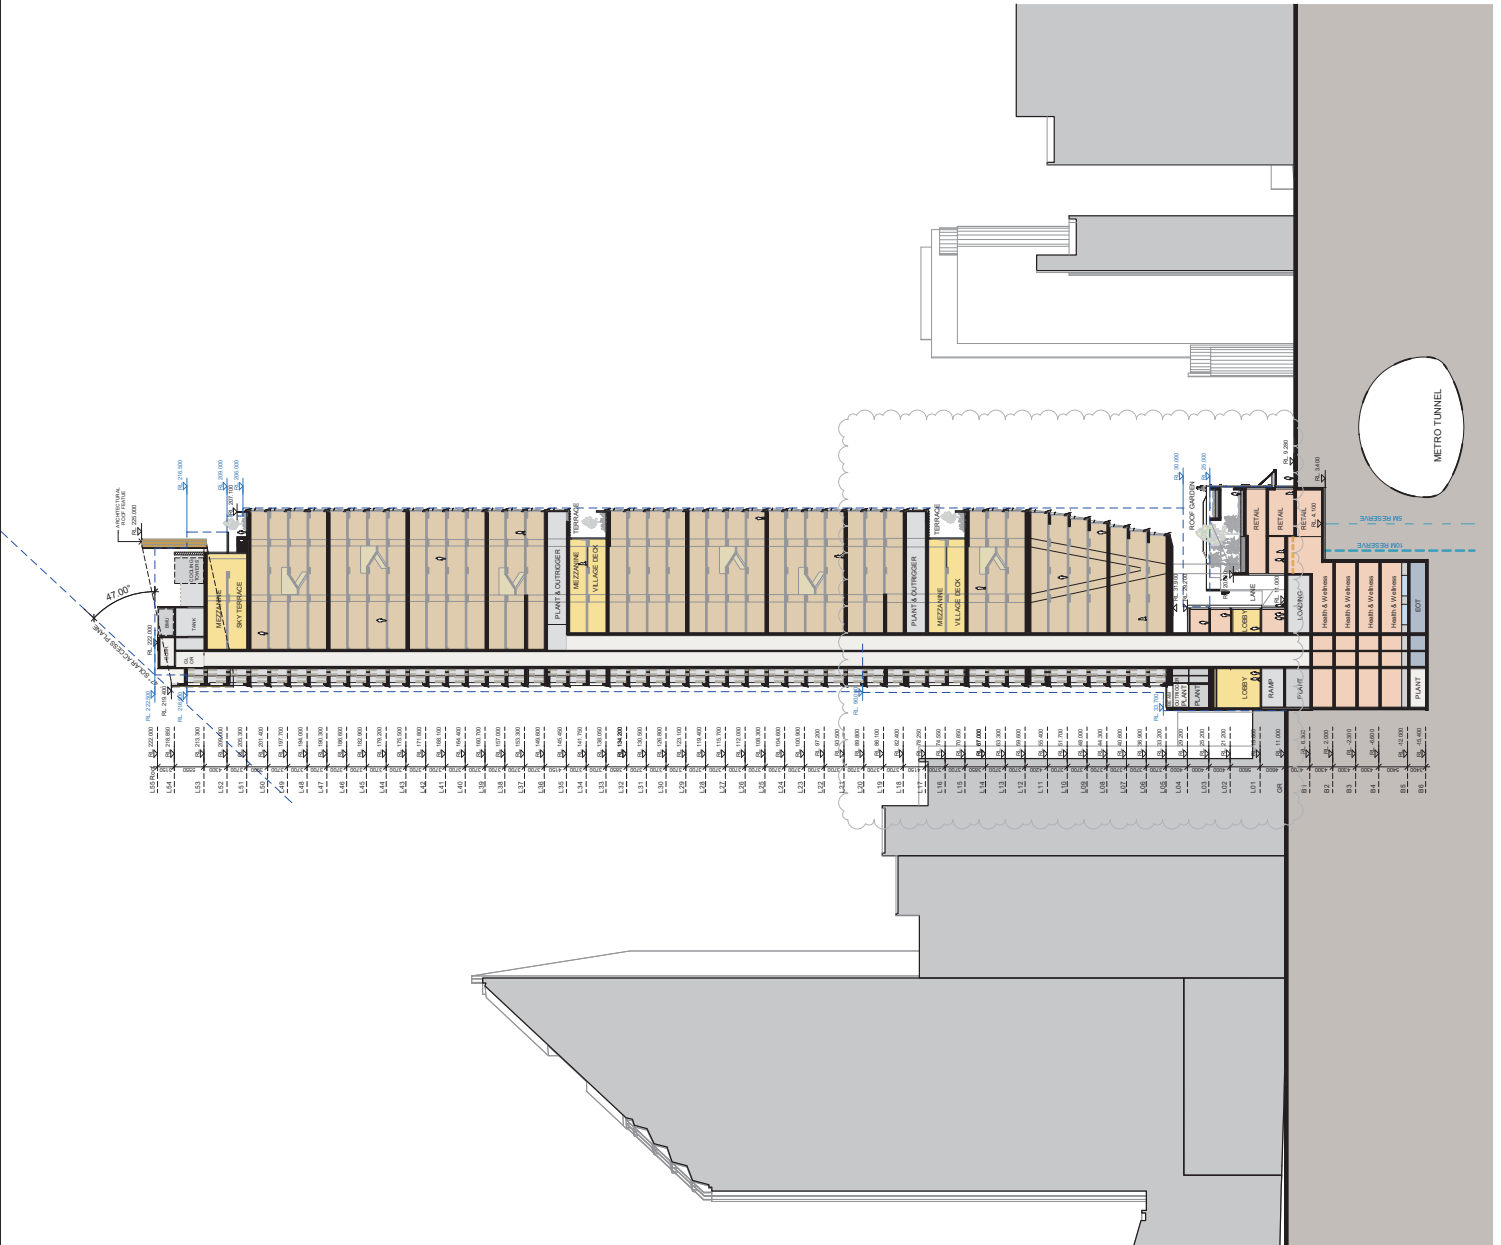


Check all dimensions and site conditions prior to commencement of any work. Any previous or existing site conditions, including but not limited to, existing structures, services, utilities, and other infrastructure, shall be identified and recorded on site. Do not scale drawings - refer to listed dimensions only. Any discrepancies shall immediately be referred to the architect for clarification. All drawings may not be reproduced or distributed without prior permission from the architect.

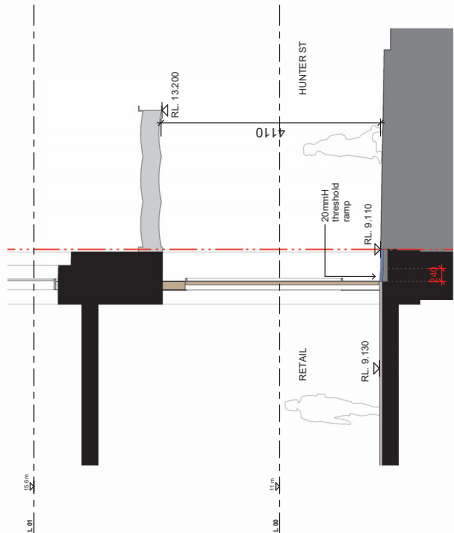


3 Section BB - Retail 1:150

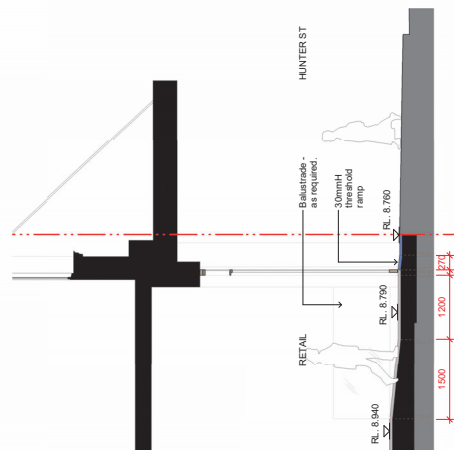

2 Section AA - Pangas house 1:150

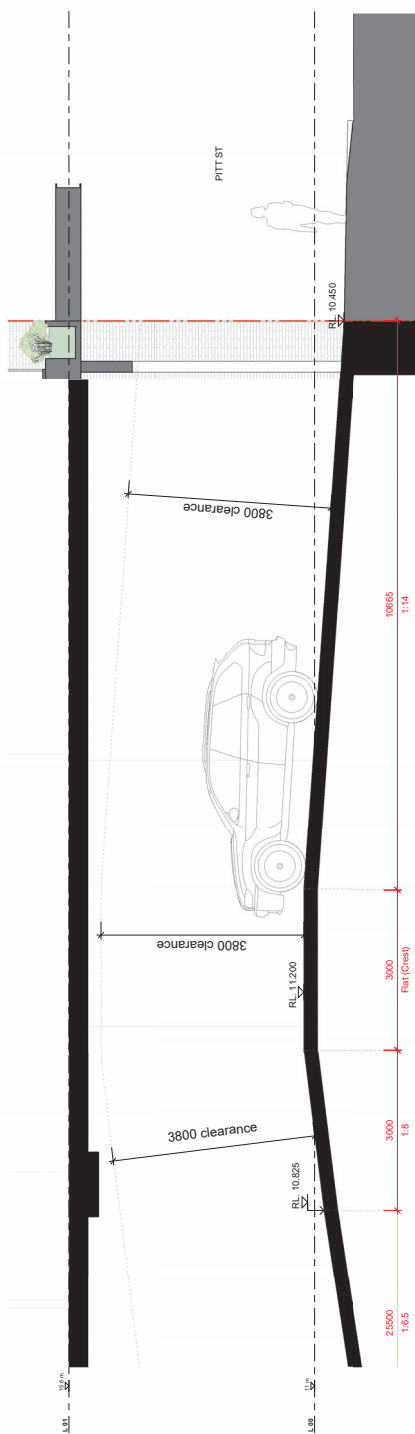

5 Section DD - Carpark Entry 1:150

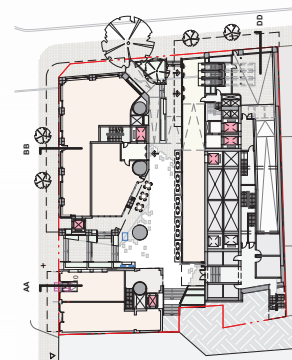

1 Keyplan 1:150

Hunter & Pitt

Sections - Building Entries

| | | | |
|-------------|-------------------------|---------|---------|
| Status | Development Application | | |
| Scale | As indicated @ A1 | | |
| Drawn | Author | Checked | Checker |
| Project No. | S12353.A | | |
| File Date | 23/05/2024 10:27 AM | | |
| BIM | | | |

| | |
|-------------|----------|
| Drawing No. | Revision |
| A10.101 | A |

Melbourne 1 Nicholson Street
 Sydney NSW 2010 Australia
 Melbourne VIC 3000 Australia
 email: info@batesmart.com.au
 http://www.batesmart.com.au

Bates Smart Architects Pty Ltd
 ABN 68 094 740 988
 100 Victoria Street, Suite 100, Melbourne VIC 3000
 100 Victoria Street, Suite 100, Melbourne VIC 3000



Check all dimensions and site conditions prior to commencement of any work.
 Any provision or condition of any instrument, treaty, plan, contract or agreement
 shall prevail over any provision or condition of any instrument, treaty, plan, contract
 or agreement. All dimensions are in millimetres unless otherwise stated.
 Do not scale drawings - refer to listed dimensions only. Any discrepancies shall
 immediately be referred to the architect for clarification.
 All drawings may not be reproduced or distributed without prior permission from
 the architect.

| A | 20/03/2020 | 04/08/2020 | AT | DS |
|-----|------------|-------------|---------|---------|
| Rev | Date | Description | Initial | Checked |

Hunter & Pitt



Photomontage 1 - Hunter & Pitt Street Corner

| | |
|-------------|-------------------------|
| Status | Development Application |
| Scale | @ A1 |
| Drawn | AT |
| Checked | DS |
| Project No. | S172353.A |
| Plot Code | 19050208 to 12/4/PM |
| BM | |

| | |
|----------------|----------|
| Drawing No. | Revision |
| A23.001 | A |

Melbourne 1 Nicholson Street
 Melbourne VIC 3000 Australia
 Sydney 43 Blakes Street
 Surry Hills NSW 2010 Australia
 Brisbane 100 Queen Street
 Brisbane QLD 4000 Australia
 email: mel@batesmart.com.au
 sydney@batesmart.com.au
 brisbane@batesmart.com.au
 http://www.batesmart.com.au

Bates Smart Architects Pty Ltd ABN 68 094 740 686
 100 Victoria Street, Suite 1000, Brisbane QLD 4000
 100 Queen Street, Suite 1000, Brisbane QLD 4000
 43 Blakes Street, Suite 1000, Sydney NSW 2010
 100 Queen Street, Suite 1000, Brisbane QLD 4000
 Victorian Reg 6098 /

BATESSMART™



Check all dimensions and table conditions prior to commencement of any work. Any provision or condition of any instrument, code, plan, contract or agreement, or any other document, shall be taken into account in the preparation of any drawings. Do not scale drawings - refer to listed dimensions only. Any discrepancies shall immediately be referred to the architect for clarification. All drawings may not be reproduced or distributed without prior permission from the architect.

| A | 20/03/2020 | DATE | DESCRIPTION | BY | CHKD |
|---|------------|------|-------------|----|------|
| | | | | | |

Hunter & Pitt

Photomontage 2 - Hunter Street



| | |
|-------------|-------------------------|
| Status | Development Application |
| Scale | @ A1 |
| Drawn | AT |
| Checked | DS |
| Project No. | S12353.A |
| File Date | 19/03/2020 10:12:27 AM |
| BIM | |

| Drawing No. | Revision |
|-------------|----------|
| A23.002 | A |

Melbourne 1 Nicholson Street
 Sydney NSW 2010, Australia
 Phone: +61 (0)2 9230 9000
 Email: info@batesmart.com.au
 http://www.batesmart.com.au

Bates Smart Architects Pty Ltd ABN 68 094 740 686
 100 Victoria Street, Suite 200, Melbourne VIC 3000, Australia
 Phone: +61 (0)3 9230 9000
 Fax: +61 (0)3 9230 9001
 Email: info@batesmart.com.au
 http://www.batesmart.com.au

BATESMART



Check all dimensions and table conditions prior to commencement of any work.
 Any previous conditions of any materials, trench, drains, services or equipment
 shall be noted on the drawings. The drawings shall be used for information only.
 Do not scale drawings - refer to listed dimensions only. Any discrepancies shall
 immediately be referred to the architect for clarification.
 All drawings may not be reproduced or distributed without prior permission from
 the architect.

| Rev | Date | Description | AT | DS | Initial | Checked |
|-----|------------|-------------|----|----|---------|---------|
| A | 20/10/2024 | 04/18/2024 | | | | |

Hunter & Pitt

Photomontage 3 - Pitt Street



| | |
|-------------|-------------------------|
| Status | Development Application |
| Scale | @ A1 |
| Drawn | AT |
| Checked | DS |
| Project No. | S172353.A |
| Plot Date | 19/09/2024 at 12:06 PM |
| BIM | |

Drawing No.

Revision

A23.003

A

Melbourne 1 Nicholson Street
 Sydney NSW 2010, Australia
 Phone: +61 (0)2 9230 9000
 Email: info@batesmart.com.au
 http://www.batesmart.com.au

Bates Smart Architects Pty Ltd ABN 68 094 740 686
 10/110 Pitt Street, Melbourne, Victoria 3000, Australia
 Phone: +61 (0)3 9230 9000
 Email: info@batesmart.com.au
 www.batesmart.com.au

Check all dimensions and site conditions prior to commencement of any work. Any increase or omission of any material, work, plant, service or equipment, or any change in the design, shall be the responsibility of the client. Do not scale drawings. Refer to listed dimensions only. Any discrepancies shall immediately be referred to the architect for clarification. All drawings may not be reproduced or distributed without prior permission from the architect.

| Rev | Date | Description | AT | DS | Checked |
|-----|------------|-------------|----|----|---------|
| A | 23/10/2023 | DL180106 | | | |

Hunter & Pitt



Phoenoxbagge 4 - Hunter Street Laneway

| | |
|-------------|--------------------------|
| Status | Development Application |
| Scale | @ A1 |
| Drawn | AT |
| Checked | DS |
| Project No. | 5172353.A |
| Proj. Date | 19/05/2024 to 12/08/2024 |
| BIM | |

| Drawing No. | Revision |
|-------------|----------|
| A23.004 | A |

Melbourne | Nicholson Street
 Melbourne VIC 3000 Australia
 Sydney | 41 Blakes Street
 Surry Hills NSW 2010 Australia
 Brisbane | 100 St Johns Road
 Brisbane QLD 4000 Australia
 email: mel@batesmart.com.au
 mel@batesmart.com.au
 sydney@batesmart.com.au
 brisbane@batesmart.com.au
 http://www.batesmart.com.au

Bates Smart Architects Pty Ltd ABN 68 694 740 986
 100 St Johns Road, Brisbane QLD 4000 Australia
 41 Blakes Street, Sydney NSW 2010 Australia
 100 St Johns Road, Brisbane QLD 4000 Australia
 Vinnier Reg. 6168 /

