



Attachment B


Selected Drawings

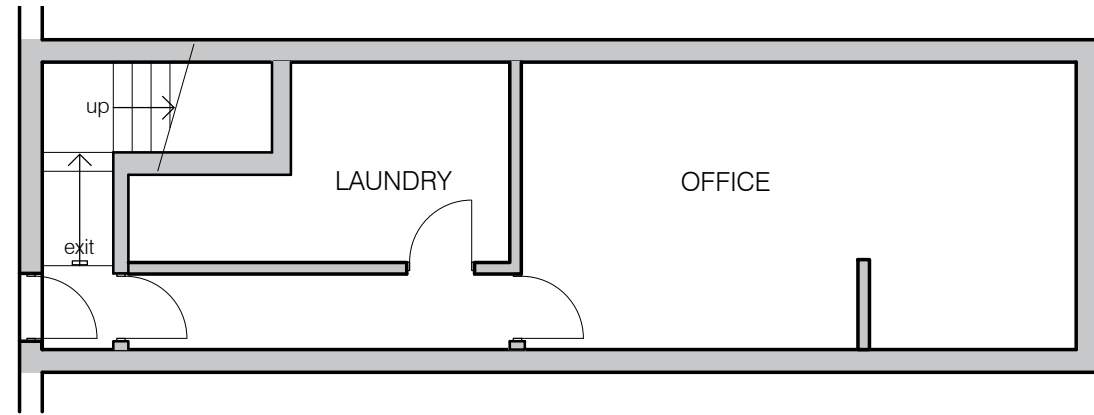

1 AS-BUILT BASEMENT FLOOR PLAN & SITE PLAN
SCALE 1:100

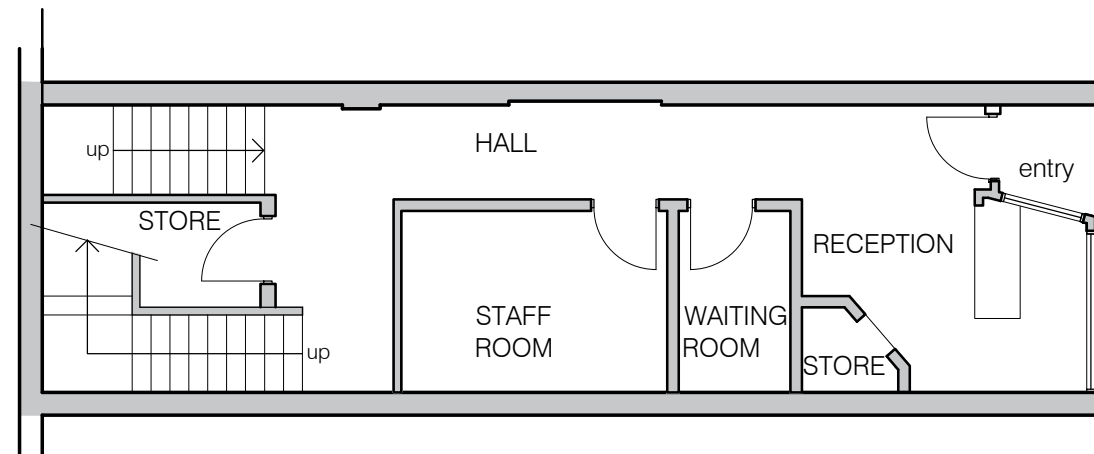

2 AS-BUILT GROUND FLOOR PLAN
SCALE 1:100

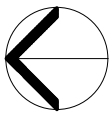


NOTE: CONTRACTOR TO CHECK ALL DIMENSIONS ON SITE PRIOR TO COMMENCING CONSTRUCTION. DO NOT SCALE FROM THIS DRAWING.


CLIENT	PROJECT MANAGER	ARCHITECT	REVISIONS	DRAWN	APP PROJECT ID	RFA PROJECT NO	PROJECT									
		rfa architects	<table border="1"> <thead> <tr> <th>Rev.</th> <th>Date</th> <th>Description</th> </tr> </thead> <tbody> <tr> <td>1</td> <td>26/06/24</td> <td>AS-BUILT/DA ISSUE</td> </tr> <tr> <td>2</td> <td>21/08/24</td> <td>AS-BUILT/DA ISSUE</td> </tr> </tbody> </table>	Rev.	Date	Description	1	26/06/24	AS-BUILT/DA ISSUE	2	21/08/24	AS-BUILT/DA ISSUE	VG	-	23024	CONTINUOUS USE OF EXISTING BROTHEL 80 ERSKINE STREET SYDNEY NSW 2000
Rev.	Date	Description														
1	26/06/24	AS-BUILT/DA ISSUE														
2	21/08/24	AS-BUILT/DA ISSUE														
				By KM VG	MANAGER	DRAWING NO	DRAWING									
					BH	A2101	AS-BUILT FLOOR PLANS									
					REVISION	PJT COMMENCEMENT DATE	SCALE									
					2	JUNE 2024	1:100 @ A3 SIZE									

Ms. Yada Martyn
70 Erskine Street, Sydney NSW 2000
T 0403 824 568

Level 1 / 121 Alexander Street
Crows Nest NSW 2065
T 02 9901 4422 F 02 9901 4466
E admin@rfaarchitects.com.au

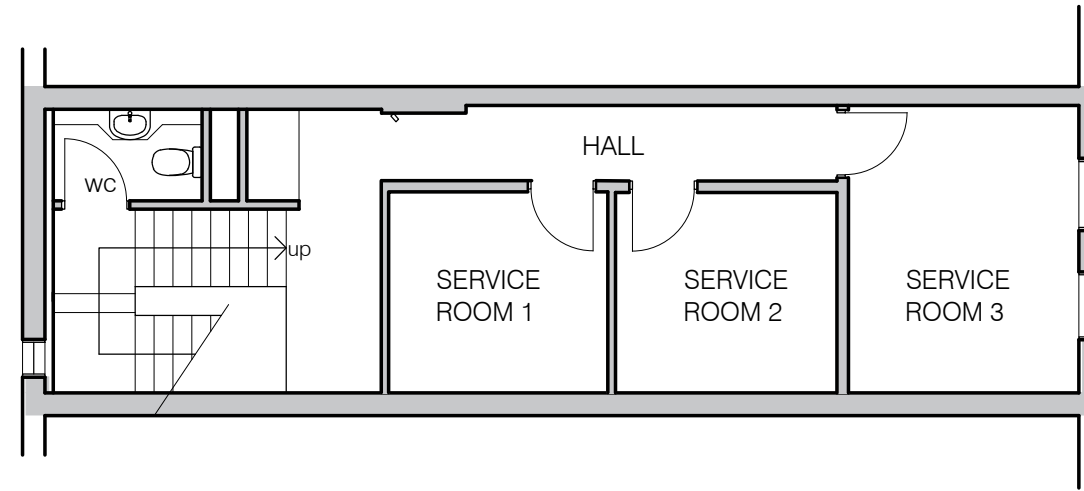


1 AS-BUILT FIRST FLOOR PLAN
SCALE 1:100

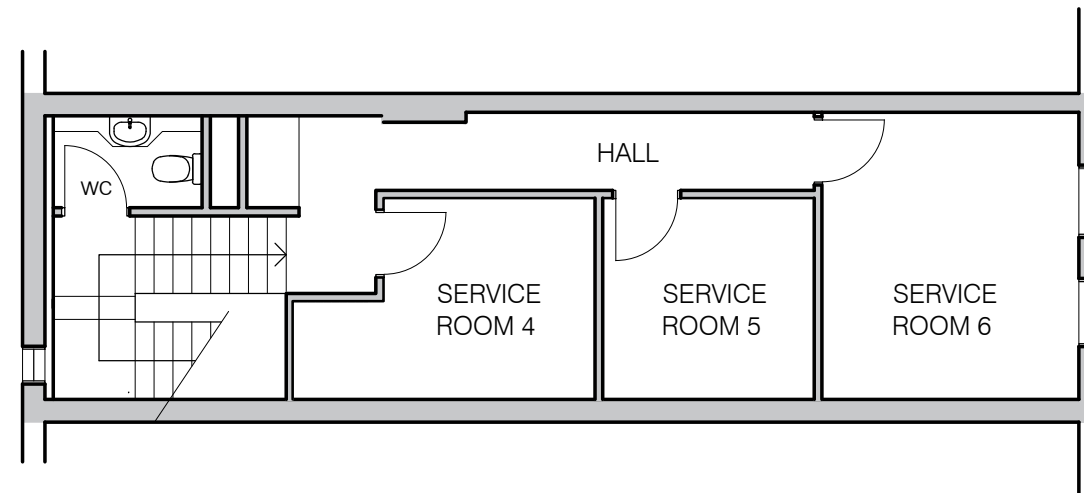

2 AS-BUILT SECOND FLOOR PLAN
SCALE 1:100

41

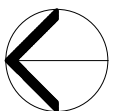

NOTE: CONTRACTOR TO CHECK ALL DIMENSIONS ON SITE PRIOR TO COMMENCING CONSTRUCTION. DO NOT SCALE FROM THIS DRAWING.

CLIENT	PROJECT MANAGER	ARCHITECT	REVISIONS	DRAWN	APP PROJECT ID	RFA PROJECT NO	PROJECT									
			<table border="1"> <thead> <tr> <th>Rev.</th> <th>Date</th> <th>Description</th> </tr> </thead> <tbody> <tr> <td>1</td> <td>26/06/24</td> <td>AS-BUILT/DA ISSUE</td> </tr> <tr> <td>2</td> <td>21/08/24</td> <td>AS-BUILT/DA ISSUE</td> </tr> </tbody> </table>	Rev.	Date	Description	1	26/06/24	AS-BUILT/DA ISSUE	2	21/08/24	AS-BUILT/DA ISSUE	By KM VG VG	-	23024	CONTINUOUS USE OF EXISTING BROTHEL 80 ERSKINE STREET SYDNEY NSW 2000
Rev.	Date	Description														
1	26/06/24	AS-BUILT/DA ISSUE														
2	21/08/24	AS-BUILT/DA ISSUE														
				MANAGER	REGION	DRAWING NO	DRAWING									
				BH	-	A2102	AS-BUILT FLOOR PLANS									
				REVISION	DESIGN	PJT COMMENCEMENT DATE	SCALE									
				2		JUNE 2024	1:100 @ A3 SIZE									

Ms. Yada Martyn
70 Erskine Street, Sydney NSW 2000
T 0403 824 568

Level 1 / 121 Alexander Street
Crows Nest NSW 2065
T 02 9901 4422 F 02 9901 4466
E admin@rfaarchitects.com.au



1 AS-BUILT STREET ELEVATION
SCALE 1:100

NOTE: CONTRACTOR TO CHECK ALL DIMENSIONS ON SITE PRIOR TO COMMENCING CONSTRUCTION. DO NOT SCALE FROM THIS DRAWING.

CLIENT	PROJECT MANAGER	ARCHITECT	REVISIONS	DRAWN	APP PROJECT ID	RFA PROJECT NO	PROJECT									
		rfa architects	<table border="1"> <thead> <tr> <th>Rev.</th> <th>Date</th> <th>Description</th> </tr> </thead> <tbody> <tr> <td>1</td> <td>26/06/24</td> <td>AS-BUILT/DA ISSUE</td> </tr> <tr> <td>2</td> <td>21/08/24</td> <td>AS-BUILT/DA ISSUE</td> </tr> </tbody> </table>	Rev.	Date	Description	1	26/06/24	AS-BUILT/DA ISSUE	2	21/08/24	AS-BUILT/DA ISSUE	By VG	-	23024	CONTINUOUS USE OF EXISTING BROTHEL 80 ERSKINE STREET SYDNEY NSW 2000
Rev.	Date	Description														
1	26/06/24	AS-BUILT/DA ISSUE														
2	21/08/24	AS-BUILT/DA ISSUE														
				MANAGER BH	REGION -	DRAWING NO A3001	DRAWING AS-BUILT STREET ELEVATION									
				REVISION 1	DESIGN	PJT COMMENCEMENT DATE JUNE 2024	SCALE 1:100 @ A3 SIZE									

Ms. Yada Martyn
70 Erskine Street, Sydney NSW 2000
T 0403 824 568

Level 1 / 121 Alexander Street
Crows Nest NSW 2065
T 02 9901 4422 F 02 9901 4466
E admin@rfaarchitects.com.au