


INTELLECTUAL PROPERTY


| NO. | DATE | BY | DESCRIPTION |
|-----|----------|----|-----------------|

ATTACHMENT A



PROJECT
 BUILDING A ROSEBERRY OVERLAND GARDENS
 66-87 EPSOM ROAD, ROSEBERRY NSW
 15/01/01 D02
 DRAWING SET

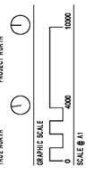

SCALE
 1:200
 1:200
 1:200

DEVELOPMENT APPLICATION
 DRAWING

LEVEL 07 PLAN
 ISSUE 8



- LEGEND**
- STAGE 1 DA OUTLINE
 - - - 485mm BOUNDARY PROJECTION OFFSET
 - APARTMENT STORAGE
 - SITE BOUNDARY

- SERVICES LEGEND**
- EL ELECTRICAL HOUSE SERVICES C/P REWED
 - EG ELECTRICAL GROUNDING
 - GP GAS
 - SP STAIR REEF APP
 - W WASTE
 - K KITCHEN EXHAUST
 - CE CARPARK EXHAUST
 - HS HOTWATER SUPPLY
 - HW HOTWATER
 - CW COLD WATER

INTELLECTUAL PROPERTY



NOTE
 1. THIS DRAWING IS TO BE USED AS A REFERENCE ONLY. ALL DIMENSIONS SHALL BE TAKEN FROM THE FACE UNLESS OTHERWISE SPECIFIED.
 2. ALL DIMENSIONS SHALL BE IN METERS UNLESS OTHERWISE SPECIFIED.

| NO. | DATE | BY | CHKD. | DESCRIPTION |
|-----|----------|----|-------|-----------------|

ATTACHMENT A



PROJECT
 BUILDING A ROSEBERRY OVERLAND GARDENS
 66-87 EPSOM ROAD, ROSEBERRY NSW
 15/01/001 002
 DRAWING SET

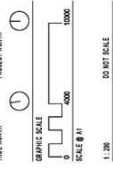

DEVELOPMENT APPLICATION
 DRAWING

LEVEL 08 PLAN
 ISSUE 8
 AR-DA-2111



- LEGEND**
- STAGE 1 DA OUTLINE
 - - - 450mm BOUNDARY PROJECTION OFFSET
 - APARTMENT STORAGE
 - SITE BOUNDARY

- SERVICES LEGEND**
- E ELECTRICAL
 - G GAS
 - SP STAR PRESSURISATION
 - W WASTE
 - R RECYCLING
 - CE CARPARK EXHAUST
 - CS CARPARK SUPPLY
 - WV WASTE WATER
 - CW COLD WATER

INTELLECTUAL PROPERTY



NOTES
 1. THIS DRAWING IS TO BE USED AS A REFERENCE ONLY. ALL DIMENSIONS SHALL BE TAKEN TO THE CENTERLINE UNLESS OTHERWISE SPECIFIED.
 2. ALL DIMENSIONS SHALL BE IN METERS UNLESS OTHERWISE SPECIFIED.
 3. ALL DIMENSIONS SHALL BE TO THE CENTERLINE UNLESS OTHERWISE SPECIFIED.

| NO. | DATE | BY | CHKD BY | DESCRIPTION |
|-----|----------|----------------|----------------|------------------|

ATTACHMENT A



BUILDING A ROSEBERY OVERLAND GARDENS
 66-67 EPSOM ROAD, ROSEBERY NSW
 15/01/001 002
 DRAWING SET
 DRAWING NUMBER

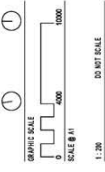

SCALE 1:100
 DATE 15/01/15
 DRAWING APPLICATION

LEVEL 09 PLAN
 AR-DA-2112
 ISSUE 8



- LEGEND**
- STAGE 1 DA OUTLINE
 - - - 450mm BOUNDARY PROJECTION OFFSET
 - APARTMENT STORAGE
 - SITE BOUNDARY

- SERVICES LEGEND**
- E ELECTRICAL
 - B MECHANICAL
 - SP STAR PRESSURISATION
 - W WATER
 - R RECYCLING
 - CS CARRIAGEWAY
 - CS CARPARK SUPPLY
 - EW EXHAUST
 - EW COLD WATER

20/01/15 15:00

INTELLECTUAL PROPERTY




| NO. | DATE | BY | FOR |
|-----|----------|----|-----------------|
| 1 | 20/01/15 | DA | FOR INFORMATION |
| 2 | 20/01/15 | DA | FOR INFORMATION |
ATTACHMENT A



PROJECT
 BUILDING A ROSEBERRY OVERLAND GARDENS
 66-87 EPSOM ROAD, ROSEBERRY NSW

PROJECT NUMBER
 1510/1001 D02

DRAWING SET



GRAPHIC SCALE
 0 500 1000

SCALE 1:1









INTELLECTUAL PROPERTY


NOTE
 1. THIS DRAWING IS TO BE USED AS A REFERENCE ONLY. ALL DIMENSIONS SHALL BE TO FACE UNLESS OTHERWISE SPECIFIED.
 2. ALL DIMENSIONS SHALL BE TO FACE UNLESS OTHERWISE SPECIFIED.


| NO. | DATE | BY | CHKD BY | DESCRIPTION |
|-----|----------|----|---------|-----------------|
| 1 | 20/01/15 | DP | DP | FOR INFORMATION |
| 2 | 20/01/15 | DP | DP | FOR INFORMATION |
ATTACHMENT A



PROJECT
 BUILDING A ROSEBERRY OVERLAND GARDENS
 66-87 EPSOM ROAD, ROSEBERRY NSW

15/01/01 D02
 DRAWING SET

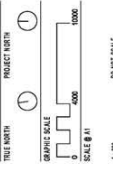

SCALE
 1:200
 AS SHOWN

DEVELOPMENT APPLICATION
 DRAWING

LEVEL 11 PLAN
 ISSUE 8
 AR-DA-2114



INTELLECTUAL PROPERTY


NOTE
 THIS DRAWING IS TO BE USED AS A REFERENCE ONLY. ALL DIMENSIONS SHALL BE TO FACE UNLESS OTHERWISE SPECIFIED. 

| NO. | DATE | BY | CHKD BY | DESCRIPTION |
|-----|----------|--------------|--------------|------------------|

ATTACHMENT A



PROJECT
 BUILDING A ROSEBERY OVERLAND GARDENS
 64-87 EPSOM ROAD, ROSEBERY NSW

PROJECT NUMBER
 15101001_002

DRAWING SET



TIME NORTH

PROJECT NORTH

GRAPHIC SCALE

SCALE 1:1000

SCALE 1:1000

- LEGEND**
- STAGE 1 DA OUTLINE
 - 450mm BOUNDARY PROJECTION OFFSET
 - APARTMENT STORAGE
 - SITE BOUNDARY

- SERVICES LEGEND**
- E ELECTRICAL
 - GH GAS
 - G STAR PRESSURISATION
 - SP SWIMMING POOL
 - W WASTE
 - R RECYCLING
 - RA RAINWATER
 - CE CARPARK EXHAUST
 - CS CARPARK SUPPLY
 - WV WASTE WATER
 - CV COLD WATER

INTELLECTUAL PROPERTY




| NO. | DATE | BY | FOR |
|-----|----------|---------|---------|
| 1 | 20/07/16 | DA/ANON | DA/ANON |
| 2 | 20/07/16 | DA/ANON | DA/ANON |

ATTACHMENT A

CLIENT
TOPSPACE
CLIENT NUMBER
PROJECT

**BUILDING A ROSEBERRY OVERLAND GARDENS
 66-87 EPSOM ROAD, ROSEBERRY NSW
 89 PROJECT NUMBER**

 DRAWING SET**




DATE NORTH
GRAPHIC SCALE


SCALE @ A1
1:100
DATE

DEVELOPMENT APPLICATION
DRAWING


ADAPTABLE APARTMENTS
ISSUE
AR-DA-2200
2

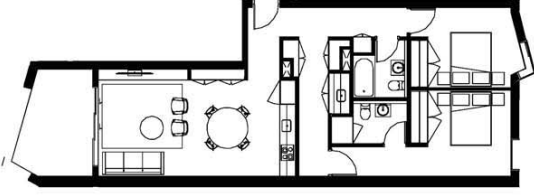


8 2 BED APARTMENT TYPE 2
 1:100

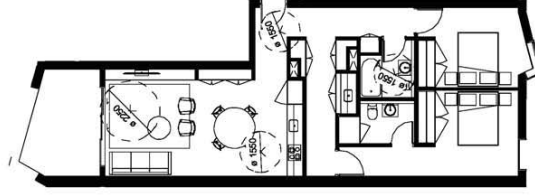


6 2 BED APARTMENT TYPE 2 - ACCESSIBLE
 1:100

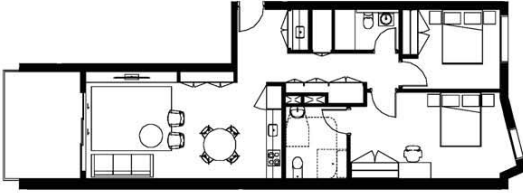


4 2 BED APARTMENT TYPE 1
 1:100

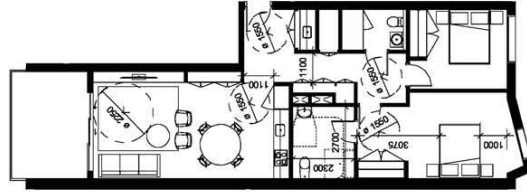

3 2 BED APARTMENT TYPE 1 - ACCESSIBLE
 1:100

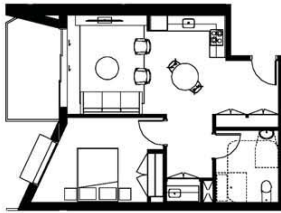

2 1 BED APARTMENT TYPE 1
 1:100

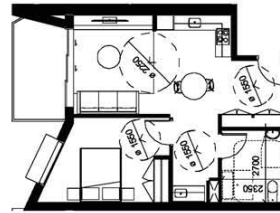

1 1 BED APARTMENT TYPE 1 - ACCESSIBLE
 1:100

INTELLECTUAL PROPERTY


NOTES:
 1. THIS DRAWING IS TO BE USED IN CONJUNCTION WITH THE OTHER DRAWINGS IN THIS SET.

| NO. | DATE | BY | CHKD BY | DESCRIPTION |
|-----|----------|------------|------------|-----------------|
| 1 | 17/04/15 | PAH/MS/MSH | PAH/MS/MSH | FOR INFORMATION |
| 2 | 22/06/15 | PAH/MS/MSH | PAH/MS/MSH | FOR INFORMATION |
| 3 | 15/07/15 | PAH/MS/MSH | PAH/MS/MSH | FOR INFORMATION |
| 4 | 15/07/15 | PAH/MS/MSH | PAH/MS/MSH | FOR INFORMATION |
| 5 | 21/07/15 | PAH/MS/MSH | PAH/MS/MSH | FOR INFORMATION |

ATTACHMENT A

CLIENT: **TOPSPACE**
 CLIENT NUMBER: **TOPSPACE**
 PROJECT: **TOPSPACE**


BUILDING A ROSEBERY OVERLAND GARDENS
 66-67 EPSOM ROAD, ROSEBERY NSW
 DRAWING NUMBER: **1515/001_002**
 DRAWING DATE: **15/07/15**



GRAPHIC SCALE: 0 500 1000
 SCALE 1:1
 1:100
 1:500
 1:1000
 UNIT SCALE
 DEVELOPMENT APPLICATION
 DRAWING

EAST ELEVATION
 AR-DA-3001
 ISSUE
 5

LEGEND : STAGE 1 DA OUTLINE

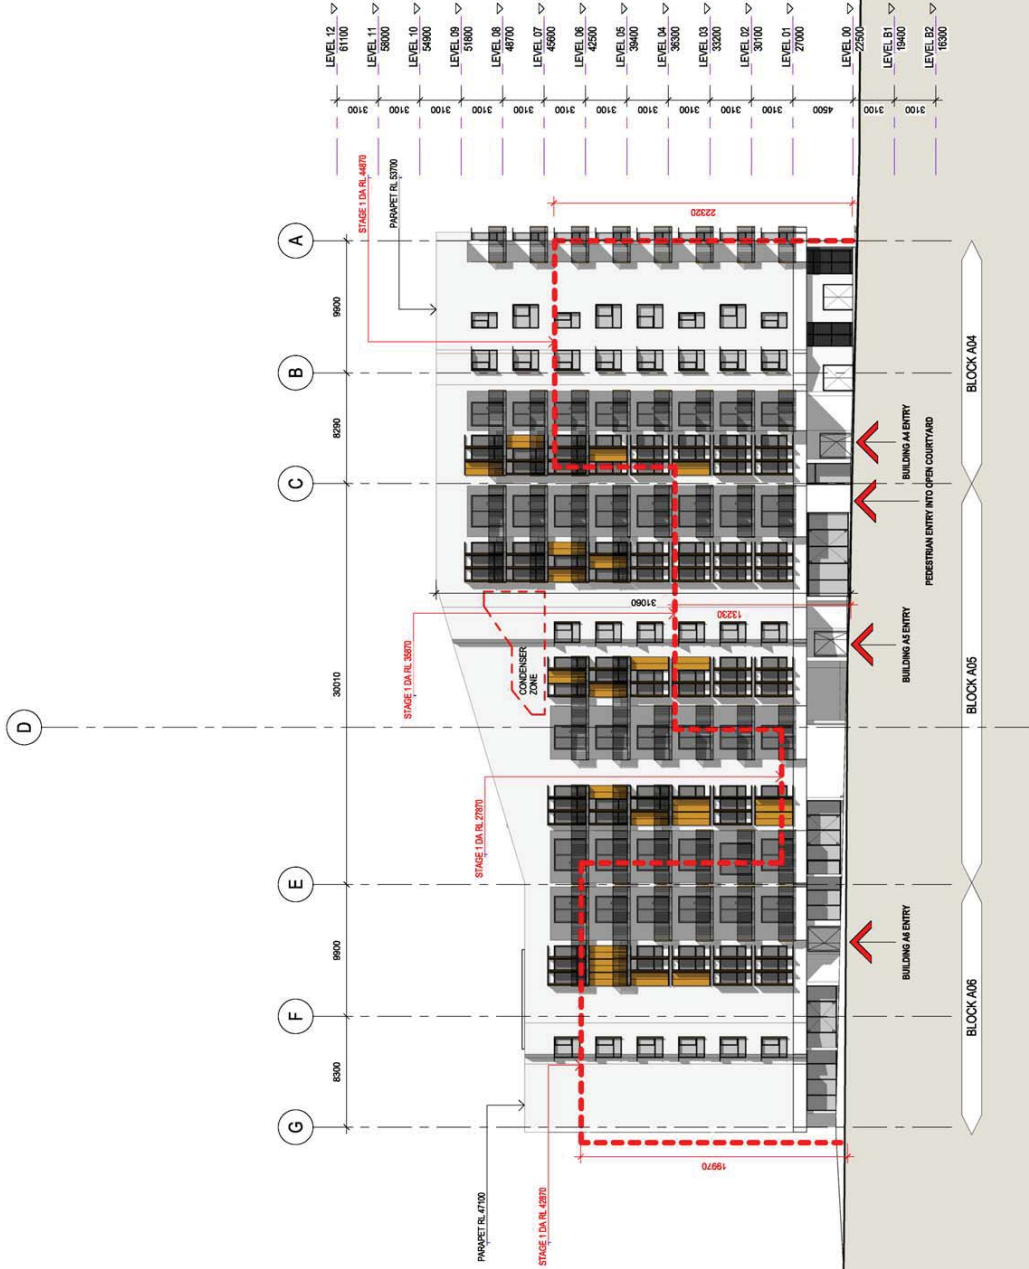


INTELLECTUAL PROPERTY


| NO. | DATE | ISSUE |
|-----|----------|--------------|
| 1 | 17/04/15 | FOR APPROVAL |
| 2 | 29/06/15 | FOR APPROVAL |
| 3 | 15/07/15 | FOR APPROVAL |
| 4 | 15/07/15 | FOR APPROVAL |
| 5 | 21/07/15 | FOR APPROVAL |

ATTACHMENT A

CLIENT: **TOPSPACE**
 CLIENT NUMBER: **TOPSPACE**
 PROJECT: **TOPSPACE**


BUILDING A ROSEBERY OVERLAND GARDENS
 66-67 EPSOM ROAD, ROSEBERY NSW
 DRAWING NUMBER: **1515/001_002**
 DRAWING DATE: **15/07/15**

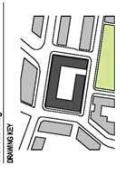

GRAPHIC SCALE: 0 5000 10000
 SCALE @ 1:1000
 DATE: 15/07/15
 DRAWING: DEVELOPMENT APPLICATION
 DRAWING

WEST ELEVATION
 AR-DA-3002
 ISSUE: 5

LEGEND:
 STAGE 1 DA OUTLINE

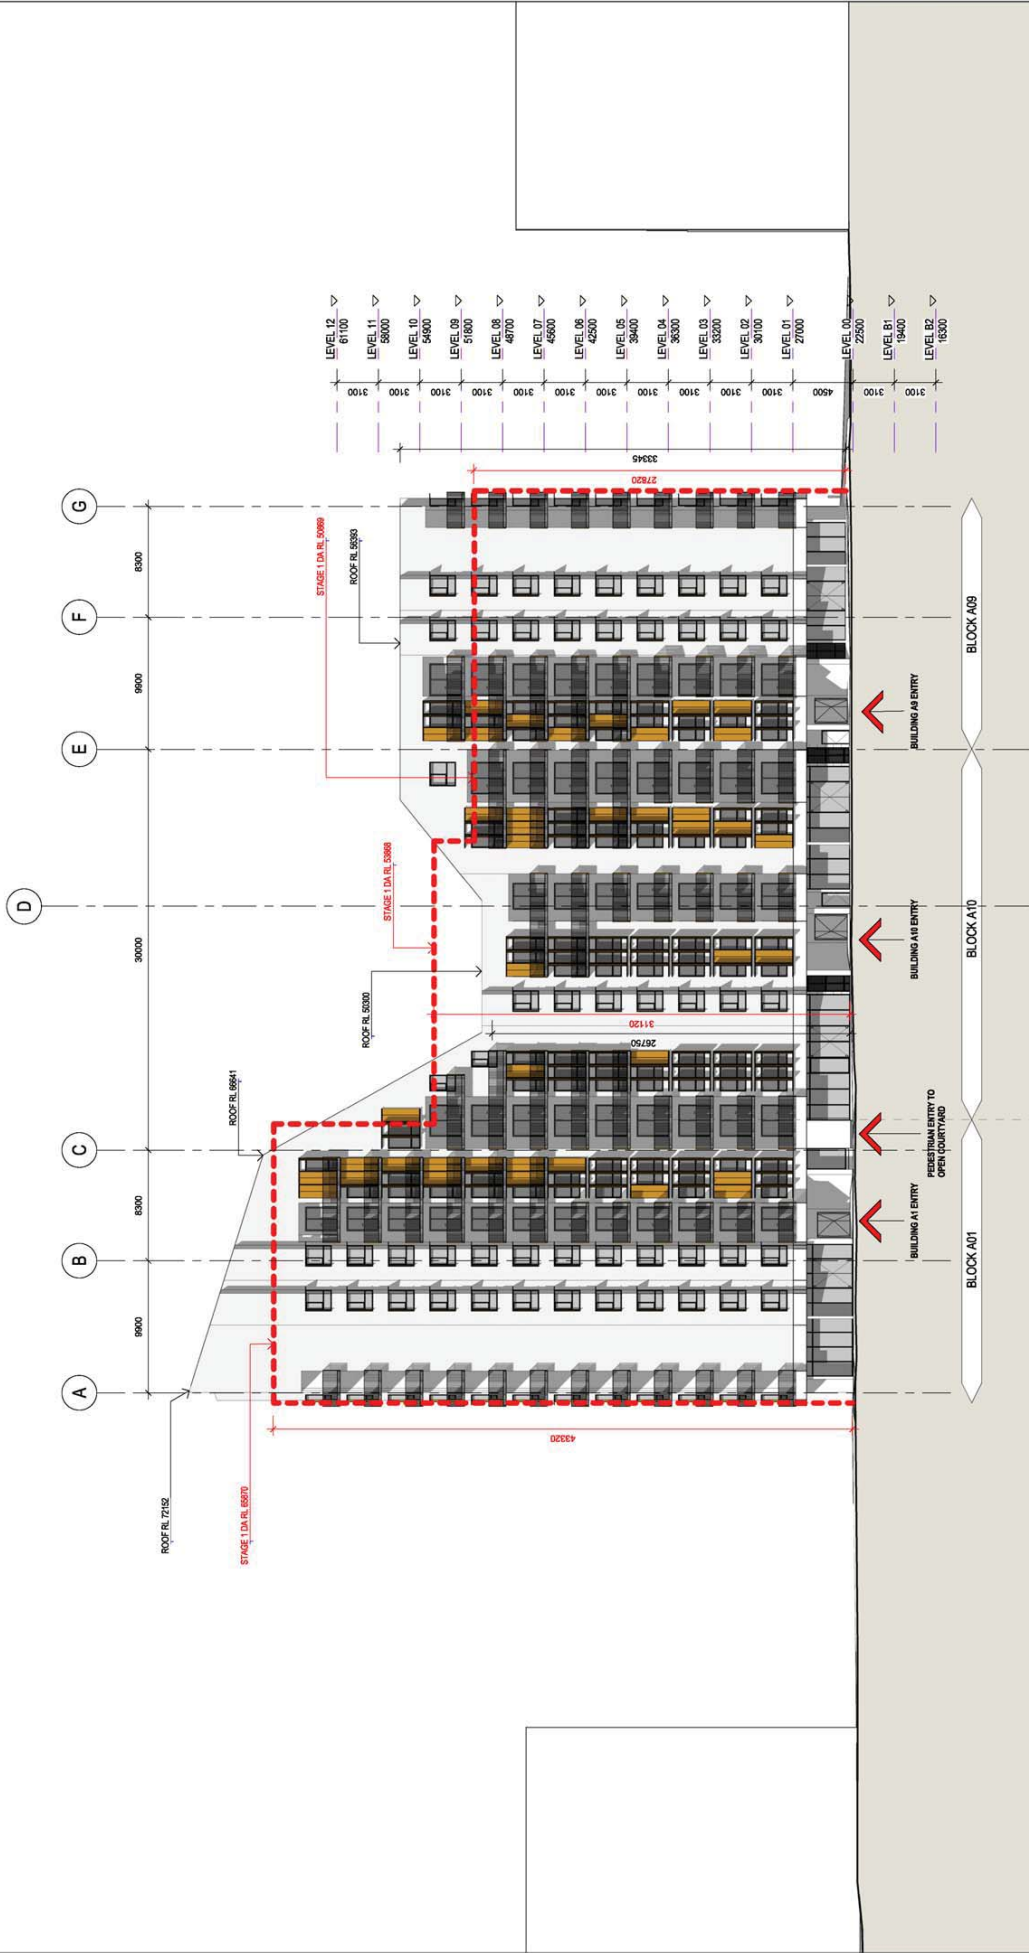

INTELLECTUAL PROPERTY
 THIS DOCUMENT IS THE PROPERTY OF BVN AND IS TO BE USED ONLY FOR THE PROJECT AND SITE SPECIFICALLY IDENTIFIED IN THE TITLE. IT IS NOT TO BE REPRODUCED, COPIED, EITHER WHOLLY OR IN PART, OR TRANSMITTED IN ANY FORM OR BY ANY MEANS, WITHOUT THE WRITTEN PERMISSION OF BVN. THE INFORMATION CONTAINED HEREIN IS CONFIDENTIAL AND IS NOT TO BE DISCLOSED TO ANY OTHER PARTY WITHOUT THE WRITTEN PERMISSION OF BVN. THE INFORMATION CONTAINED HEREIN IS NOT TO BE USED FOR ANY OTHER PROJECT OR SITE WITHOUT THE WRITTEN PERMISSION OF BVN.

NOTE:
 1. THIS DRAWING IS TO BE USED IN CONJUNCTION WITH ALL DRAWINGS IN THIS PROJECT.
 2. THIS DRAWING IS TO BE USED IN CONJUNCTION WITH THE SITE SPECIFIC INFORMATION PROVIDED IN THE PROJECT INFORMATION DOCUMENT (PID).

| NO. | DATE | BY | FOR |
|-----|----------|-----------------|---------|
| 1 | 17/04/15 | PL/ARCHITECTURE | CONCEPT |
| 2 | 22/06/15 | PL/ARCHITECTURE | CONCEPT |
| 3 | 15/07/15 | PL/ARCHITECTURE | CONCEPT |
| 4 | 15/07/15 | DA/ARCHITECTURE | CONCEPT |
| 5 | 21/07/15 | DA/ARCHITECTURE | CONCEPT |

ATTACHMENT A



CLIENT
 PROJECT
 BUILDING A ROSEBERY OVERLAND GARDENS
 56-67 EPSOM ROAD, ROSEBERY NSW

DATE PROJECT NUMBER
 15/10/15 001
 DRAWING NO. 507




GRAPHIC SCALE
 SCALE 1:100
 SCALE 1:1000

DATE SCALE
 DEVELOPMENT APPLICATION
 DRAWING

SOUTH ELEVATION
 ISSUE
 AR-DA-3003
 5

LEGEND :
 STAGE 1 DA OUTLINE

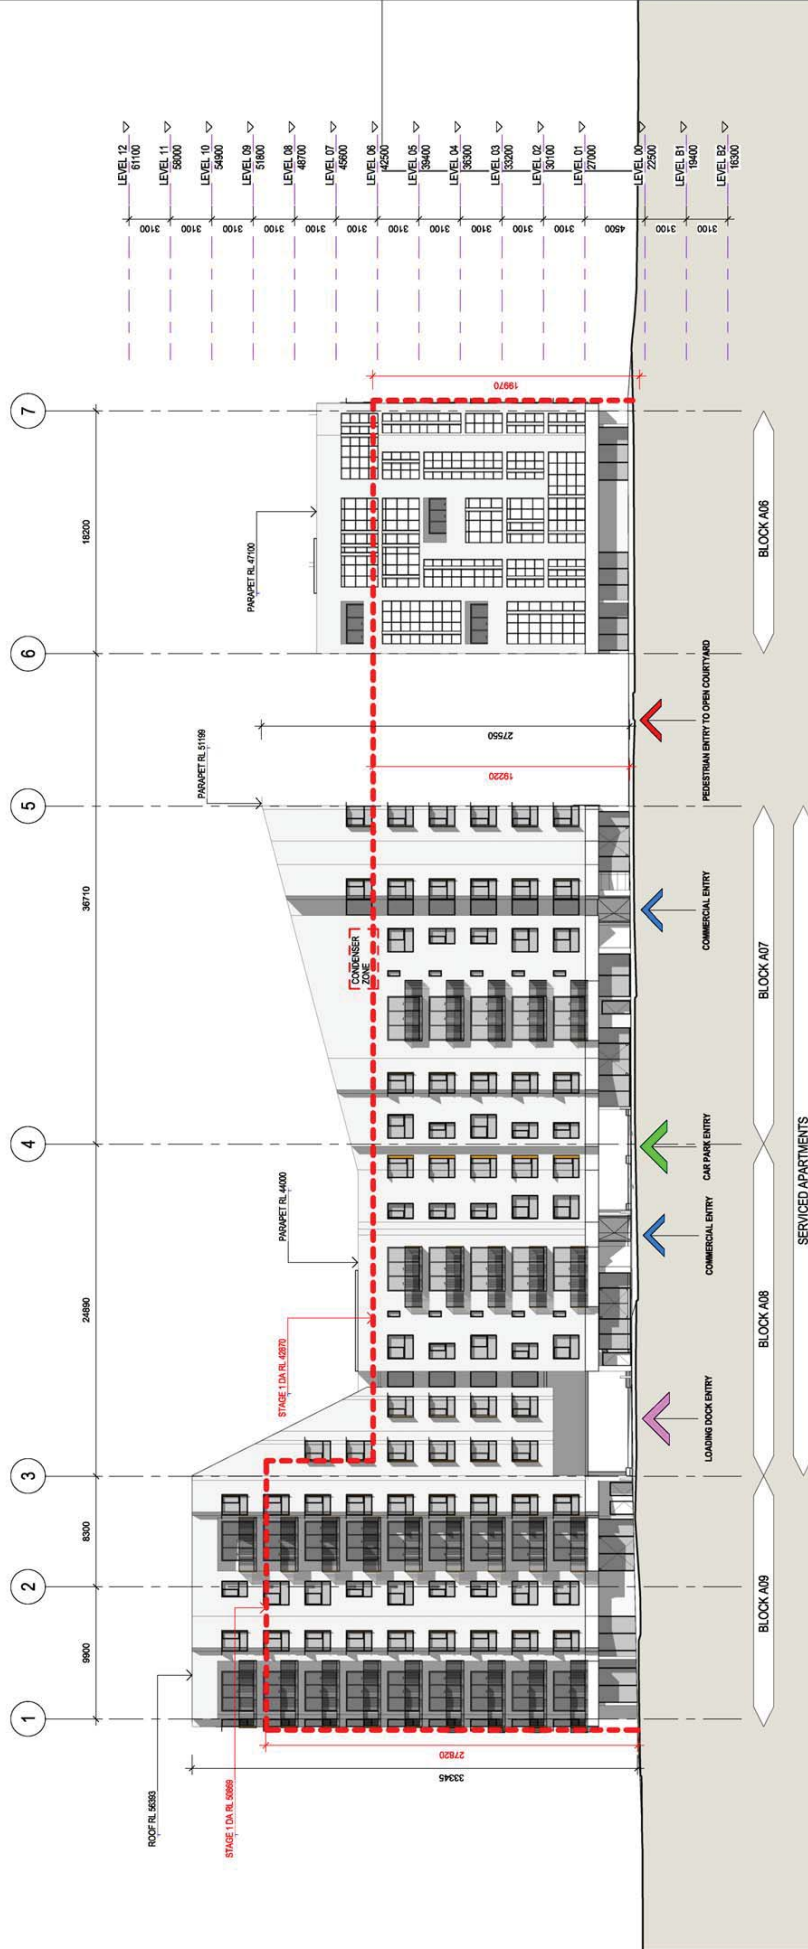




NOTES
 1. THIS DRAWING IS TO BE USED AS A REFERENCE ONLY. ALL DIMENSIONS SHALL BE TO THE
 CENTERLINE UNLESS OTHERWISE SPECIFIED.
 2. ALL DIMENSIONS SHALL BE TO THE CENTERLINE UNLESS OTHERWISE SPECIFIED.

| NO. | DATE | BY | CHKD | DESCRIPTION |
|-----|----------|----|------|-----------------|

ATTACHMENT A



PROJECT
 BUILDING A ROSEBERRY OVERLAND GARDENS
 66-87 EPSOM ROAD, ROSEBERRY NSW
 DWG PROJECT NUMBER
 15/01/001 DWG
 DRAWN BY: JET

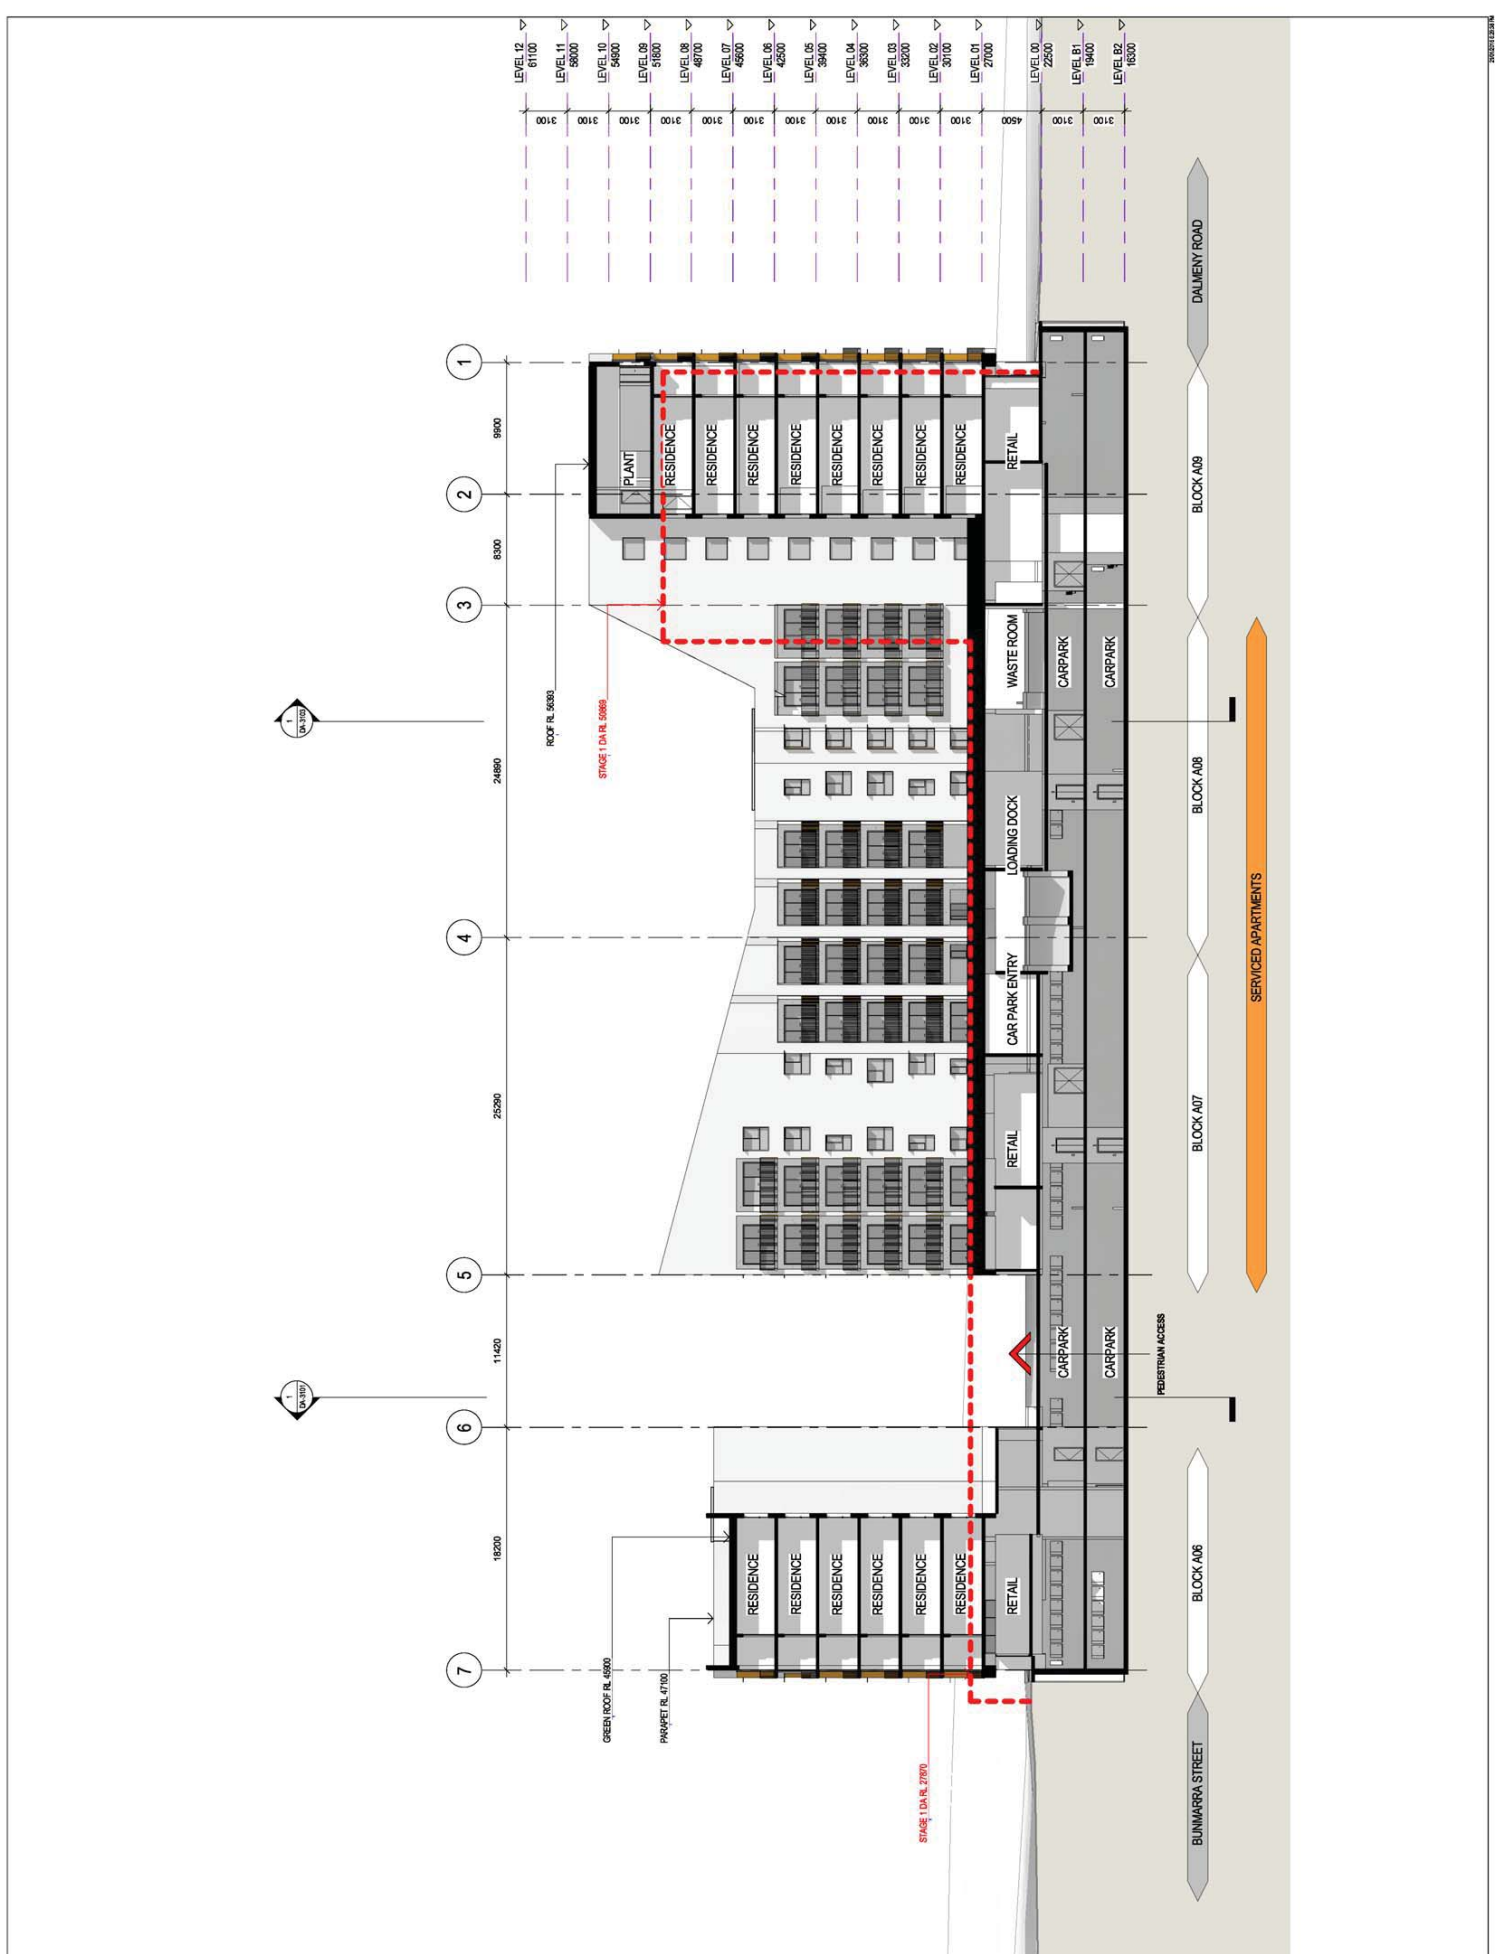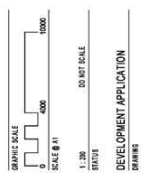

INTELLECTUAL PROPERTY


NOTES
 1. THIS DRAWING IS TO BE USED AS A REFERENCE ONLY. ALL DIMENSIONS SHOWN ON THIS DRAWING SHALL TAKE PRECEDENCE OVER ANY DIMENSIONS SHOWN ON ANY OTHER DRAWING.
 2. THE CLIENT IS RESPONSIBLE FOR OBTAINING ALL NECESSARY APPROVALS FROM THE RELEVANT AUTHORITIES.
 3. THE CLIENT IS RESPONSIBLE FOR OBTAINING ALL NECESSARY APPROVALS FROM THE RELEVANT AUTHORITIES.

| NO. | DATE | BY | FOR |
|-----|----------|----|-----|
| 1 | 08/08/15 | DA | DA |
| 2 | 08/08/15 | DA | DA |
ATTACHMENT A



CLIENT
 TOPSPACE

PROJECT
 BUILDING A ROSEBERRY OVERLAND GARDENS
 64-87 EPSOM ROAD, ROSEBERRY NSW

PROJECT NUMBER
 15/01/001_D04

DRAWING SET
 DRAWING A-01



GRAPHIC SCALE
 0 5000 10000

SCALE 1:100

DATE
 15/08/15






DEVELOPMENT APPLICATION
 DRAWING

SECTION BB

ISSUE
 6

AR-DA-3101

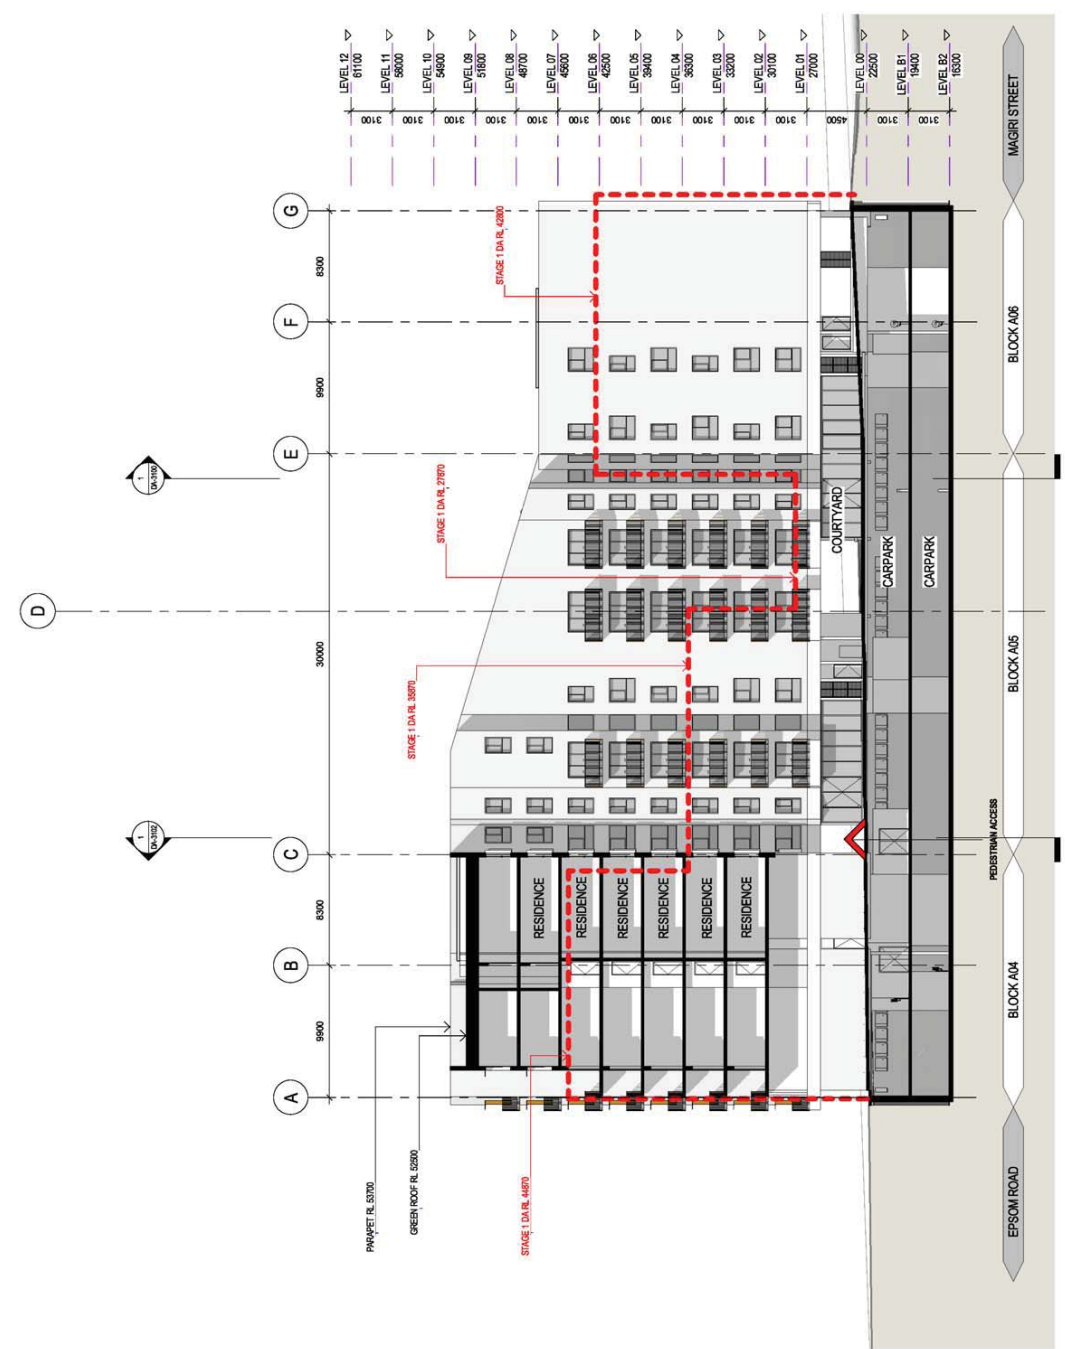

INTELLECTUAL PROPERTY


NOTES
 1. THIS DRAWING IS TO BE USED FOR ALL INFORMATION FROM THIS DRAWING TO BE USED FOR THE PROJECT.
 2. THIS DRAWING IS TO BE USED FOR THE PROJECT ONLY.

| NO. | DATE | BY | FOR |
|-----|----------|----|-----------------|


ATTACHMENT A



PROJECT
 BUILDING A ROSEBURY OVERLAND GARDENS
 64-67 EPSOM ROAD, ROSEBURY NSW



GRAPHIC SCALE
 DEVELOPMENT APPLICATION
 DRAWING

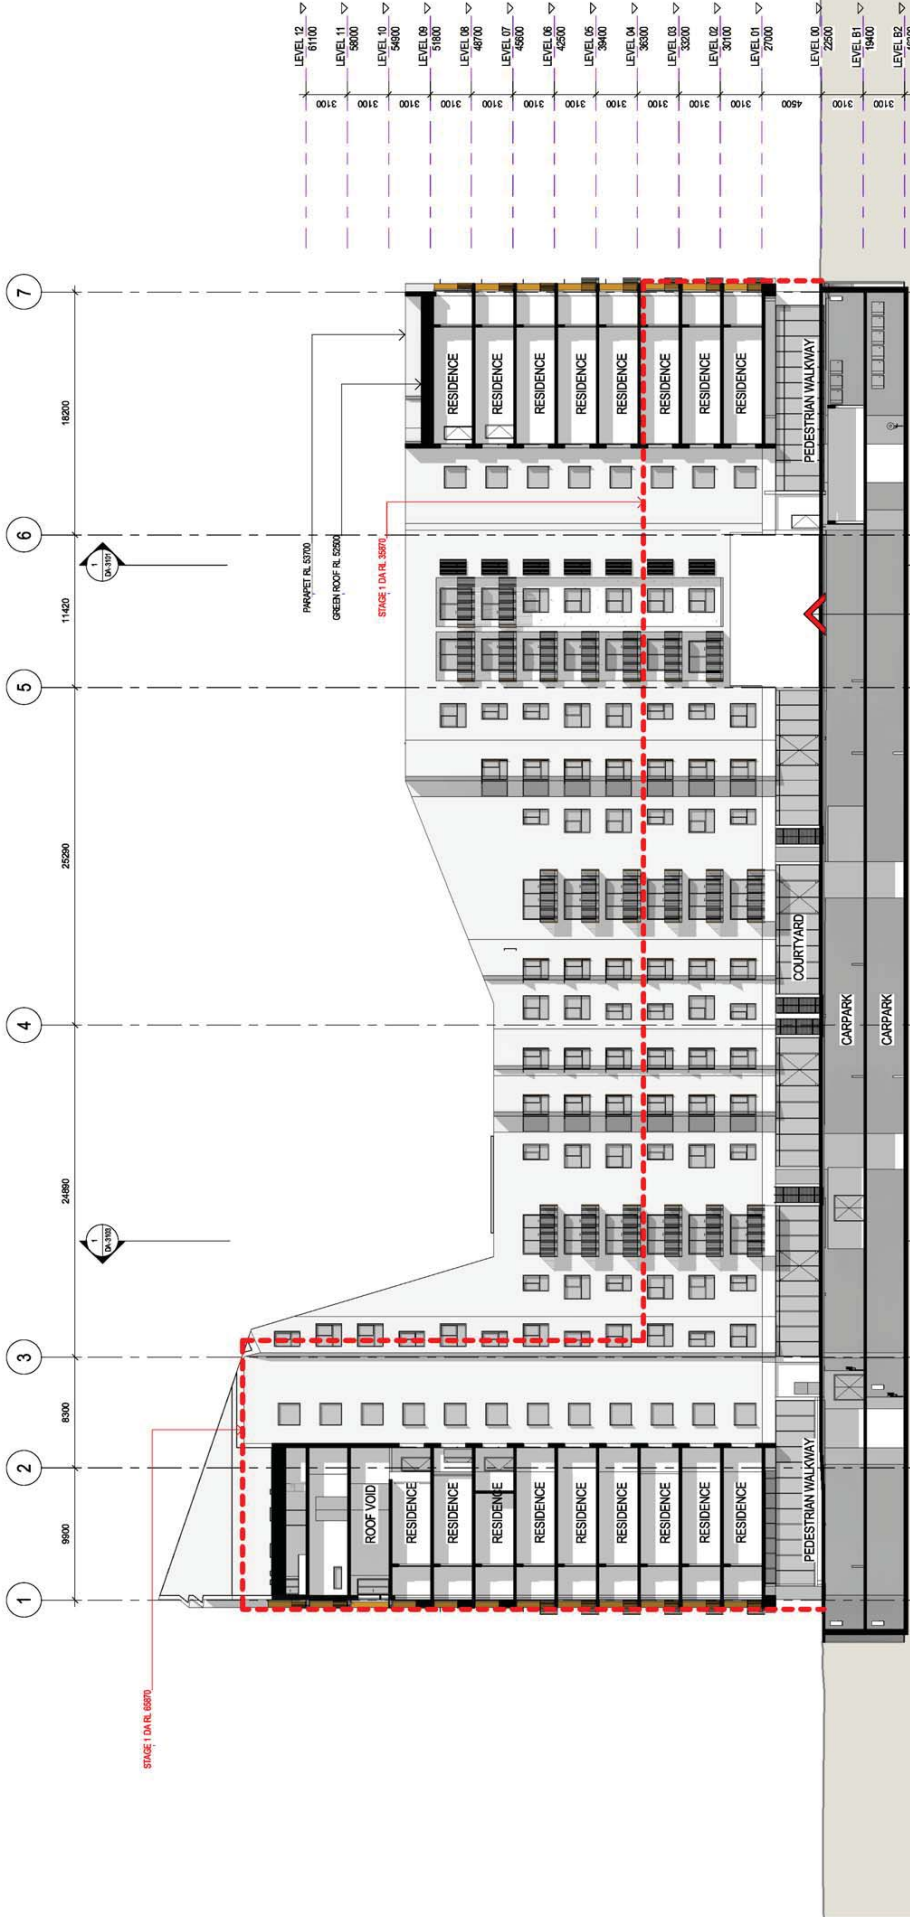

INTELLECTUAL PROPERTY


NOTES

ATTACHMENT A



CLIENT
 PROJECT

PROJECT
 BUILDING A ROSEBERRY OVERLAND GARDENS
 66-87 EPSOM ROAD, ROSEBERRY NSW

DATE
 DRAWING SET



GRAPHIC SCALE
 0 5000 10000
 SCALE @ 1:1000

DATE
 DRAWING SET


DEVELOPMENT APPLICATION
 DRAWING

SECTION DD

AR-DA-3103

ISSUE

6

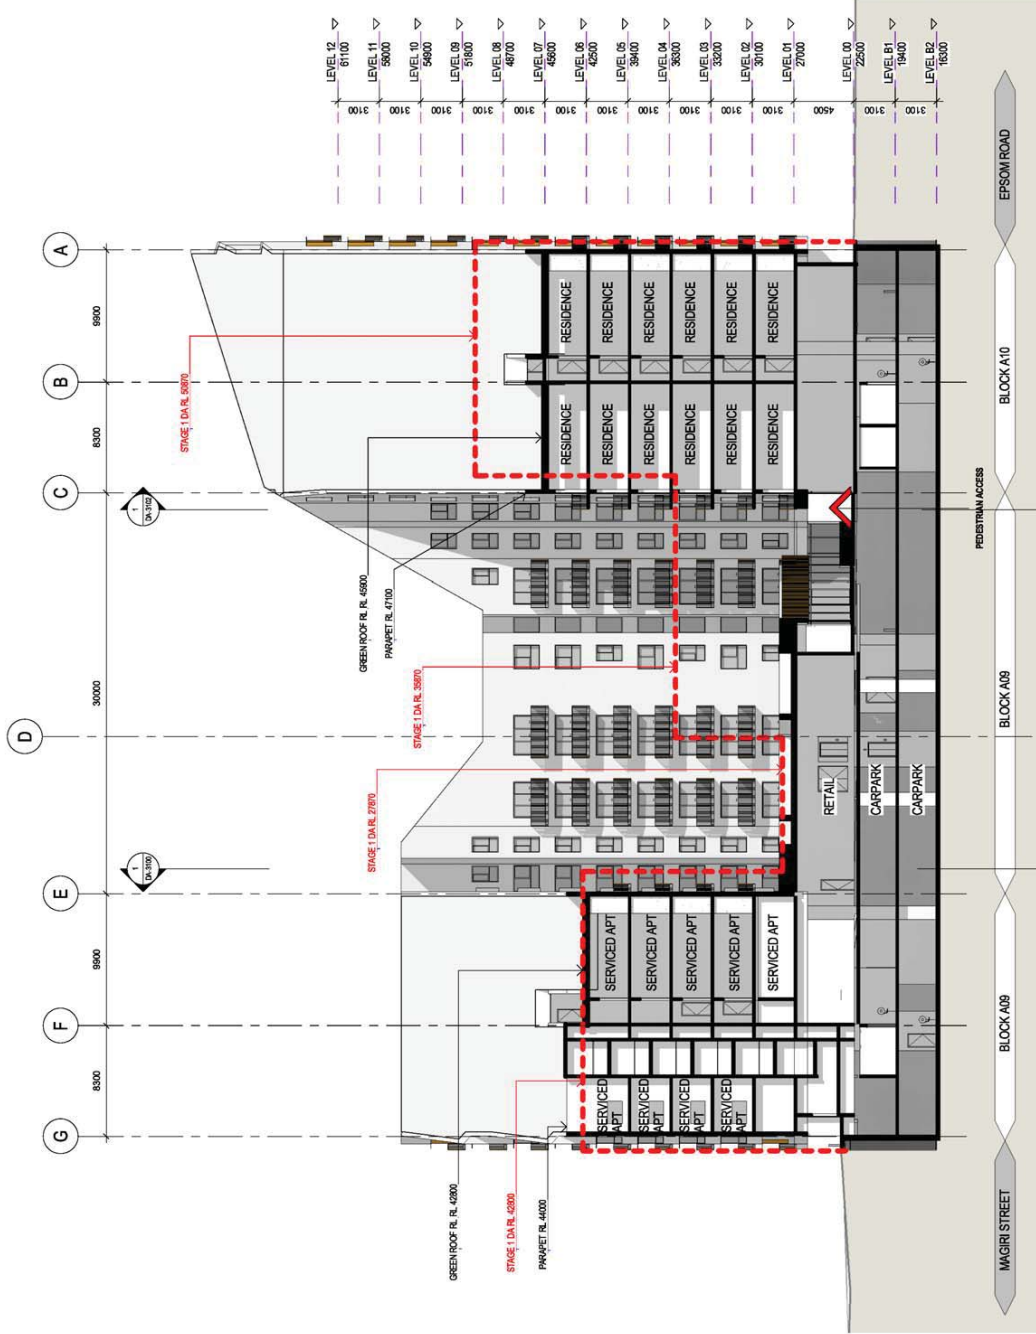

INTELLECTUAL PROPERTY


NOTES

| NO. | DATE | BY | REVISION |
|-----|----------|---------|------------------|
| 1 | 08/05/15 | DA/ANMP | ISSUE FOR PERMIT |
| 2 | 22/07/15 | DA/ANMP | REVISED PERMIT |

ATTACHMENT A



CURT
 CENT TOWER
 PROJECT


BUILDING A ROSEBERRY OVERLAND GARDENS
 66-87 EPSOM ROAD, ROSEBERRY NSW
 15/01/01 D02
 DRAWING SET



TIME NORTH
 GRAPHIC SCALE
 SCALE 1:1000
 SCALE 1:5000

1:500
 1:1000
 1:5000
 DEVELOPMENT APPLICATION
 DRAWING

GFA PLANS
 AR-DA-400
 ISSUE 4

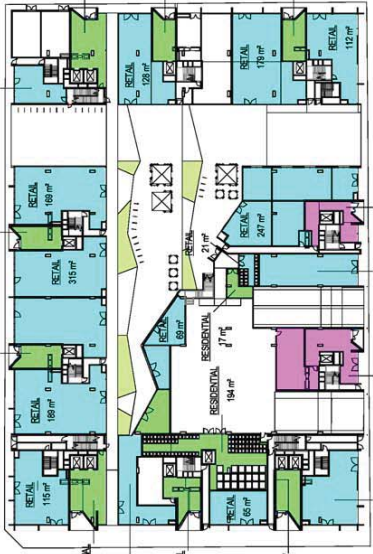


3 LEVEL 00
 1:500



6 LEVEL 03
 1:500



9 LEVEL 06
 1:500

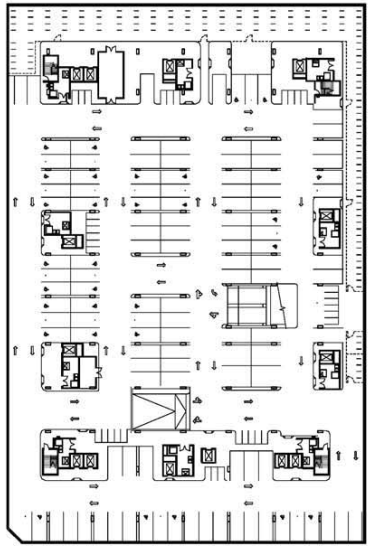


2 LEVEL B1
 1:500



5 LEVEL 02
 1:500



8 LEVEL 05
 1:500

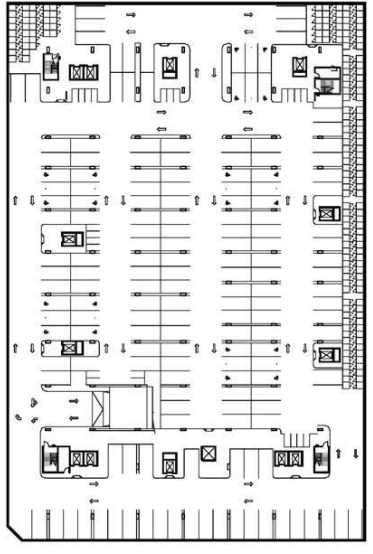

1 LEVEL B2
 1:500



4 LEVEL 01
 1:500



7 LEVEL 04
 1:500

INTELLECTUAL PROPERTY


NOTE:
 THIS DRAWING IS TO BE USED AS A REFERENCE ONLY. ALL DIMENSIONS SHOWN ON THIS DRAWING SHALL BE TAKEN FROM THE DIMENSIONS OF THE SHOP DRAWINGS, UNLESS OTHERWISE SPECIFIED.

| NO. | DATE | ISSUE |
|-----|----------|--------------|
| 1 | 08/01/15 | FOR PERMIT |
| 2 | 08/05/15 | FOR APPROVAL |
| 3 | 22/07/15 | FOR APPROVAL |
| 4 | 22/07/15 | FOR APPROVAL |

ATTACHMENT A

CLIENT
 TOPSPACE
 CLIENT NUMBER
 PROJECT

BUILDING A ROSEBERRY OVERLAND GARDENS
 64-87 EPSOM ROAD, ROSEBERRY NSW
 DWG PROJECT NUMBER

15/01/001.DWG
 DRAWING SET




TRUE NORTH
 PROJECT NORTH



SCALE 1:500
 SCALE 1:1000
 SCALE 1:2000
 DRAWING SCALE

DEVELOPMENT APPLICATION
 DRAWING

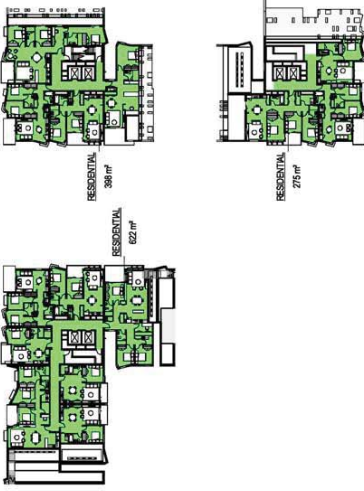

1 LEVEL 07
 1:500




2 LEVEL 08
 1:500



3 LEVEL 09
 1:500



4 LEVEL 10
 1:500

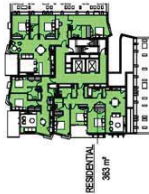

5 LEVEL 11
 1:500



6 LEVEL 12
 1:500



7 LEVEL 13
 1:500