

Attachment B2

Selected Plans


MATERIAL LEGEND



WFB 1 - FACE BRICK - PURE VENETS CRUSHED GREY




SST - SAND STONE WALL
 FINISH: SANDSTONE
 PRIMER: SANDSTONE WALL

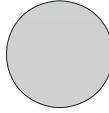


PCA 1 WFN 1 WFB
 POWDER COATING OR PAINT
 COLOUR TO MATCH
 SOUTH - SOUTHERLY
 (ROOFING)



WFB 2 WFN 2 WMS 2 PCA 2
 MATCH WOODLAND GREY
 (WINDOWS, PRIVACY SCREENS,
 GUTTERS AND TRIMS)

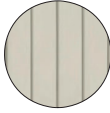

WFB 1
 FIBRE CEMENT WEATHERBOARD
 CLADDING (LIGHT CREAM COLOUR)

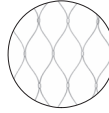

PROPOSED STAINLESS STEEL NETTING
 WITH
 BLACK PAINTED STEEL SUPPORT
 POSTS



RDR 1
 RENDERED MASONRY (WHITE)




SCALE 1:250

DA550
 ARCHITECTURE
 15
 ROAD



STREETSCAPE (ROCKWALL LANE)


PROPOSED FINISH
 ST VINCENT'S COLLEGE DEVELOPMENT APPLICATION
 ROKWALL URBESSENT POTTSPOINT NSW 2208
 PROJECT TITLE
 ROCKWALL URBESSENT POTTSPOINT NSW 2208
 PROJECT TITLE
 ST VINCENT'S COLLEGE POTTSPOINT
 CLIENT

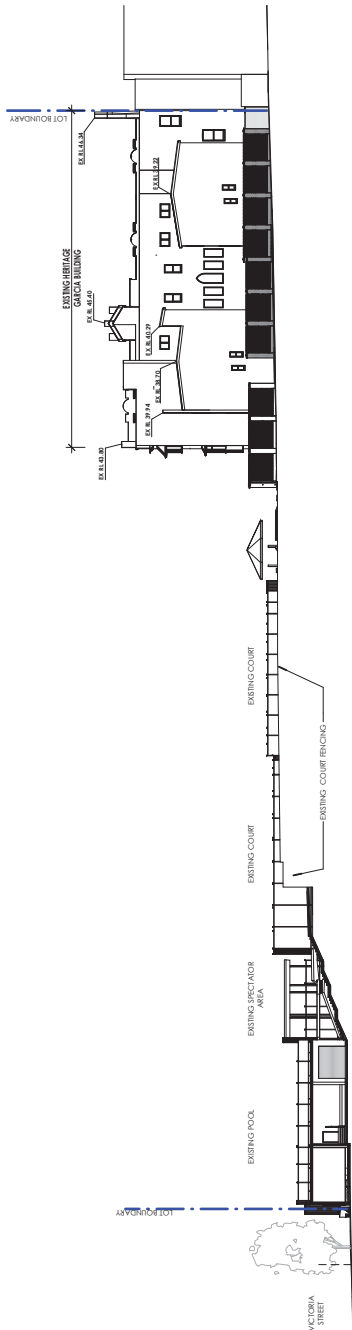

EXISTING ELEVATION - ROCKWALL LANE (SOUTHERN ELEVATION)
 1:250

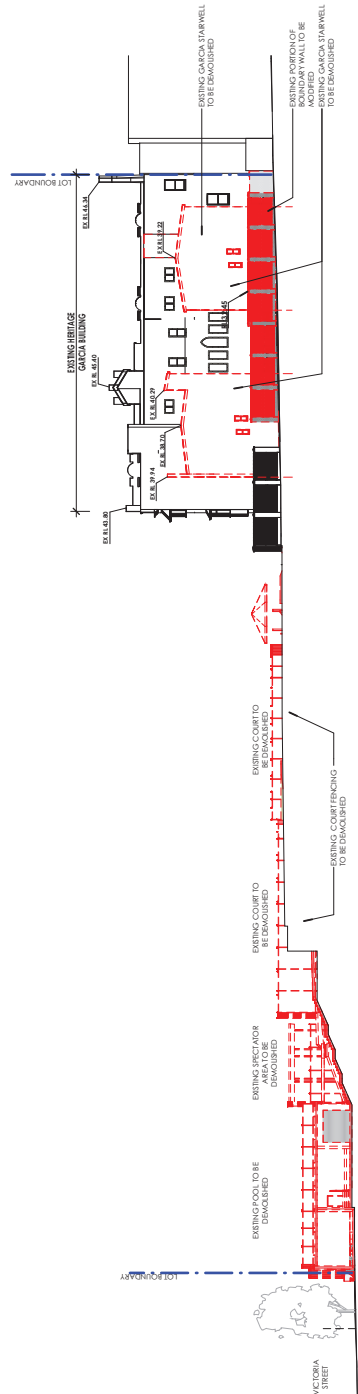

DEMOLITION ELEVATION - ROCKWALL LANE (SOUTHERN ELEVATION)
 1:250

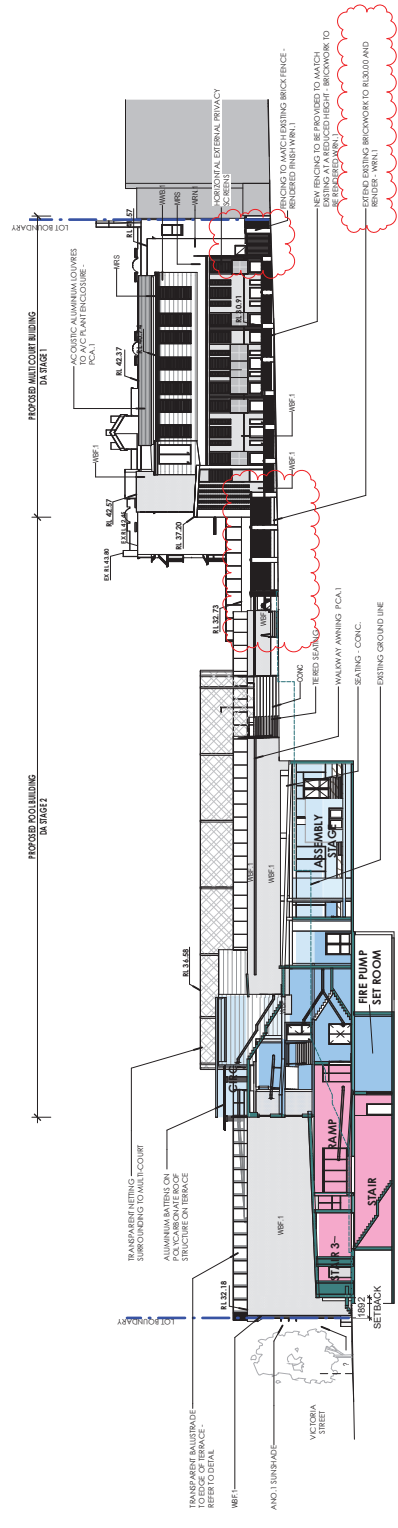

PROPOSED ELEVATION - ROCKWALL LANE (SOUTHERN ELEVATION)
 1:250

LEGEND

DATE	REVISION	DESCRIPTION	BY	CHK

LEGEND



MATERIAL LEGEND



WFB.1 - FACE BRICK - PURE VENETS CRUSHED GREY




SST - SAND STONE WALL
 FINISH: SANDSTONE WITH
 PRIMER SANDSTONE WALL

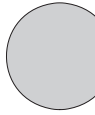

FCA.1 WFN.1 WFE
 POWDERCOATING OR PAINT
 COLOUR TO MATCH
 COLOUR - SOUTHERLY
 (ROOFING)



WWS.2 WWS.1 WWS.2 WWS.1
 WOOD FINISH TO
 MATCH WOOD AND GREY
 (WINDOWS, PRIVACY SCREENS,
 GUTTERS AND TRIMS)

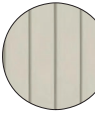

WWB.1
 FIBRE CEMENT WEATHERBOARD
 CLADDING (LIGHT CREAM COLOUR)




RDR.1
 RENDERED MASONRY (WHITE)




PROPOSED STAINLESS STEEL NETTING
 WITH
 BLACK PAINTED STEEL SUPPORT
 POSTS




DA560
 PROJECT NUMBER
8
 DRAWING TITLE
8
 DATE
 EMAIL - info@leafarch.com.au
 WEBSITE - www.leafarch.com.au
 PROJECT NUMBER
21048

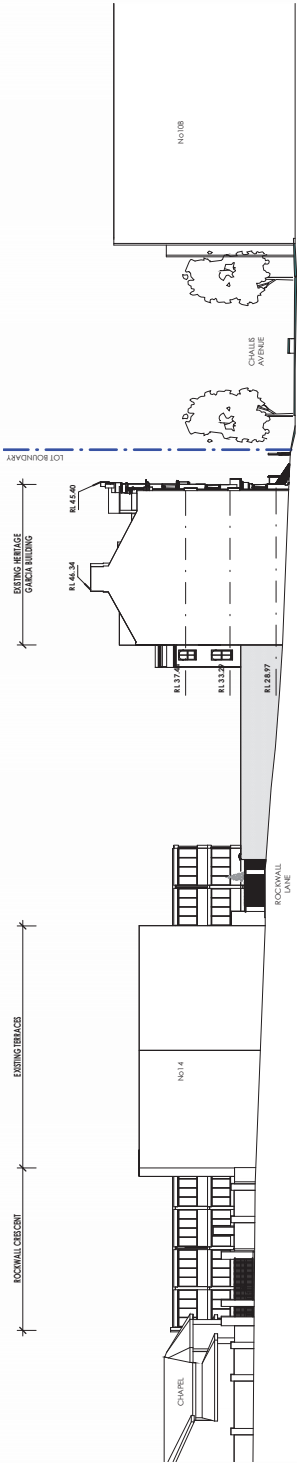

EXISTING ELEVATION - EASTERN ELEVATION
 1:250

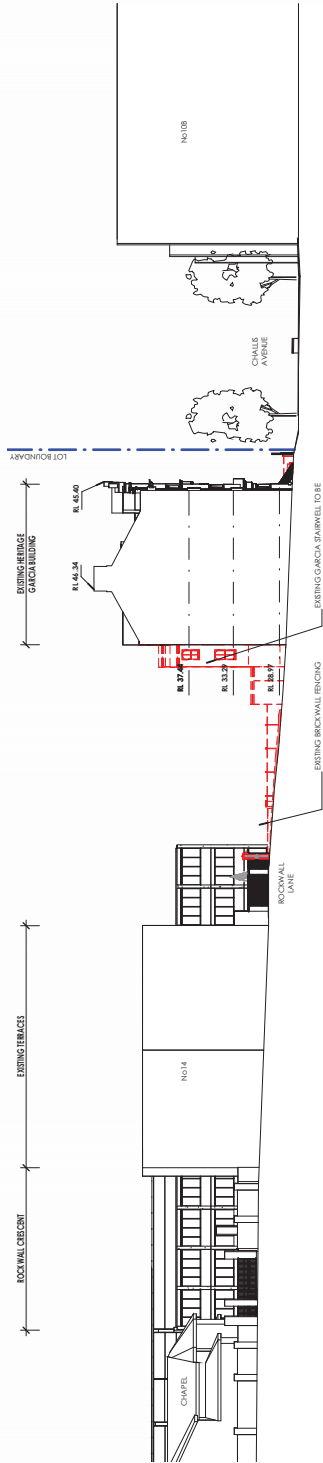

DEMOLITION ELEVATION EASTERN ELEVATION
 1:250

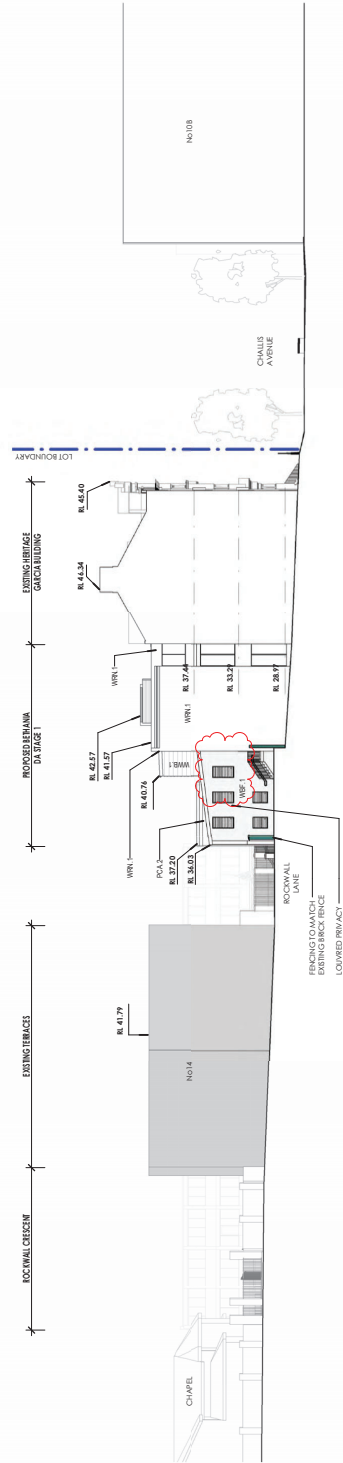

PROPOSED ELEVATION - EASTERN ELEVATION
 1:250


NO	DATE	REVISION	BY	CHECKED	APPV	LEGEND

LEGEND
DA STAGE 1
VOID OVER DA STAGE 1
DA STAGE 2
VOID OVER DA STAGE 2
NO DA WORKS - EXISTING BUILDINGS
UP HEIGHT LINE
SITE BOUNDARY


DEVELOPMENT APPLICATION
 PROJECT TITLE
ST VINCENT'S COLLEGE DEVELOPMENT APPLICATION
 PROJECT TITLE
ST VINCENT'S COLLEGE POTTS POINT
 CLIENT
ST VINCENT'S COLLEGE POTTS POINT

STREETSCAPE (EASTERN ELEVATION)
 PROJECT TITLE
ST VINCENT'S COLLEGE DEVELOPMENT APPLICATION
 PROJECT TITLE
ST VINCENT'S COLLEGE POTTS POINT
 CLIENT
ST VINCENT'S COLLEGE POTTS POINT


DA560
 PROJECT NUMBER
8
 DRAWING TITLE
8
 DATE
 EMAIL - info@leafarch.com.au
 WEBSITE - www.leafarch.com.au
 PROJECT NUMBER
21048

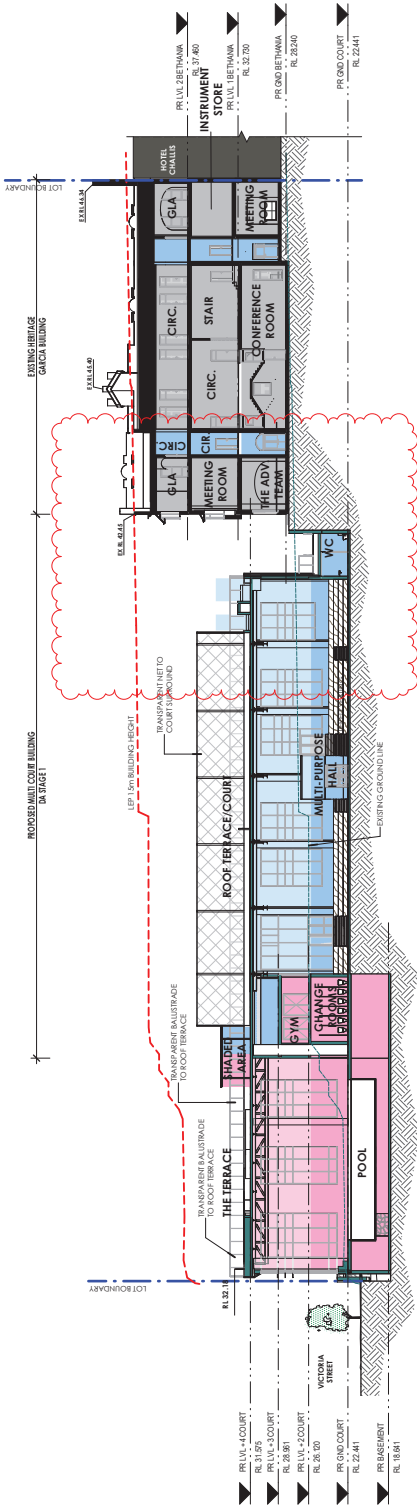

DA - SECTION H
1:250

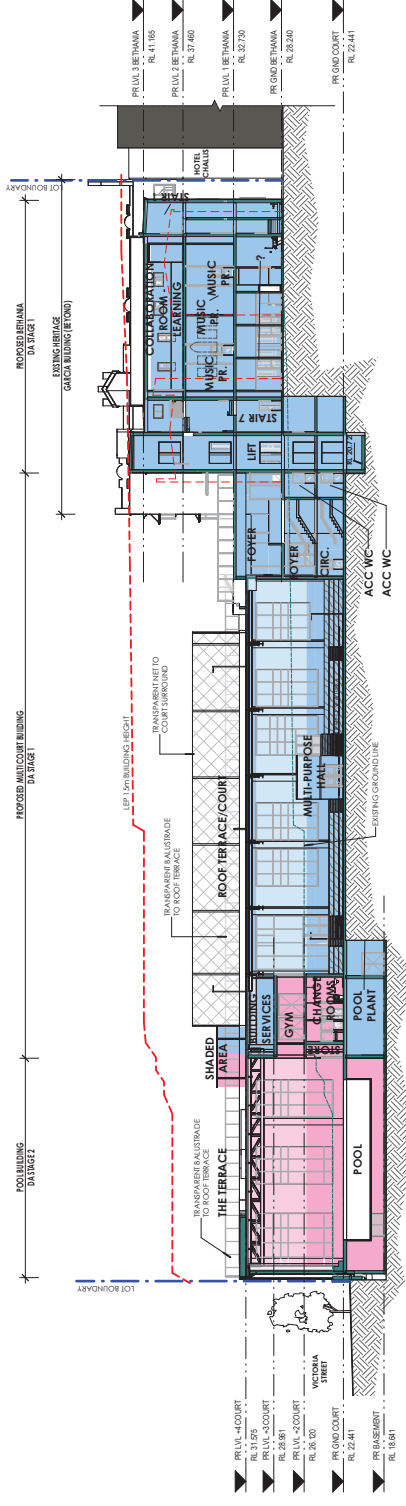

DA - SECTION M
1:250

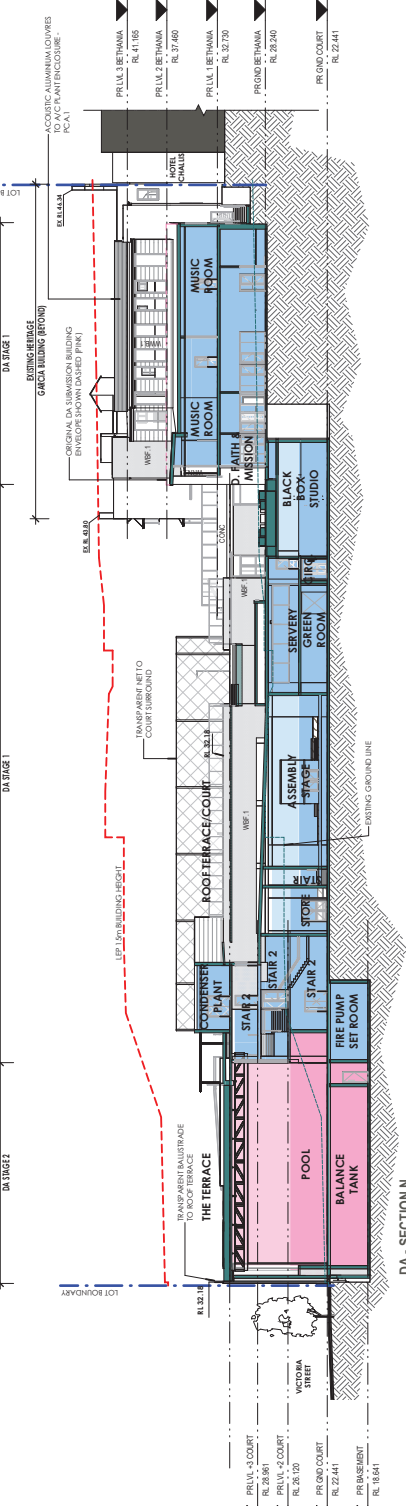

DA - SECTION N
1:250

DATE	REVISION

DEVELOPMENT APPLICATION
 ST WINCENT'S COLLEGE DEVELOPMENT APPLICATION
 ST WINCENT'S COLLEGE, POTTS POINT
 CLIENT: ST WINCENT'S COLLEGE, POTTS POINT

PROPOSED SECTIONS
 DA 552
 16
 ARCHITECTURE
 LEAF ARCHITECTURE
 STUDIO Level 11, 12, 13 Queen's Chapel Lane, Potts Point NSW 2018
 PHONE (02) 9332 3030
 EMAIL info@leafarch.com.au
 www.leafarch.com.au




MATERIAL LEGEND




WF 1 - FACELIFTED, RIVE WEYATTS CRUSHED GRIT



SST - SAND STONE WALL (DETAILED TO MATCH EXISTING PERIMETER SANDSTONE WALL)

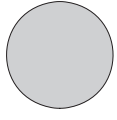


PCA 1 - WRM 1/WMS OR PAINT (DETAILED TO MATCH EXISTING COLOUR TO MATCH COLORBOND - SOUTHERLY COLORBOND)

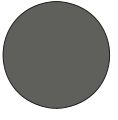

WWS 2 - WRM 2/WMS 2/PCA 2 (POWDER COATING OR PAINT TO MATCH EXISTING COLOUR TO MATCH WINDOWS, FRAMA, SCREENS, GUTTERS AND TRIMS)



WWS 1 - WWS 1 (WIRE GEMME WEATHERBOARD CLADDING (LIGHT CREAM COLOUR))

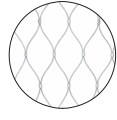


PROPOSED STAINLESS STEEL NETTING TO ROOF TERRACE/COURT WITH 50% PLY WEAVER STEEL SUPPORT POSTS




RMR 1 - RENDERED MASONRY (WHITE)

DA550
14
 ARCHITECTURE

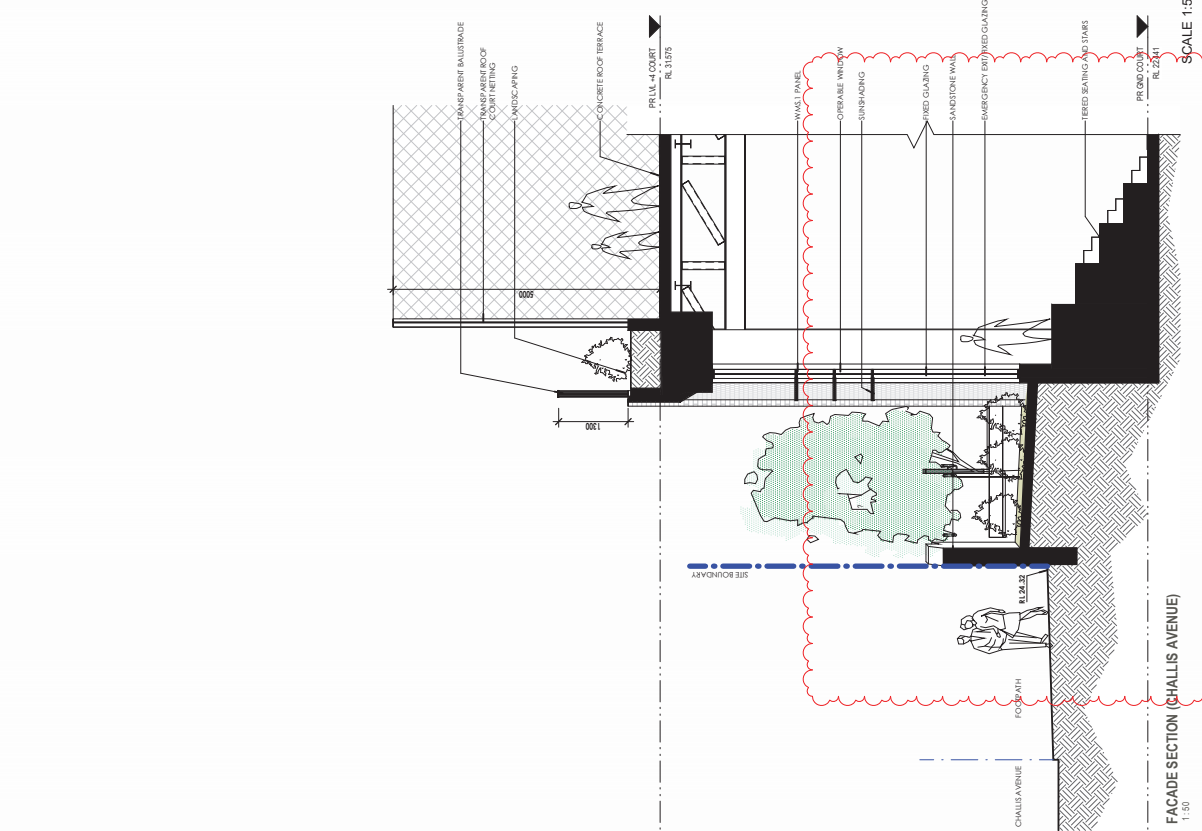

SCALE 1:50
 FACADE SECTION (CHALLIS AVENUE)

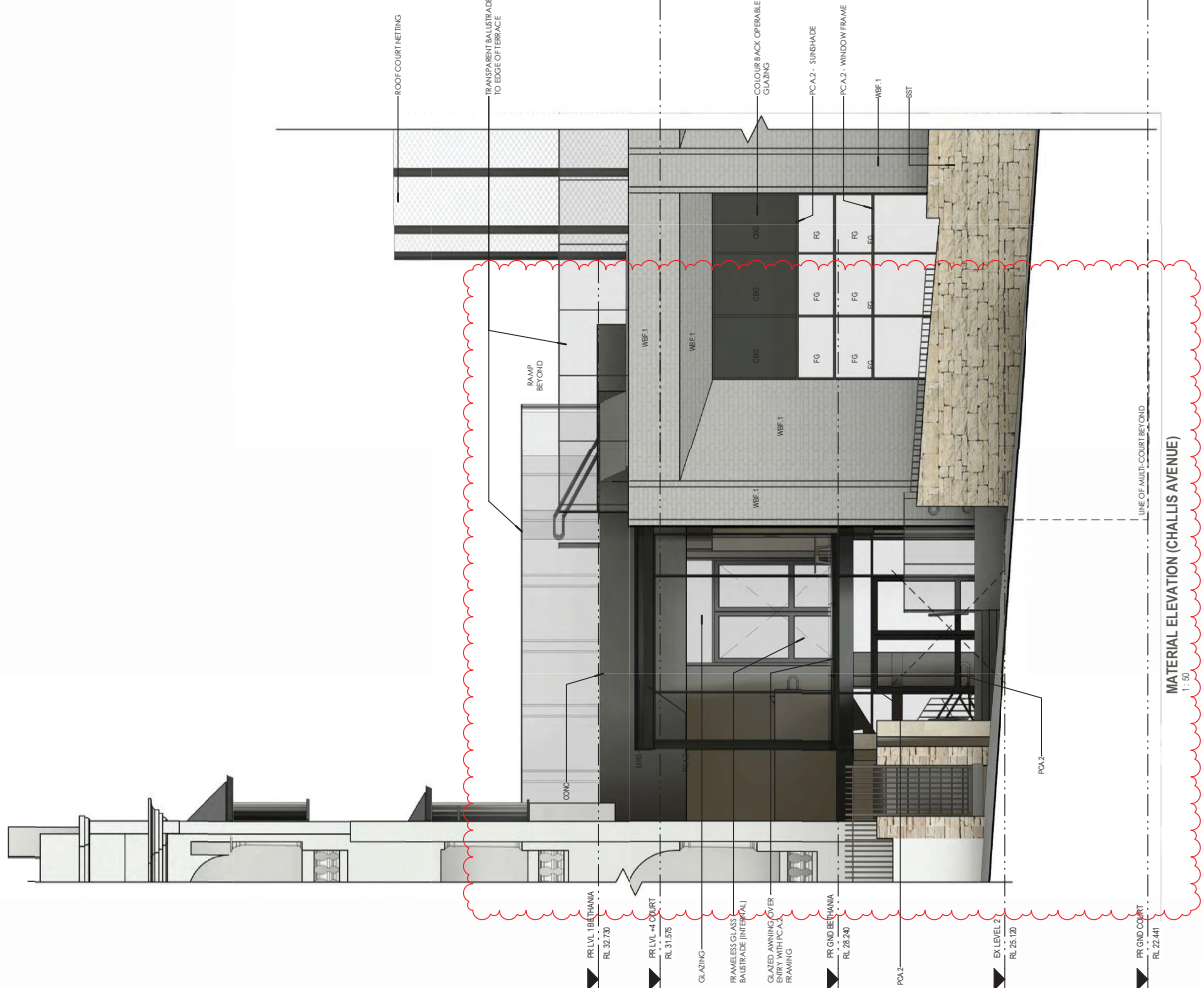


MATERIAL ELEVATION (CHALLIS AVENUE)

DEVELOPMENT APPLICATION
 PROJECT TITLE
ST VINCENT'S COLLEGE DEVELOPMENT APPLICATION
 PROJECT TITLE
 ST VINCENT'S COLLEGE, POTTS POINT
 ST VINCENT'S COLLEGE, POTTS POINT
 CLIENT

DESIGNER


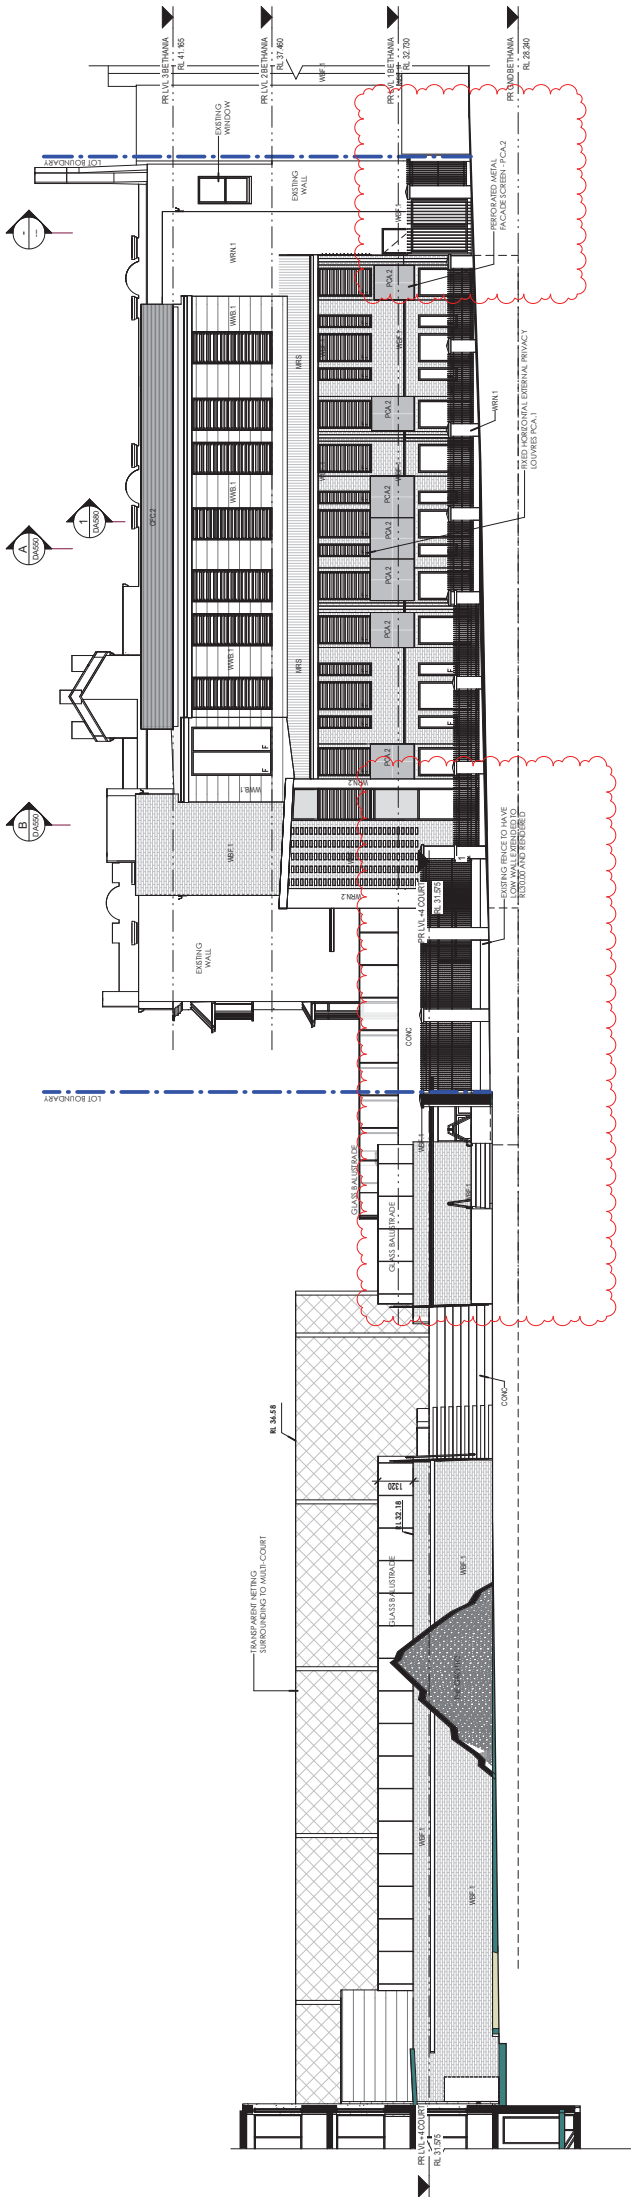

PROPOSED ELEVATION - ROCKWALL LANE (SOUTHERN ELEVATION)
1:100

MATERIAL LEGEND

- BR.1** RENDERED MASONRY (WHITE)
- BR.2** PRECAST STAINLESS STEEL NETTING TO ROOF TERRACE/COURT WITH STAINLESS STEEL SUPPORT POSTS
- WB.1** WEATHERBOARD CLADDING (LIGHT CREAM COLOUR)
- WB.1** WEATHERBOARD CLADDING (LIGHT CREAM COLOUR)
- WB.2 / WB.2 / WB.2 / PCA.2** POWDER COATING AND PAINT TO MATCH WOODLAND GREY SCREENS, GUTTERS AND TRIMS
- PCA.1 / WB.1 / WB.1** POWDER COATING OR PAINT COLOUR TO MATCH ROOFING
- ST** SANDSTONE WALL (DETAILED TO MATCH EXISTING PERIMETER SANDSTONE WALL)
- WB.3** FACEBRICK - PURE, VELVETS CRUSHED GREY


NO.	DATE	REVISION	BY	CHECKED	STATUS
1	20/02/2024	RF - 1 - CLIENT DRAWING ISSUE	AS	ON	ISSUED
2	20/02/2024	Issue for Construction	AS	ON	
3	20/02/2024	CLIENT RFI - New Wall Finishes, Colours, Details, Materials	AS	ON	

DEVELOPMENT APPLICATION
ST VINCENT'S COLLEGE DEVELOPMENT APPLICATION
 PROJECT TITLE
 ST VINCENT'S COLLEGE POTTS POINT
 CLIENT

ELEVATION - ROCKWALL LANE


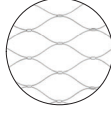
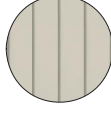

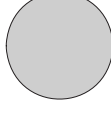


DA570
PROJECT NUMBER
9
ARCHITECTURE
 STUDIO Level 1 / 2 - 11 Down St, CHERRYVALE NSW 2038
 PHONE (02) 9339 2038
 EMAIL info@leafarch.com.au
 www.leafarch.com.au

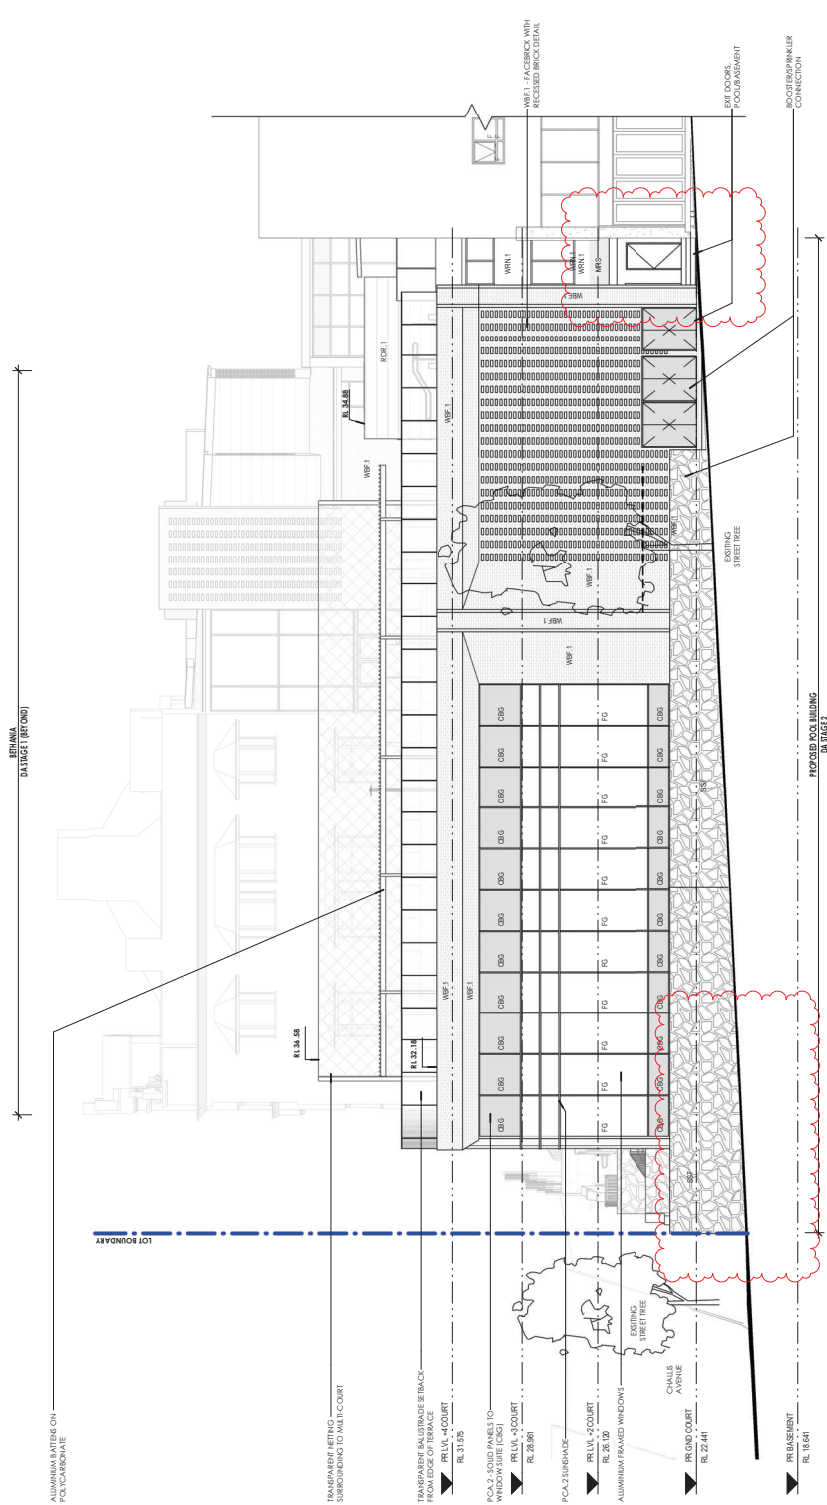



PROPOSED ELEVATION - VICTORIA STREET (WESTERN ELEVATION)
1:100

MATERIAL LEGEND


-  **BR.1** RENDERED MASONRY (WHITE)
-  **PC.1 (WV.1) W/MS** POWDER COATING OR PAINT COLOUR TO MATCH EXISTING ROOFING
-  **WB.1** WEATHERBOARD CLADDING (LIGHT CREAM COLOUR)
-  **WB.2 (WV.2) W/MS.2 / PC.A.2** POWDER COATING AND PAINT TO MATCH WOODLAND GREY SCREENS, GUTTERS AND TRIMS
-  **PC.1 (WV.1) W/MS** POWDER COATING OR PAINT COLOUR TO MATCH EXISTING ROOFING
-  **ST** SANDSTONE WALL (DETAILED TO MATCH EXISTING PERIMETER SANDSTONE WALL)
-  **WB.3** FACE BRICK - PURE VELVET CRUSHED GREY

NO.	DATE	REVISION	BY	CHECKED	STATUS
1	20/05/2024	RF-1 - CIVIL/DRAWING ISSUE	AM	AM	FOR PERMIT
2	20/05/2024	Issue for Construction	AM	AM	FOR PERMIT

DEVELOPMENT APPLICATION
ST VINCENT'S COLLEGE DEVELOPMENT APPLICATION
ST VINCENT'S COLLEGE POTTS POINT
CLIENT

DA571
PROJECT NUMBER
9
DATE
ARCHITECTURE
LEAF ARCHITECTURE
STUDIO Level 1 / 2 - 10 Down St, CHIPPENDALE NSW 2038
PHONE (02) 932 3200
EMAIL info@leafarch.com.au
21049
PROJECT NUMBER
www.leafarch.com.au



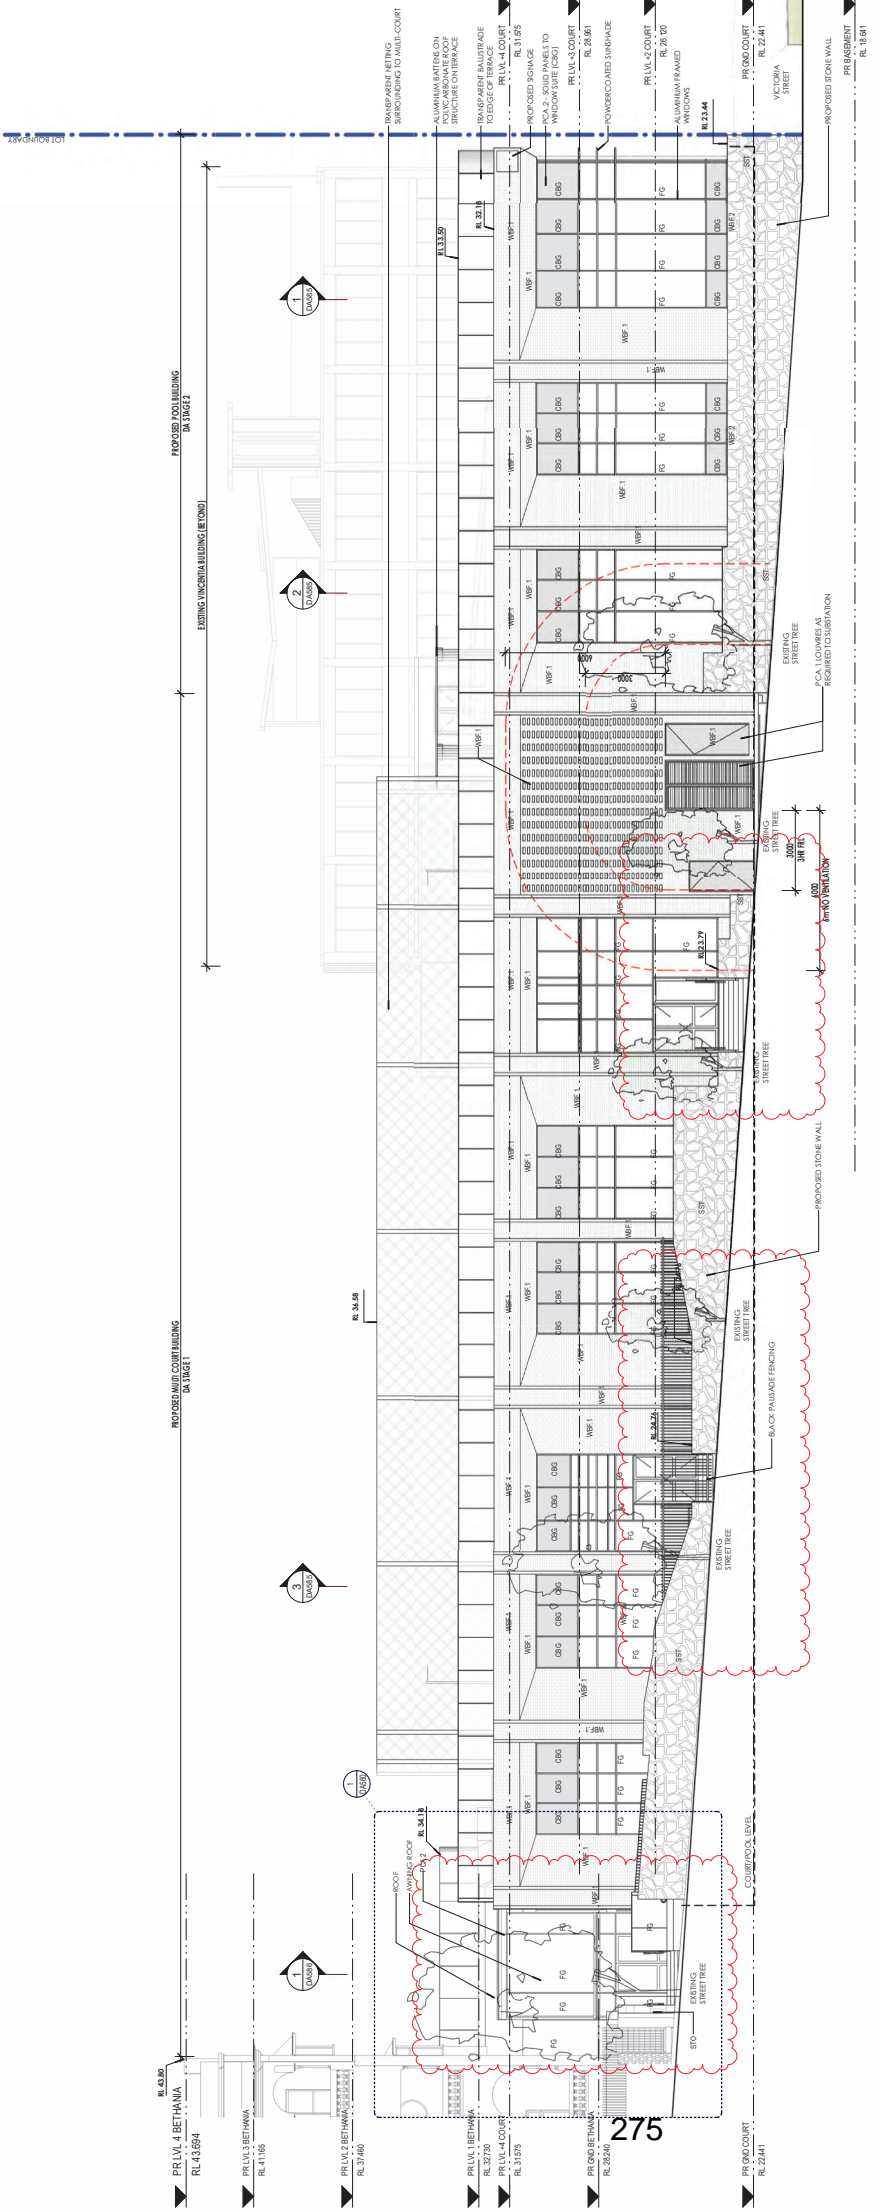

PROPOSED ELEVATION AT CHALLIS AVENUE
1:100

MATERIAL LEGEND

- | | |
|--|--|
| | RB.1
RENDERED MASONRY (WHITE) |
| | RB.2
PROPOSED STAINLESS STEEL NETTING TO ROOF TERRACE/COURT WITH SUPPORT POSTS |
| | WB.1
WEATHERBOARD CLADDING (LIGHT CREAM COLOUR) |
| | WB.2/WB.3/WB.4
WEATHERBOARD CLADDING TO MATCH WOODLAND GREY SCREENS, GUTTERS AND TRIMS |
| | FCL.1/WB.1/WB.2
POWDER COATING OR PAINT TO MATCH WOODLAND GREY |
| | SBT
SANDSTONE WALL (DETAILED TO MATCH EXISTING PERIMETER SANDSTONE WALL) |
| | WB.3
FACEBRICK - PURE VELVET CRUSHED GREY |

NO	DATE	REVISION	BY	CHKD	REVISED
1	15/02/2024	FINAL COMMENT	AS	CH	
2	20/02/2024	REVISED	AS	CH	
3	27/02/2024	ISSUE FOR PERMIT	AS	MM	
4	03/03/2024	REVISED	AS	CH	
5	04/03/2024	REVISED	AS	CH	
6	30/03/2024	ISSUE FOR PERMIT	AS	CH	
7	04/04/2024	ISSUE FOR PERMIT	AS	CH	

ELEVATION - CHALLIS AVENUE

DEVELOPMENT APPLICATION

ST VINCENT'S COLLEGE DEVELOPMENT APPLICATION

ST VINCENT'S COLLEGE - POTTS POINT

ST VINCENT'S COLLEGE - POTTS POINT

ST VINCENT'S COLLEGE - POTTS POINT

DA572

DRAFT


7

7



SCALE 1:100


10m

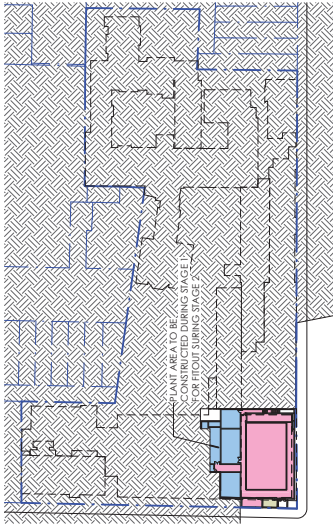


PROPOSED BASEMENT LEVEL
1:1,000

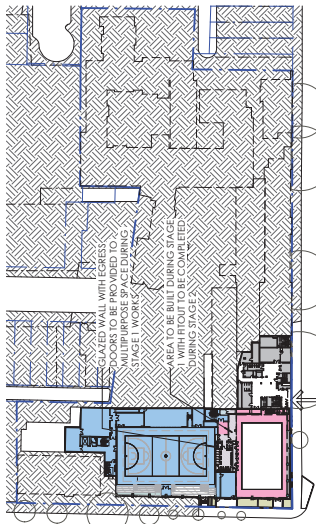


FLOOR PLAN - LEVEL 1
1:1,000

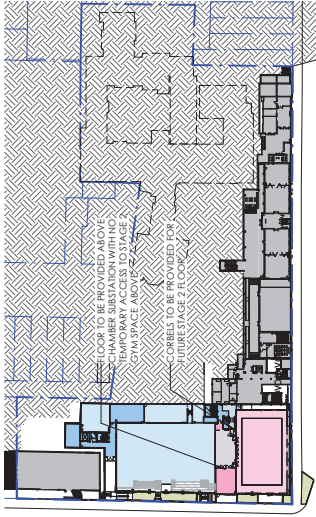


FLOOR PLAN - LEVEL 2
1:1,000

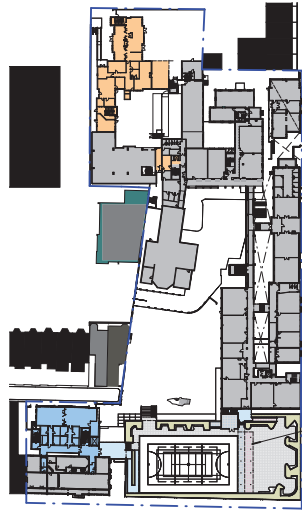

FLOOR PLAN - LEVEL 4
1:1,000

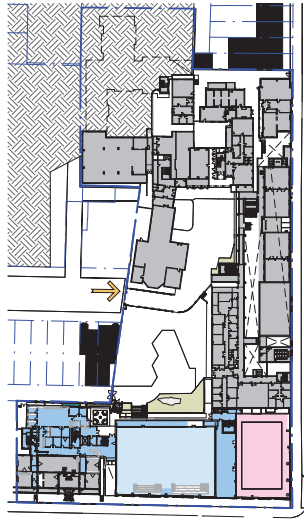

FLOOR PLAN - LEVEL 3
1:1,000

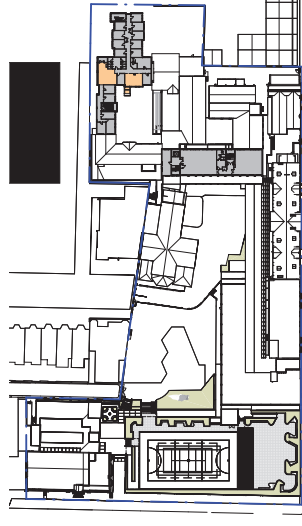

FLOOR PLAN - LEVEL 6
1:1,000

SCALE 1:1000

DEVELOPMENT APPLICATION
PROJECT TITLE:
ST VINCENT'S COLLEGE DEVELOPMENT APPLICATION



21048


MATERIAL LEGEND




WWS 1 - FACED BRICK - RIVE. METALS CRUSHED GRAY




SST - SAND STONE WALL (DETAILED TO MATCH EXISTING PERIMETER SANDSTONE WALL)

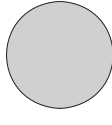


PCA.1/WWS.1/WMS OR PAINT COLOUR TO MATCH COLORBOND - SOUTHERLY (ROOFING)

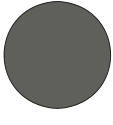

WWS.2/WWS.2/WMS.2/PCA.2 POWDERCOATING (PUPA INTO WOODWORK, GUTTERS, GUTTERS AND TRIMS)

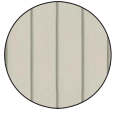

WWS 1 WIRE CEMENT WEATHERBOARD CLADDING (LIGHT CREAM COLOUR)

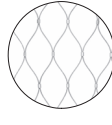

PROPOSED STAINLESS STEEL NETTING TO ROOF TERRACE/COURT WITH 100% WIND BREAK SCREENS



RMR.1 RENDERED MASONRY (WHITE)




DA702
DATE/NUMBER
7
JOB NO
STUDIO - Level 1, 12-16 Green St, CHIPPINDALE NSW 2008
EMAIL - info@leafarch.com.au
WEB - www.leafarch.com.au
REG - 21048 PROJECT NUMBER


PROPOSED SIGNAGE PLANS
PROJECT TITLE
ST VINCENT'S COLLEGE DEVELOPMENT APPLICATION
PROJECT TITLE
PROJECT TITLE
ST VINCENT'S COLLEGE, POTTSPOINT
CLIENT



NO	DATE	REVISION	BY	CHKD	APP'D
1	15/06/2023	For Client (Event) Meeting	JDM	LUP	
2	15/06/2023	Final Design	JDM	LUP	
3	15/06/2023	Final Design	JDM	LUP	
4	24/06/2024	Final Design	JDM	CM	
5	03/06/2024	COMPLIANCE REVIEW	JDM	CM	
6	03/06/2024	COMPLIANCE REVIEW	JDM	CM	
7	03/06/2024	COMPLIANCE REVIEW	JDM	CM	

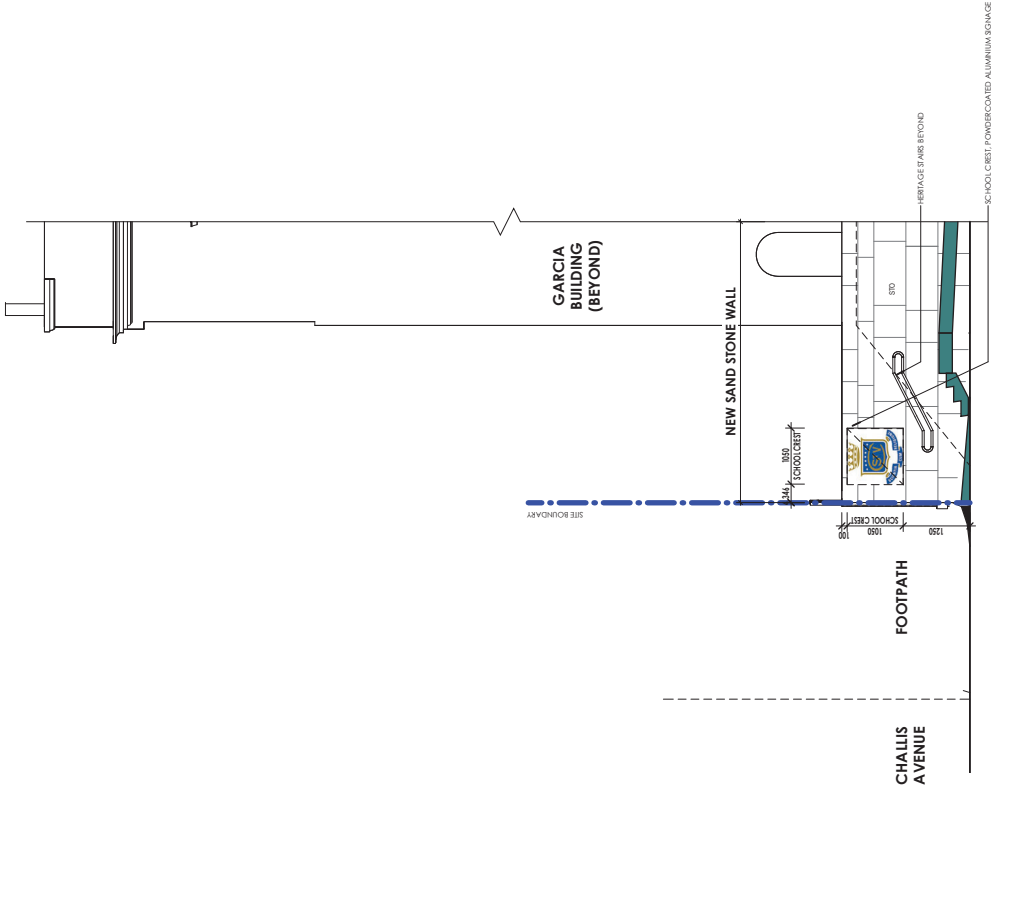


CHALLIS AVENUE ENTRY SIGNAGE DETAIL
1:50

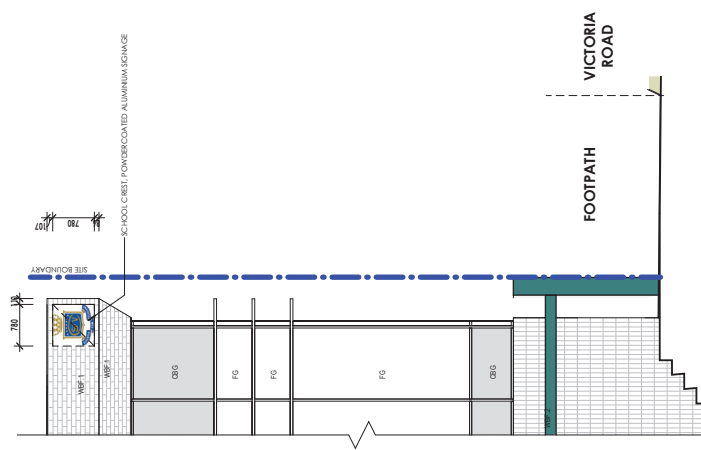

CNR, CHALLIS & VICTORIA SIGNAGE DETAIL
1:50

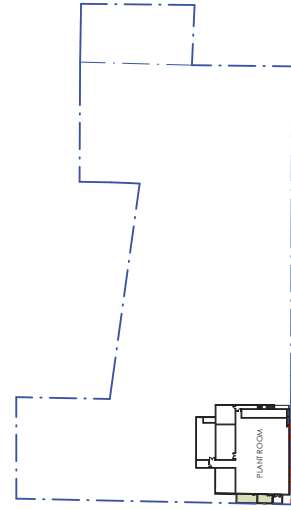


PROPOSED LEVEL -1 (PLANT ROOM)
1:1,000

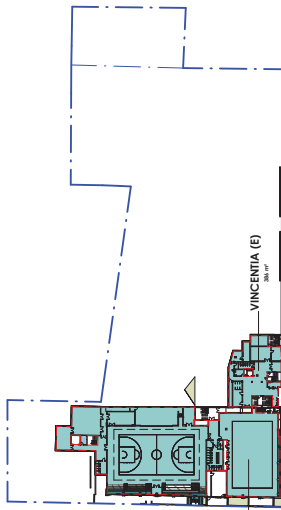


PROPOSED LEVEL 1
1:1,000




PROPOSED LEVEL 4
1:1,000

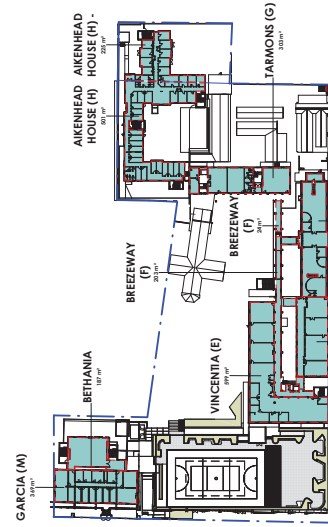

PROPOSED LEVEL 5
1:1,000

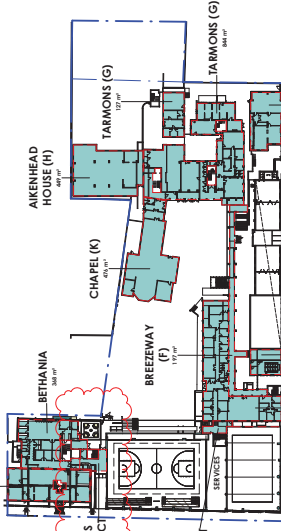

PROPOSED LEVEL 3
1:1,000

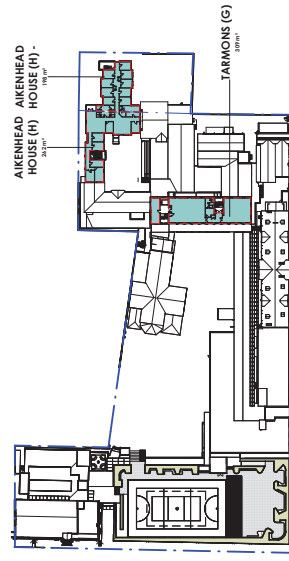

PROPOSED LEVEL 6
1:1,000

Site Area - Area Total

Lot	Site Area	Building GFA	Proposed GFA	Balance	Difference
Lot 10 (200/200)	338.2				
Lot 11 (200/200)	347.9				
Lot 12 (200/200)	347.9				
REFER TO SURVEY FOR SITE AREA

PROPOSED GFA (FR 1.75:1)

BUILDING	AREA
AIKENHEAD HOUSE (H)	4,497 m ²
AIKENHEAD HOUSE (H)	299 m ²
AIKENHEAD HOUSE (H)	501 m ²
AIKENHEAD HOUSE (H)	222 m ²
BETHANIA	348 m ²
BETHANIA	348 m ²
BETHANIA	187 m ²
BREEZEWAY (F)	378 m ²
BREEZEWAY (F)	200 m ²
BREEZEWAY (F)	200 m ²
BREEZEWAY (F)	203 m ²
BREEZEWAY (F)	24 m ²
CHAPEL (K)	476 m ²
GARCIA (M)	349 m ²
GARCIA (M)	348 m ²
GARCIA (M)	369 m ²
MARY AIKENHEAD (B/C)	418 m ²
MARY AIKENHEAD (B/C)	111 m ²
MARY AIKENHEAD (B/C)	402 m ²
MARY AIKENHEAD (D)	312 m ²
MARY AIKENHEAD (D)	106 m ²
MARY AIKENHEAD (D)	335 m ²
MARY AIKENHEAD (D)	39 m ²
MARY AIKENHEAD (D)	37 m ²
SPORTS PRECINCT	237 m ²
SPORTS PRECINCT	63 m ²
SPORTS PRECINCT	243 m ²
SPORTS PRECINCT	37 m ²
ST DOMINIC'S (A)	233 m ²
ST DOMINIC'S (A)	234 m ²
TARMONS (G)	844 m ²
TARMONS (G)	127 m ²
TARMONS (G)	303 m ²
TARMONS (G)	309 m ²
VINCENTIA (E)	386 m ²
VINCENTIA (E)	293 m ²
VINCENTIA (E)	171 m ²
VINCENTIA (E)	410 m ²
VINCENTIA (E)	509 m ²
VINCENTIA (E)	1,561 m ²
Grand Total: 40	1,561 m ²

PROPOSED GFA (FR 1.5:1)

BUILDING	AREA
AIKENHEAD HOUSE (H)	1,514 m ²
AIKENHEAD HOUSE (H)	224 m ²
AIKENHEAD HOUSE (H)	188 m ²
Grand Total: 3	637 m ²

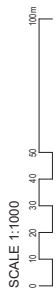

DA882
LEAF ARCHITECTURE
 13
 DATE
 EMAIL: info@leafarch.com.au
 WEBSITE: www.leafarch.com.au
 PROJECT NUMBER: 21048

PROPOSED GROSS FLOOR AREA

DEVELOPMENT APPLICATION




ST VINCENT'S COLLEGE DEVELOPMENT APPLICATION

LEGEND

EXISTING GFA (FR 1.75:1)	EXISTING GFA (FR 1.5:1)	PROPOSED GFA (FR 1.75:1)	PROPOSED GFA (FR 1.5:1)	SITE BOUNDARY
[Light Blue]	[Light Blue]	[Light Blue]	[Light Blue]	[Blue Line]


NOTE:
THIS IMAGE IS INDICATIVE ONLY AND AN ARTIST
IMPRESSION TO COMMUNICATE THE GENERAL
DESIGN INTENT. FOR DETAIL OF PROPOSED MATERIALS
REFER TO PLANS, ELEVATIONS AND SECTIONS.

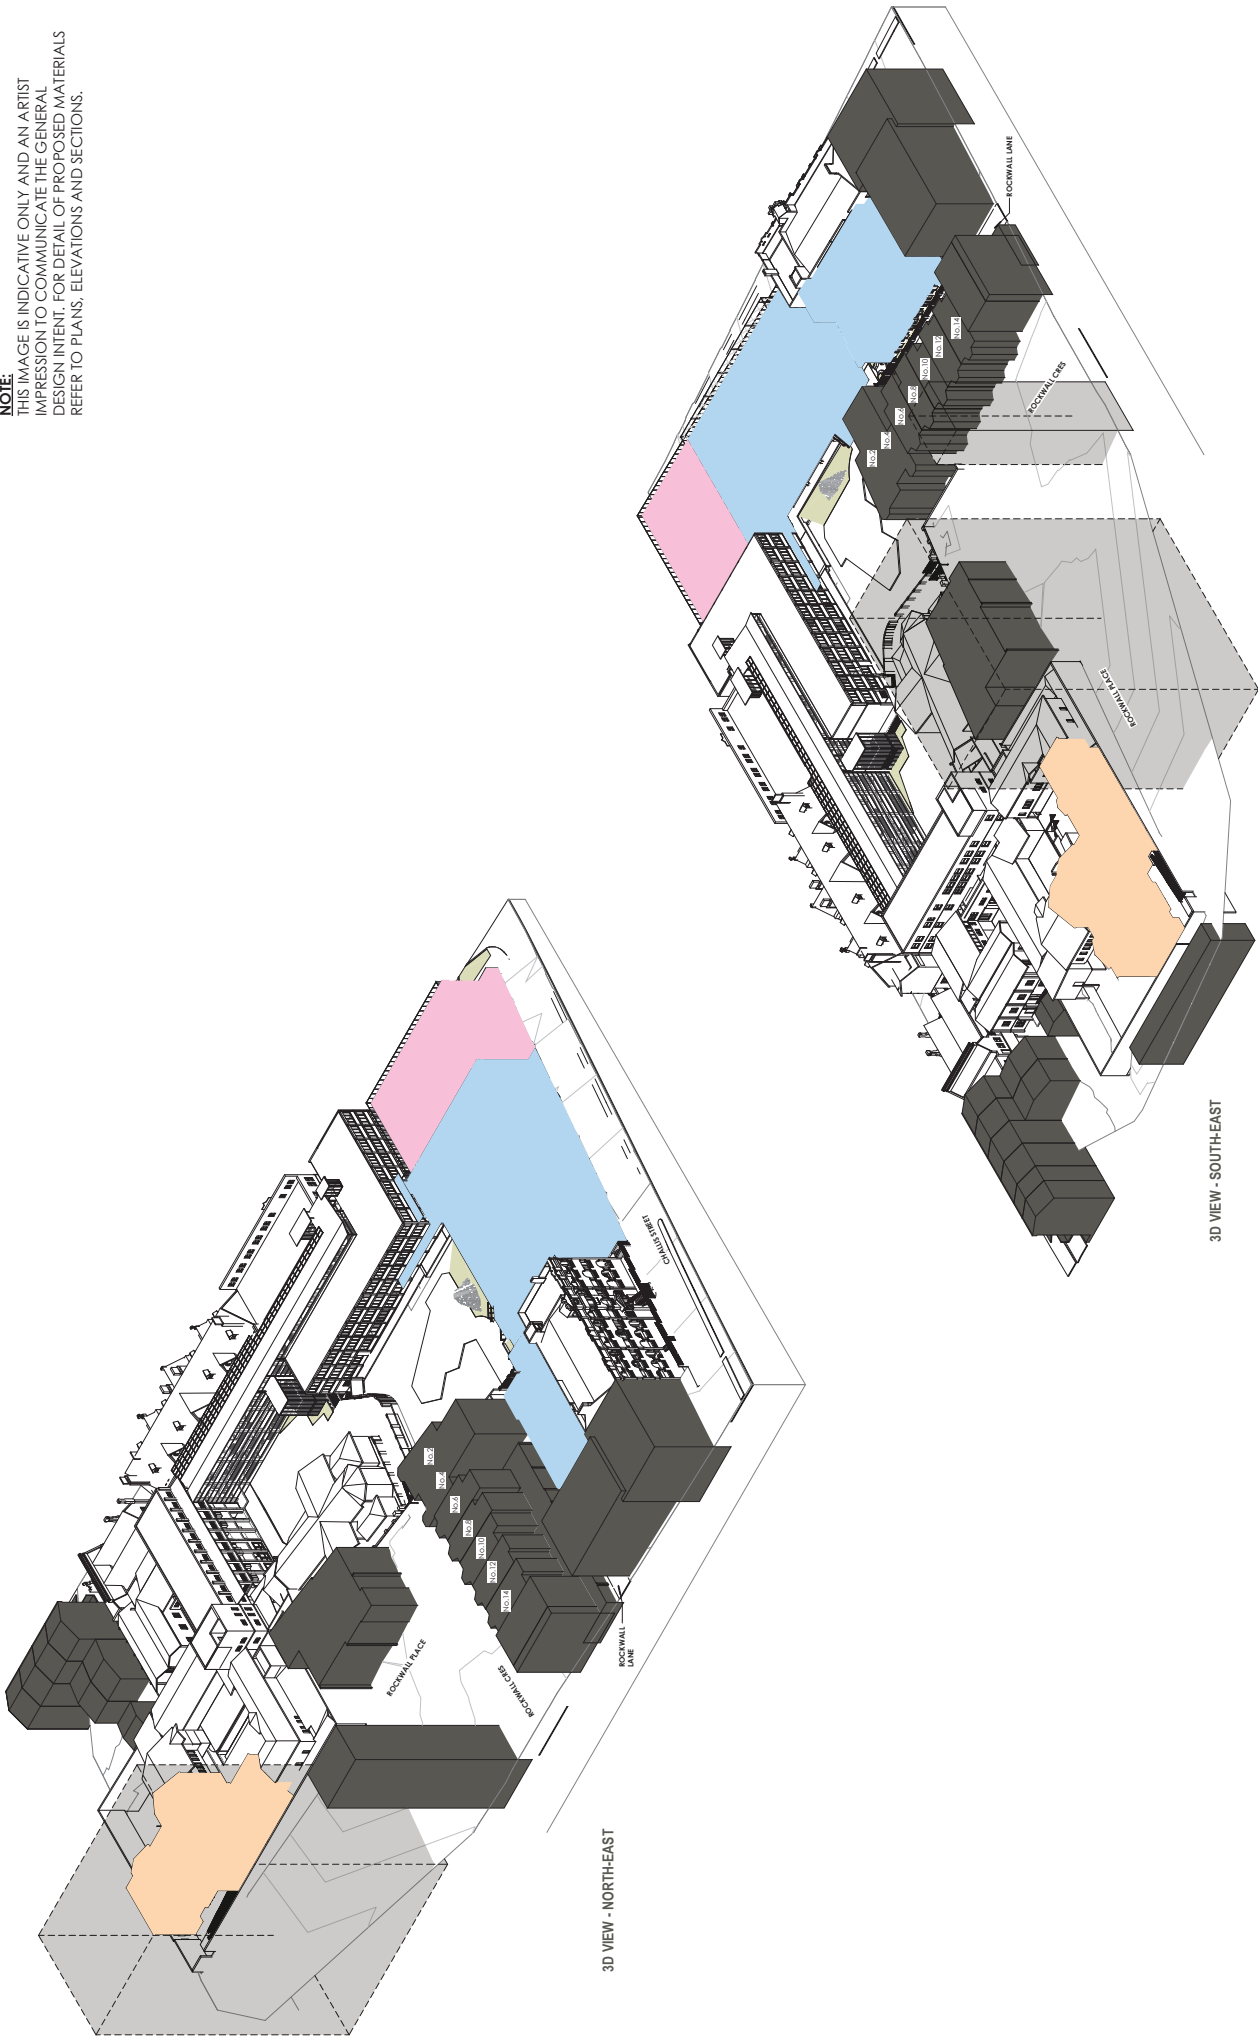

3D VIEW - NORTHEAST

3D VIEW - SOUTHEAST

DA971
PROJECT NUMBER
14
DATE

LEAF
ARCHITECTURE
STUDIO - Level 11, 12, 13, 100


DEVELOPMENT APPLICATION
PROJECT TITLE: ST VINCENT'S COLLEGE DEVELOPMENT APPLICATION

LEGEND	DESCRIPTION
DA STAGE 1	DA STAGE 1
VOID COVER	VOID COVER
DA STAGE 2A	DA STAGE 2A
DA STAGE 2B	DA STAGE 2B
NO DA WORKS	NO DA WORKS
EXISTING BUILDINGS	EXISTING BUILDINGS
LEP HEIGHT LINE	LEP HEIGHT LINE
SITE BOUNDARY	SITE BOUNDARY



3D view - Aerial View - Original DA
1:1




3D view - Aerial View - Proposed
1:1


MATERIAL LEGEND




RM.1
RENDERED MASONRY (WHITE)

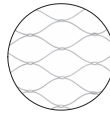


PROPOSED STAINLESS STEEL NETTING TO ROOF TERRACE/COURTYARD WITH SUPPORT POSTS

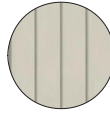

WB.1
WEATHERBOARD CLADDING (LIGHT CREAM COLOUR)

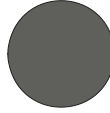

WB.2/WB.3/WB.4/WB.5
WHITE/WHITE/WHITE/WHITE POWDERCOATING AND PAINT TO MATCH WOODLAND GREY SCREENS, GUTTERS AND TRIMS

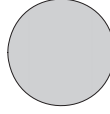

PCA.1/WB.6/WB.7



SST
SANDSTONE WALL (DETAILED TO MATCH EXISTING PERIMETER SANDSTONE WALL)



WB.8
FACE BRICK - PURE, NEVER CRUSHED GREY

NOTE:
THIS IMAGE IS INDICATIVE ONLY AND AN ARTIST IMPRESSION TO COMMUNICATE THE GENERAL DESIGN INTENT. FOR DETAIL OF PROPOSED MATERIALS REFER TO PLANS, ELEVATIONS AND SECTIONS.

NO.	DATE	REVISION	BY	CHECKED	APPROVED
01	15/03/2023	Issue for DA	JDM	LUP	JDM
02	15/03/2023	Issue for DA	JDM	DM	JDM
03	24/03/2023	Issue for DA	JDM	DM	JDM
04	03/04/2023	Issue for DA	JDM	DM	JDM
05	03/04/2023	Issue for DA	JDM	DM	JDM
DEVELOPMENT APPLICATION
PROJECT TITLE
ST VINCENT'S COLLEGE DEVELOPMENT APPLICATION
PROJECT NUMBER

3D VIEWS - Aerial
PROJECT TITLE
ST VINCENT'S COLLEGE DEVELOPMENT APPLICATION
PROJECT NUMBER
ST VINCENT'S COLLEGE POTSPPOINT CLINIC

DA980
LEAF ARCHITECTURE
15
DATE
As indicated
20/04/2023
PROJECT NUMBER
21048
www.leafarch.com.au




3D view - Cnr Challis & Victoria - Original DA
1:1




3D view - Cnr Challis & Victoria - Proposed
1:1


MATERIAL LEGEND



R04.1 RENDERED MASONRY (WHITE)

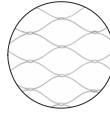


R04.2 PROPOSED STAINLESS STEEL NETTING TO ROOF TERRACE/COURT WITH SUPPORT POSTS

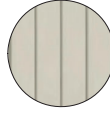

W01.1 WEATHERBOARD CLADDING (LIGHT CREAM COLOUR)



W02.1/W02.2/W02.3 WHITE FACE BRICK - PURE

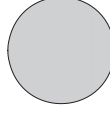

W03.1 SANDSTONE WALL (DETAILED TO MATCH EXISTING PERIMETER SANDSTONE WALL)



W04.1/W04.2 FACE BRICK - PURE

NEVER CRUSHED GREY

NOTE: THIS IMAGE IS INDICATIVE ONLY AND AN ARTIST IMPRESSION TO COMMUNICATE THE GENERAL DESIGN INTENT. FOR DETAIL OF PROPOSED MATERIALS REFER TO PLANS, ELEVATIONS AND SECTIONS.

DATE	REVISION	BY	CHKD	APP'D
10/03/2023	Issue for DA	JRM	LUP	
15/03/2023	Issue for DA	JRM	CH	
24/03/2023	Issue for DA	JRM	CH	
03/04/2023	Issue for DA	JRM	CH	
10/04/2023	Issue for DA	JRM	CH	
20/04/2023	Issue for DA	JRM	CH	

NO.	DESCRIPTION	STATUS
01	Issue for DA	U
02	Issue for DA	U
DEVELOPMENT APPLICATION
PROJECT TITLE
ST VINCENT'S COLLEGE DEVELOPMENT APPLICATION
PROJECT SITE
ST VINCENT'S COLLEGE, POTTS POINT
R04.1/W01.1/W02.1/W02.2/W02.3
POWDER COATING OR PAINT
COLOUR TO MATCH
EXISTING ROOFING
R04.2
PROPOSED STAINLESS STEEL
NETTING TO ROOF
TERRACE/COURT WITH
SUPPORT POSTS
W01.1
WEATHERBOARD CLADDING
(LIGHT CREAM COLOUR)
W02.1/W02.2/W02.3
WHITE FACE BRICK - PURE
NEVER CRUSHED GREY
SCREENS, GUTTERS AND TRIMS
TO MATCH WOODLAND GREY
FACE BRICK - PURE
NEVER CRUSHED GREY
SCREENS, GUTTERS AND TRIMS
ST VINCENT'S COLLEGE, POTTS POINT
CLIENT

DA981
DRAWING NUMBER
15
DATE
ARCHITECTURE
LEAF ARCHITECTURE
STUDIO - Level 11, 12, 13, 100
PROJECT NUMBER
21048
www.leafarch.com.au



3D view - Foyer Entry - Original DA
1:1




3D view - Foyer Entry - Proposed
1:1


MATERIAL LEGEND




RM.1 RENDERED MASONRY (WHITE)

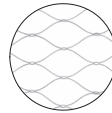


PROPOSED STAINLESS STEEL NETTING TO ROOF TERRACE/COURTYARD WITH SUPPORT POSTS

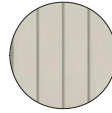

WB.1 WEATHERBOARD CLADDING (LIGHT CREAM COLOUR)

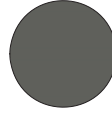

WWS.2/WWS.2/WWS.2/WWS.2 TO MATCH WOODLAND GREY SCREENS, GUTTERS AND TRIMS

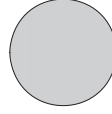

PCA.1/WRN.1/WRS POWDERCOATING OR PAINT COLOUR TO MATCH ROOM AND SOOTHERLY (ROOMS)



SST SANDSTONE WALL (DETAILED TO MATCH EXISTING PERIMETER SANDSTONE WALL)



WBE.1 FACE BRICK - PURE, NEVER CRUSHED GREY

NOTE: THIS IMAGE IS INDICATIVE ONLY AND AN ARTIST IMPRESSION TO COMMUNICATE THE GENERAL DESIGN INTENT. FOR DETAIL OF PROPOSED MATERIALS REFER TO PLANS, ELEVATIONS AND SECTIONS.

NO.	DATE	REVISION	BY	CHECKED	STATUS
01	15/03/2023	Issue for DA	JRM	LUP	FOR APPROVAL
02	15/03/2023	Issue for DA	JRM	LUP	FOR APPROVAL
03	24/03/2023	Issue for DA	JRM	CM	FOR APPROVAL
04	03/04/2023	Issue for DA	JRM	CM	FOR APPROVAL
05	03/04/2023	Issue for DA	JRM	CM	FOR APPROVAL
DA982
DA982
15
 DATE
 DRAWING NUMBER
 SHEET NUMBER

LEAF ARCHITECTURE


3D VIEWS - Front Foyer

PROPOSED FINISH
 PRODUCT NAME
 ST VINCENT'S COLLEGE DEVELOPMENT APPLICATION

PROPOSED FINISH
 PRODUCT NAME
 ST VINCENT'S COLLEGE POTTS POINT CLIENT

DEVELOPMENT APPLICATION

PROPOSED FINISH
 PRODUCT NAME
 ST VINCENT'S COLLEGE DEVELOPMENT APPLICATION

PROPOSED FINISH
 PRODUCT NAME
 ST VINCENT'S COLLEGE POTTS POINT CLIENT



3D view - Rockwall Lane - Original DA




3D view - Rockwall Lane - Proposed


MATERIAL LEGEND




R04.1 RENDERED MASONRY (WHITE)

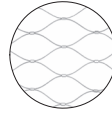


R04.2 PROPOSED STAINLESS STEEL NETTING TO ROOF TERRACE/COURT WITH SUPPORT POSTS

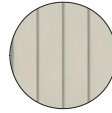

W04.1 WEATHERBOARD CLADDING (LIGHT CREAM COLOUR)

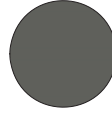

W04.2 WAIN / WMS / WPC / W2 POWDERCOATING AND PAINT TO MATCH WOODLAND GREY SCREENS, GUTTERS AND TRIMS

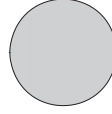

R04.1 WMS / WMS POWDERCOATING OR PAINT COLOUR TO MATCH WMS / WMS (ROOFING)



S01 SANDSTONE WALL (DETAILED TO MATCH EXISTING PERIMETER SANDSTONE WALL)



W04.1 FACE BRICK - PURE, NEVER CRUSHED GREY

NOTE: THIS IMAGE IS INDICATIVE ONLY AND AN ARTIST IMPRESSION TO COMMUNICATE THE GENERAL DESIGN INTENT. FOR DETAIL OF PROPOSED MATERIALS REFER TO PLANS, ELEVATIONS AND SECTIONS.

NO	DATE	REVISION	BY	CHECKED	REVISION	DATE
1	07/03/2023	Issue for DA	JPM	LUP		
2	15/03/2023	Issue for DA - Rev 1	JPM	LUP		
3	15/03/2023	Issue for DA - Rev 2	JPM	CM		
4	27/03/2023	Issue for DA - Rev 3	JPM	CM		
5	03/04/2023	Issue for DA - Rev 4	JPM	CM		

DEVELOPMENT APPLICATION
ST VINCENT'S COLLEGE DEVELOPMENT APPLICATION
 PROJECT TITLE
 ST VINCENT'S COLLEGE, POTTS POINT
 CLIENT

DA984
ARCHITECTURE
14
 DATE
 14/03/2023
 PROJECT NUMBER